

FED. ROAD DIST. NO.	STATE	FEDERAL AID PROJ. NO.	FISCAL YEAR	SHEET NO.	TOTAL SHEETS
HAWAII	HAW.	BLD-092-1(029)	2021	5	295

PUBLIC HEALTH, SAFETY AND CONVENIENCE NOTES:

1. The Contractor shall observe and comply with all Federal, State, and Local laws required for the protection of public health and safety and environmental quality.
2. The Contractor, at his own expense, shall keep the project and its surrounding areas free from dust nuisance. The work shall be in conformance with the air pollution standards and regulations of the State Department of Health. The City may require supplementary measures as necessary.
3. The Contractor's attention is directed to Chapter 448, Public Health Regulations, Department of Health, State of Hawaii, "Community Noise Control for Oahu" in which maximum allowable noise levels have been set. If the construction activities for this project will exceed the allowable noise levels, the Contractor will be required to obtain a permit from the Director of the Department of Health. The Contractor shall obtain a copy of Chapter 448 and become familiar with the noise level restrictions and the procedures for obtaining a Permit for construction activities.
4. The Contractor is to comply with the directions of the State of Hawaii Occupation Safety and Health Law (DOSH).

ORIGINAL PLAN	SURVEY PLOTTED BY	DATE
	DRAWN BY	
	DESIGNED BY	
	NOTED BY	
	CHECKED BY	
NOTE BOOK		
No.		


RANDALL M. URASAKI

LICENSED PROFESSIONAL ENGINEER

No. 7269-C

HAWAII U.S.A.

THIS WORK WAS PREPARED BY ME OR UNDER MY SUPERVISION.

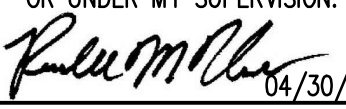

04/30/22

SIGNATURE

EXPIRATION DATE OF THE LICENSE

STATE OF HAWAII
DEPARTMENT OF TRANSPORTATION
HIGHWAYS DIVISION

GENERAL NOTES

ALA MOANA BOULEVARD
ELEVATED PEDESTRIAN WALKWAY
Federal Aid Project No. BLD-092-1(029)














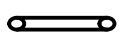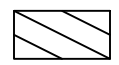



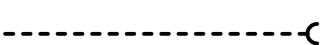



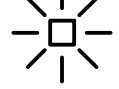
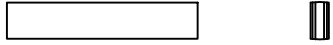


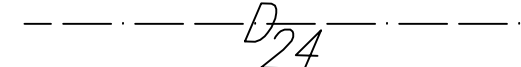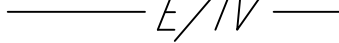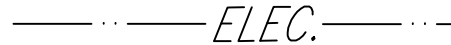

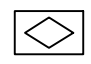


Scale: NoneDate: July 2021














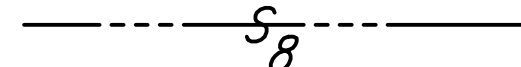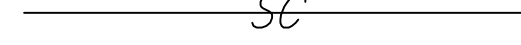


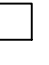

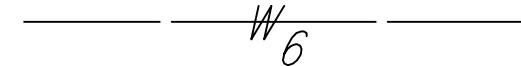



SHEET No. N-4 OF 10 SHEETS

5

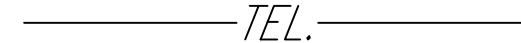LEGEND:

EXISTING

	BFP
	CATV BOX
	C.O.
	DI
	D.S.
	DSP
	24" DRAIN LINE
	ELECTRIC/TV LINE
	ELEC. BOX
	ELEC MH
	ELEC. BOX
	ELEC TRANSFORMER
	E.O.
	F.A. BOX
	FH
	2" GAS LINE
	G.P.
	G.W.
	H.B.
	ICV
	ICV BOX
	L.P.
	MB
	MH
	OVERHEAD LINE
	PBX
	PSL
	RISER
	SCMH
	SDMH

	SMH
	SEWER VALVE
	8" SEWER LINE
	SIGNAL CORPS LINE
	S.L.
	SLB
	SPR
	STREET MONUMENT
	TEL BOX
	TEL. MH
	TELEPHONE LINE
	TREE
	TSL
	TSLB
	U.P./S.L.
	U.P./CONDUIT
	UTILITY BOX
	U.S. POSTAL M.B.
	6" WATERLINE
	WM
	WMH
	WV

ABBREVIATIONS:

AC	Asphalt Concrete
APPROX.	Approximate
BL	Baseline
BC	Bottom Curb
BFP	Back Flow Preventer
BOT.	Bottom
BW	Bottom Wall
CL	Centerline
C	Chord
CATV	Cable Television
C.B.	Catch Basin
C.L.	Chain Link
CMU	Concrete Masonry Unit
C.O.	Clean Out
COL.	Column
COMM.	Communication
CONC.	Concrete
CRM	Concrete Rubble Masonry
D	Diameter or Drain
DI	Drain Inlet
D.S.	Down Spout
DSP	Dry Stand Pipe
DWY	Driveway
E/D42	Existing 42" Drain Pipe
E/ELEC.	Electric
ELEV/EL.	Elevation
EMH	Electric Manhole
E.O.	Electric Outlet
EP	Edge of Pavement
F.A.	Fire Alarm
FH	Fire Hydrant
G	Gas
GND.	Ground
G.P.	Guard Post/Guy Pole/Gate Post
GV	Gas Valve
G.W.	Guy Wire
H	Height
H.B.	Hose Bib
HMA	Hot Mix Asphalt
ICV	Irrigation Control Valve
INV.	Invert
JPCP	Jointed Pre-cast Concrete Pavement
L.P.	Lamp Pole / Light Pole
MB	Mail Box
MH	Manhole
NTS	Not to Scale
O/H	Overhead
PBX	Penal Box

PCC	Portland Cement Concrete
P/L	Property Line
PSL	Pedestrian Signal Light
REF	Reflector
RPM	Raised Pavement Marker
R/W	Right of Way
S	Sewer or Spread
SC	Signal Corps
SCMH	Signal Corps Manhole
SDMH	Storm Drain Manhole
S.E.	Super Elevation
S.L.	Street Light
SLB	Street Light Box
SMH	Sewer Manhole
ST. NAME	Street Name
STA.	Station
TC	Top Curb
TDC	Top Drop Curb
T/TEL.	Telephone/Tangent
TMH	Telephone Manhole
TP	Top Pipe
TS	Top Stem
TSL	Traffic Signal Light
TSLB	Traffic Signal Light Box
TV	Top Valve
TW	Top Wall
U.P.	Utility Pole
U.P./S.L.	Utility Pole w/Street Light
W	Water
WM	Water Meter
WMH	Water Manhole
WV	Water Valve Box
X-WALK	Cross Walk

SURVEY PLOTTED BY	DATE
DRAWN BY	
TRACED BY	
DESIGNED BY	
NOTE BOOK	
QUANTITIES BY	
CHECKED BY	
N.	

FED. ROAD DIST. NO.	STATE	FEDERAL AID PROJ. NO.	FISCAL YEAR	SHEET NO.	TOTAL SHEETS
HAWAII	HAW.	BLD-092-1(029)	2021	7	295


RANDALL M. URASKI

LICENSED PROFESSIONAL ENGINEER

No. 7269-C

HAWAII U.S.A.

THIS WORK WAS PREPARED BY ME OR UNDER MY SUPERVISION.



SIGNATURE

EXPIRATION DATE OF THE LICENSE

04/30/22

STATE OF HAWAII

DEPARTMENT OF TRANSPORTATION

HIGHWAYS DIVISION

LEGEND AND ABBREVIATIONS

ALA MOANA BOULEVARD

ELEVATED PEDESTRIAN WALKWAY

Federal Aid Project No. BLD-092-1(029)

Scale: None

Date: July 2021

SHEET No. N-6 OF 10 SHEETS

7