



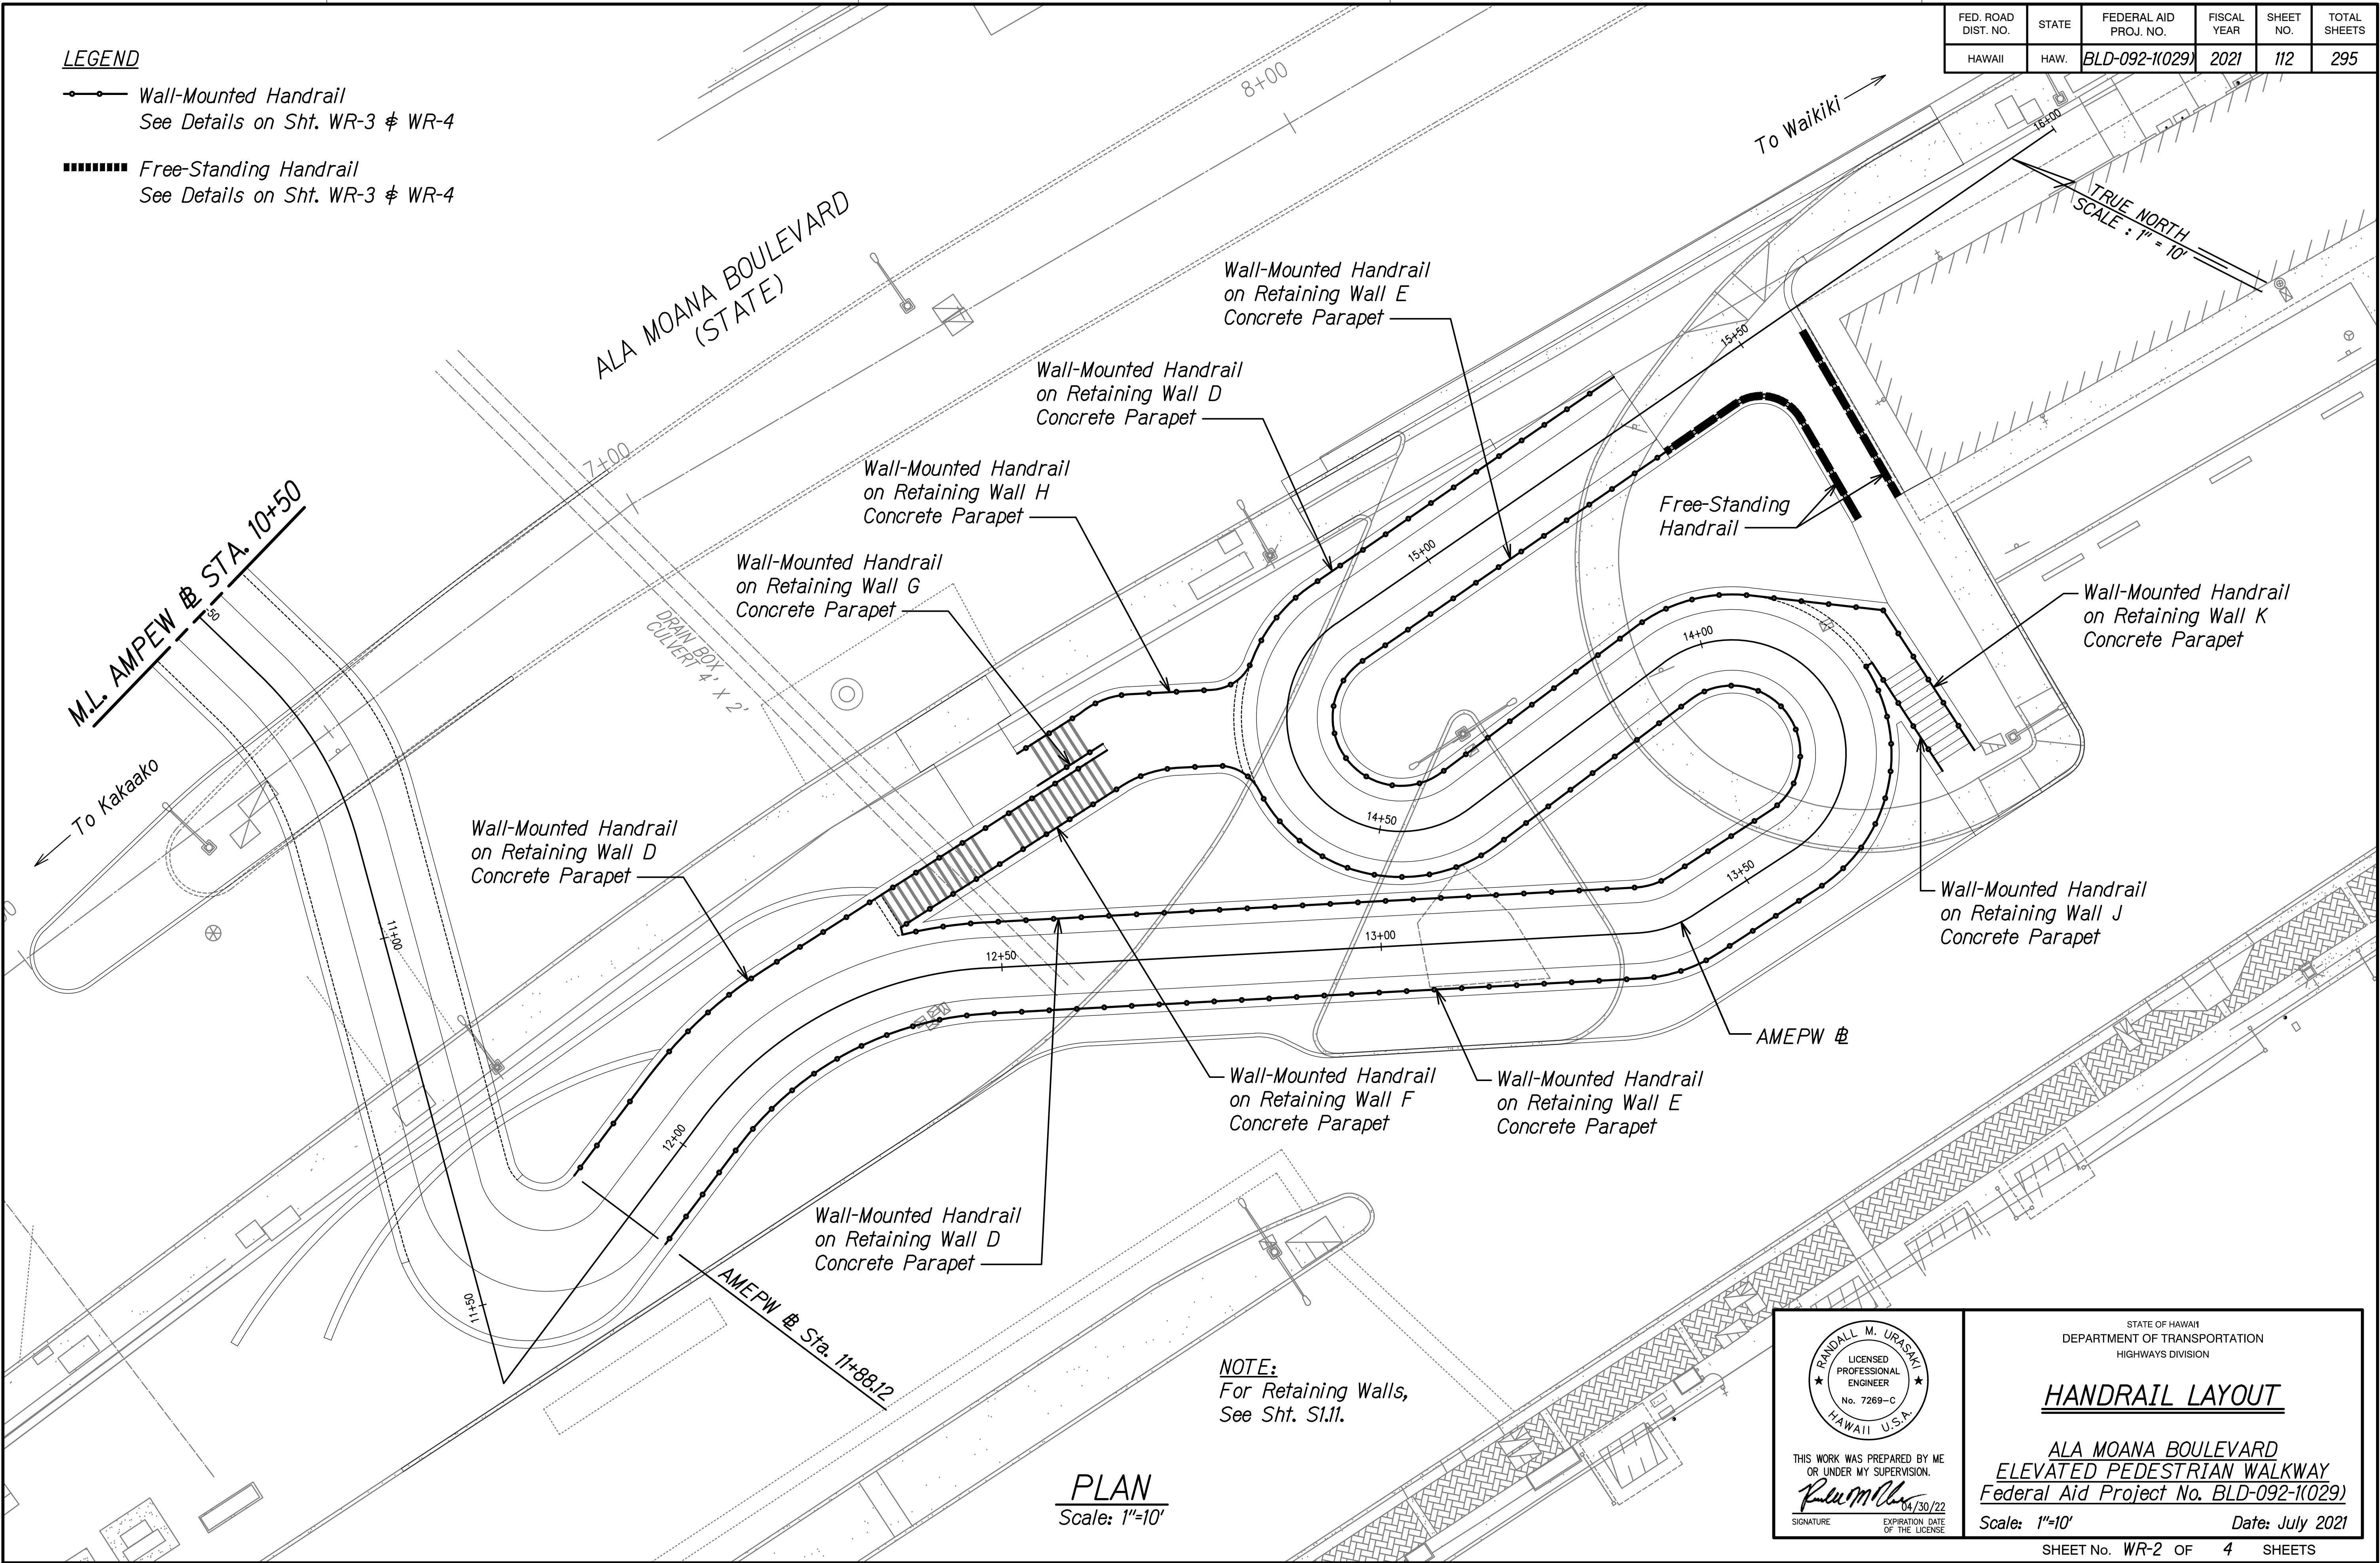


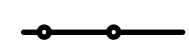

FED. ROAD DIST. NO.	STATE	FEDERAL AID PROJ. NO.	FISCAL YEAR	SHEET NO.	TOTAL SHEETS
HAWAII	HAW.	BLD-092-1(029)	2021	112	295

**LEGEND**


-  Wall-Mounted Handrail  
See Details on Sht. WR-3 & WR-4
-  Free-Standing Handrail  
See Details on Sht. WR-3 & WR-4



SURVEY PLOTTED BY	DATE
DRAWN BY	
DESIGNED BY	
NOTE BOOK	
QUANTITIES BY	
CHECKED BY	
No.	

**NOTE:**  
For Retaining Walls,  
See Sht. S1.11.

**PLAN**  
Scale: 1"=10'

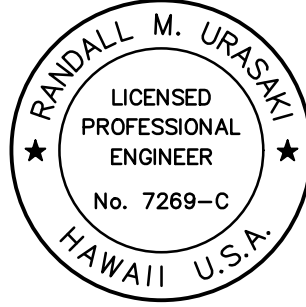

THIS WORK WAS PREPARED BY ME  
OR UNDER MY SUPERVISION.  
*Randall M. Uraski*  
SIGNATURE EXPIRATION DATE OF THE LICENSE 04/30/22

STATE OF HAWAII  
DEPARTMENT OF TRANSPORTATION  
HIGHWAYS DIVISION

**HANDRAIL LAYOUT**

ALA MOANA BOULEVARD  
ELEVATED PEDESTRIAN WALKWAY  
Federal Aid Project No. BLD-092-1(029)

Scale: 1"=10' Date: July 2021





