











| FED. ROAD DIST. NO. | STATE | FEDERAL AID PROJ. NO. | FISCAL YEAR | SHEET NO. | TOTAL SHEETS |
|---------------------|-------|-----------------------|-------------|-----------|--------------|
| HAWAII              | HAW.  | BLD-092-1(029)        | 2021        | 55        | 295          |

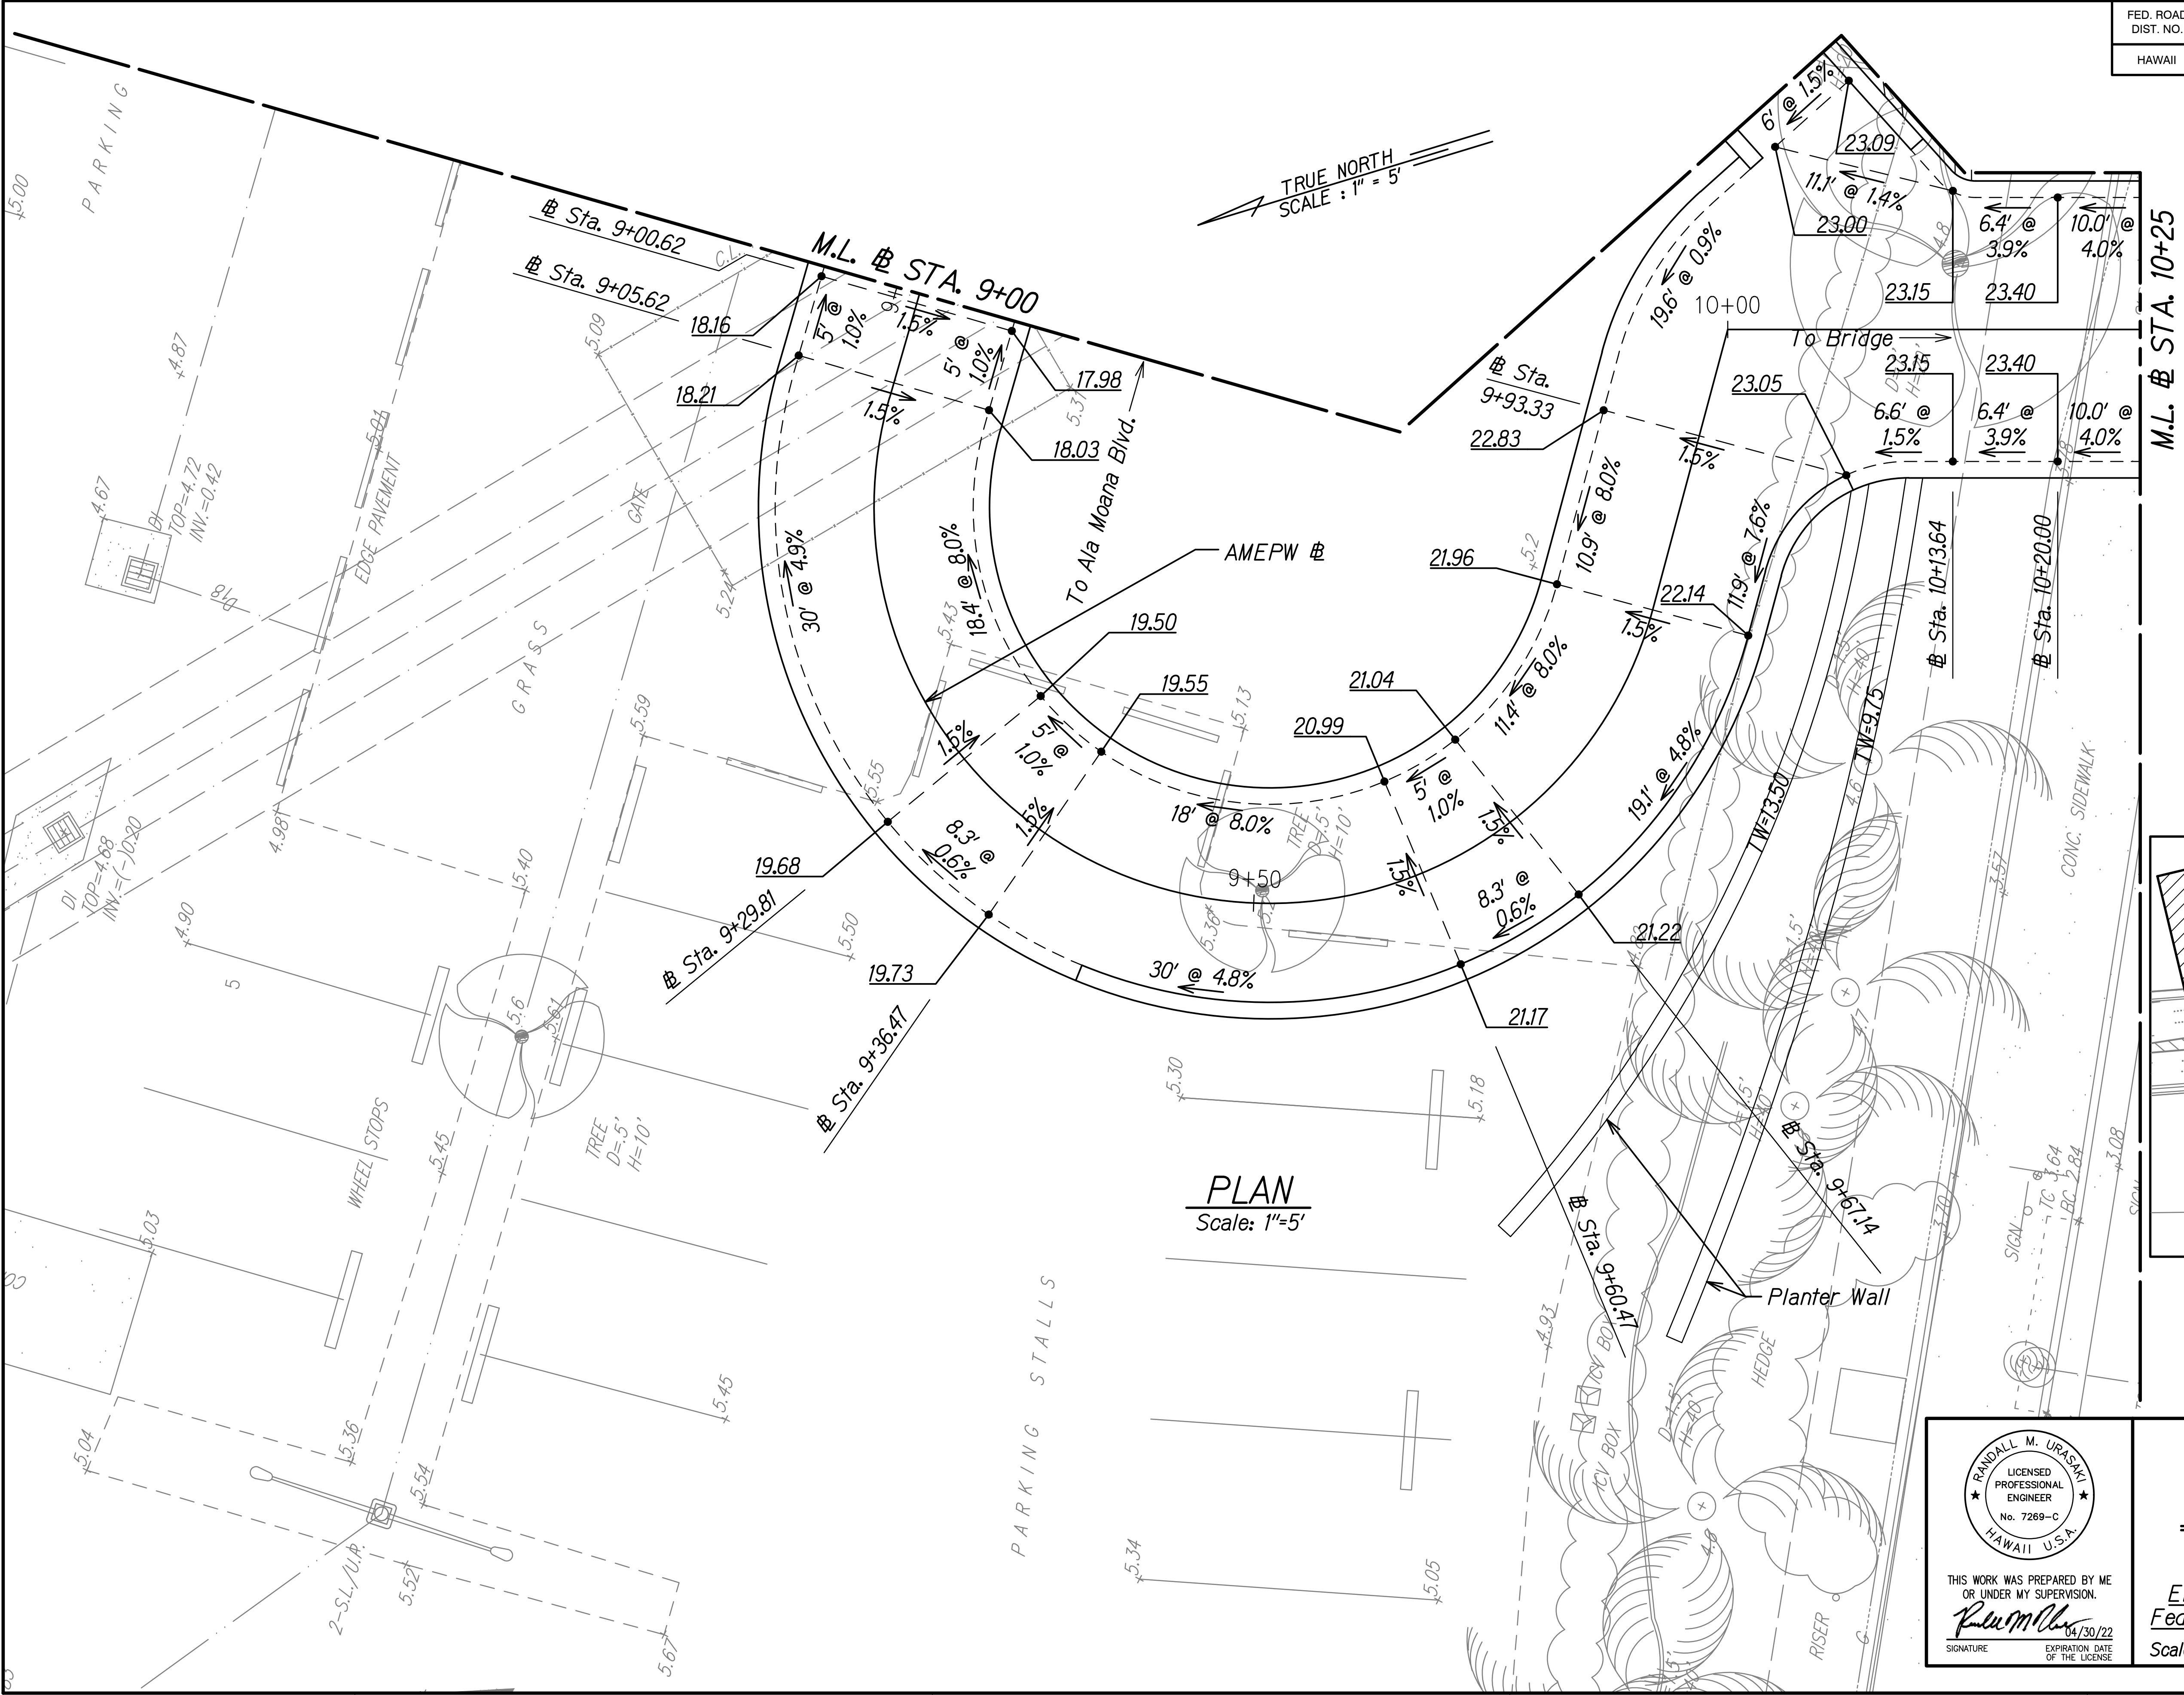

PLAN  
Scale: 1"=5'

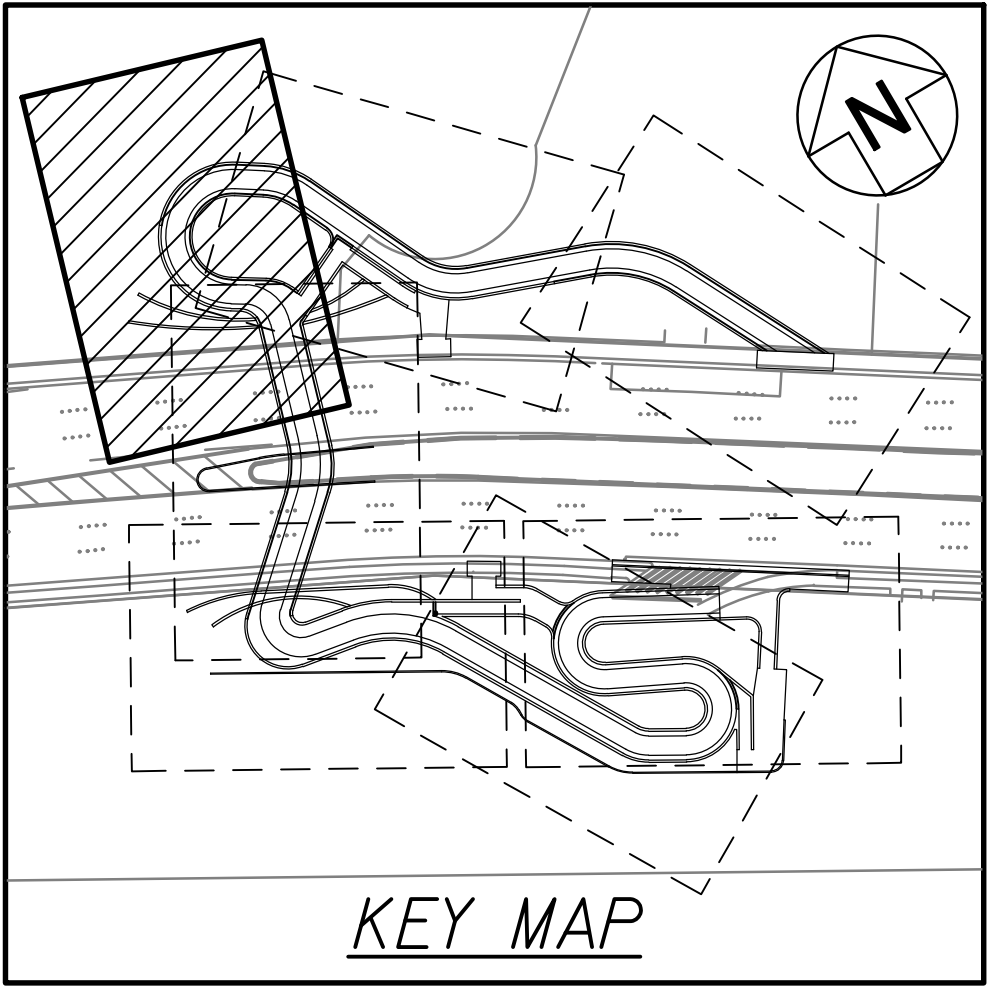

|               |                   |      |
|---------------|-------------------|------|
| ORIGINAL PLAN | SURVEY PLOTTED BY | DATE |
| NOTE BOOK     | DRAWN BY          |      |
| QUANTITIES BY | DESIGNED BY       |      |
| CHECKED BY    |                   |      |

★

RANDALL M. URASAKI

LICENSED PROFESSIONAL ENGINEER

No. 7269-C

HAWAII U.S.A.

★

THIS WORK WAS PREPARED BY ME OR UNDER MY SUPERVISION.

*R. M. Urasaki*

SIGNATURE

04/30/22

EXPIRATION DATE OF THE LICENSE

STATE OF HAWAII  
DEPARTMENT OF TRANSPORTATION  
HIGHWAYS DIVISION

**SPOT ELEVATION PLAN**

ALA MOANA BOULEVARD  
ELEVATED PEDESTRIAN WALKWAY  
Federal Aid Project No. BLD-092-1(029)

Scale: 1"=5'

Date: July 2021



SHEET No. CE-3 OF 7 SHEETS







| FED. ROAD DIST. NO. | STATE | FEDERAL AID PROJ. NO. | FISCAL YEAR | SHEET NO. | TOTAL SHEETS |
|---------------------|-------|-----------------------|-------------|-----------|--------------|
| HAWAII              | HAW.  | BLD-092-1(029)        | 2021        | ADD. 57   | 295          |

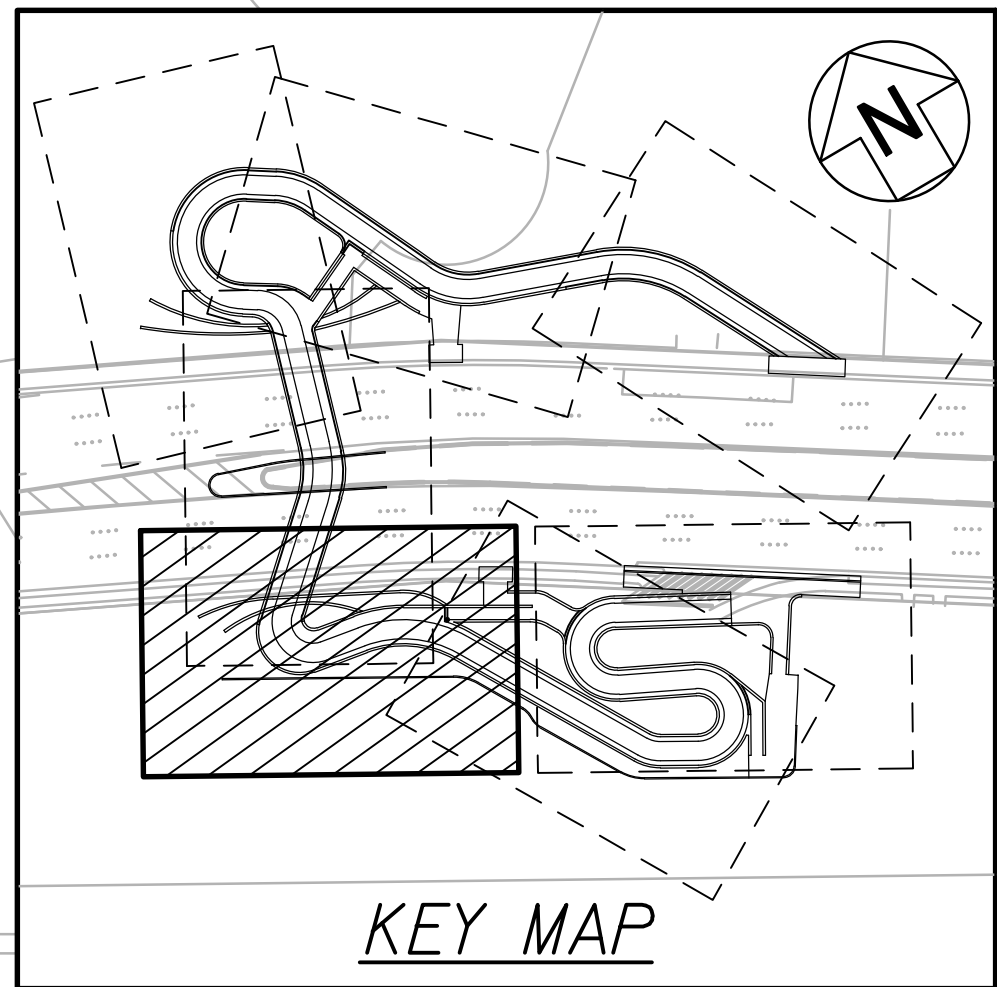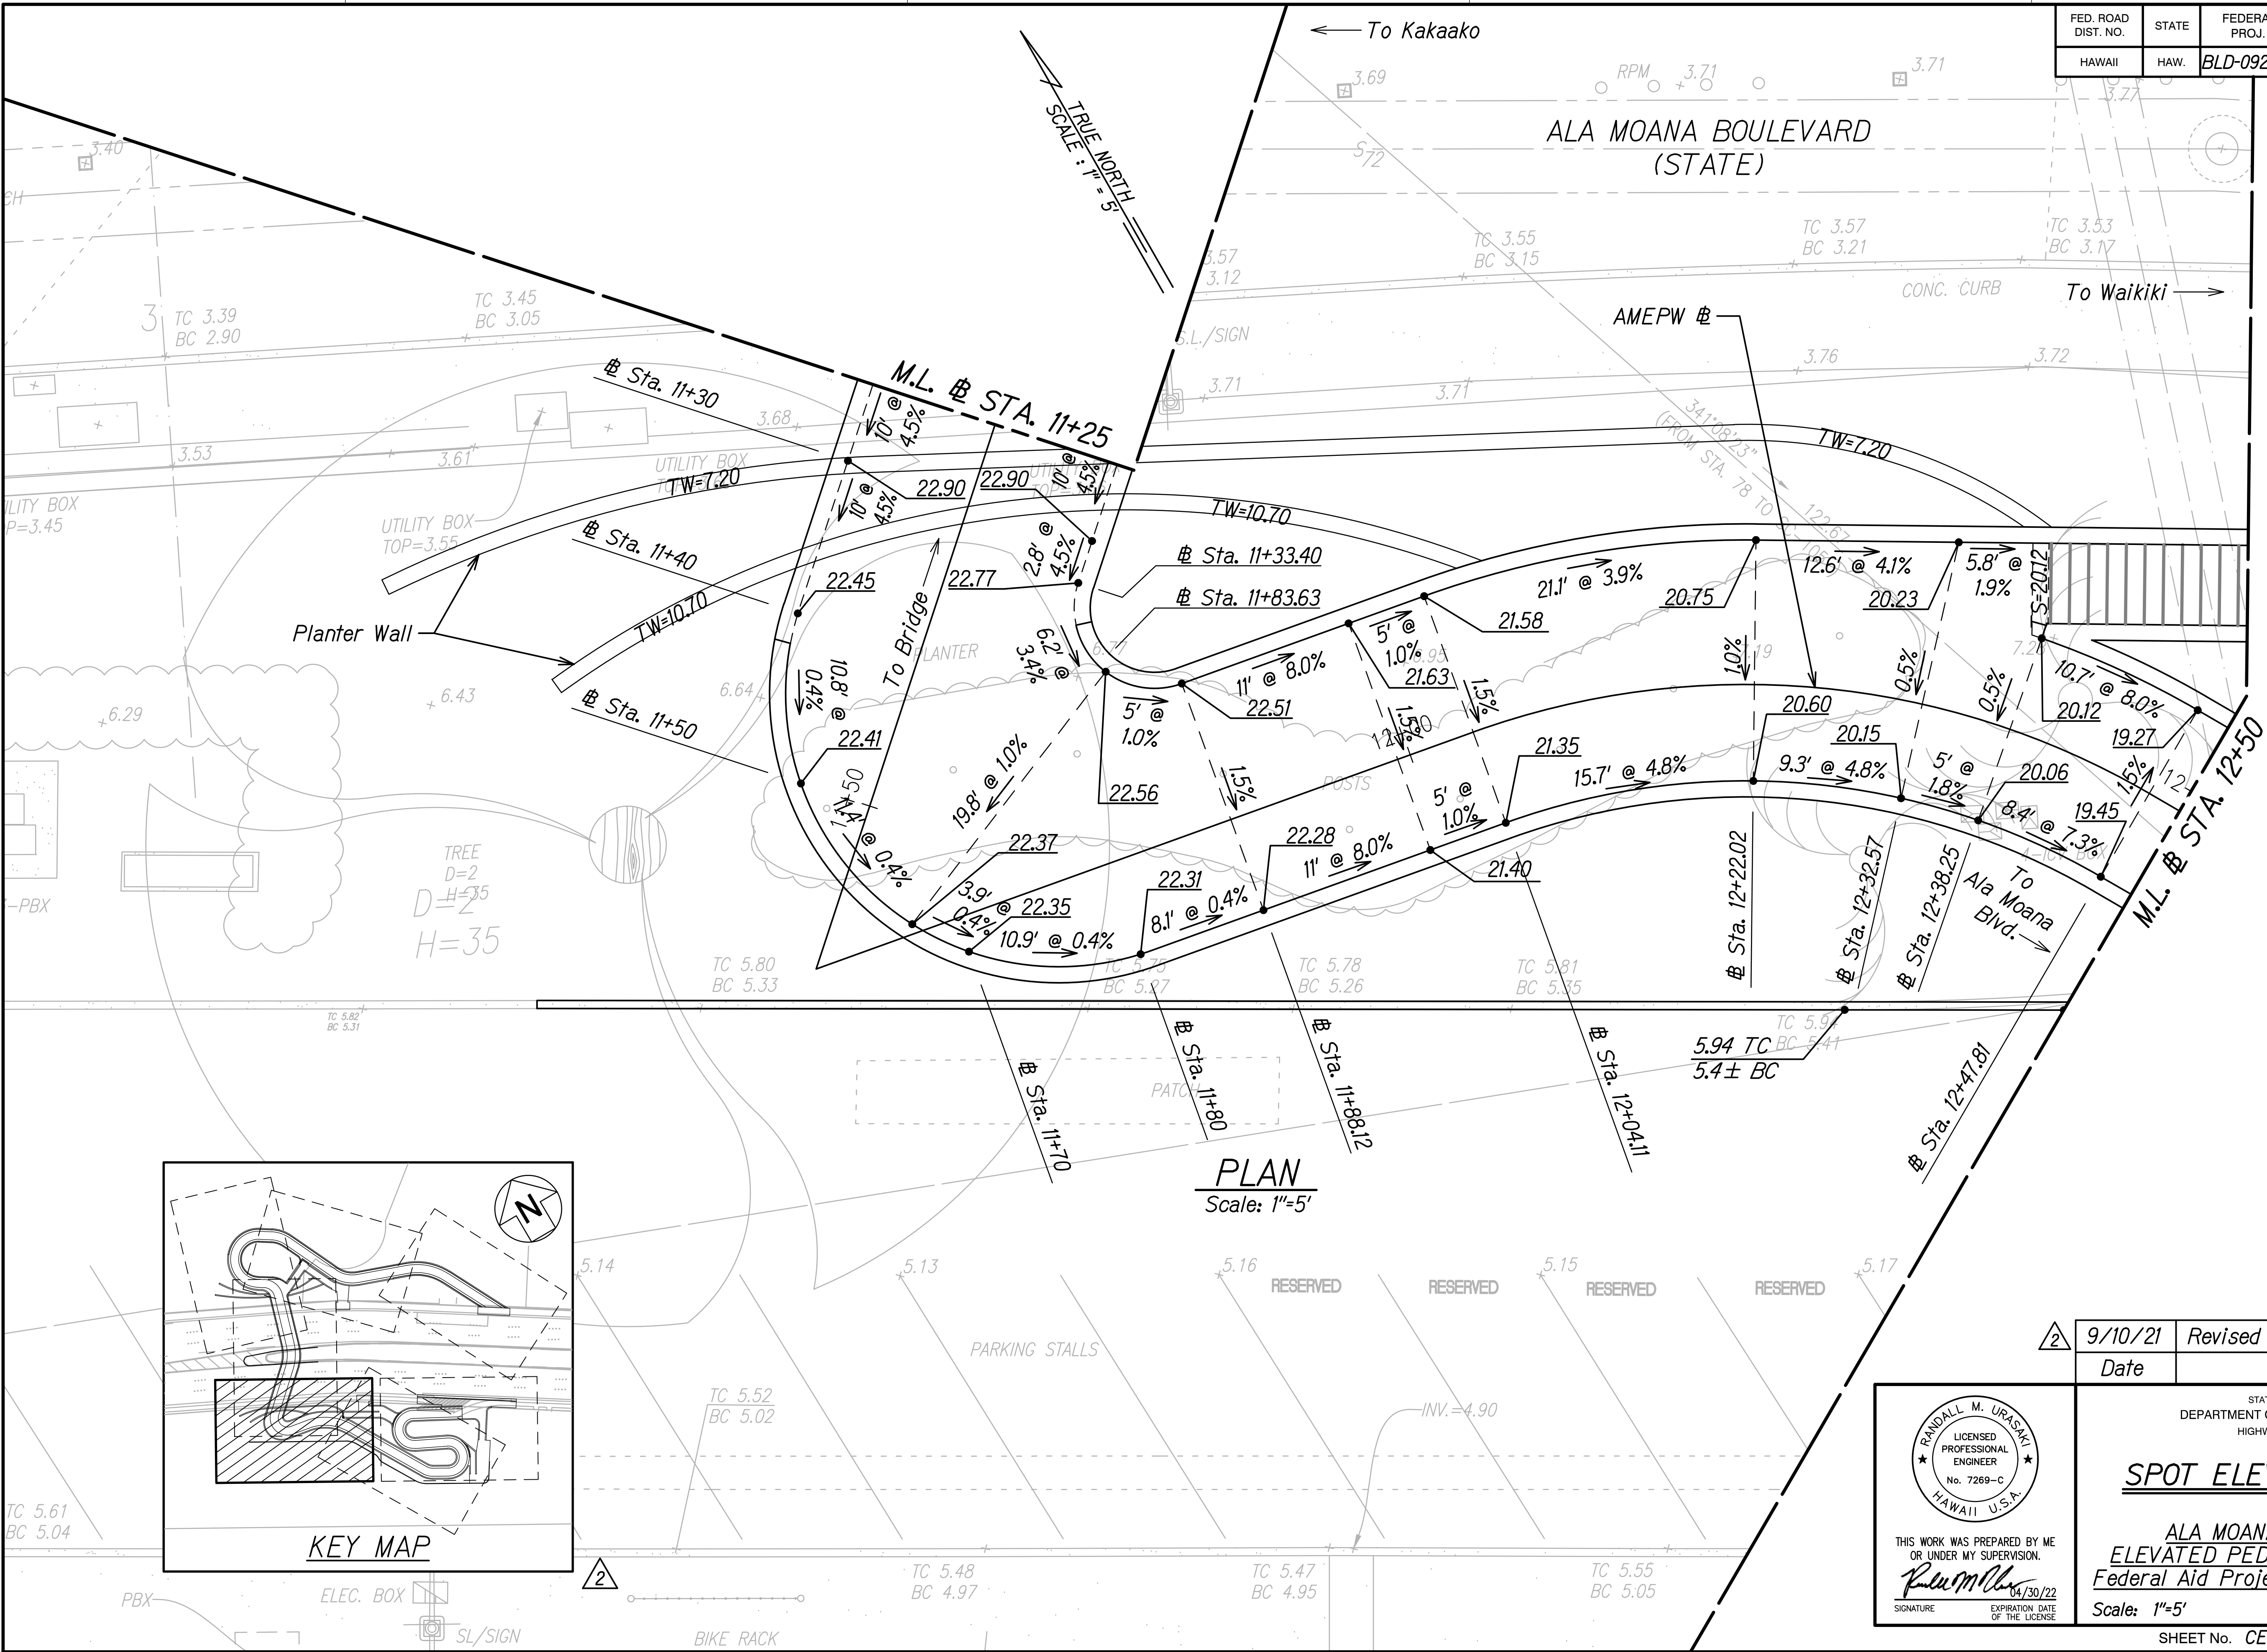

|                   |         |
|-------------------|---------|
| DATE              | 9/10/21 |
| SURVEY PLOTTED BY | DATE    |
| DRAWN BY          | DATE    |
| DESIGNED BY       | DATE    |
| NOTED BY          | DATE    |
| CHECKED BY        | DATE    |

| Date    | Revision        |
|---------|-----------------|
| 9/10/21 | Revised Key Map |

STATE OF HAWAII  
DEPARTMENT OF TRANSPORTATION  
HIGHWAYS DIVISION

**SPOT ELEVATION PLAN**


ALA MOANA BOULEVARD  
ELEVATED PEDESTRIAN WALKWAY  
Federal Aid Project No. BLD-092-1(029)

Scale: 1"=5' Date: July 2021

SHEET No. CE-5 OF 7 SHEETS




| FED. ROAD DIST. NO. | STATE | FEDERAL AID PROJ. NO. | FISCAL YEAR | SHEET NO. | TOTAL SHEETS |
|---------------------|-------|-----------------------|-------------|-----------|--------------|
| HAWAII              | HAW.  | BLD-092-1(029)        | 2021        | ADD. 58   | 295          |

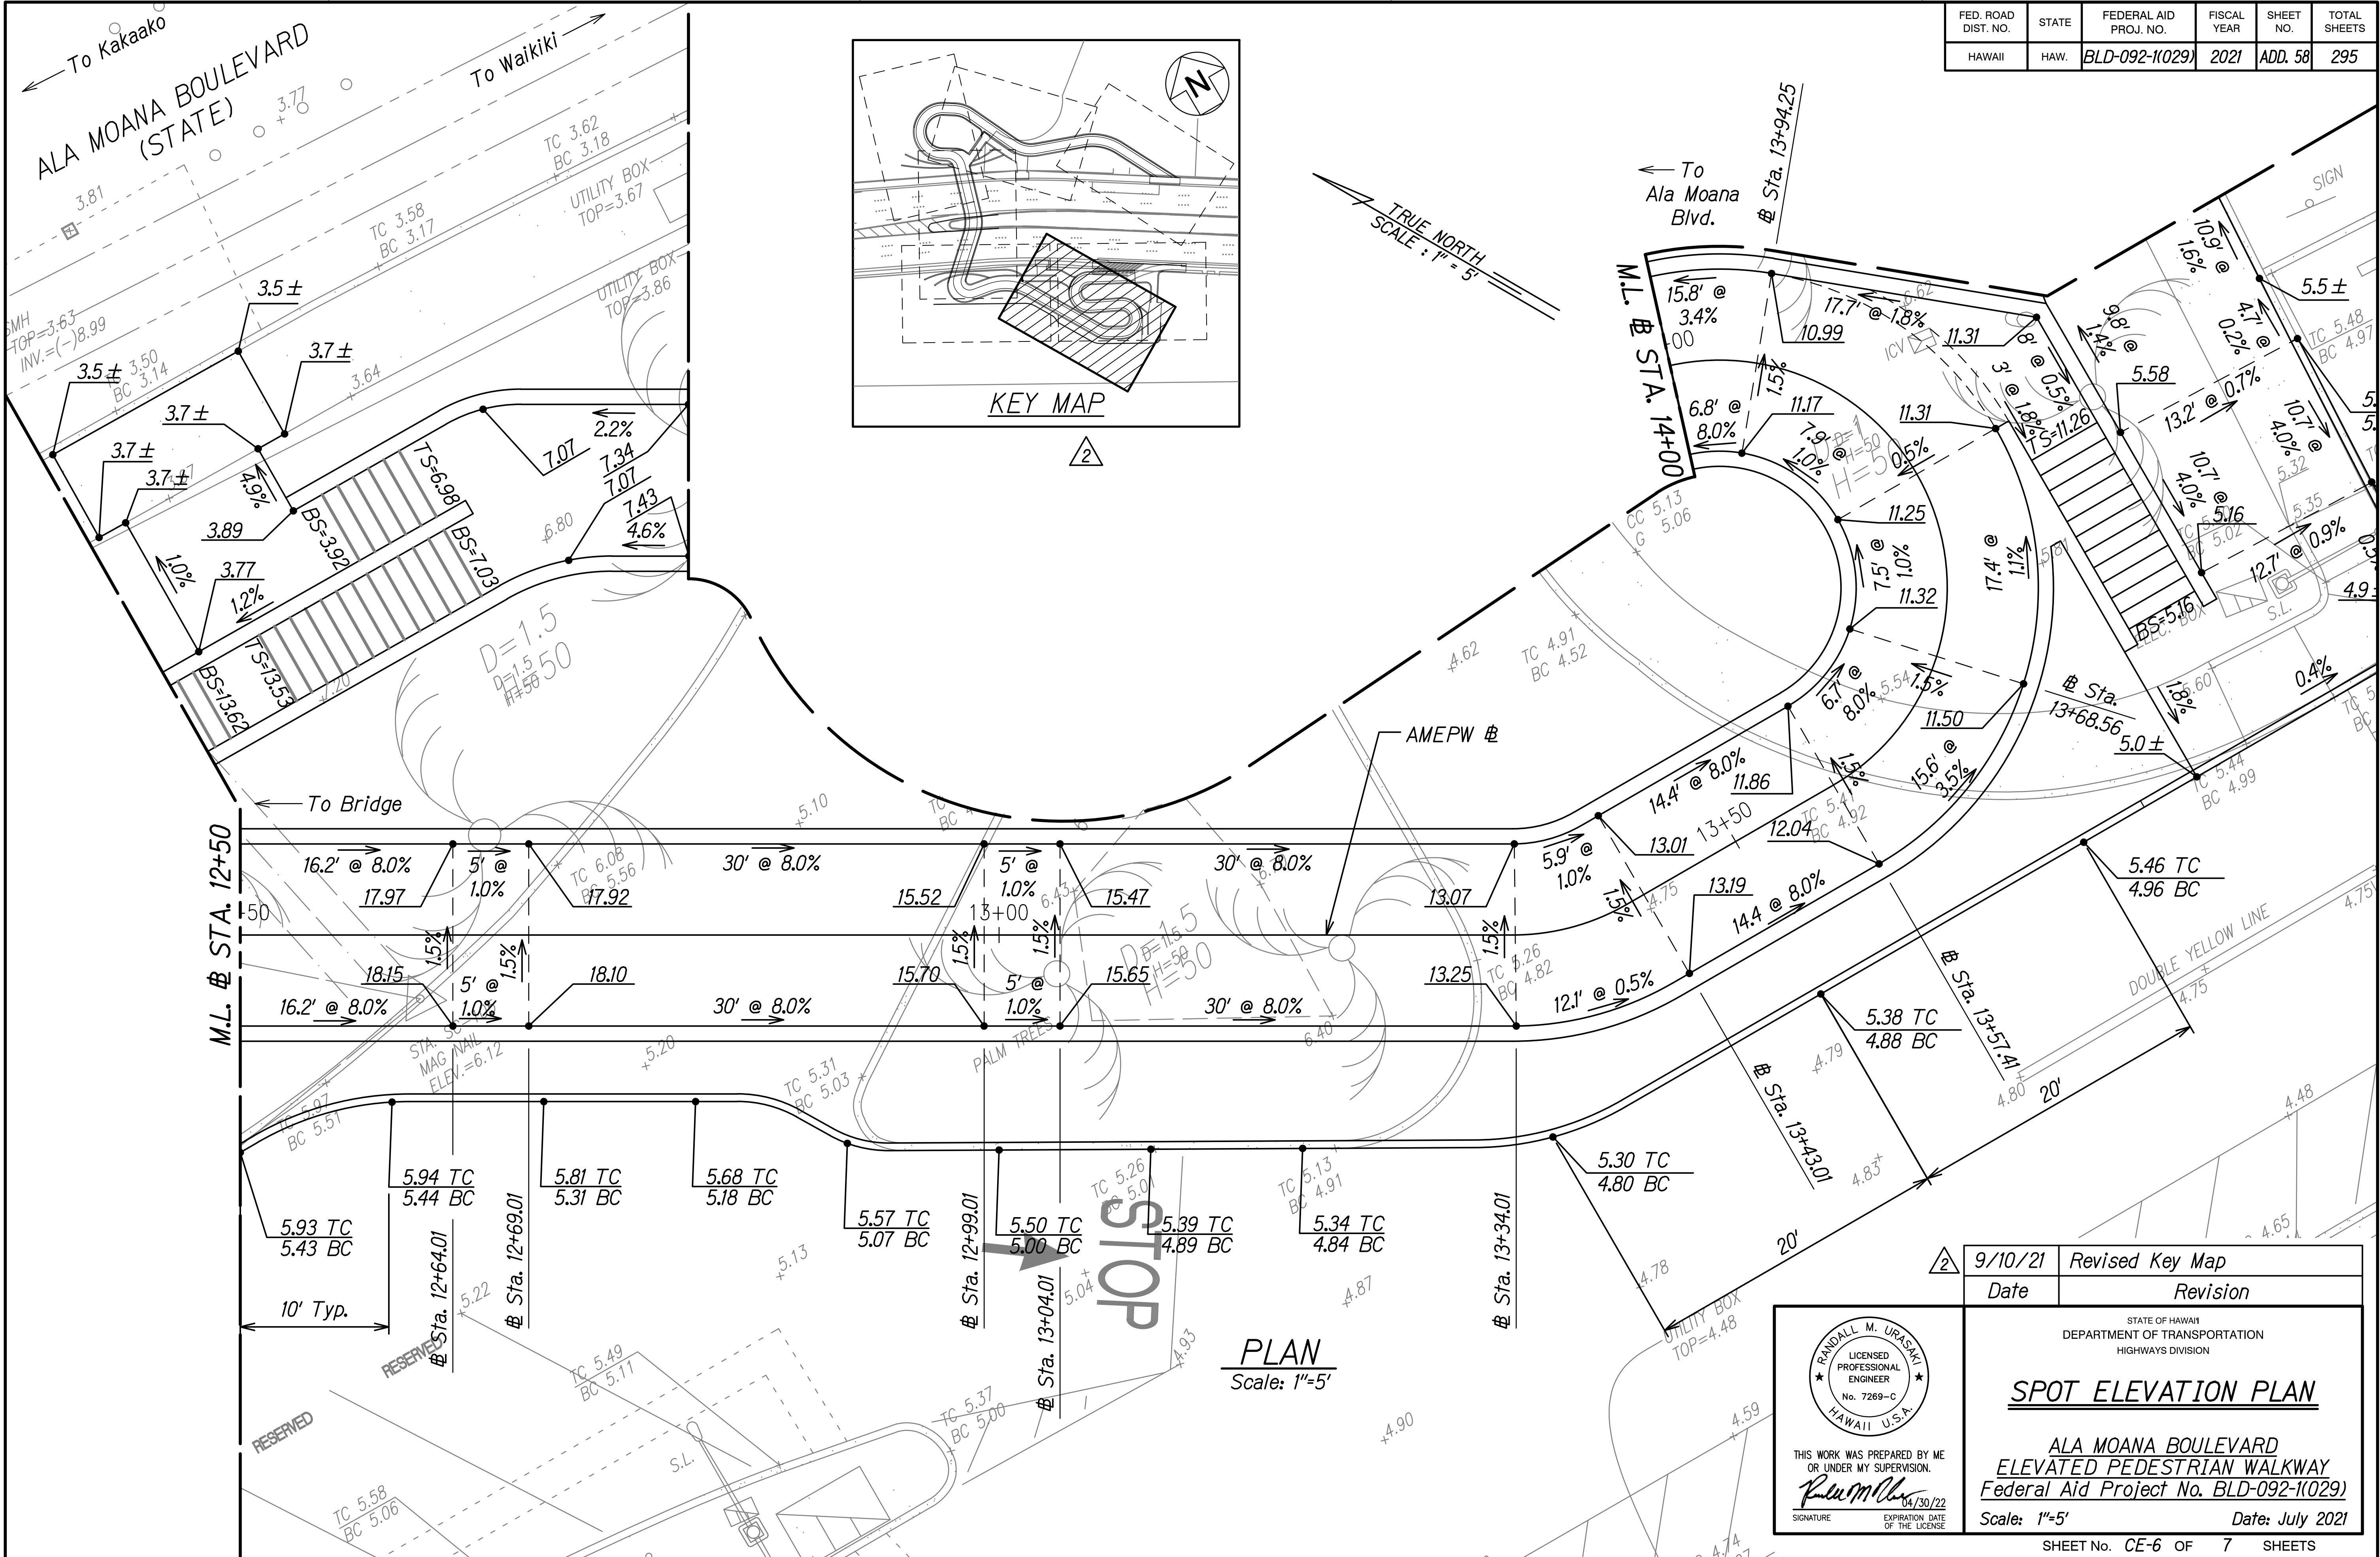

|                   |      |
|-------------------|------|
| ORIGINAL PLAN     | DATE |
| SURVEY PLOTTED BY |      |
| DRAWN BY          |      |
| DESIGNED BY       |      |
| NOTE BOOK         |      |
| QUANTITIES BY     |      |
| CHECKED BY        |      |
| No.               |      |



| FED. ROAD DIST. NO. | STATE | FEDERAL AID PROJ. NO. | FISCAL YEAR | SHEET NO. | TOTAL SHEETS |
|---------------------|-------|-----------------------|-------------|-----------|--------------|
| HAWAII              | HAW.  | BLD-092-1(029)        | 2021        | ADD. 59   | 295          |

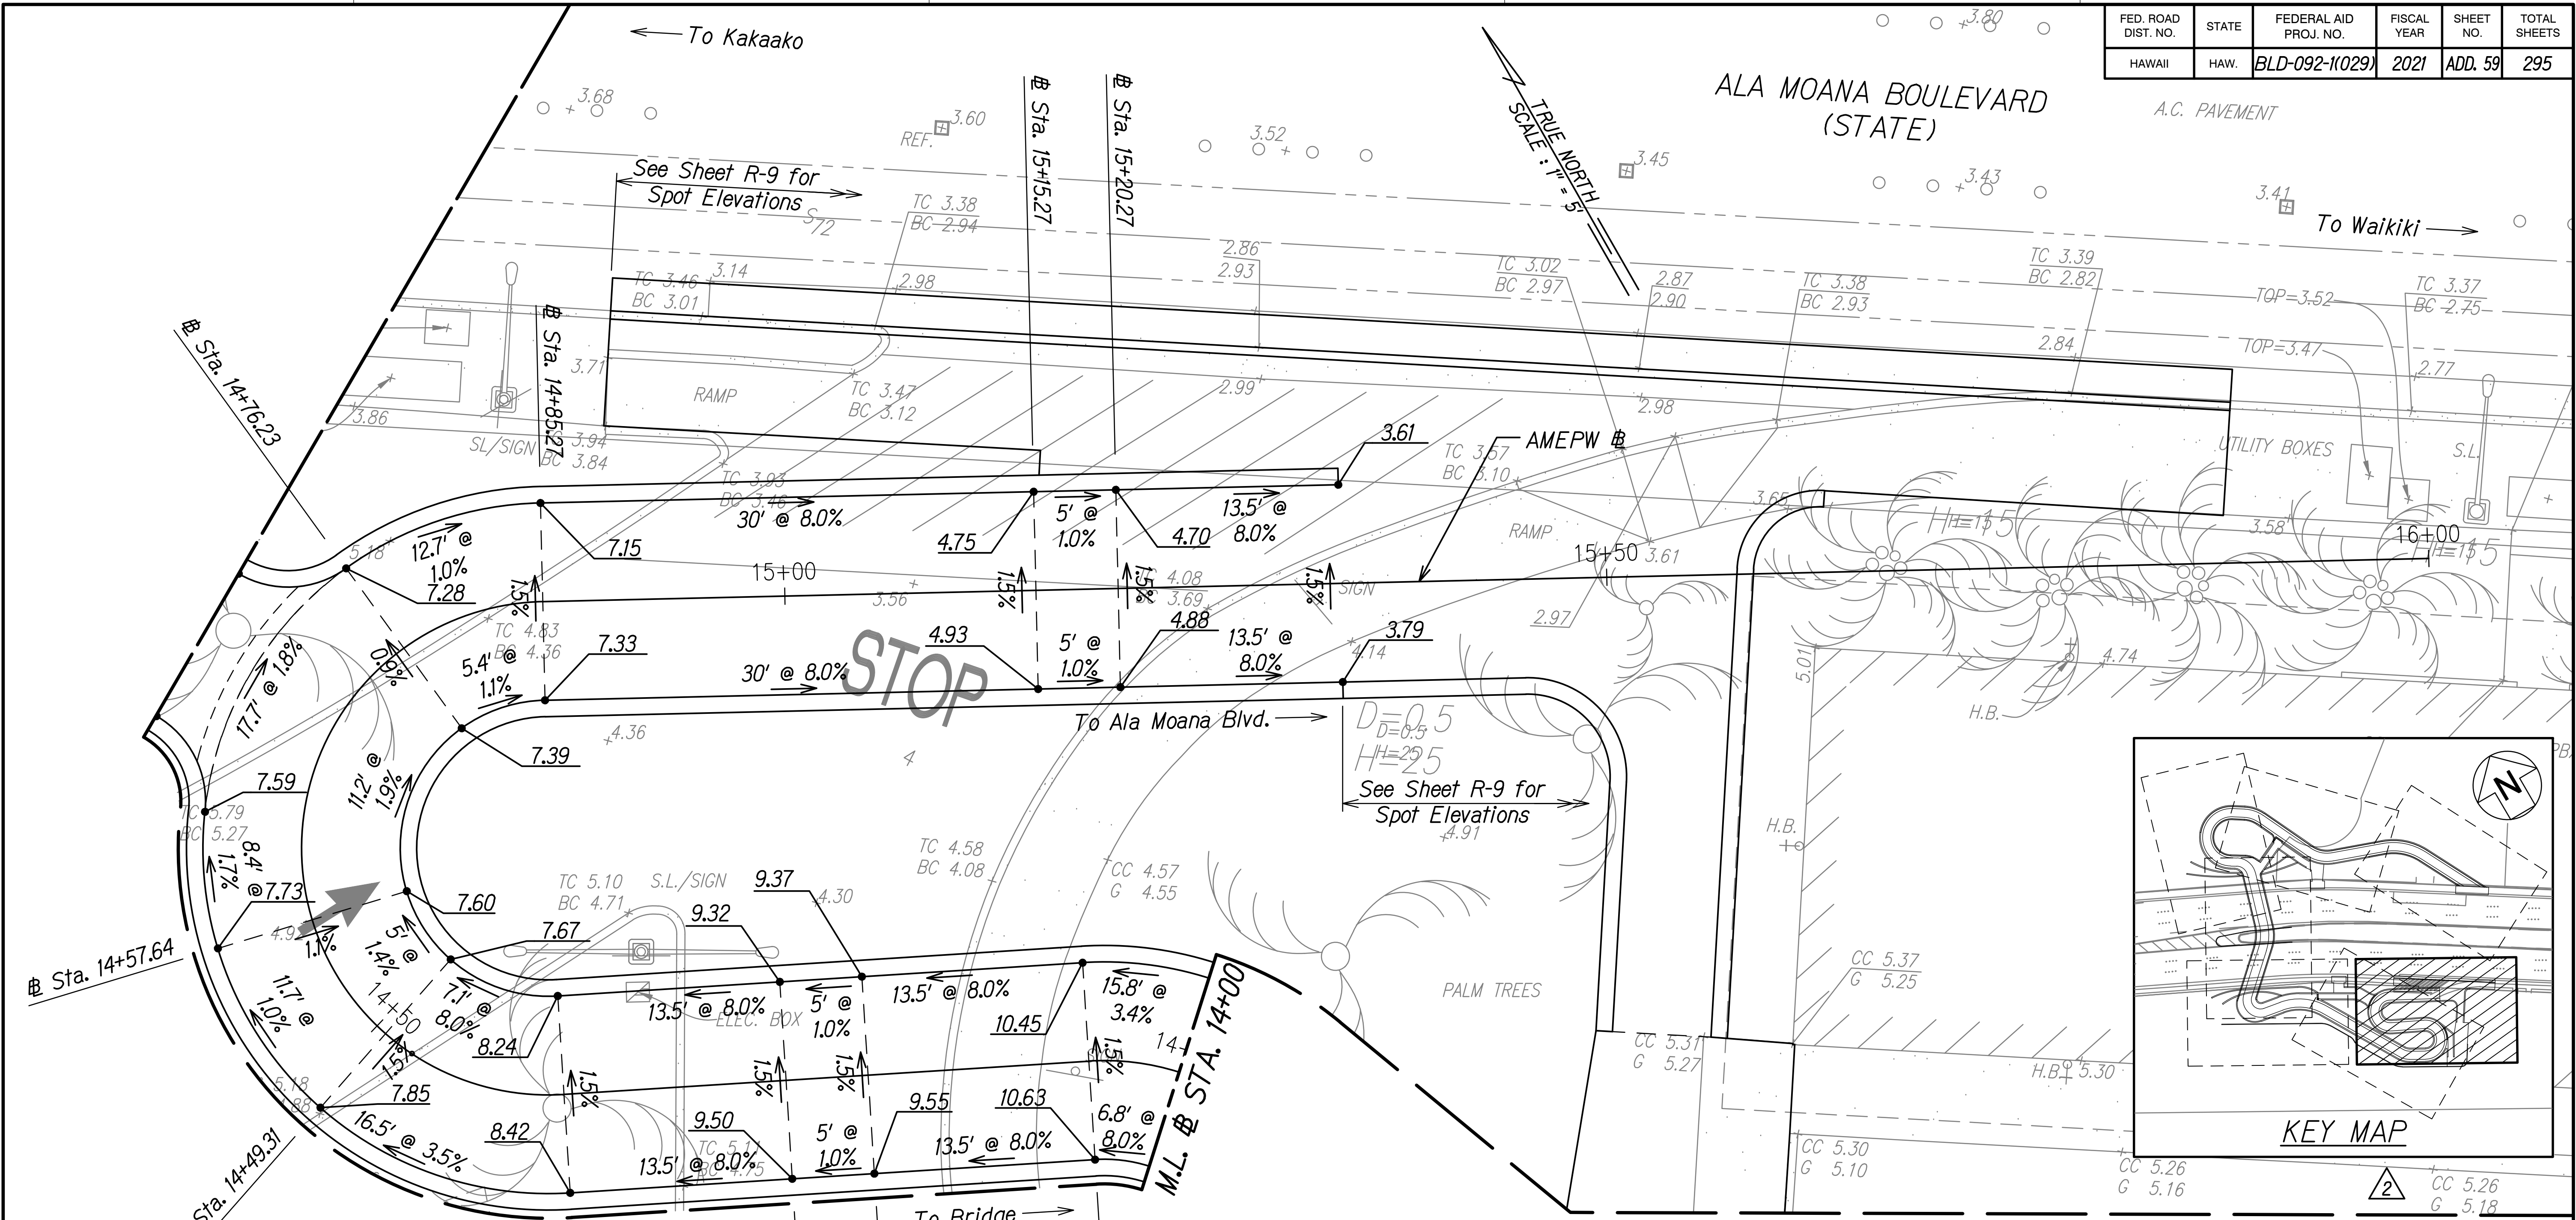

PLAN  
Scale: 1"=5'

|                   |  |
|-------------------|--|
| DATE              |  |
| SURVEY PLOTTED BY |  |
| DRAWN BY          |  |
| DESIGNED BY       |  |
| NOTED BY          |  |
| CHECKED BY        |  |

| Date    | Revision        |
|---------|-----------------|
| 9/10/21 | Revised Key Map |

THIS WORK WAS PREPARED BY ME OR UNDER MY SUPERVISION.

*R. M. Urasaki* 04/30/22

SIGNATURE EXPIRATION DATE OF THE LICENSE

STATE OF HAWAII  
DEPARTMENT OF TRANSPORTATION  
HIGHWAYS DIVISION

**SPOT ELEVATION PLAN**

ALA MOANA BOULEVARD  
ELEVATED PEDESTRIAN WALKWAY  
Federal Aid Project No. BLD-092-1(029)

Scale: 1"=5' Date: July 2021