


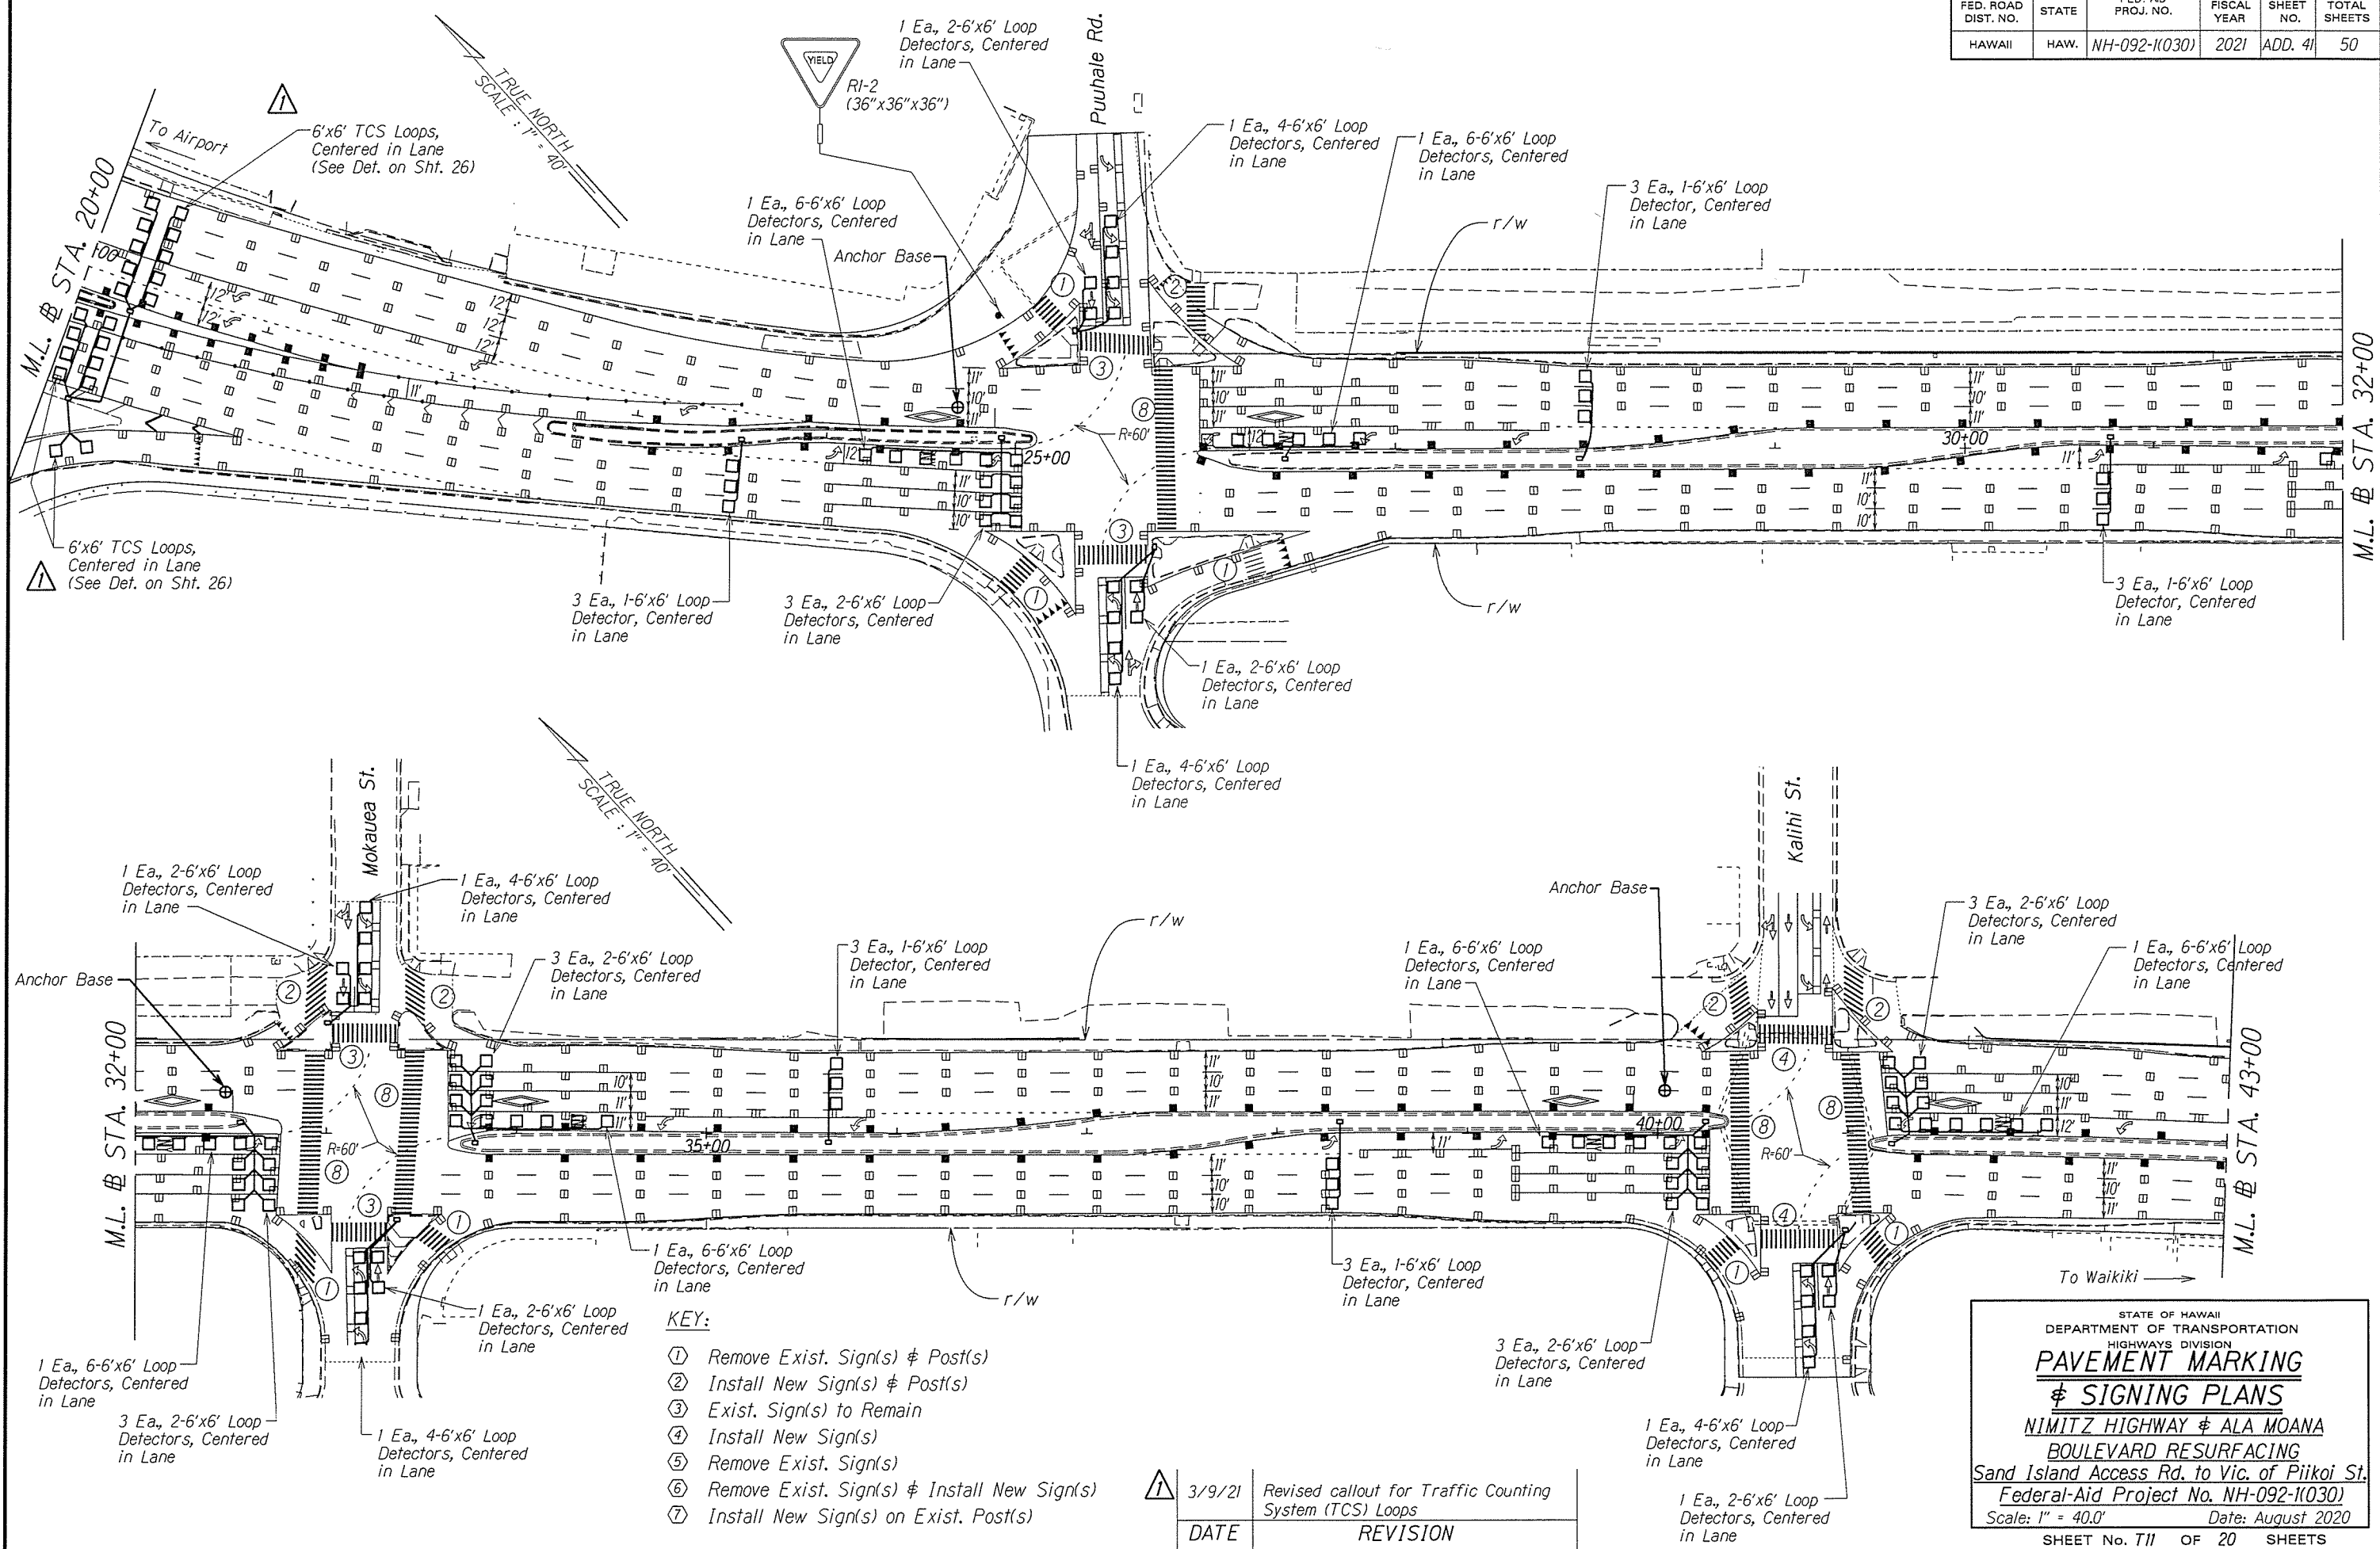


SURVEY PLOTTED BY	DATE
DRAWN BY	
DESIGNED BY	
QUANTITIES BY	
CHECKED BY	
ORIGINAL PLAN	
NOTE BOOK	
Idem	
N.	

3/9/21	Revised callout for Traffic Counting System (TCS) Loops
DATE	REVISION

STATE OF HAWAII
DEPARTMENT OF TRANSPORTATION
HIGHWAYS DIVISION
**PAVEMENT MARKING
& SIGNING PLANS**
NIMITZ HIGHWAY & ALA MOANA
BOULEVARD RESURFACING
Sand Island Access Rd. to Vic. of Piikoi St.
Federal-Aid Project No. NH-092-1(030)
Scale: 1" = 40.0' Date: August 2020
SHEET No. 711 OF 20 SHEETS

FED. ROAD DIST. NO.	STATE	FED. AID PROJ. NO.	FISCAL YEAR	SHEET NO.	TOTAL SHEETS
HAWAII	HAW.	NH-092-1(030)	2021	ADD. 46	50

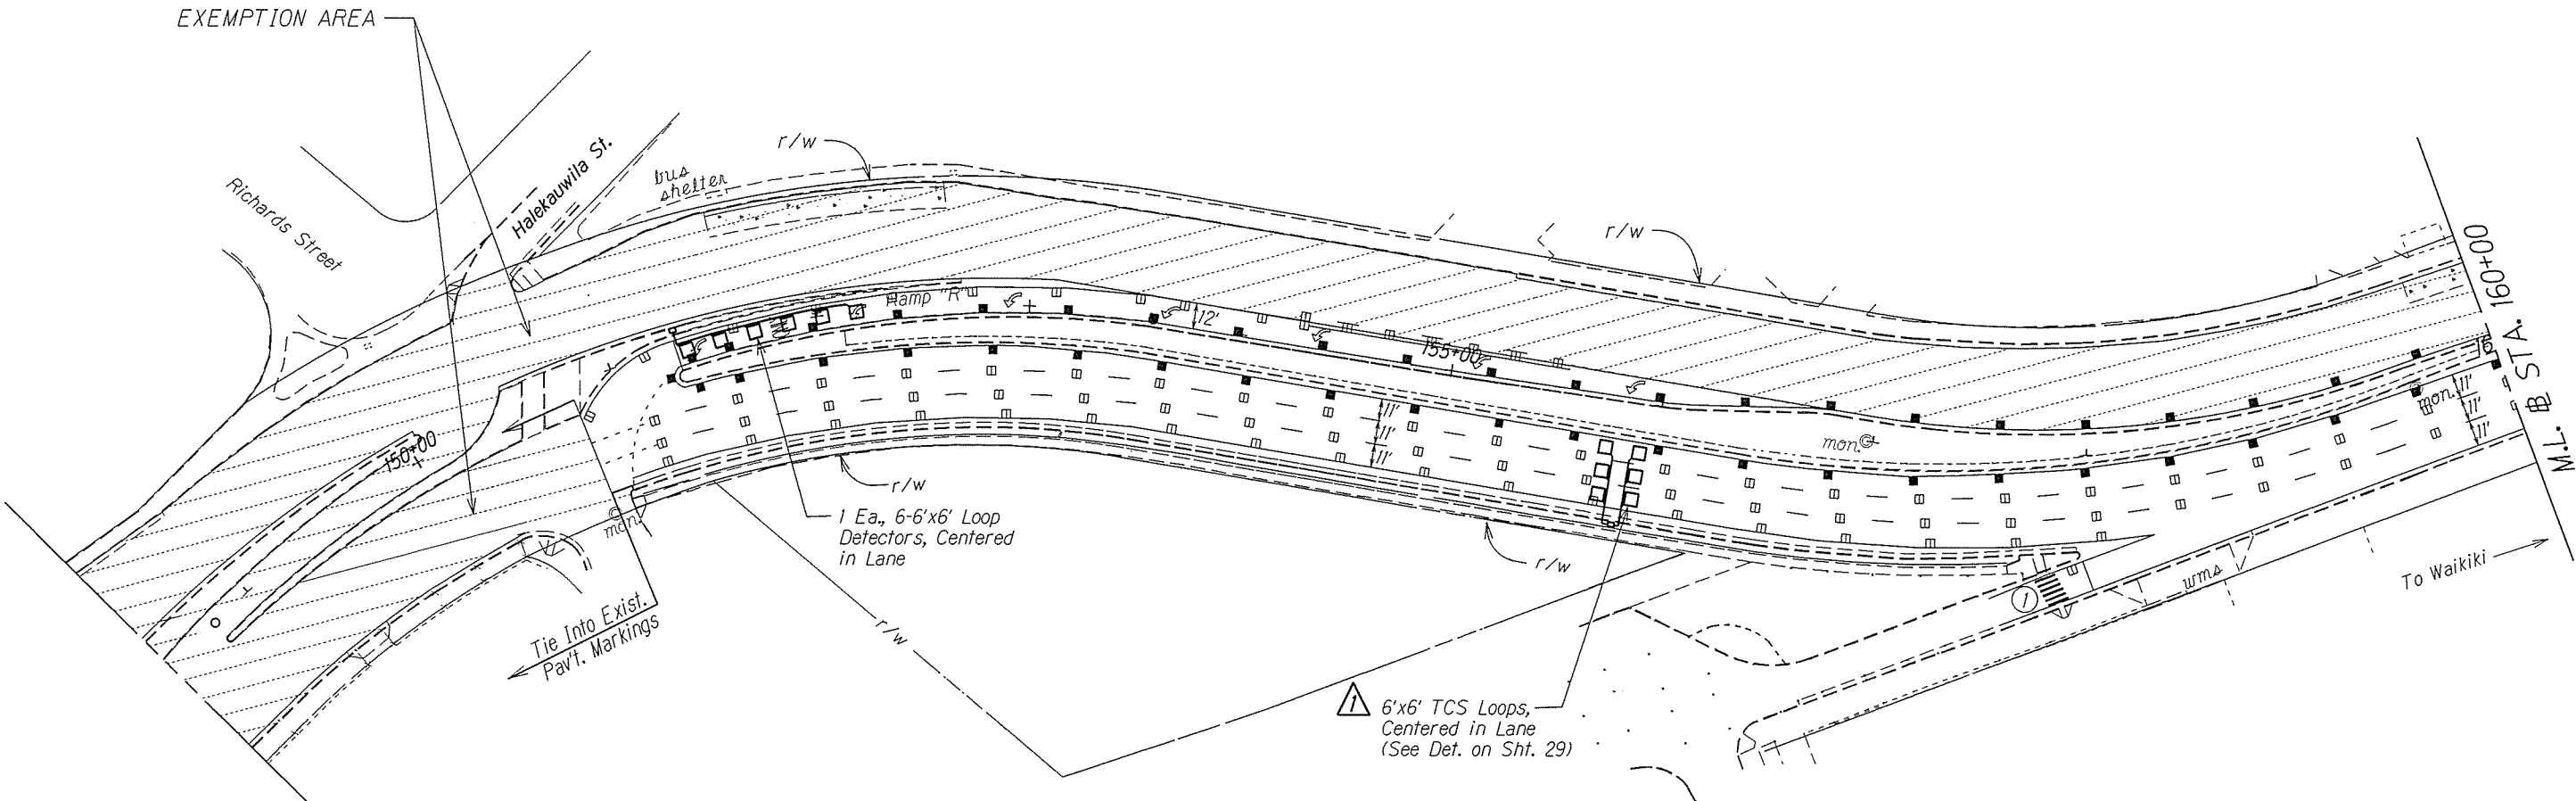

ORIGINAL PLAN	SURVEY PLOTTED BY	DATE
NOTE BOOK	DRAWN BY	
10/20/20	DESIGNED BY	
10/20/20	QUANTITIES BY	
10/20/20	CHECKED BY	

	3/9/21	Revised Callout for Traffic Counting System (TCS) Loops
	DATE	REVISION

STATE OF HAWAII
DEPARTMENT OF TRANSPORTATION
HIGHWAYS DIVISION

PAVEMENT MARKING

& SIGNING PLANS

NIMITZ HIGHWAY & ALA MOANA

BOULEVARD RESURFACING

Sand Island Access Rd. to Vic. of Piikoi St.
Federal-Aid Project No. NH-092-1(030)

Scale: 1" = 40.0' Date: August, 2020

SHEET No. T16 OF 20 SHEETS