

INDEX TO DRAWINGS	
SHEET NO.	DESCRIPTION
1	TITLE SHEET
2	STANDARD PLANS SUMMARY
3 - 4	GENERAL NOTES AND LEGEND
5 - 6	UTILITY NOTES
7 - 9	WATER POLLUTION & EROSION CONTROL NOTES
10	TYPICAL SECTION
11 - 12	RECONSTRUCTION SCHEDULE
13 - 24	ROADWAY PLANS
25 - 30	TRAFFIC COUNTING SYSTEM PLANS
31 - 50	TRAFFIC PLANS



STATE OF HAWAII
DEPARTMENT OF TRANSPORTATION
HIGHWAYS DIVISION
HONOLULU, HAWAII
As-Built
PLANS FOR
**NIMITZ HIGHWAY & ALA MOANA BOULEVARD RESURFACING
SAND ISLAND ACCESS ROAD TO VICINITY OF PIKOI STREET
FEDERAL-AID PROJECT NO. NH-092-1(030)**

DISTRICT OF HONOLULU
ISLAND OF OAHU


CHANGES MADE DURING CONSTRUCTION HAVE
BEEN INCORPORATED ON THESE PLANS EXCEPT
CHANGES IN THE ORIGINAL THEORETICAL
QUANTITIES. FOR ACTUAL QUANTITIES, REFER TO
PROJECT LEDGER AND/OR COMPUTATION BOOK.

 Jan 11, 2024
RESIDENT ENGINEER DATE

FED. ROAD DIST. NO.	STATE	FED. AID PROJ. NO.	FISCAL YEAR	SHEET NO.	TOTAL SHEETS
HAWAII	HAW.	NH-092-1(030)	2021	1	50

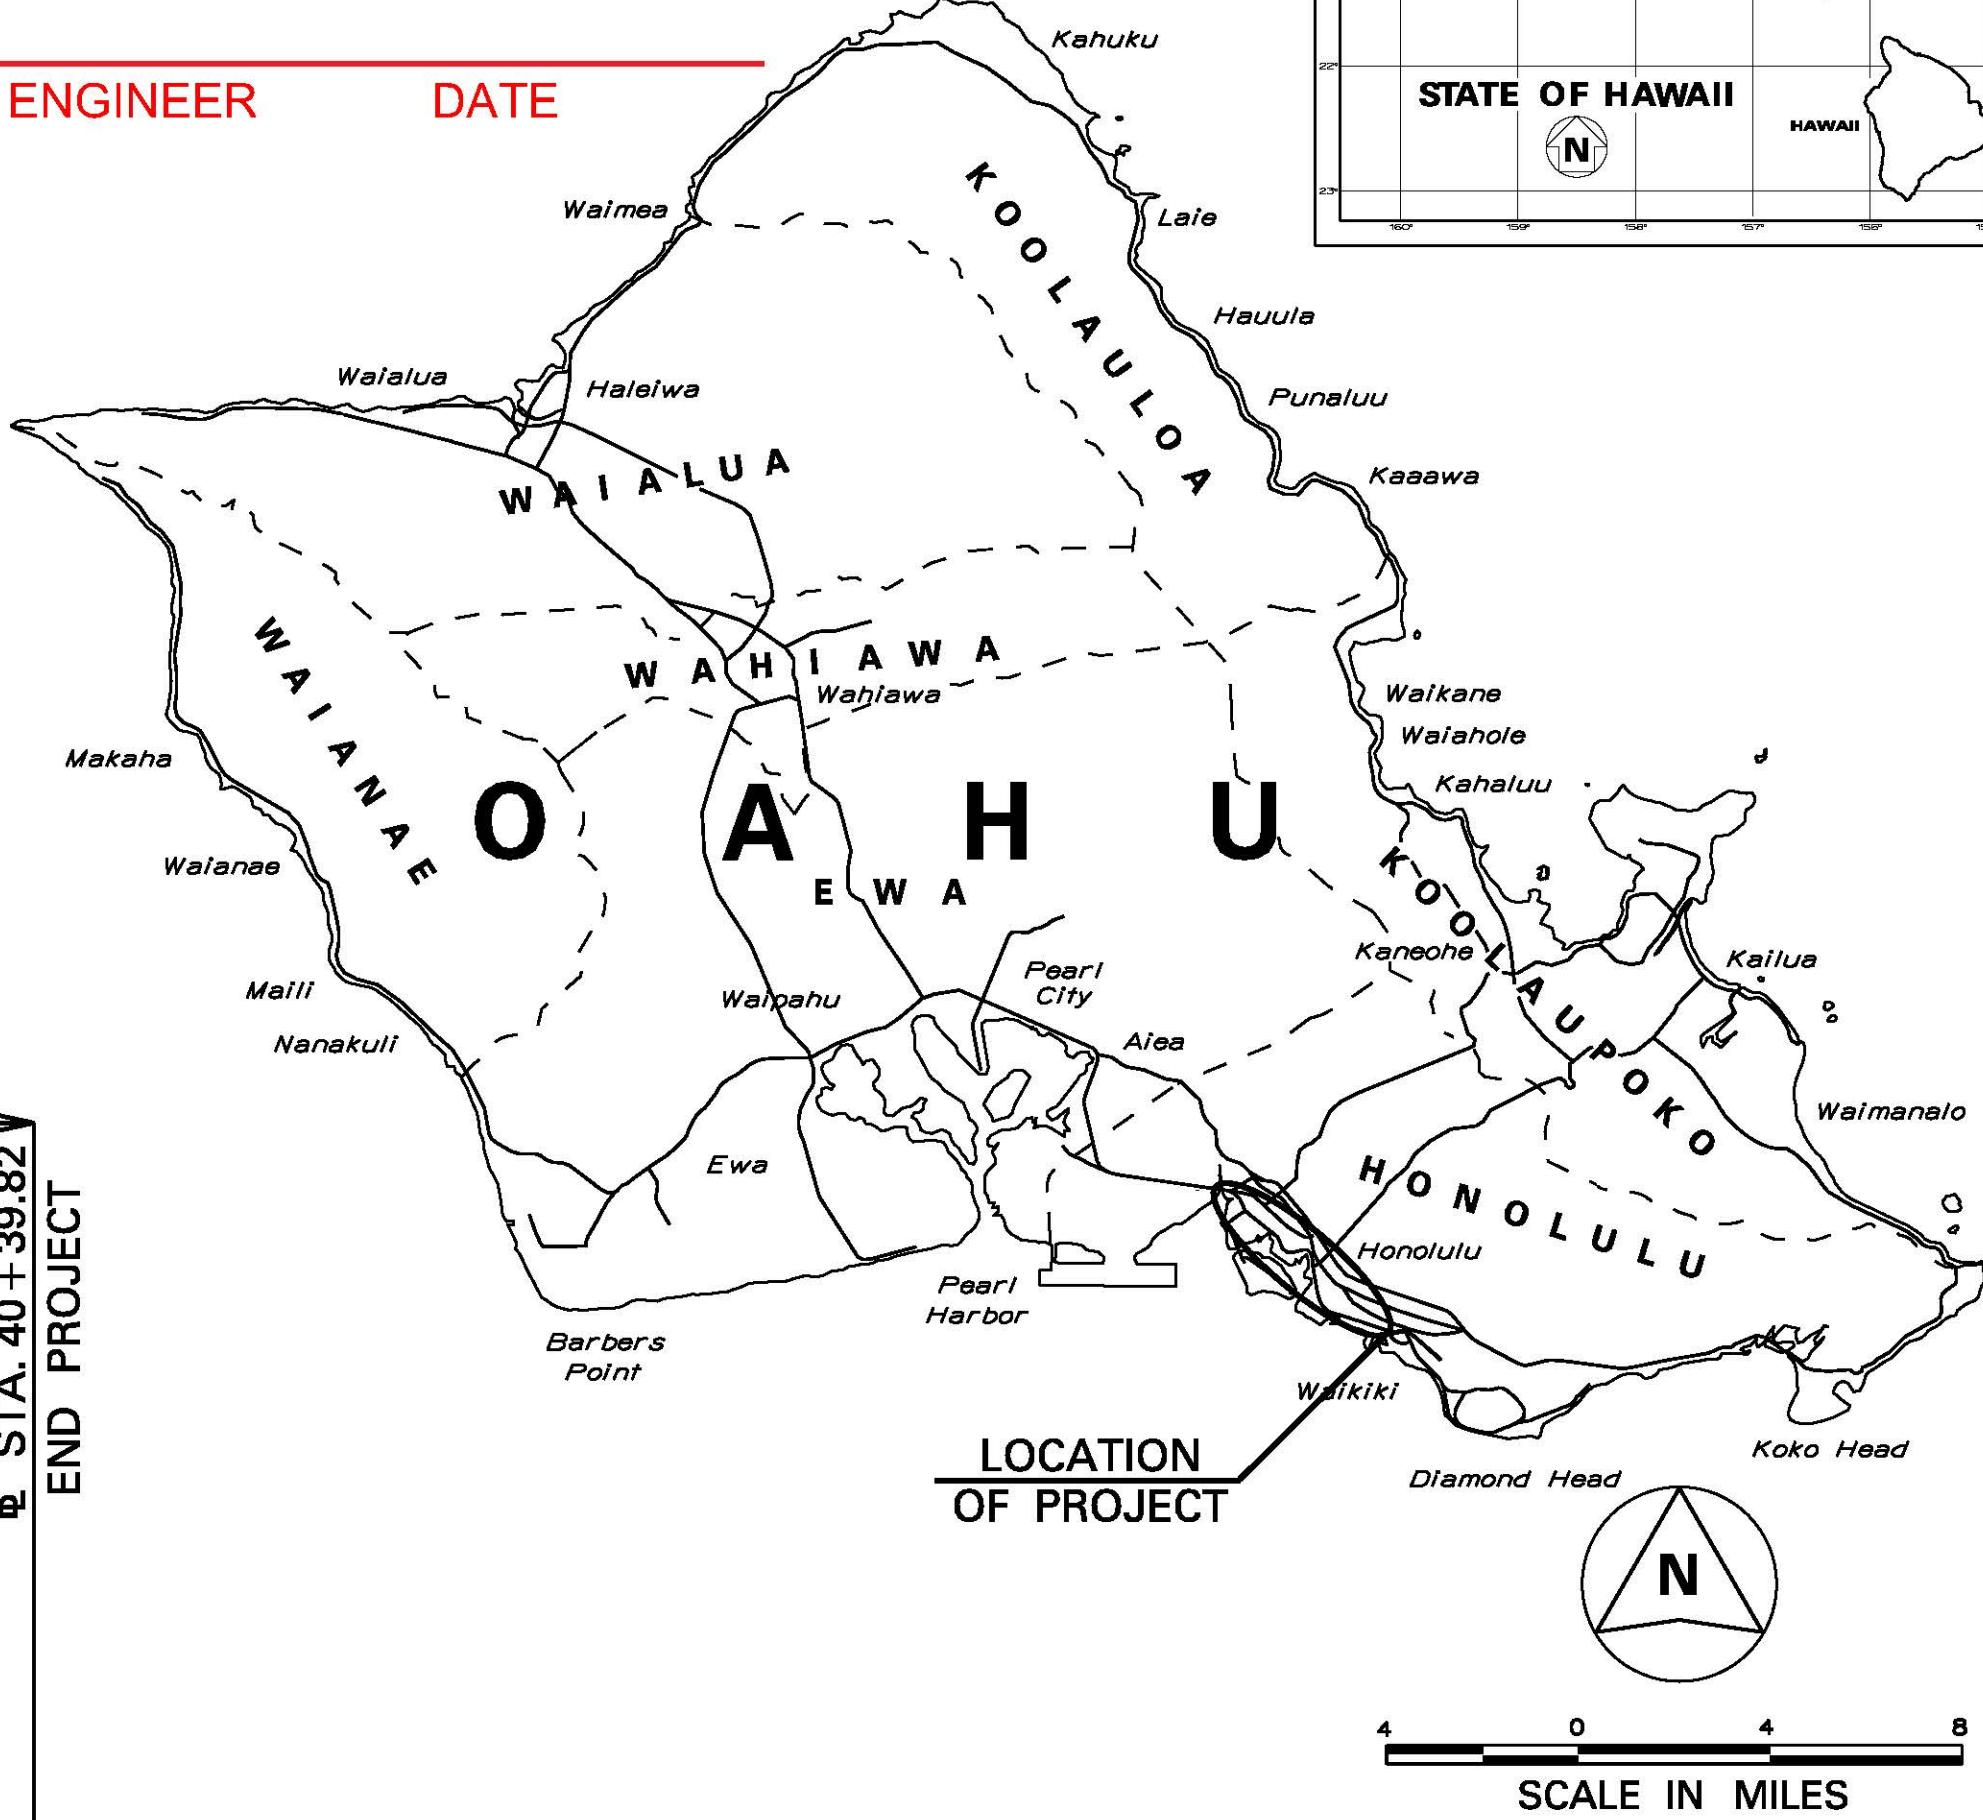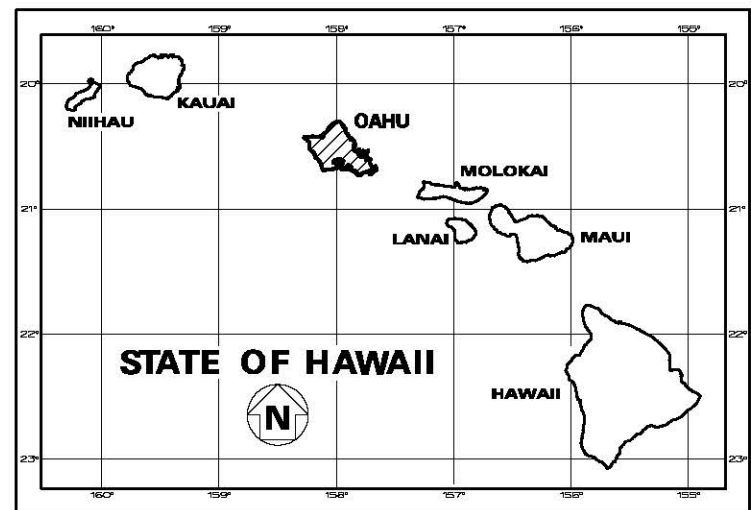

LOCATION
OF PROJECT

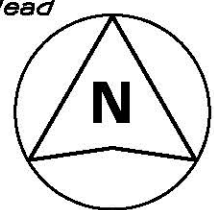


SCALE IN MILES
0 4 8

MILE POST 3.99 TO MILE POST 8.16

DESIGN DESIGNATION	NIMITZ HIGHWAY, ROUTE 92			
	KALIHI STREAM BRIDGE TO SAND ISLAND ACCESS ROAD, (MP 3.66 TO 3.99)	SAND ISLAND ACCESS ROAD TO WAIKAMULO ROAD, (MP 3.99 TO 4.68)	WAIKAMULO ROAD TO BISHOP STREET, (MP 4.68 TO 6.38)	
ADT (2018)	82,200	68,200	75,700	
ADT (2028)	86,200	71,600	79,400	
DHV	6,900	5,730	6,750	
K	8.0	8.0	8.5	
T	7.5	10.0	11.0	
T ₂₄	10.0	11.5	9.0	

DESIGN DESIGNATION	ALA MOANA BOULEVARD, ROUTE 92			
	BISHOP STREET TO WARD AVENUE, (MP 6.38 TO 7.39)	WARD AVENUE TO PIKOI STREET, (MP 7.39 TO 8.10)	PIKOI STREET TO ATKINSON DRIVE (MP 8.10 TO 8.53)	
ADT (2018)	64,700	56,300	51,600	
ADT (2028)	67,900	59,100	54,200	
DHV	5,430	4,730	4,340	
K	8.0	8.0	8.0	
T	11.0	8.0	8.0	
T ₂₄	11.0	9.5	9.0	

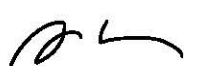DEPARTMENT OF TRANSPORTATION
STATE OF HAWAII
APPROVED:
 Jan 14, 2021
DIR. OF TRANSPORTATION DATE

