	INDEX TO DRAWINGS	
SHEET NO.	DESCRIPTION	
	TITLE SHEET	
2	GENERAL NOTES AND PRESERVING & ADJUSTMENT OF MONUMENTS	
<b>33</b>	TYPICAL SECTIONS AND PLAN OF ROADWAY	
4	PAVEMENT MARKERS	
5	SIGN INSTALLATION	
6	STREET NAME SIGNS	
7 - 14	STANDARD DETAILS	
1		

April, 1981 DATE

548-4125 PHONE

UNIT "E" DESIGNED BY



STATE OF HAWAII

## DEPARTMENT OF TRANSPORTATION HIGHWAYS DIVISION

HONOLULU, HAWAII

AS BUILT


PLANS FOR

## ALA MOANA BOULEVARD RESURFACING

ENA ROAD TO KALAKAUA AVENUE


FEDERAL AID PROJECT NO. FR-092-1(17)

DISTRICT OF HONOLULU ISLAND OF OAHU

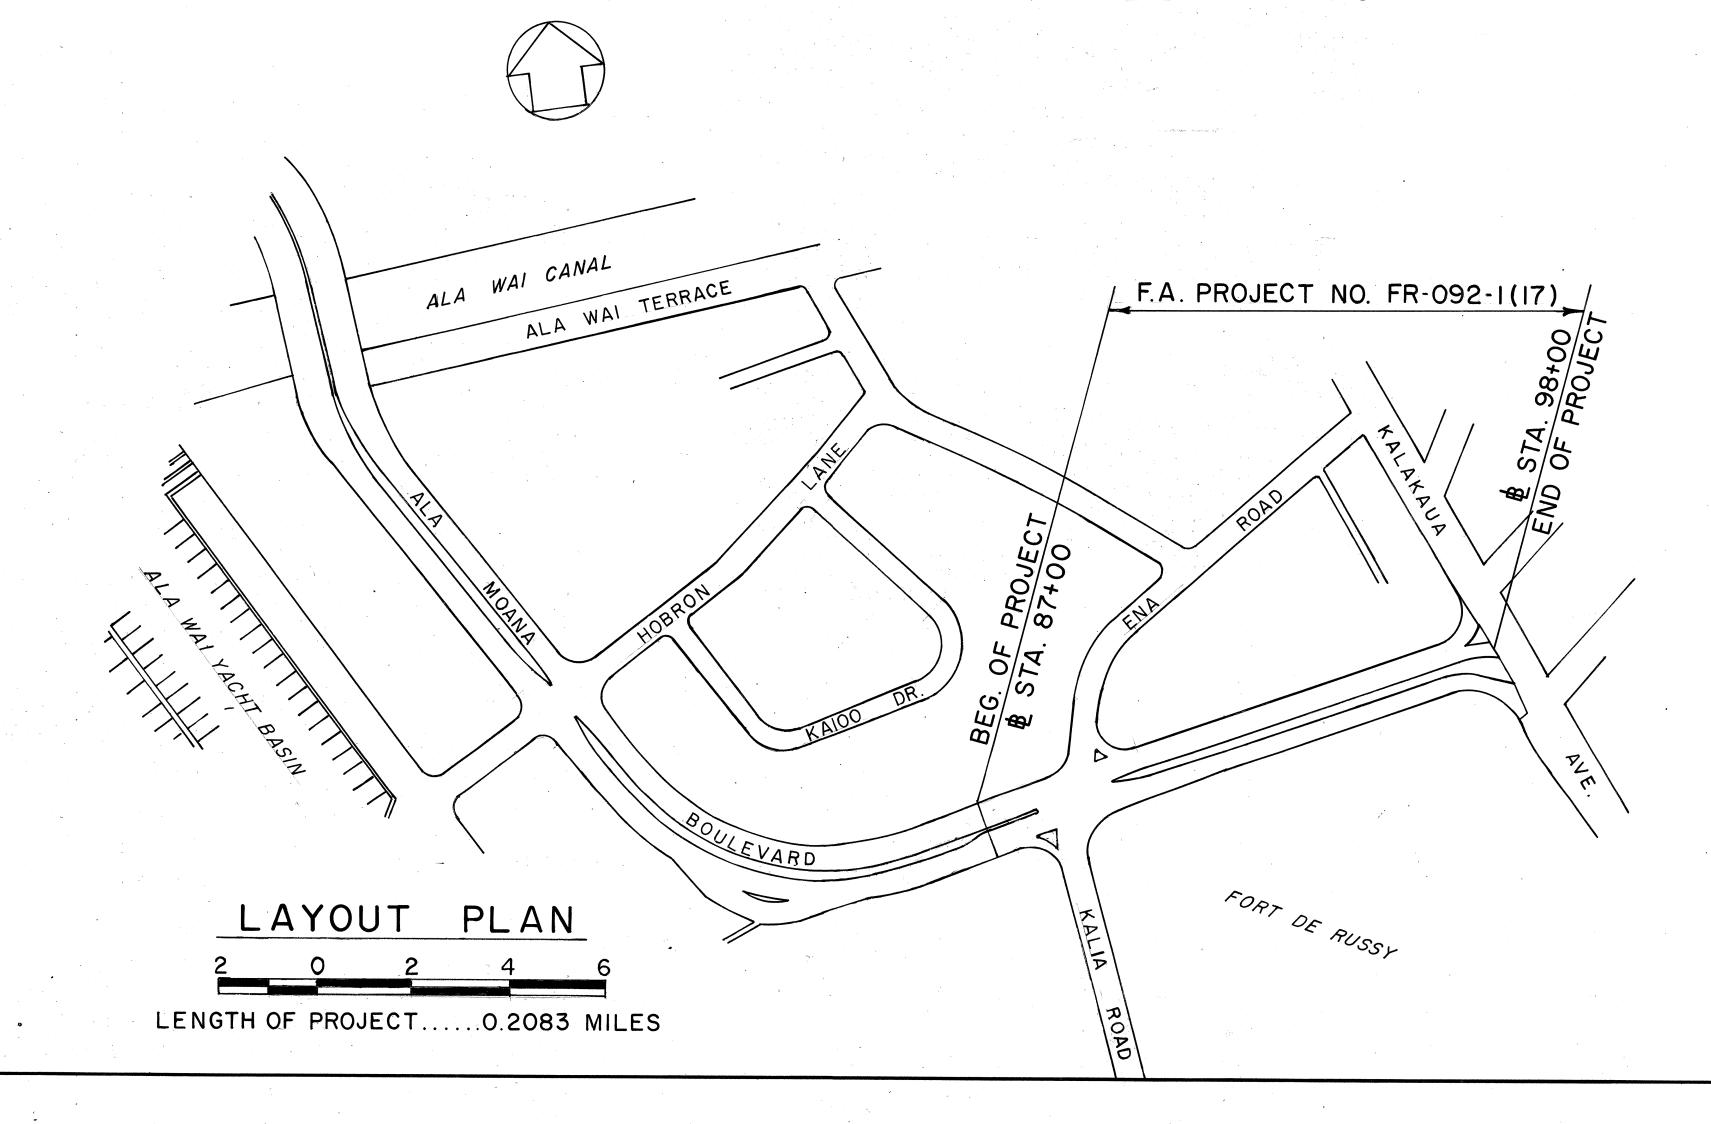

FED. ROAD DIST. NO. STATE PROJ. NO. FISCAL SHEET TOTAL SHEETS

HAWAII HAW. FR-092-1(17) 1981 1 14

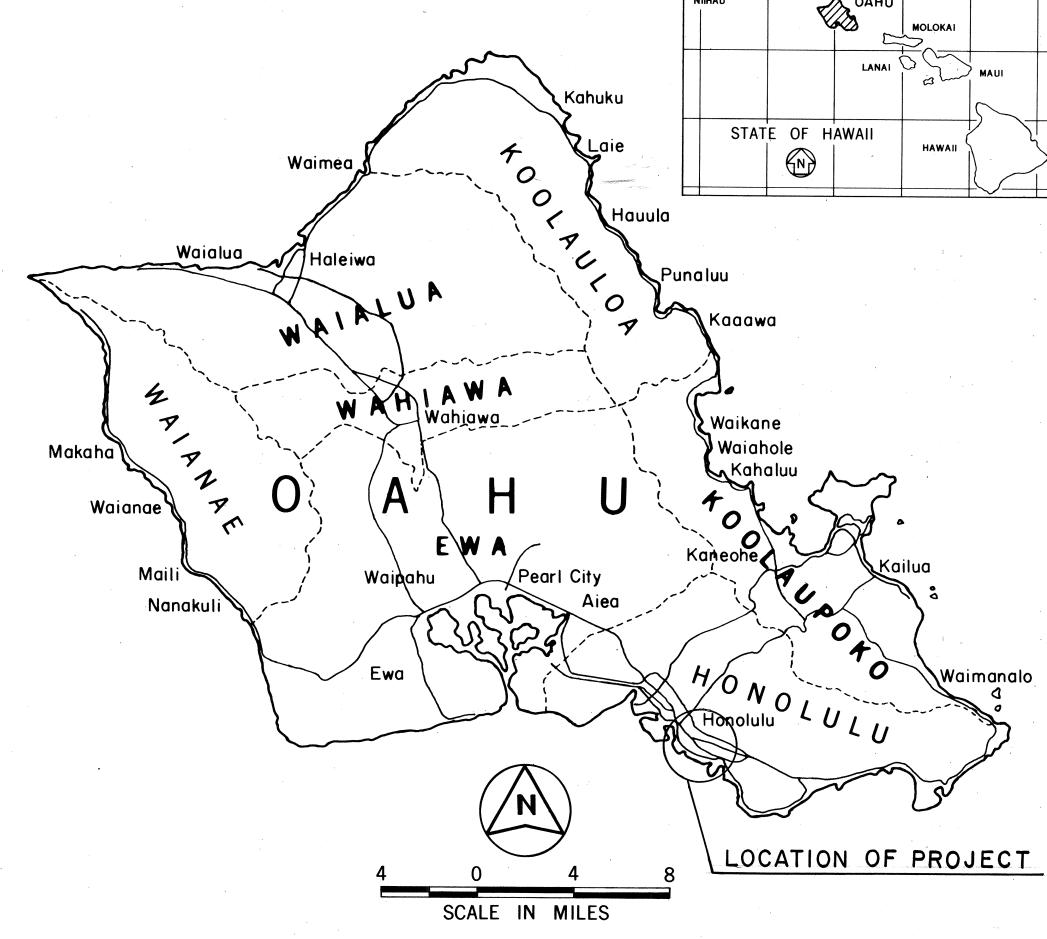

DESIGN	DESIGNATION		
CURRENT ADT (1980) 56,090			
DESIGN ADT (2000) 71,400			
	<b>3,</b> 590		
D	55/45		
T	2.0%		
$T_{24}$	3.0%		
Κ	5.0%		

ALL CHANGES MADE DURING CONSTRUCTION HAVE BEEN INCORPORATED ON THESE PLANS IN RED EXCEPT CHANGES IN THE ORIGINAL THEORETICAL QUANTITIES, FOR ACTUAL QUANTITIES, REFER TO PROJECT LEDGER AND/OR COMPUTATION BOOK.



DEPARTMENT OF TRANSPORTATION
FEDERAL HIGHWAY ADMINISTRATION

APPROVED:

APPRO

DEPARTMENT OF TRANSPORTATION
STATE OF HAWAII

APPROVED:

Lames K. Carras G/R/B

3