


INDEX TO DRAWINGS	
SHEET NO.	DESCRIPTION
1	TITLE SHEET
2	GENERAL NOTES AND TYPICAL SECTIONS
3	PLAN
4	PRESERVING & ADJUSTMENT OF MONUMENT DETAIL
5	PAVEMENT MARKINGS, SIGNS, AND WHEELCHAIR RAMPS
6	ADVANCE STREET NAME SIGN
7 - 14	STANDARD DETAILS
15 - 16	TYPICAL DETAILS OF WHEEL CHAIR RAMPS

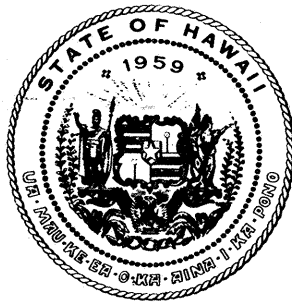

STATE OF HAWAII

DEPARTMENT OF TRANSPORTATION

HIGHWAYS DIVISION

HONOLULU, HAWAII

"AS-BUILT"

PLANS FOR

ALA MOANA BOULEVARD

RESURFACING




ALA WAI CANAL TO ENA ROAD

PROJECT NO. 92A-01-82M

DISTRICT OF HONOLULU

ISLAND OF OAHU

FED. ROAD DIST. NO.	STATE	PROJ. NO.	FISCAL YEAR	SHEET NO.	TOTAL SHEETS
HAWAII	HAW.	92A-01-82M	1982	1	16

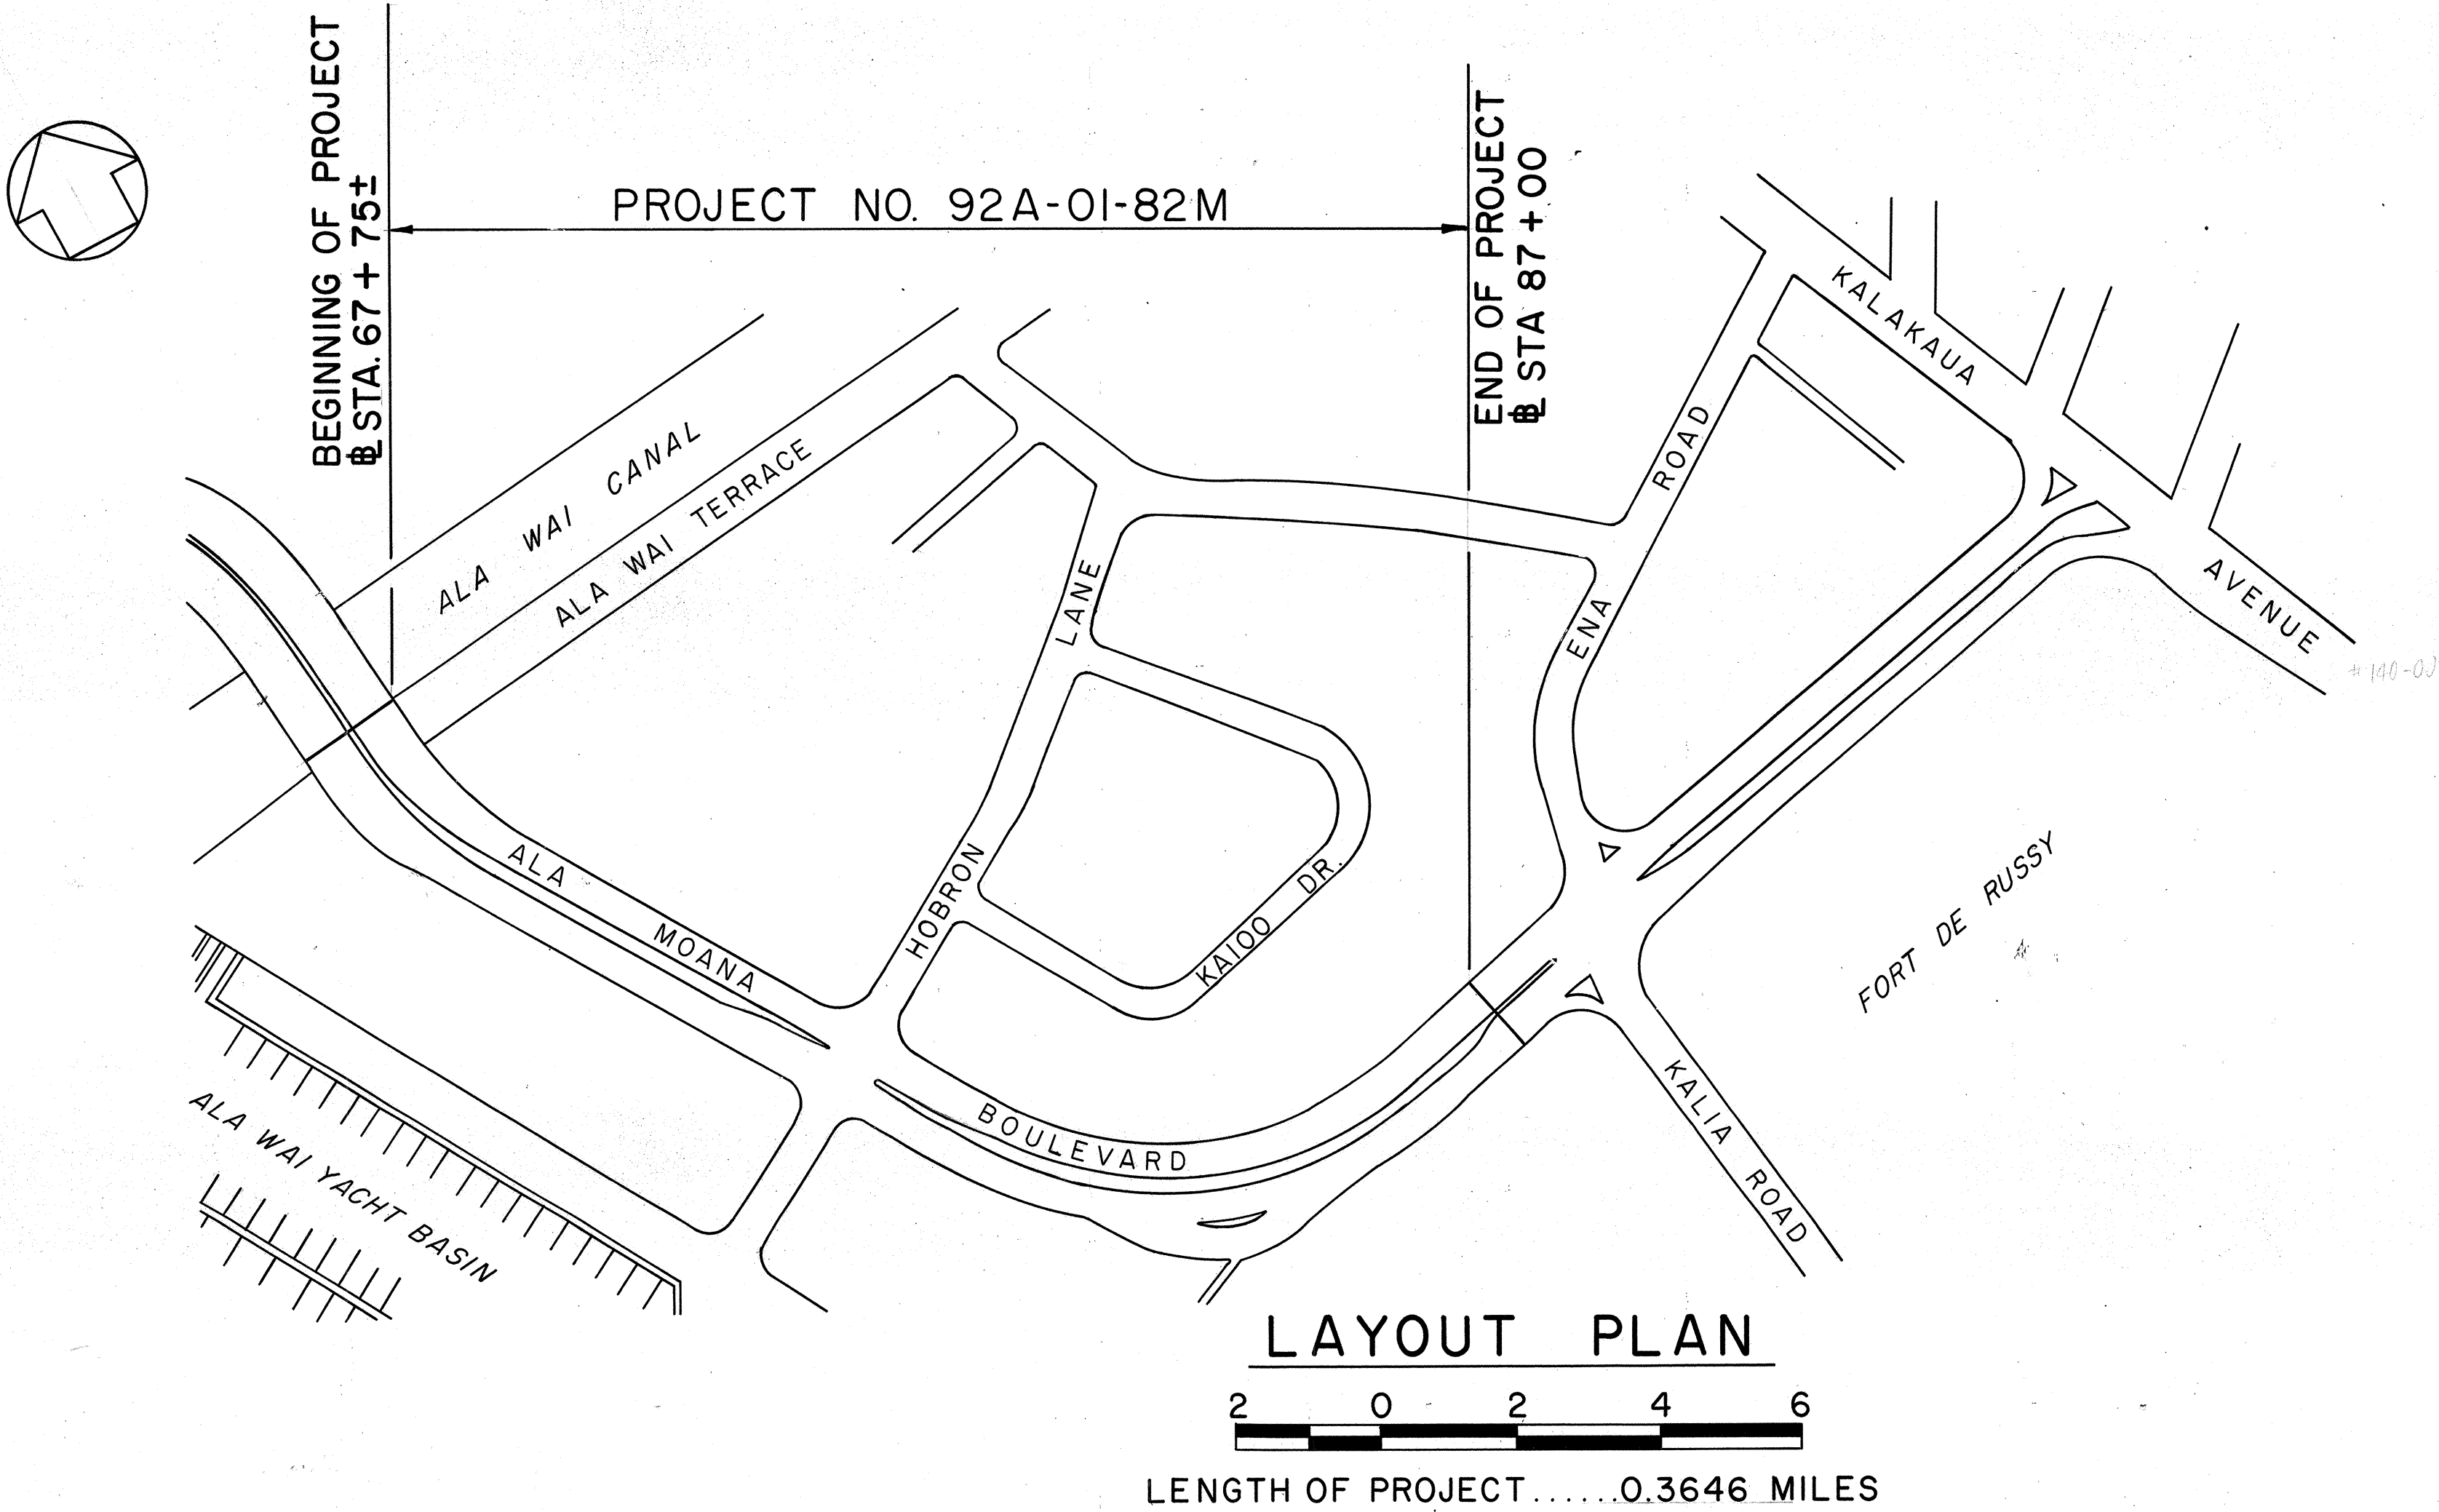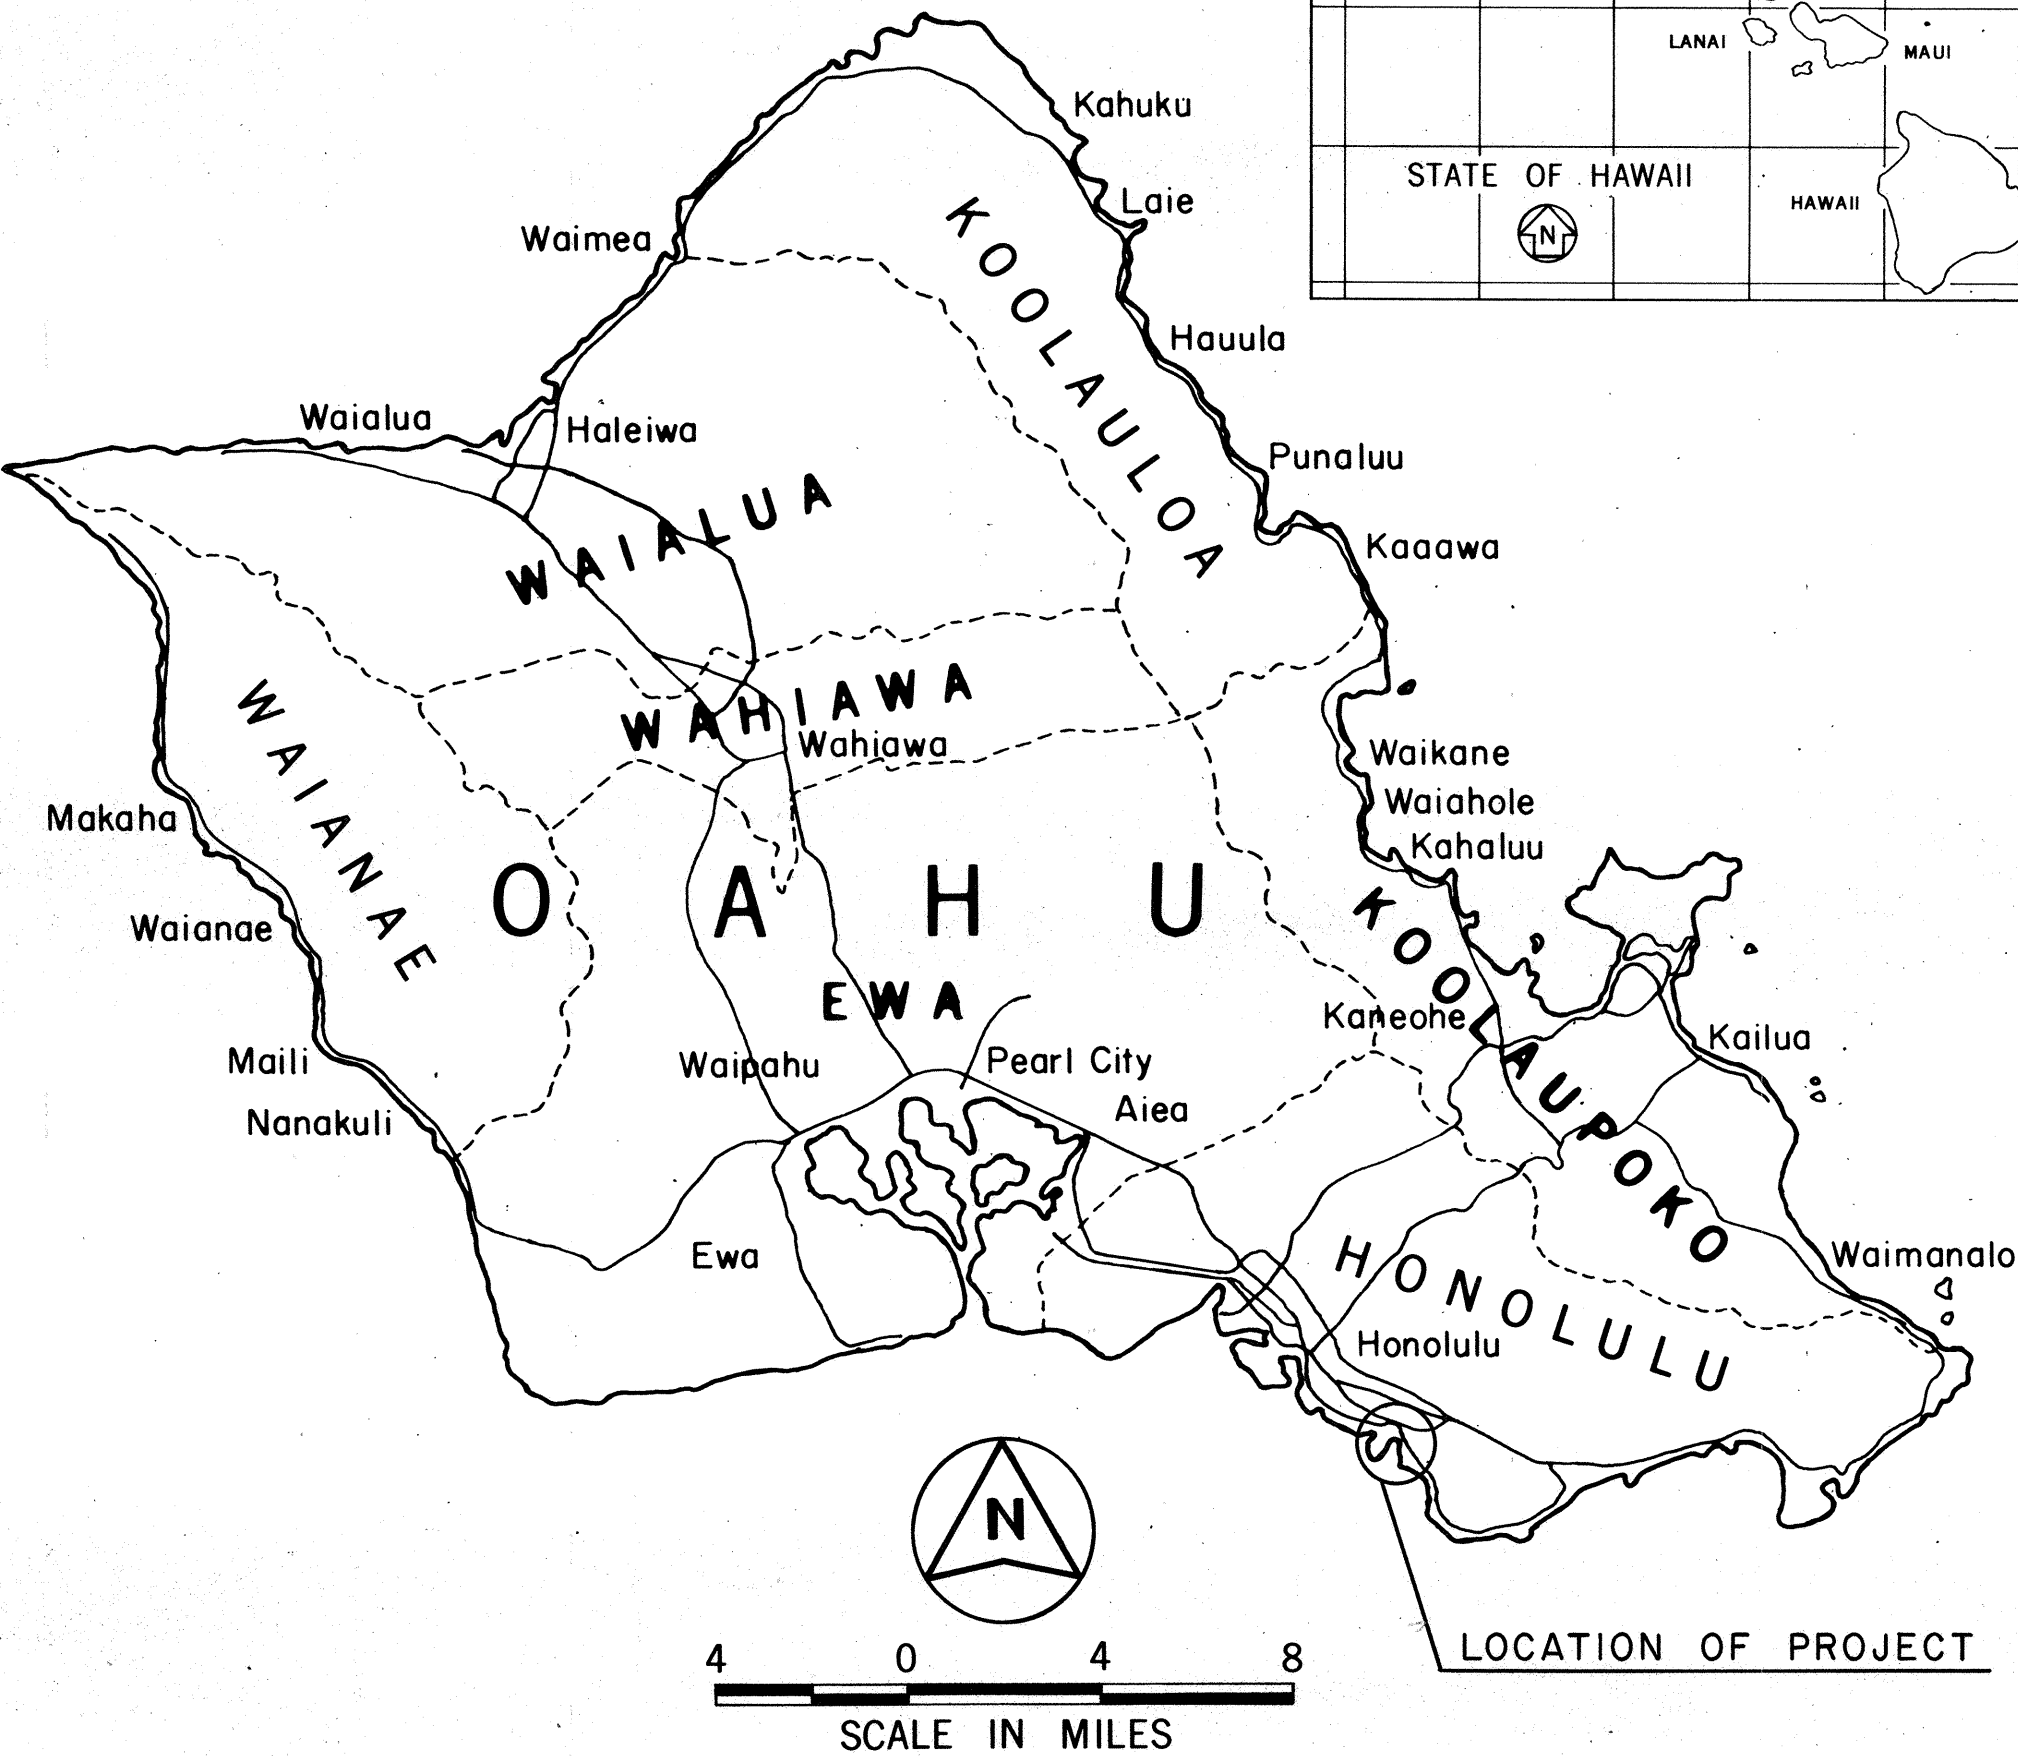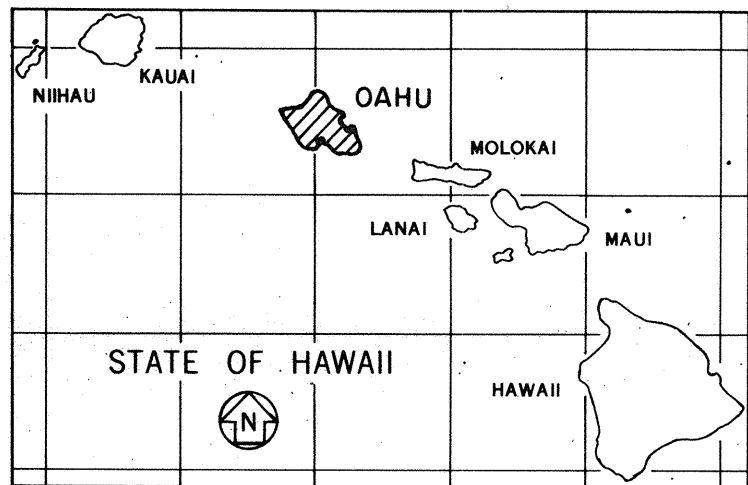

ALL CHANGES MADE DURING CONSTRUCTION HAVE BEEN INCORPORATED ON THESE PLANS IN RED EXCEPT CHANGES IN THE ORIGINAL THEORETICAL QUANTITIES. FOR ACTUAL QUANTITIES, REFER TO PROJECT LEDGER AND/OR COMPUTATION BOOK.

[Signature]

RESIDENT ENGINEER

1/3/83

DATE

DEPARTMENT OF TRANSPORTATION STATE OF HAWAII	
APPROVED:	
<i>[Signature]</i>	12/30/82
DIR. OF TRANSPORTATION	DATE

UNIT "E"

DESIGNED BY

A. Yamaguchi

548-4125

Dec. 4, 1981

DATE

P. S. & E. 8Y

PHONE