
	INDEX TO DRAWINGS
SHEET NO.	DESCRIPTION
1	TITLE SHEET
2-5	PLANTING PLANS & PLANT LIST
6-11	IRRIGATION PLANS & DETAILS
12-13	HIGHWAY MEDIAN CURBING, STRIPING
	& PAVEMENT MARKING PLANS
14	STANDARD DETAILS
A CONTRACTOR CONTRACTO	
-	

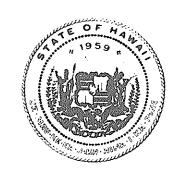

## STATE OF HAWAII

## DEPARTMENT OF TRANSPORTATION

HIGHWAYS DIVISION


HONOLULU, HAWAII
"AS-BUILT"

PLANS FOR

## THE HONOLULU GATEWAY BEAUTIFICATION PROJECT

ON NIMITZ HIGHWAY KALIHI STREET TO KAPALAMA CANAL PROJECT NO.92A-03-82



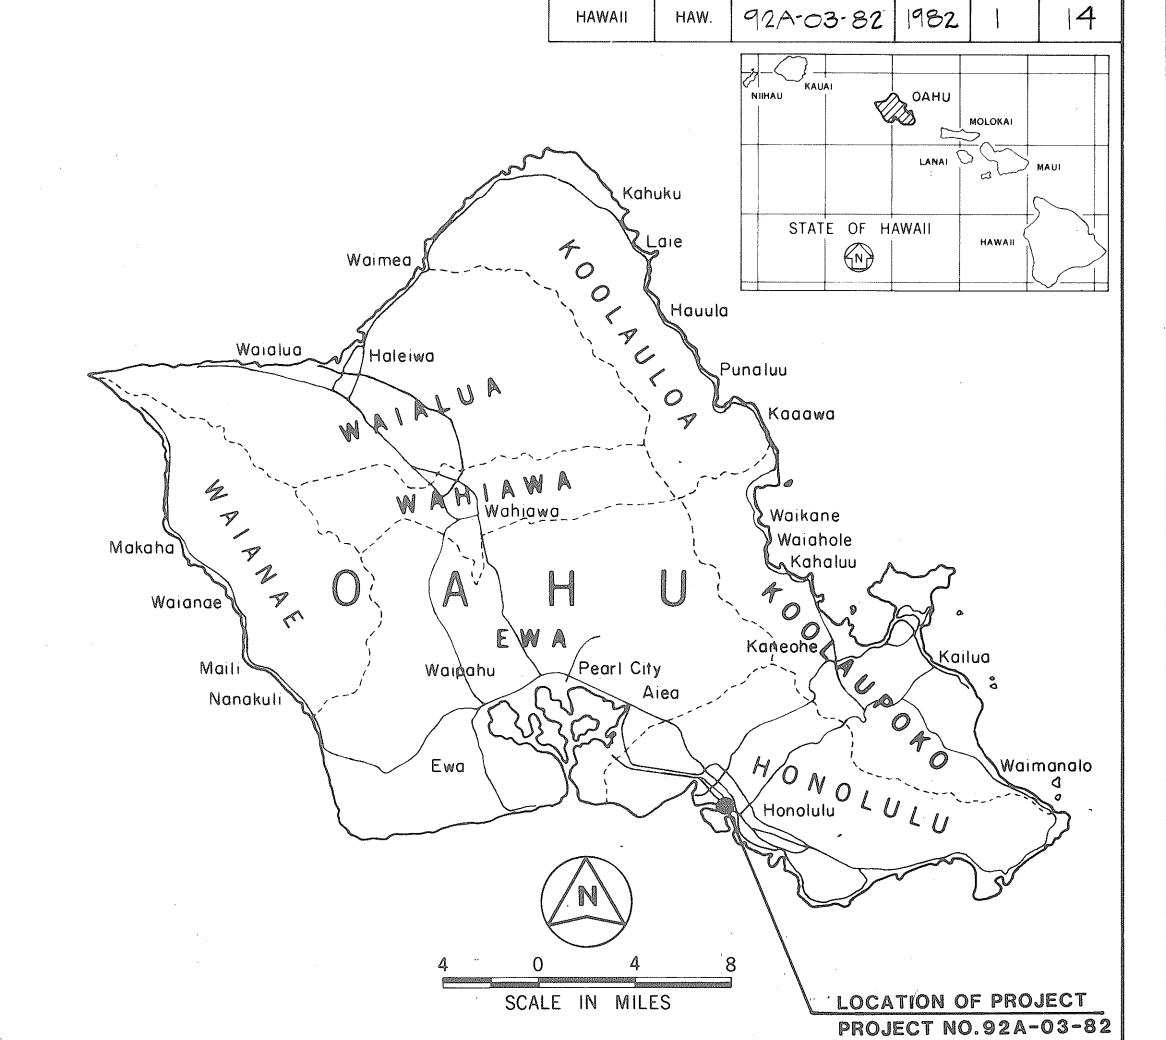

FED. ROAD DIST. NO.

CHANGES MADE DURING CONSTRUCTION HAVE BEEN INCORPORATED ON THESE PLANS EXCEPT CHANGES IN THE ORIGINAL THEORETICAL QUANTITIES. FOR ACTUAL QUANTITIES, REFER TO PROJECT LEDGER AND/OR COMPUTATION BOOK.

FISCAL SHEET TOTAL YEAR NO. SHEETS

PROJ. NO.

DEPARTMENT OF TRANSPORTATION STATE OF HAWAII DIR. OF TRANSPORTATION

548-6932 PHONE