



STATE OF HAWAII

DEPARTMENT OF TRANSPORTATION

HIGHWAYS DIVISION

HONOLULU, HAWAII


"AS-BUILT"
PLANS OF


MODERNIZATION OF TRAFFIC SIGNAL SYSTEM

ALA MOANA BOULEVARD AT WARD AVENUE FEDERAL AID PROJECT NO. HES-092-1(18)

DISTRICT OF HONOLULU

ISLAND OF OAHU

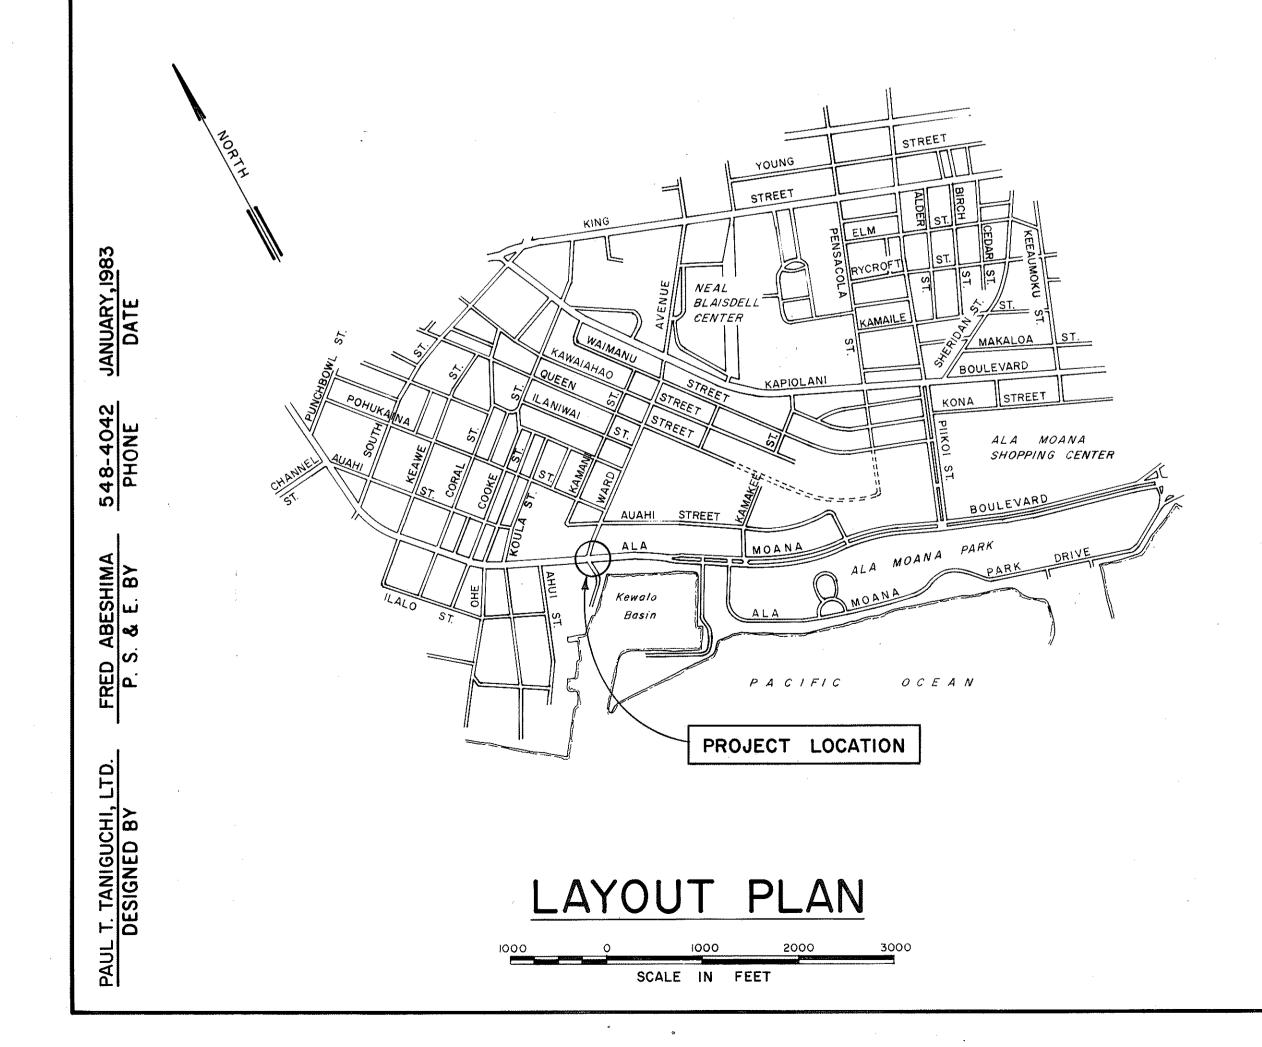

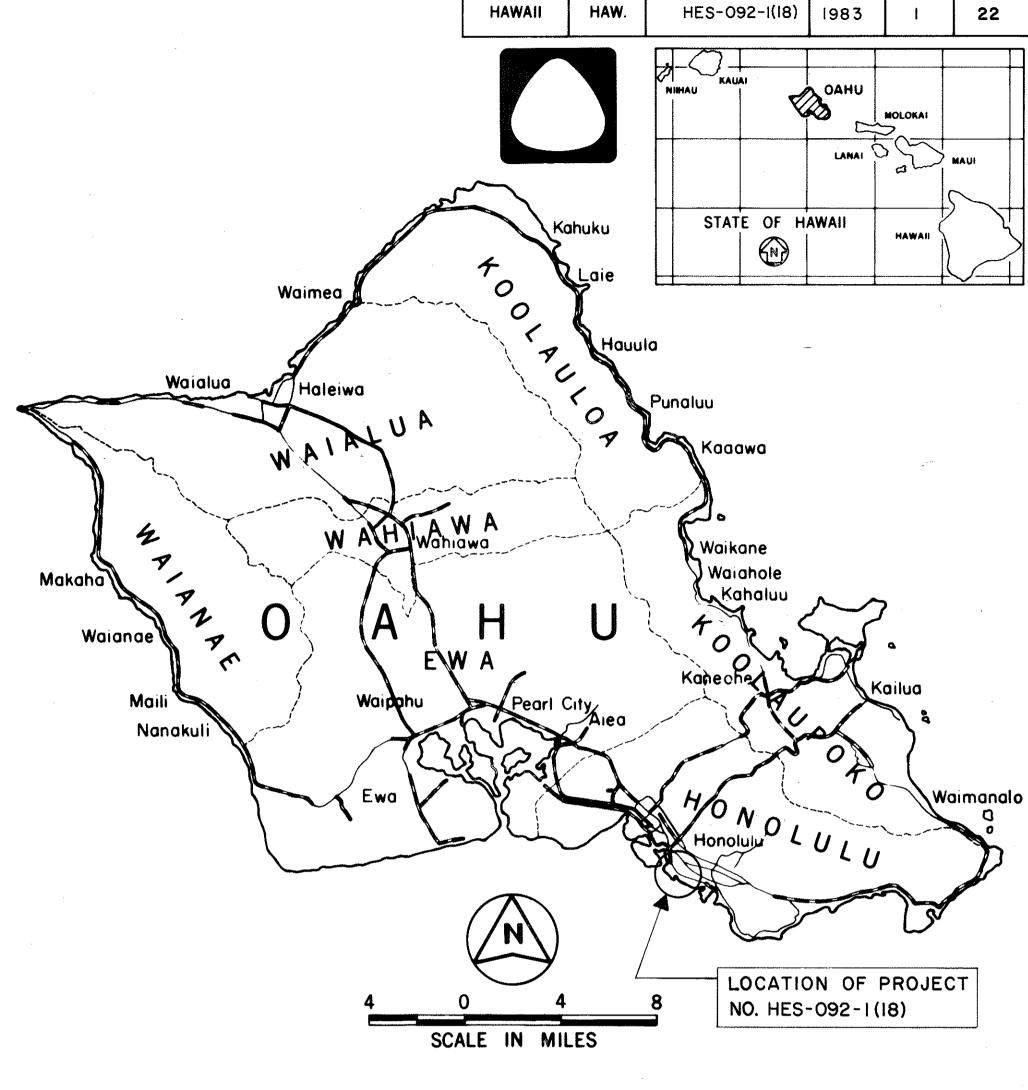

FED. ROAD DIST. NO.

STATE

FISCAL SHEET TOTAL YEAR NO. SHEETS

FED. AID PROJ. NO.

FEDERAL AID PROJECTS PREVIOUSLY CONSTRUCTED OR UNDER CONSTRUCTION

CHANGES MADE DURING CONSTRUCTION HAVE BEEN INCORPORATED ON THESE PLANS EXCEPT CHANGES IN THE ORIGINAL THEORETICAL QUANTITIES.

RESIDENT ENGINEER DATE

DEPARTME	NT OF	TRANSPOR	RTATION
FEDERAL H	HIGHWAY	ADMINIS	TRATION
APPROVED:			
Mea	Uhus		4/18/83
FOODIVISION	ADMINIS	TRATOR	DATE

DEPARTMENT OF TRANSPORTATION STATE OF HAWAII			
APPROVED: RHigashionno	3/3/83		
DIR. OF TRANSPORTATION	DATE		