


TIMING DATA

PHASES	1	2	3	4	5	6
MIN. GREEN	5	5	5	5	5	5
EXTENSION (GAP)	3	2	3	3	3	2
YELLOW CHANGE	3	3	4	4	3	3
RED CLEAR.	2	2	1	1	2	2
WALK	—	7	5	5	—	7
PED CLEAR.	—	21	18	19	—	21
MAX I	15	20	23	24	50	29

▷	CONDUITS	LF	CABLES	LF
▷1	1-2"	25	1-TYPE 1	30
▷2	1-2"	48	1-TYPE 2	53
▷3	1-2"	35	1-TYPE 7	40
▷4	2-2"	115	2-TYPE 2	250
			1-TYPE 3	125
▷5	2-2"	90	1-TYPE 1	95
			1-TYPE 7	95
▷6	2-2"	85	1-TYPE 1	90
			2-TYPE 7	180
▷7	3-2"	110	1-TYPE 1	115
			2-TYPE 2	230
			1-TYPE 3	115
			2-TYPE 7	230
▷8	3-2"	15	1-TYPE 1	20
			2-TYPE 2	40
			1-TYPE 3	20
▷9	5-2"	5	2-TYPE 1	20
			6-TYPE 2	60
			1-TYPE 3	10
			1-TYPE 6	10
			4-TYPE 7	40
▷10	EXIST.		TYPE 5 (NO. VARIES)	995
TSS TO TSPB	1-2"	43	TYPE 5 (NO. VARIES)	2,90
▷11	3-2"	110	1-TYPE 1	115
			2-TYPE 2	230
			1-TYPE 3	115
			1-TYPE 7	115

SCALE: AS SHOWN DATE: _____

SHEET NO. 1 OF 1 SHEETS

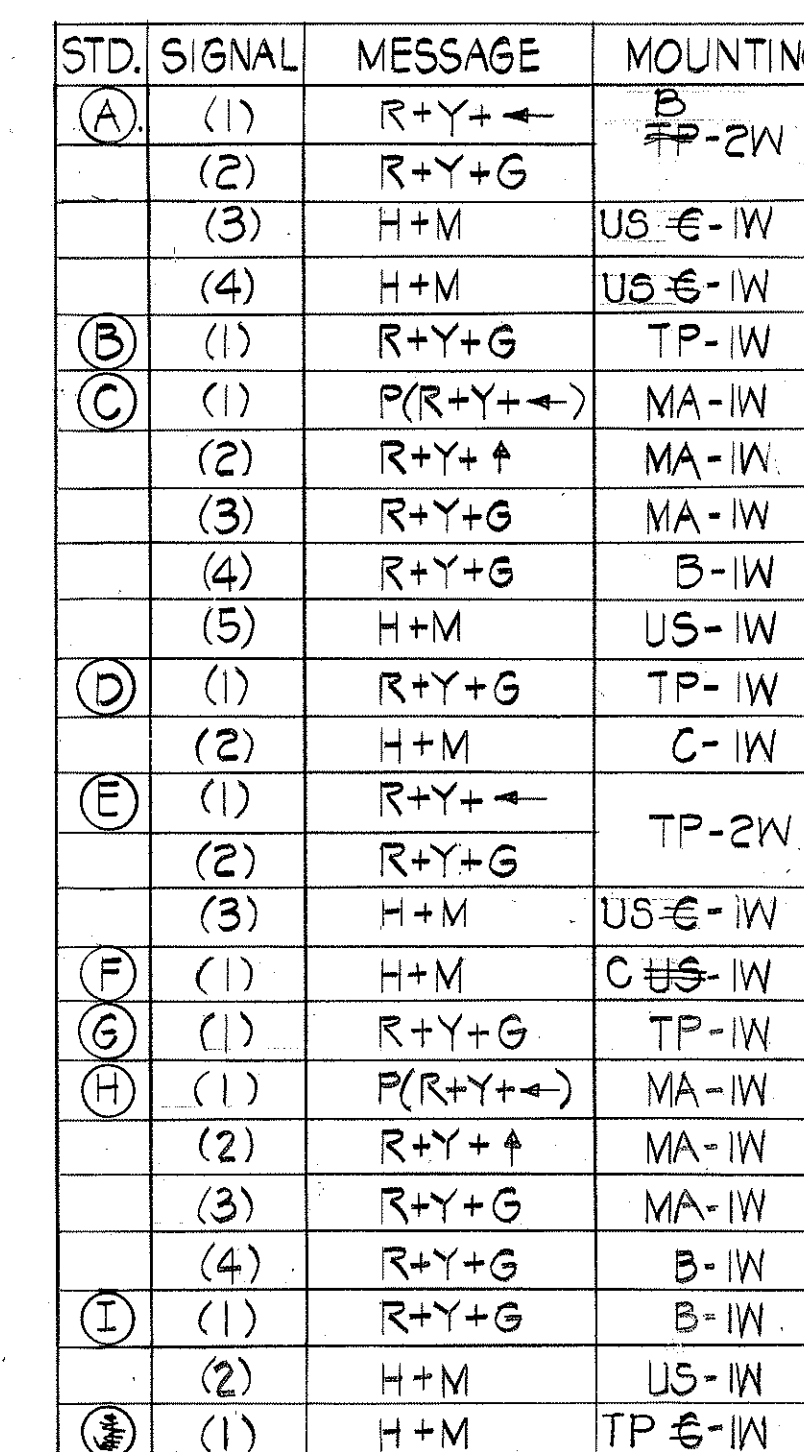

K

SCALE: 1"=20'

ORIGINAL PLAN	SURVEY PLOTTED BY _____ DATE _____
	DRAWN BY _____
	TRACED BY _____
	DESIGNED BY _____
	QUANTITIES BY _____
	CHECKED BY _____
No. _____	

THE WASHINGTON POST
AND TIMES HERALD
Paul J. Fanger