	INDEX TO DRAWINGS
SHEET NO.	DESCRIPTION
	TITLE SHEET
2	TYPICAL SECTIONS
3	GENERAL NOTES & RESURFACING
	& MISC. TYPICAL SECTIONS
4	ROADWAY PLAN
5	RESURFACING PLAN & WATER
	NOTES
6-7S-I	GUARD RAIL DETAILS
8	TYPICAL DETAILS FOR CENTER-
	LINE SURVEY MONUMENTS
9	PORTABLE CONCRETE GUARD
	RAIL TYPICAL DETAILS
10	SIGNING & PAVEMENT MARKING
	PLAN
11-22	STANDARD DETAILS



STATE OF HAWAII

DEPARTMENT OF TRANSPORTATION

HIGHWAYS DIVISION


"AS BUILT"


PLANS FOR CONSTRUCTION OF

NIMITZ HIGHWAY SAFETY IMPROVEMENTS WESTBOUND LANES AT IWILEI

FEDERAL AID PROJECT NO. HES-092-1(19)

DISTRICT OF HONOLULU ISLAND OF OAHU

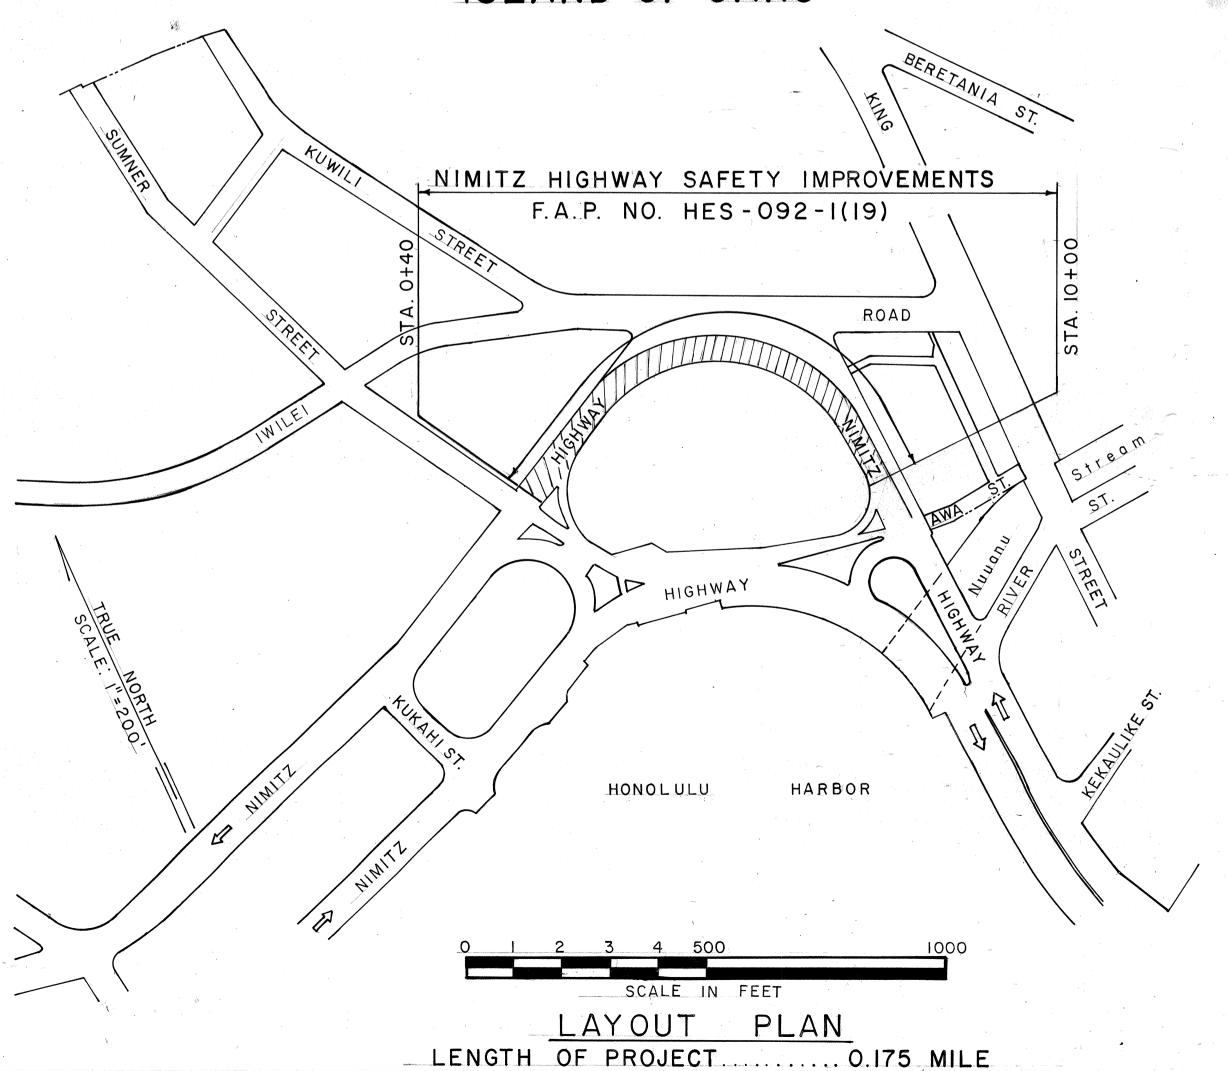

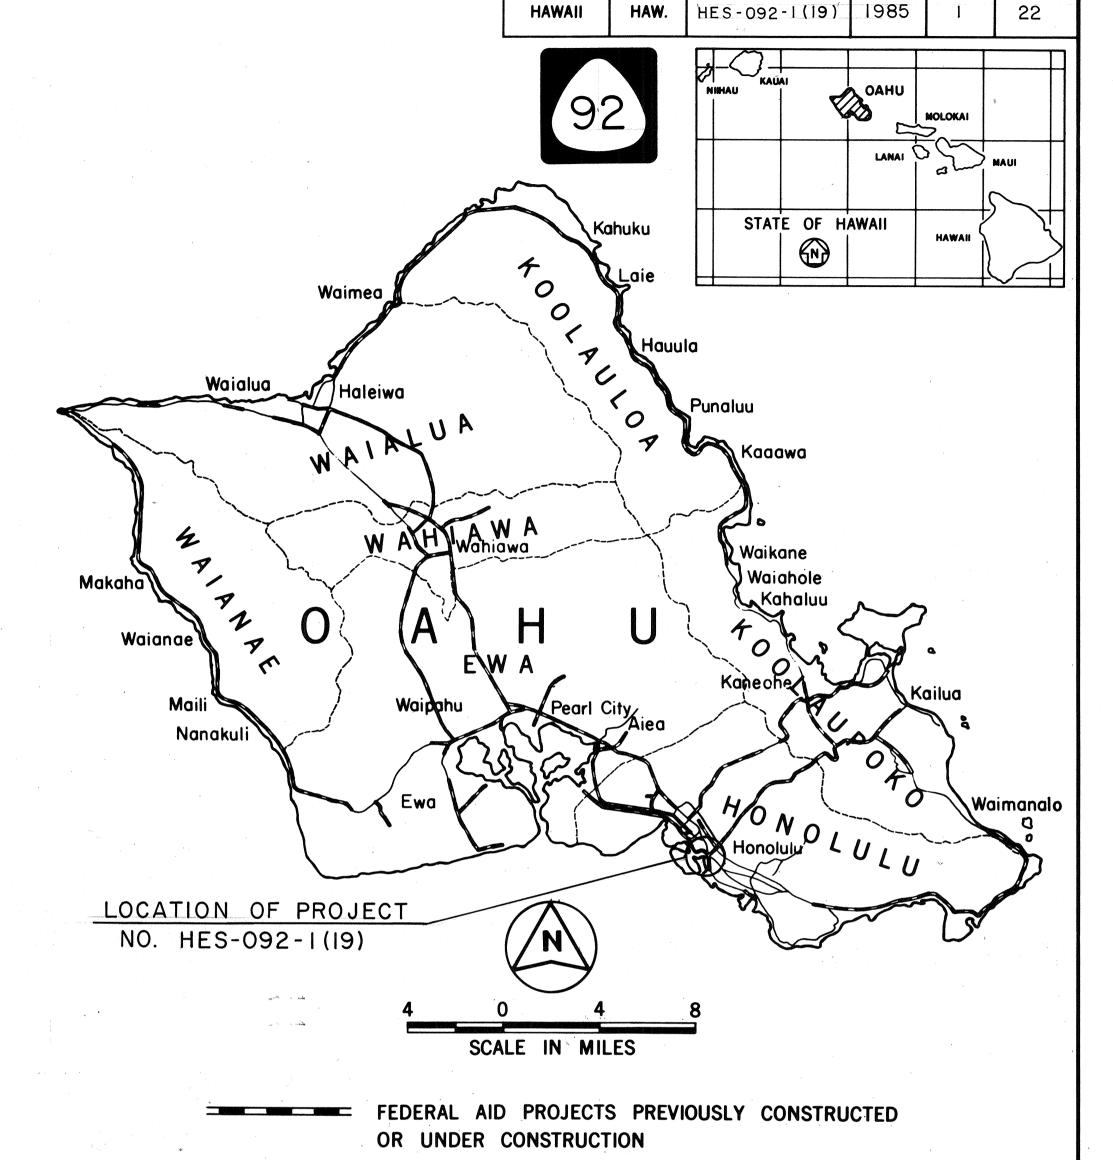

FED. ROAD DIST. NO.

STATE

FISCAL SHEET TOTAL YEAR NO. SHEETS

FED. AID PROJ. NO.

DESIGN CLASSIFICATION ADT (1984) 37,200 DHV 4,000 T.... 3%

CHANGES MADE DURING CONSTRUCTION HAVE BEEN INCORPORATED ON THESE PLANS EXCEPT CHANGES IN THE ORIGINAL THEORETICAL QUANTITIES. FOR ACTUAL QUANTITIES, REFER TO PROJECT LEDGER AND/OR COMPUTATION BOOK.

Kelvin akazawa for RESIDENT ENGINEER

11-21-85 DATE

DEPARTMENT OF TRANSPORTATION FEDERAL HIGHWAY ADMINISTRATION 8.28.84

ATION
•
1/24/84
DATE