


DATE	REVISION
7/10/85	Add installation of conduits and pullboxes for Traffic Signal System. Delete Type H Markers at Rt. E.P. and add note "4" White Edge Stripe." Revise Note by adding "4" Yellow Stripe with." Add Note Nos. 9 & 10

FED. ROAD DIST. NO.	STATE	PROJ. NO.	FISCAL YEAR	SHEET NO.	TOTAL SHEETS
HAWAII	HAW.	02A-02-86M	1985	2	12

GENERAL NOTES

1. ALL PROSPECTIVE BIDDERS ON THIS PROJECT SHALL BE RESPONSIBLE FOR INSPECTING THE PROJECT SITE PRIOR TO SUBMISSION OF BID TO CONFIRM EXISTING SITE CONDITIONS AND LOCATION OF ALL UTILITIES, OBSTRUCTIONS, ETC.
2. CONTRACTOR SHALL CONFIRM ALL PLANT QUANTITIES, SITE CONDITIONS, AND DIMENSIONS PRIOR TO CONSTRUCTION.
3. CONTRACTOR IS RESPONSIBLE FOR PROTECTING ALL UTILITIES.
4. BYFILL MIX (SEE PLANTING DETAILS)
 - A. 6 CU. FT. BURNT BAGASSE OR WOOD CHIPS
 - B. 6 CU. FT. MANURE
 - C. 15 CU. FT. IMPORTED TOPSOIL
5. ALL AREAS WHICH RECEIVE NEW CURB SHALL ALSO RECEIVE 4" OF IMPORTED SCREENED TOPSOIL. ALL OTHER AREAS TO RECEIVE 1" OF TOPSOIL - FEATHER DOWN TO 4" DEPTH AT EXIST. CURBS TO PREVENT RUNOFF.
6. ALL EXISTING VEGETATION WITHIN THE PROJECT LIMITS SHALL BE REMOVED UNLESS OTHERWISE NOTED.
7. ALL PLANTING AREAS SHALL BE AMENDED WITH 1" OF AMENDMENT AND ROTOTILLED TO A DEPTH OF 4". THE AMENDMENT SHALL BE 1 PART WELL ROTTED MANURE AND 1 PART BURNT BAGASSE


8. RAISE ALL UTILITY BOXES SO TOP IS FLUSH WITH FINISH GRADE BY INSTALLING BRICK OR COMPACTED GRAVEL BED AT BASE OF BOXES. THIS SHALL BE CONSIDERED INCIDENTAL TO TOPSOIL OPERATION.
9. LOCATIONS OF CONDUITS AND PULLBOXES SHOWN ON THIS PLAN IS APPROXIMATE. THE EXACT LOCATIONS WILL BE DETERMINED IN THE FIELD BY THE ENGINEER.
10. FOR TRENCHING OF TRAFFIC SIGNAL SYSTEM CONDUITS, SEE TRENCH DETAIL ON PLAN SH. NO. ADD.10.

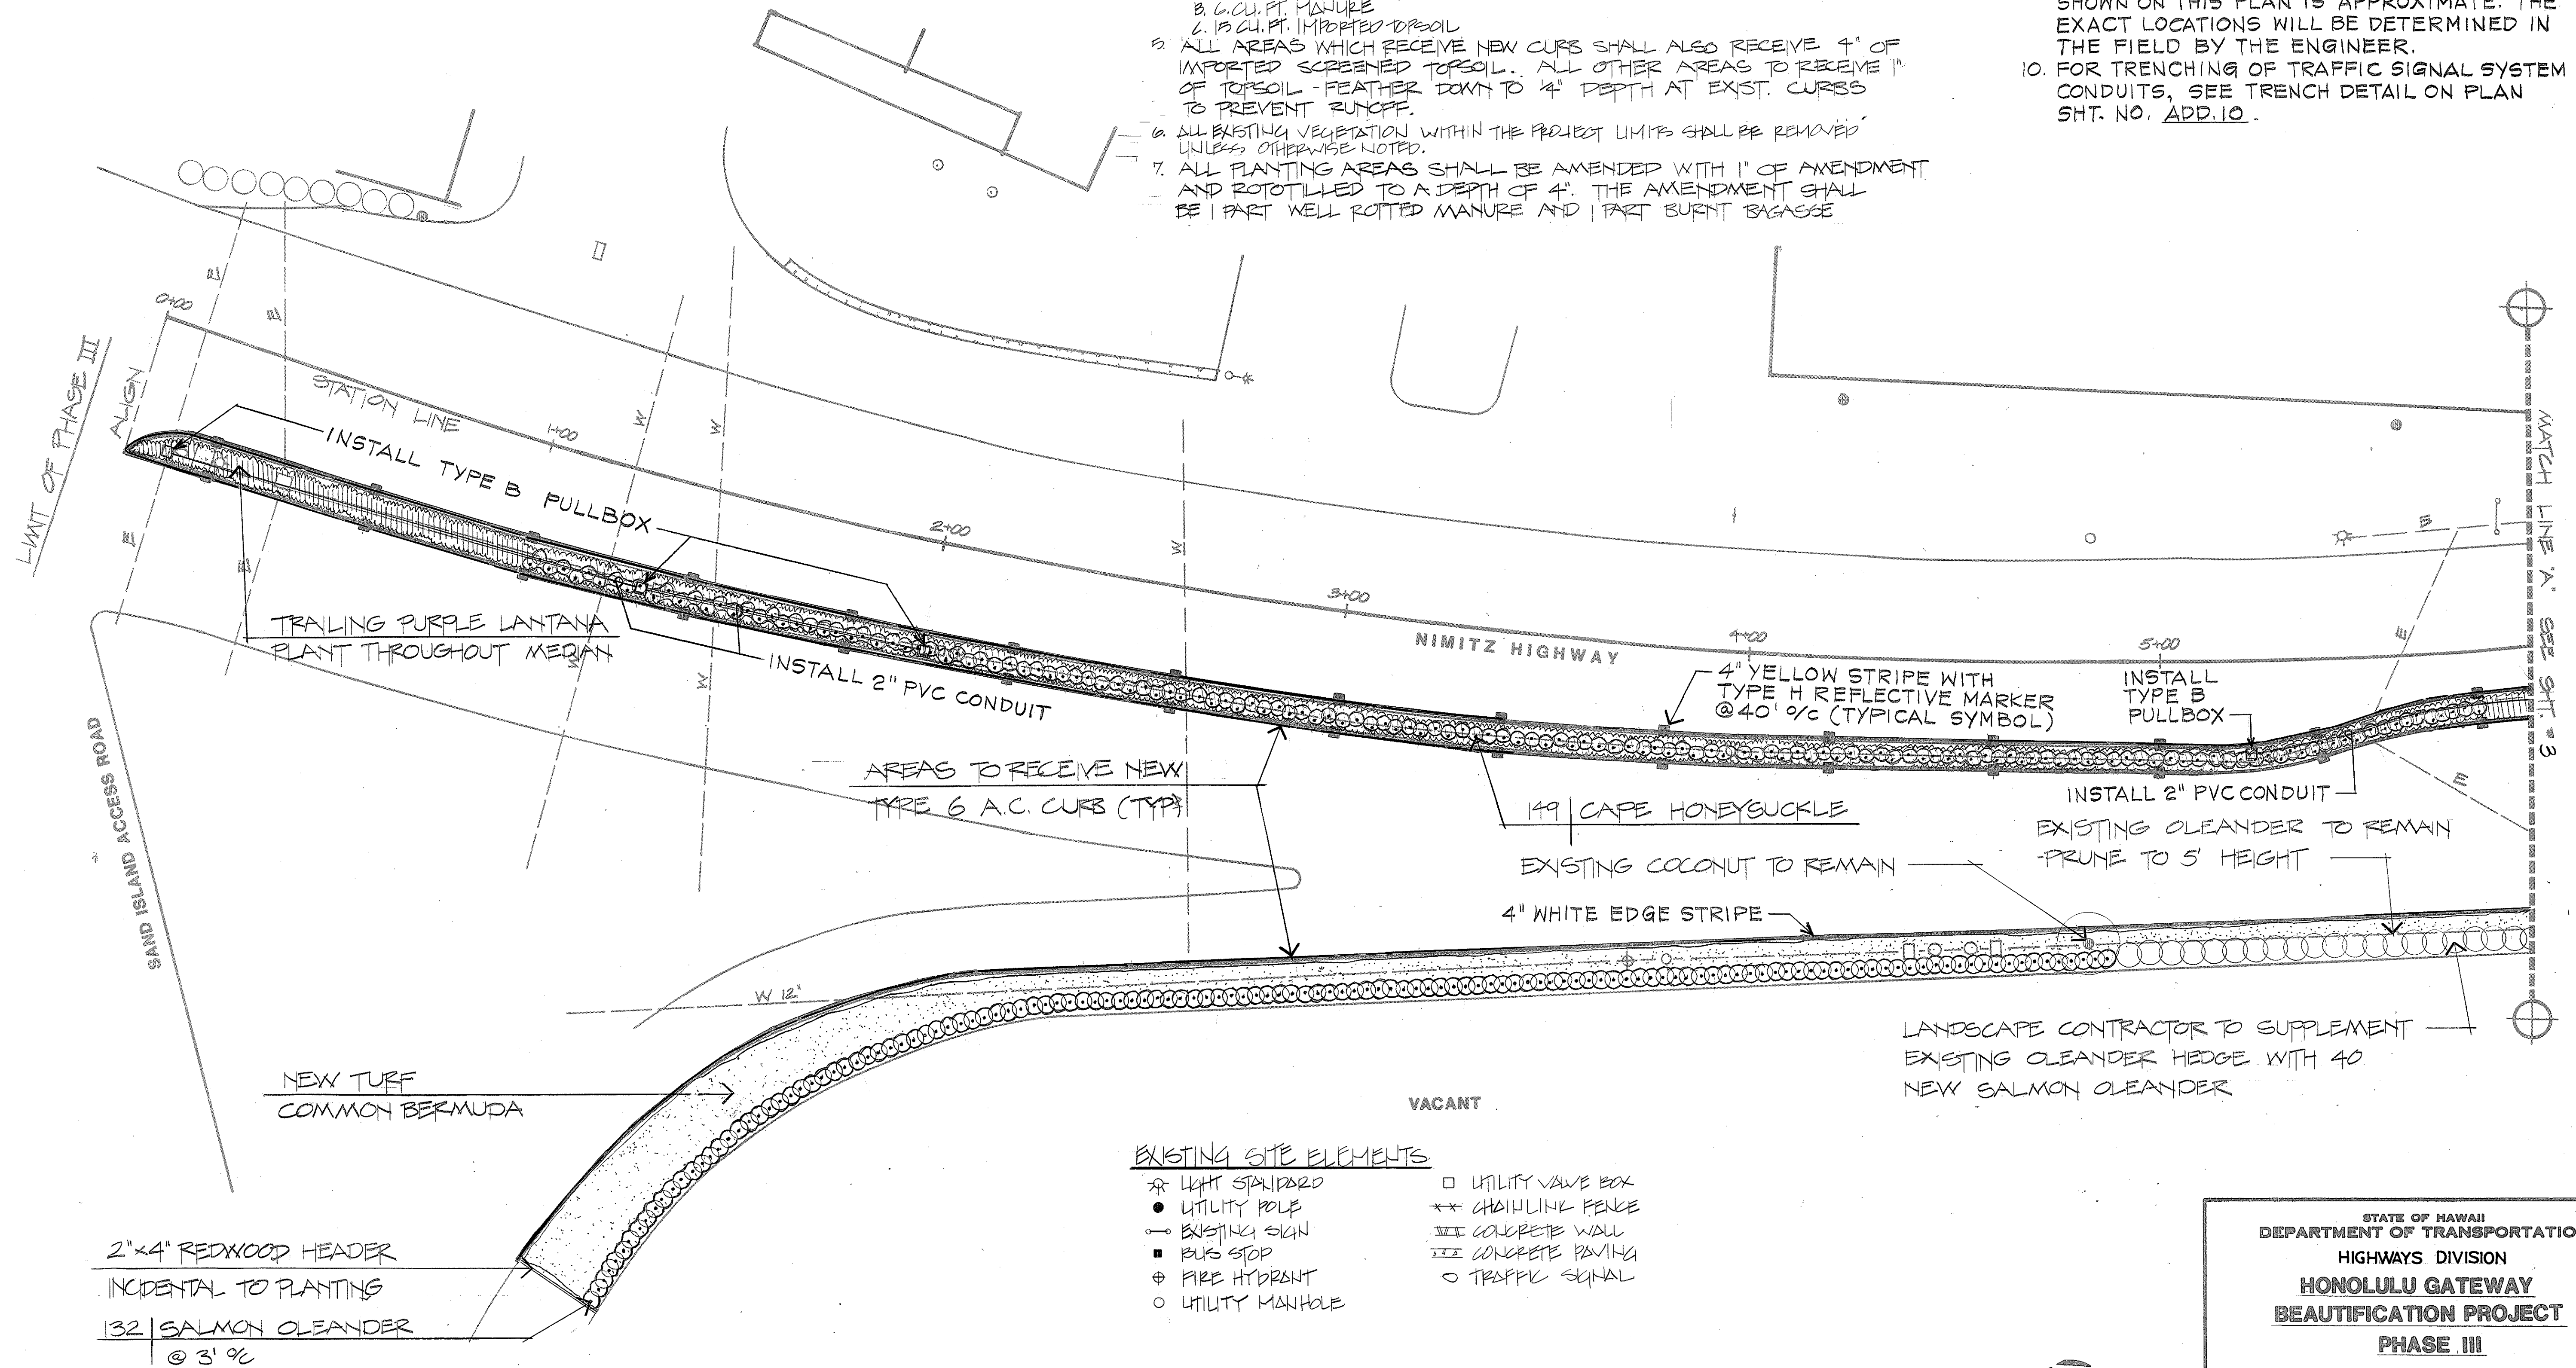

EXISTING SITE ELEMENTS

- ⊙ LIGHT STANDARD
- UTILITY POLE
- EXISTING SIGN
- BUS STOP
- ⊕ FIRE HYDRANT
- UTILITY MANHOLE
- UTILITY VALVE BOX
- ×× CHAINLINK FENCE
- ▬ CONCRETE WALL
- ▬ CONCRETE PAVING
- TRAFFIC SIGNAL

0 5 10 20 40
IN FEET
SCALE: 1"=20'

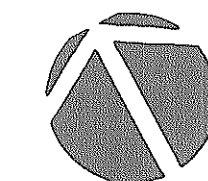

STATE OF HAWAII
DEPARTMENT OF TRANSPORTATION
HIGHWAYS DIVISION
HONOLULU GATEWAY
BEAUTIFICATION PROJECT
PHASE III

PLANTING PLAN

DATE: FEB. 1993

SHEET NO. 1 OF 4 SHEETS


ADD. 2

ORIGINAL PLAN	DATE
DESIGNED BY	
NOTED BY	
CHECKED BY	
NO.	

FED. ROAD DIST. NO.	STATE	PROJ. NO.	FISCAL YEAR	SHEET NO.	TOTAL SHEETS
HAWAII	HAW.	92A-02-86M	1986	3	12

PLANT LIST



QUANTITY	BOTANICAL NAME	COMMON NAME	SIZE	REMARKS
66	CASSIA GLAUCA	KALAMONA	15 GAL	5'-6" HT 1"-1½" CALIPER
337	NERIUM OLEANDER	OLEANDER	2½ GAL	24"-36" HT
365	TECOMARIA CAPENSIS	CAPE HONEYBUCKLE	1 GAL	12"-18" HT
6934 SF	LANTANA SELLOWIANA	TRAILING LANTANA	4" CELL	6"-8" HT 12" 9% PURPLE VAR.
2003 SF	CARISSA PROSTRATE	PROSTRATE NATAL PLUMS	1 GAL	6"-8" HT 24" 0% SEAR YELLOW VAR
7518 SF	LANTANA SELLOWIANA	TRAILING LANTANA	4" CELL	6"-8" HT 12" 9% PURPLE VAR.
32	IPOMOEA HORSFALLIAE	PRINCE KUHIO VINE	2½ GAL	18"-24" LENGTH - TRAIN ON FENCE
18470 SF	CYNODON DACTYLON	COMMON BERMUDA	SEED	HYDROMULCH

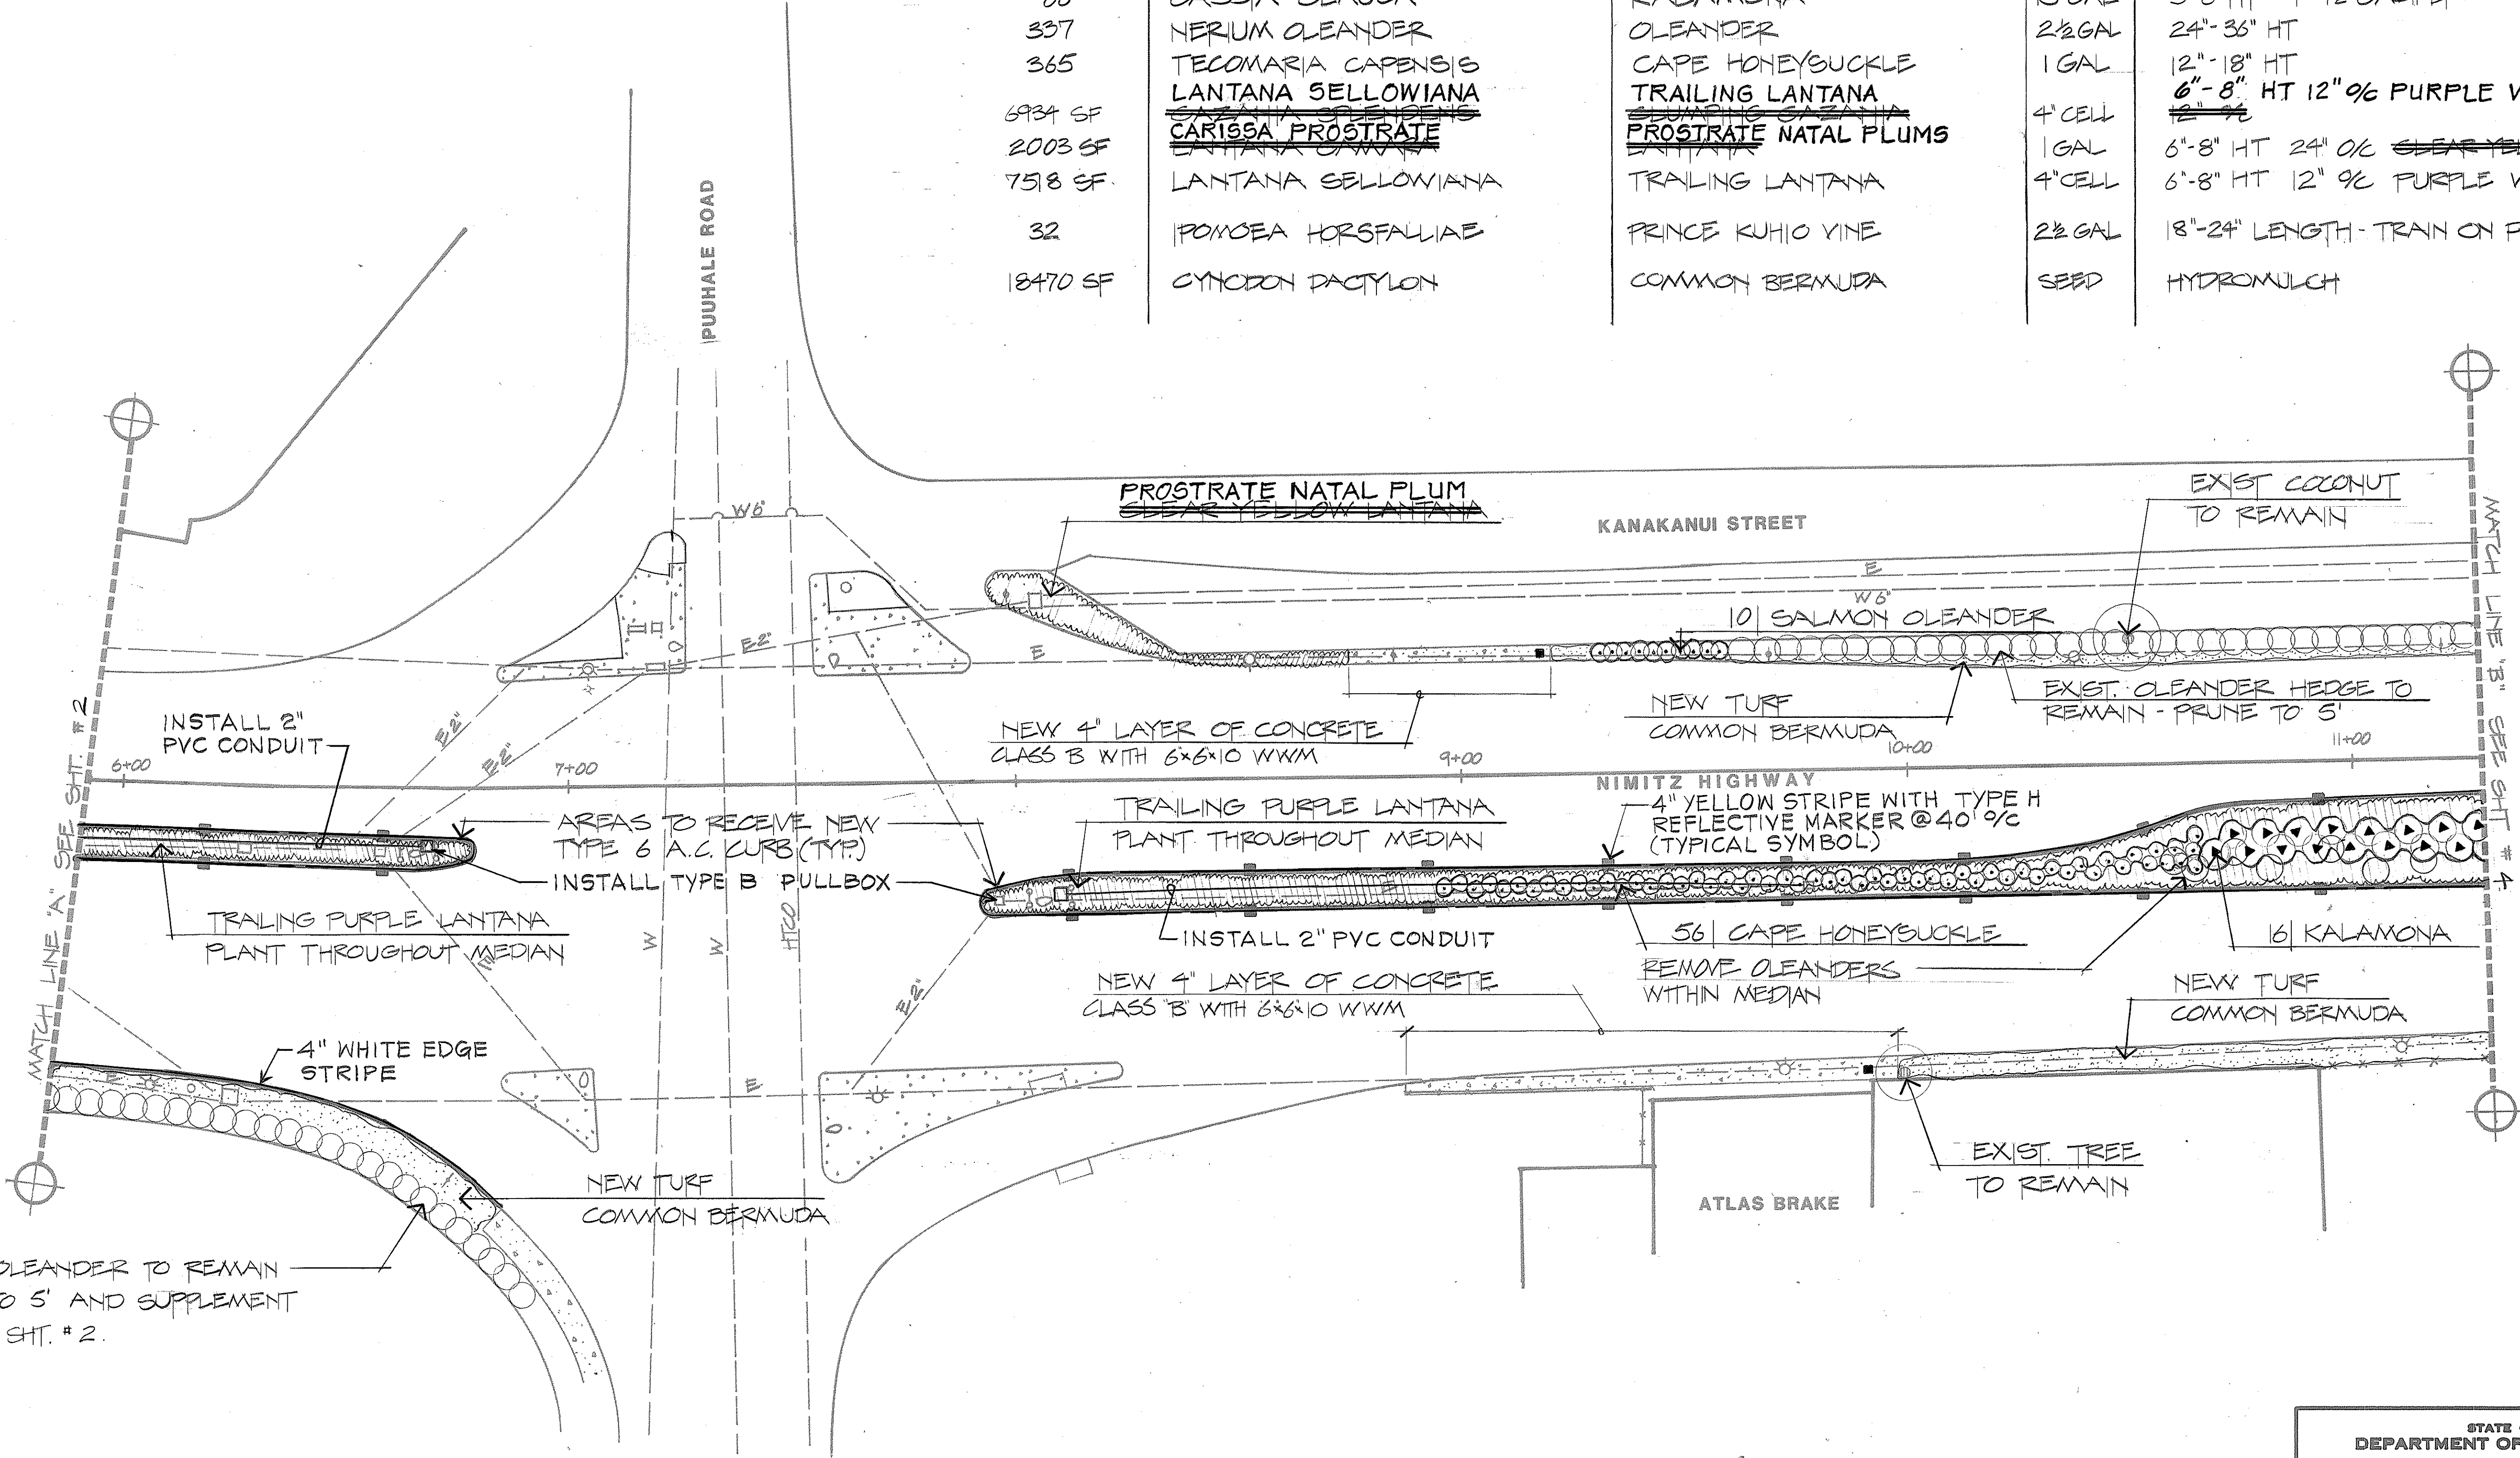

EXIST. OLEANDER TO REMAIN PRUNE TO 5' AND SUPPLEMENT AS PER SHT. # 2.

DATE	7/10/85
DESIGNED BY	ADD. 3
CHECKED BY	
NOTED BY	
QUANTITIES BY	
NO.	


7/10/85	Add installation of conduits & pullboxes for Traffic Signal System. Delete 4" layer of Concrete, Class B with 6x6x10 WWM. Revise Note by adding "4" Yellow Stripe with". Delete Type H Markers at Rt. E.P. and add note "4" White Edge Stripe".
DATE	REVISION

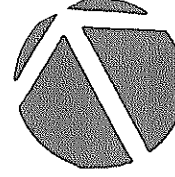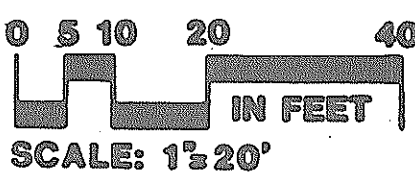

STATE OF HAWAII
DEPARTMENT OF TRANSPORTATION
HIGHWAYS DIVISION
HONOLULU GATEWAY
BEAUTIFICATION PROJECT
PHASE III
PLANTING PLAN



DATE: FEB. 1983
SHEET No. 2 OF 4 SHEETS

FED. ROAD DIST. NO.	STATE	PROJ. NO.	FISCAL YEAR	SHEET NO.	TOTAL SHEETS
HAWAII	HAW.	92A-02-86M	1985	4	12

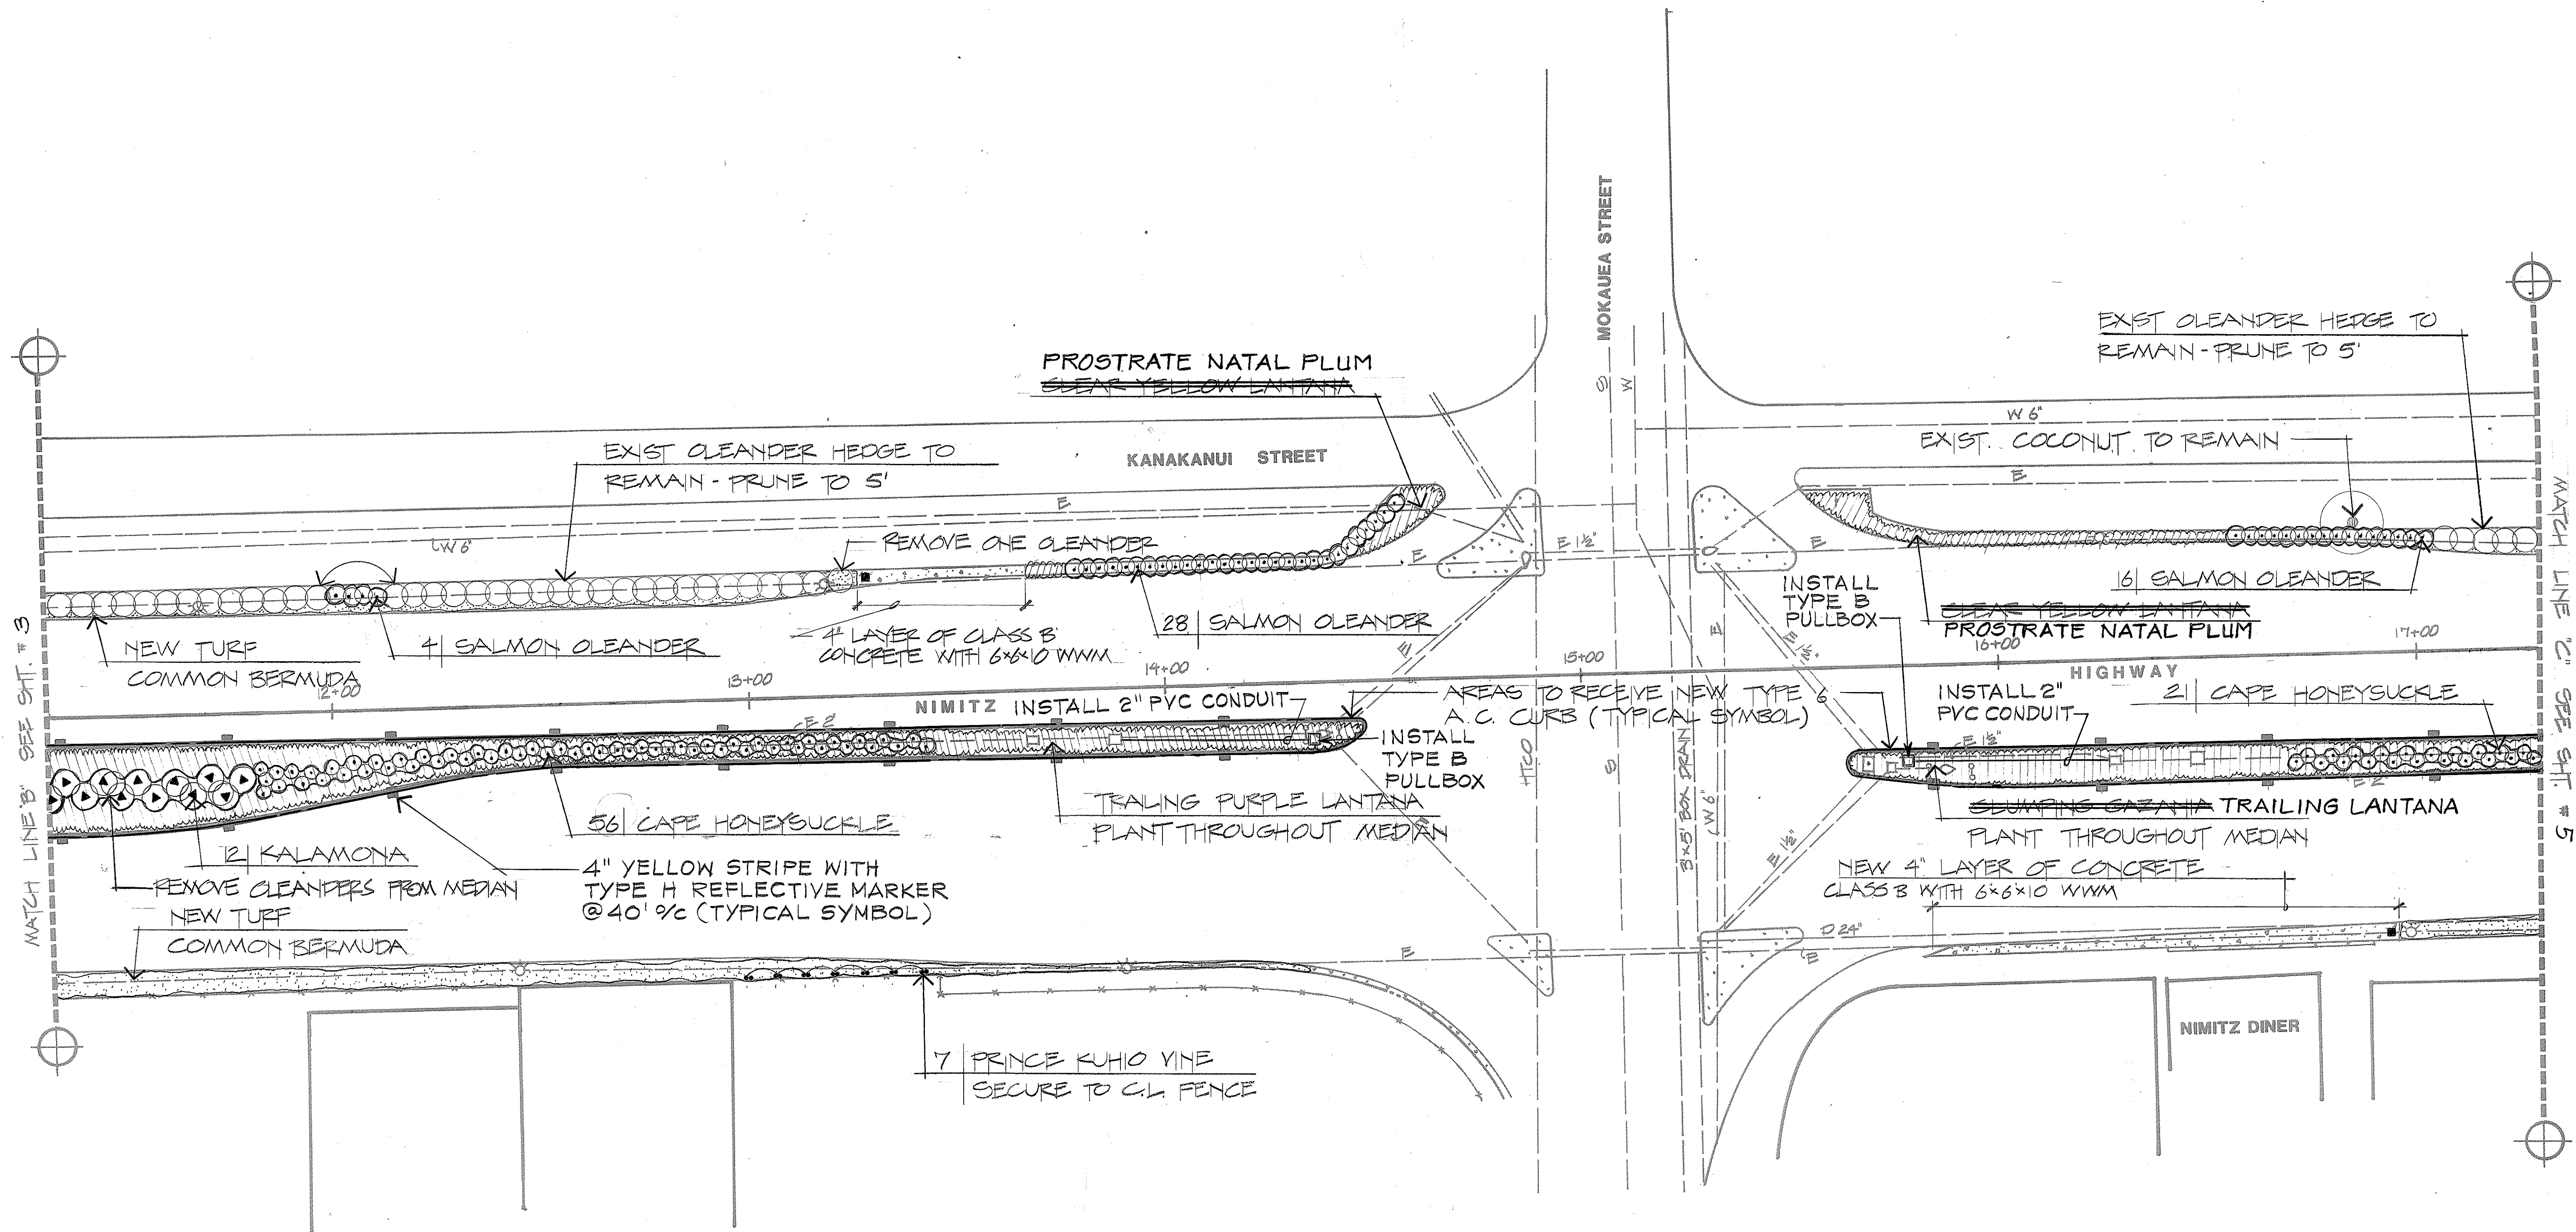


ORIGINAL PLAN	DATE
NOTED BY	DESIGNED BY
QUANTITIES BY	CHECKED BY
NO.	

7/10/85	Add installation of conduits & pullboxes for Traffic Signal System. Revise Note by adding "4" yellow stripe with
DATE	REVISION

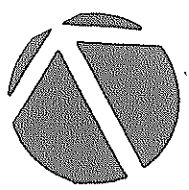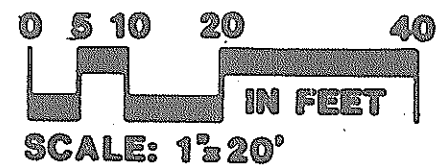



STATE OF HAWAII
DEPARTMENT OF TRANSPORTATION
HIGHWAYS DIVISION
HONOLULU GATEWAY
BEAUTIFICATION PROJECT
PHASE III
PLANTING PLAN
DATE: FEB. 1983
SHEET NO. 3 OF 4 SHEETS

FED. ROAD DIST. NO.	STATE	PROJ. NO.	FISCAL YEAR	SHEET NO.	TOTAL SHEETS
HAWAII	HAW.	02A-02-86M	1985	5	12

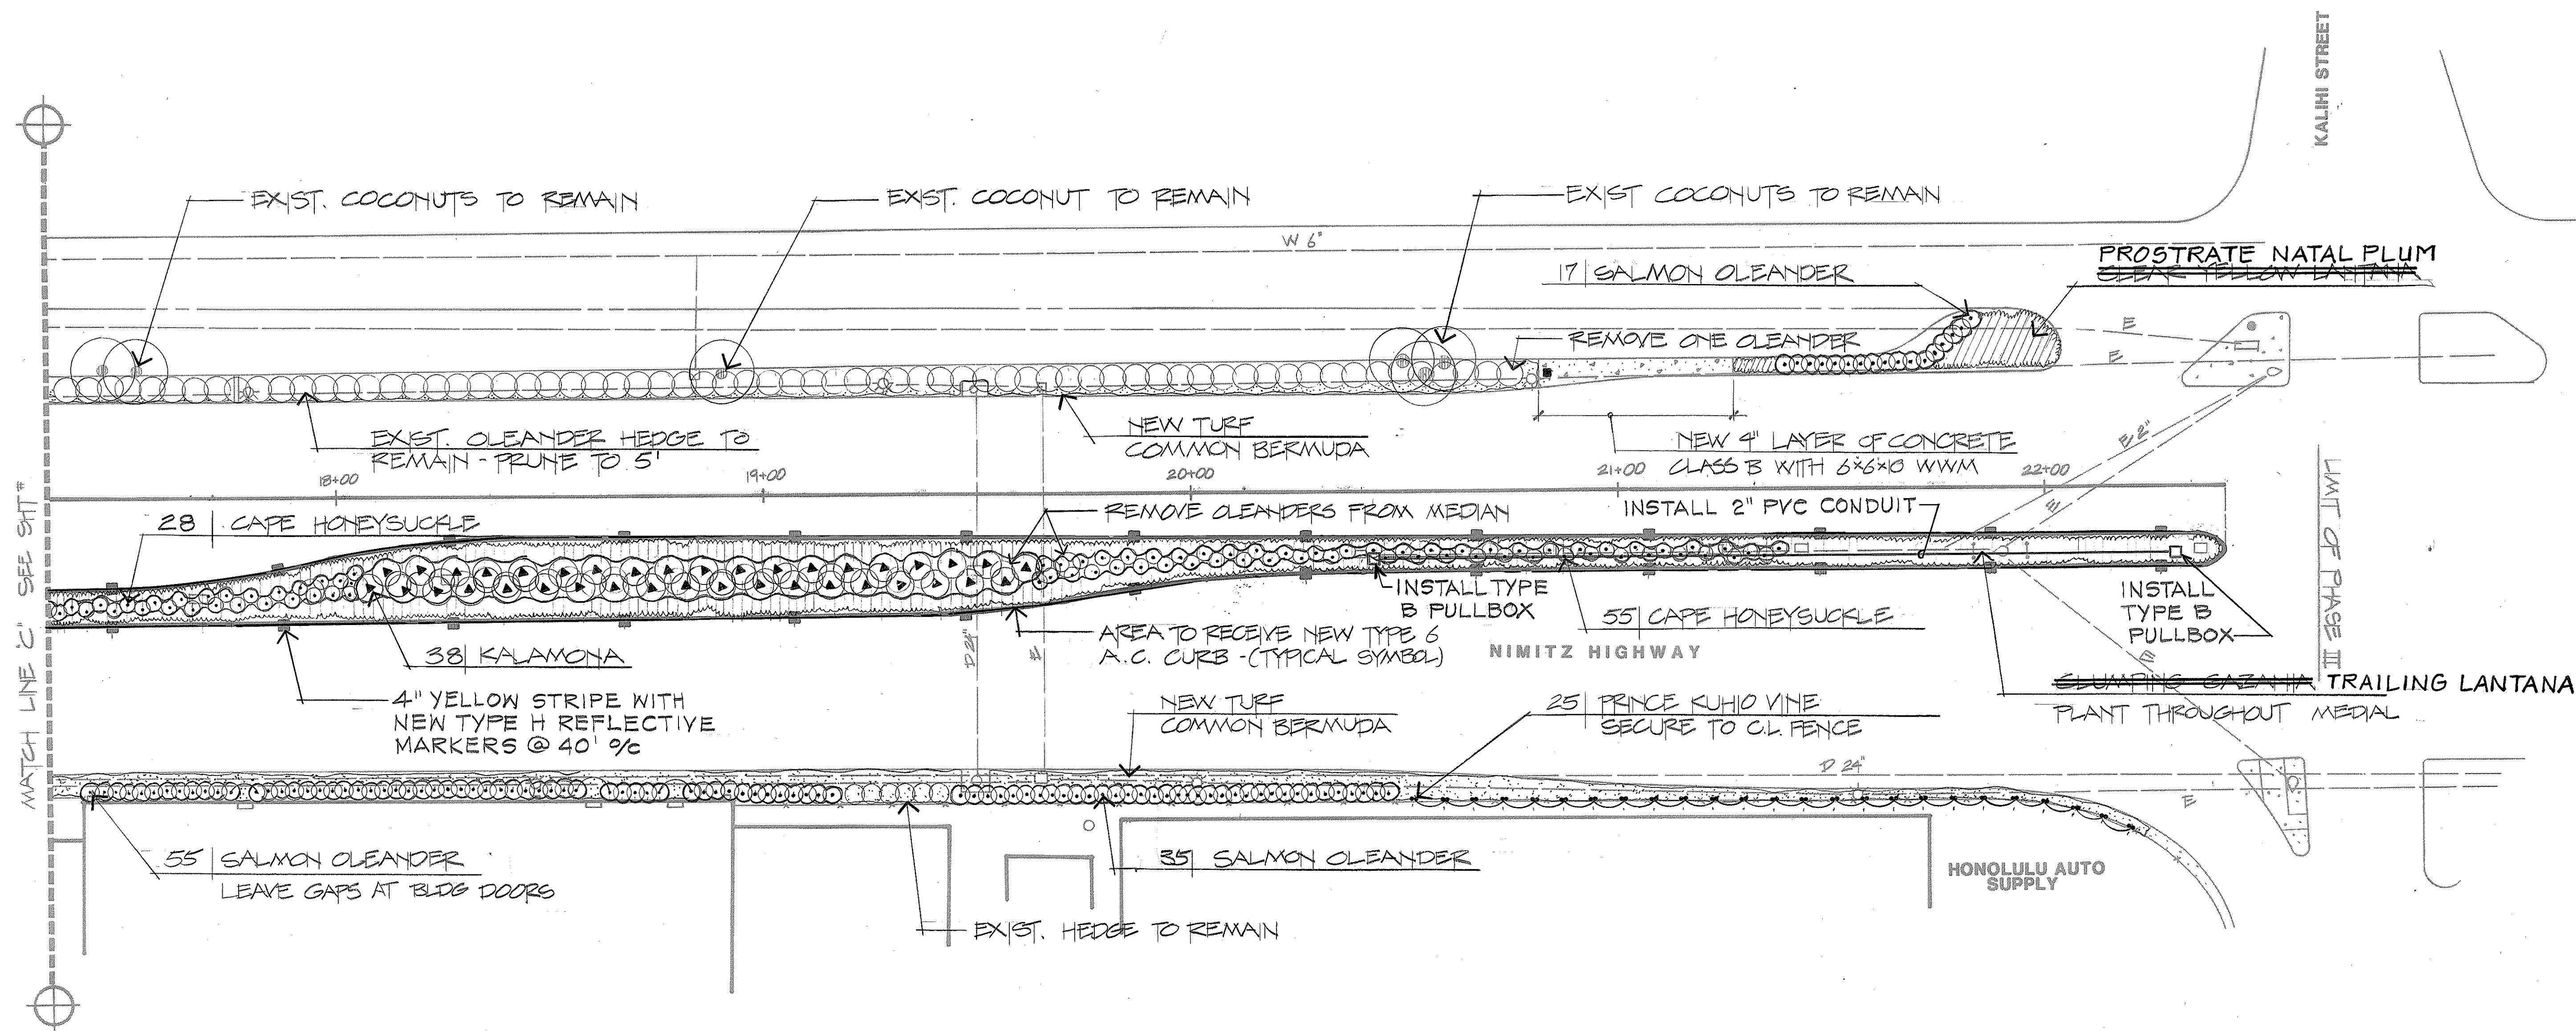

SURVEY PLOTTED BY	DATE
DRAWN BY	
TRACED BY	
QUANTITIES BY	
CHECKED BY	
ORIGINAL PLAN	
NOTE BOOK	
No.	

7/10/85	Add installation of conduits & pullboxes for Traffic Signal System. Revise Note by adding "4" Yellow Stripes with".
DATE	REVISION

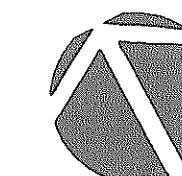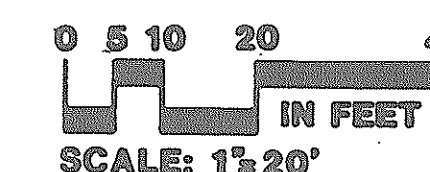

STATE OF HAWAII
DEPARTMENT OF TRANSPORTATION
HIGHWAYS DIVISION
HONOLULU GATEWAY
BEAUTIFICATION PROJECT
PHASE III
PLANTING PLAN
DATE: FEB. 1983
SHEET NO. 4 OF 4 SHEETS