


FED. ROAD DIST. NO.	STATE	FED. AID PROJ. NO.	FISCAL YEAR	SHEET NO.	TOTAL SHEETS
HAWAII	HAW.	02A-01-BGM	1986	3	5

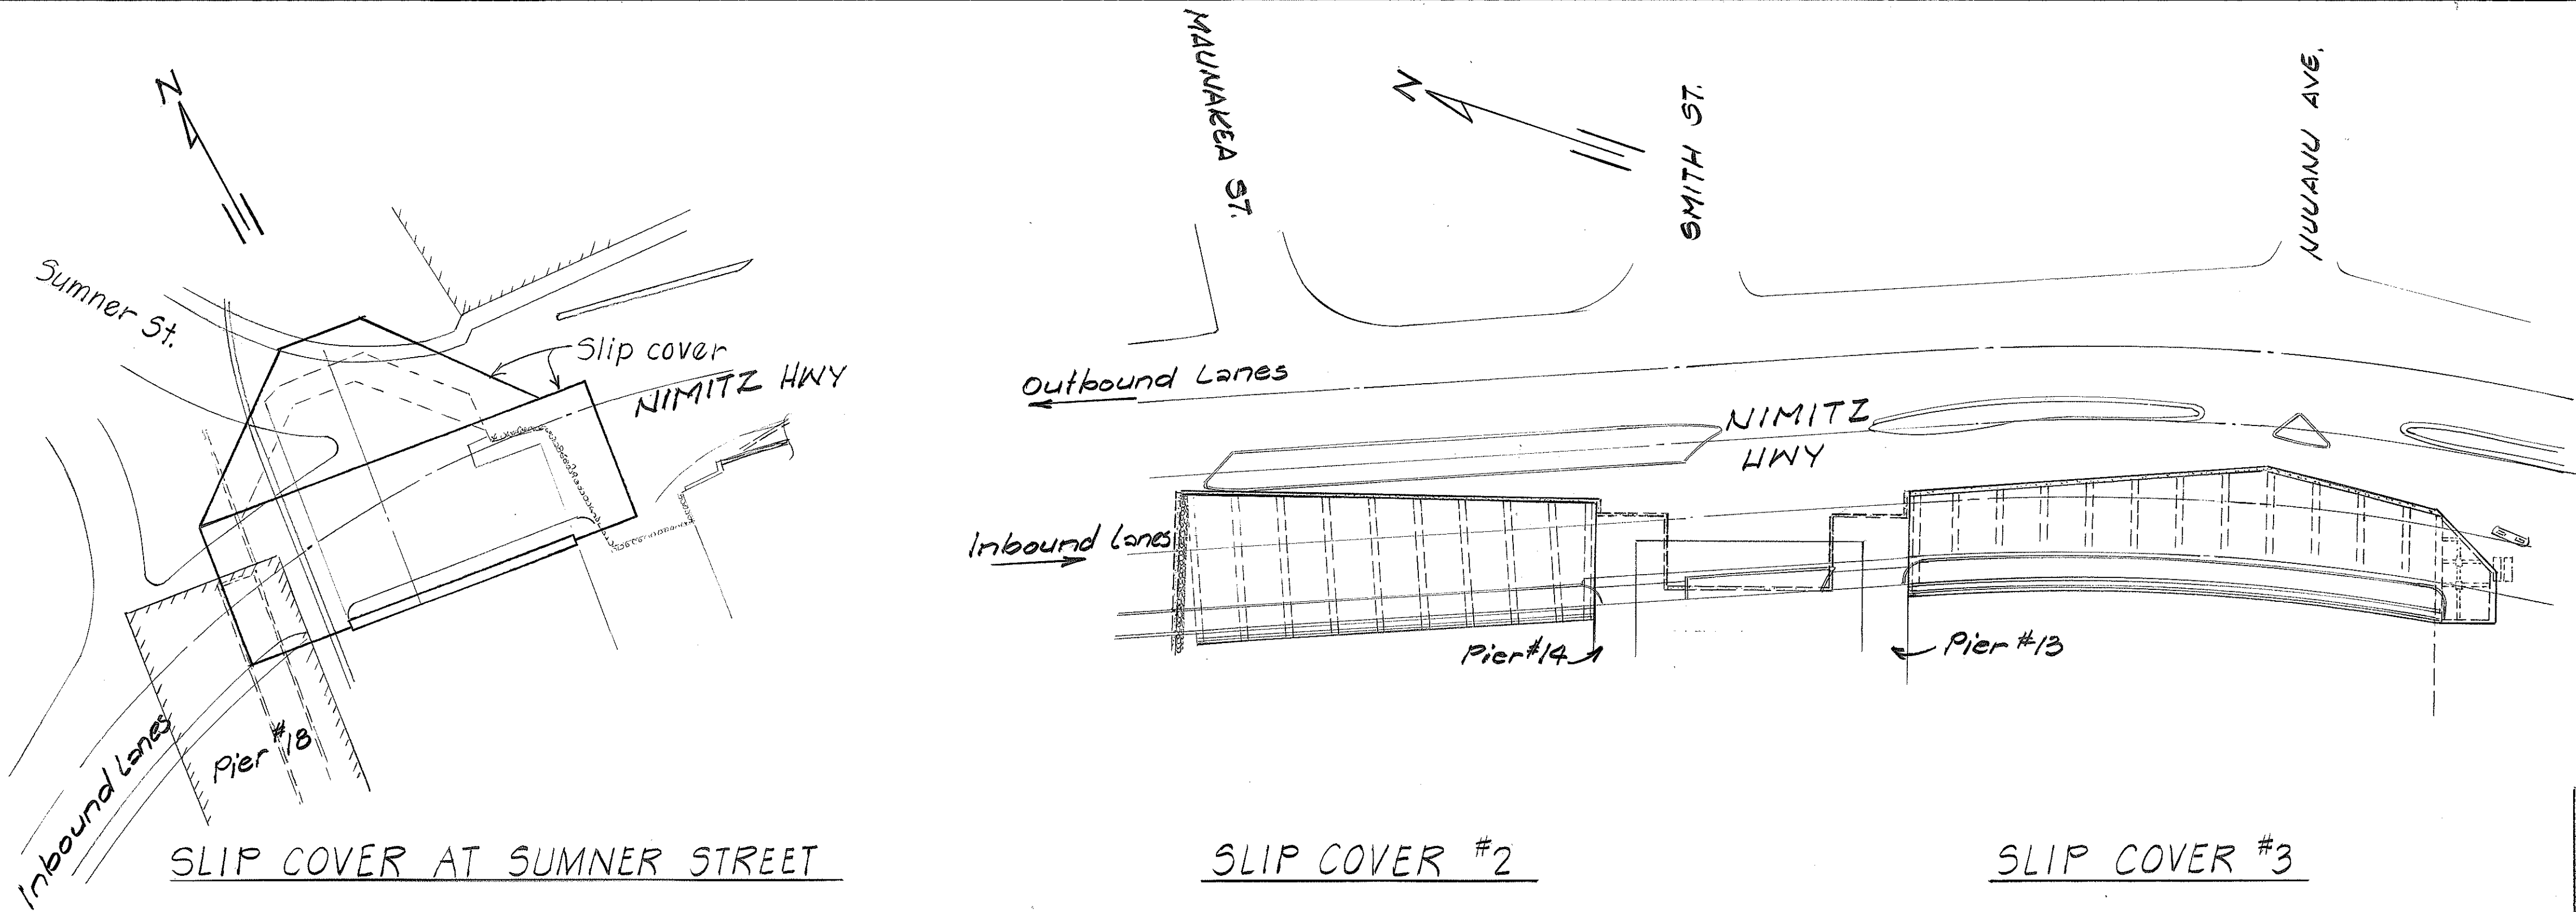

PROJECT SITE PLAN Scale: 1" = 50'-0"

ESTIMATED QUANTITIES			
ITEM NO.	ITEM	UNIT	*QUANTITY
676.0001	Repairs to Sumner St. Slip Cover with Shotcrete and/or Hand-Placed Mortar.	S.F.	720
676.0002	Repairs to Slip Cover No. 3 with Shotcrete and/or Hand-Placed Mortar.	S.F.	330
676.0003	Repairs to Slip Cover No. 2 with Shotcrete and/or Hand-Placed Mortar.	S.F.	50
676.0004	Repairs to Cavities in Seawall of Slip Cover No. 2 with Shotcrete and/or Hand-Placed Mortar.	C.Y.	2
677.0001	Sealing Cracks in Sumner St. Slip Cover.	L.F.	50
677.0002	Sealing cracks in Slip Cover No. 3	L.F.	30
677.0003	Sealing cracks in Slip Cover No. 2	L.F.	5

* Includes estimated overrun.

ORIGINAL PLAN	DATE
NOTE BOOK	9/85
NO.	9/85
SURVEY PLOTTED BY	DATE
DRAWN BY	9/85
DESIGNED BY	9/85
QUANTITIES BY	9/85
CHECKED BY	9/85

STATE OF HAWAII
DEPARTMENT OF TRANSPORTATION
HIGHWAYS DIVISION

PROJECT SITE PLAN & EST. QUANTITIES

NIMITZ HIGHWAY SLIP COVERS
REPAIR SPALLED CONCRETE
Proj. No. 02A-01-BGM

Scale: As Noted Date: Sept. 1985

SHEET NO. 2 OF 4 SHEETS