



FED. ROAD DIST. NO.	STATE	FED. AID PROJ. NO.	FISCAL YEAR	SHEET NO.	TOTAL SHEETS
HAWAII	HAW.	92A-01-BGM	1986	5	5

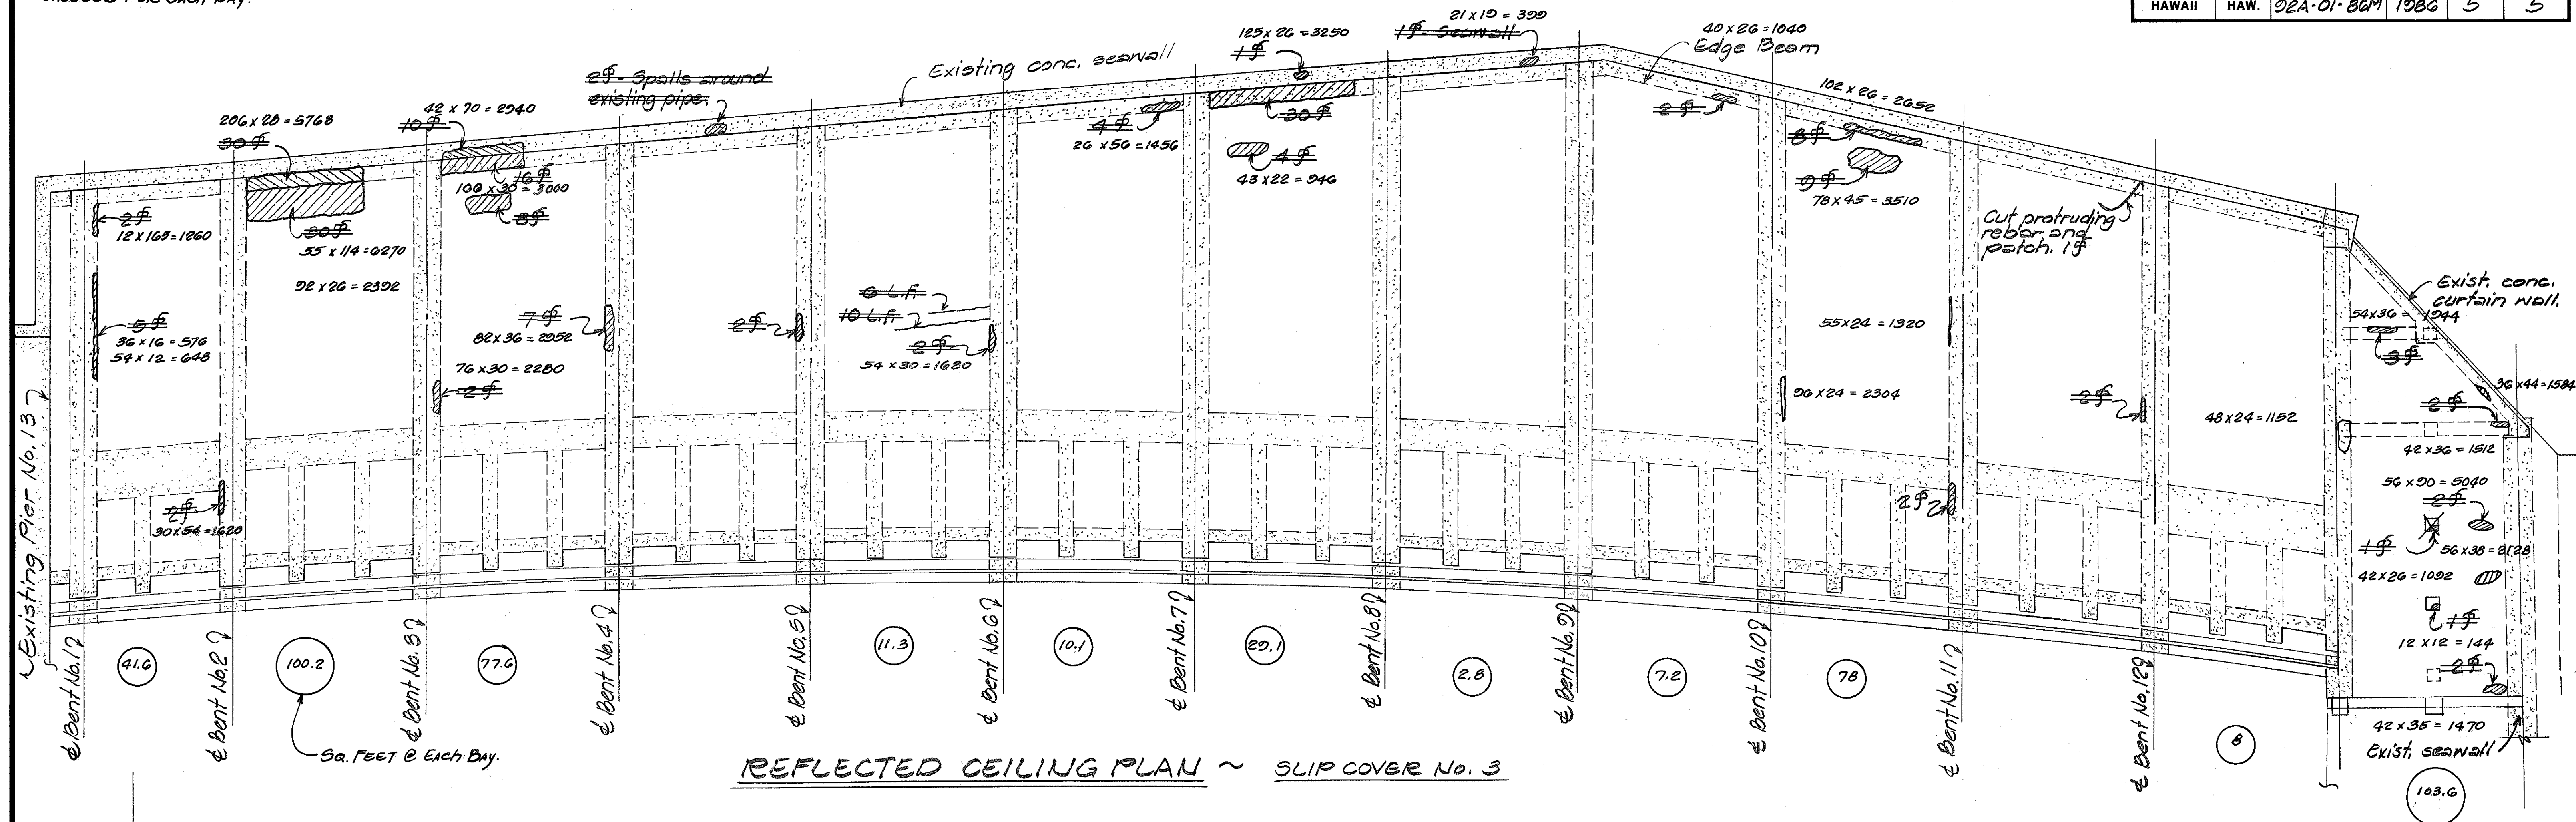

REFLECTED CEILING PLAN ~ SLIP COVER No. 3

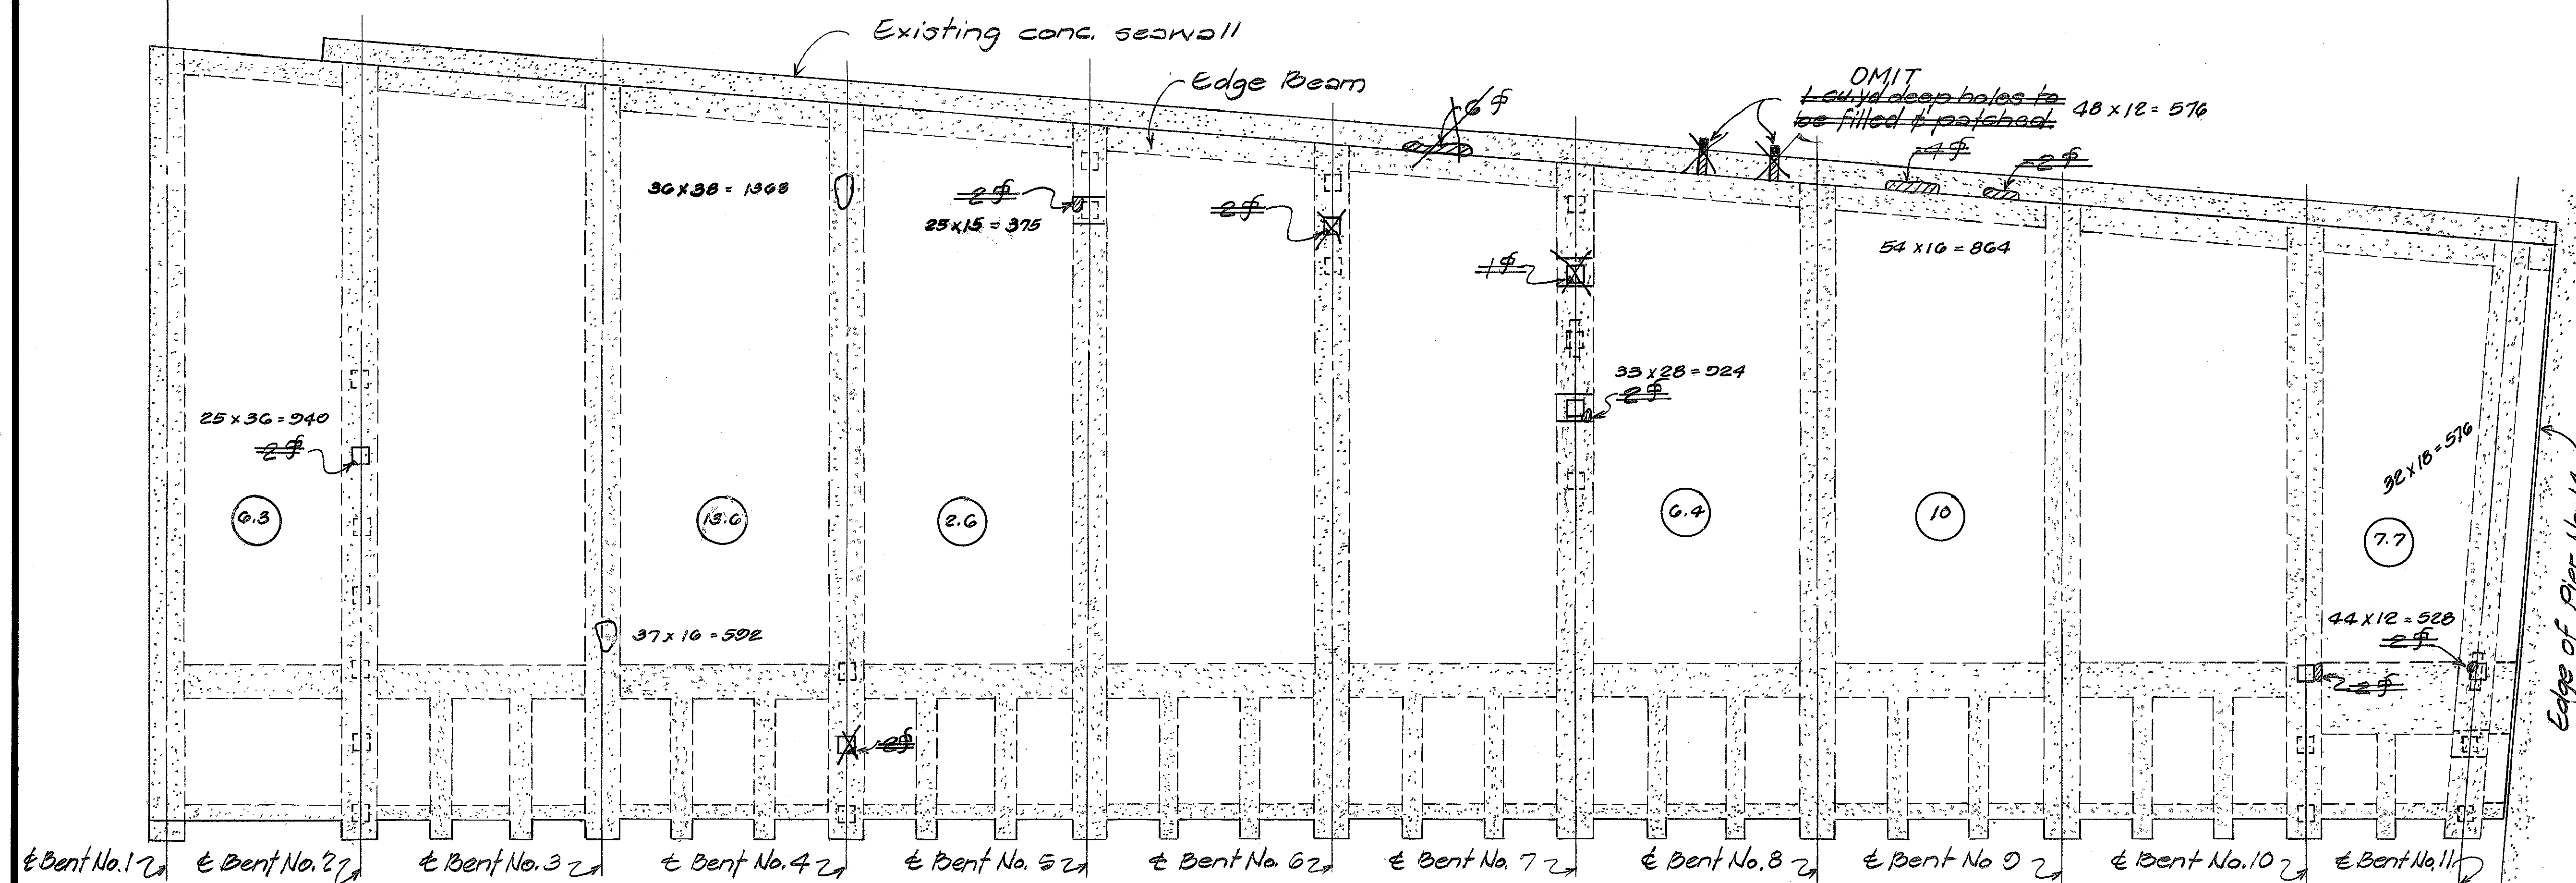

REFLECTED CEILING PLAN ~ SLIP COVER NO. 2

ORIGINAL PLAN	SURVEY PLOTTED BY _____	DATE _____
NOTE BOOK	DRAWN BY <u>SK</u>	_____
	TRACED BY _____	_____
	DESIGNED BY <u>AL</u>	_____
	QUANTITIES BY <u>AL</u>	_____
No. _____	CHECKED BY <u>SK</u>	_____
		<u>9/85</u>
		<u>9/85</u>
		<u>9/85</u>
		<u>9/85</u>

STATE OF HAWAII
DEPARTMENT OF TRANSPORTATION
HIGHWAYS DIVISION

SLIP COVERS No. 2 & No. 3

NIMITZ HIGHWAY SLIP COVERS
REPAIR SPALLED CONCRETE
Proj. No. 22A-01-86M

Scale: $1/8" = 1'-0"$ Date: Sept. 1985

SHEET NO. 4 OF 4 SHEETS