	INDEX TO DRAWINGS
SHEET NO.	DESCRIPTION
, l	TITLE SHEET
2	TYPICAL DETAILS
3 .	PROJECT SITE PLAN &
	ESTIMATED QUATITIES
4_	SLIP COVERS AT SUMNER STREET
5_	SLIP COVERS NO. 2 & NO. 3
	•
	
	•

STATE OF HAWAII


DEPARTMENT OF TRANSPORTATION
HIGHWAYS DIVISION


"AS-BUILT"
PLANS FOR

NIMITZ HIGHWAY SLIP COVERS, REPAIR SPALLED CONCRETE

PROJECT NO. 92A-01-86M

DISTRICT OF HONOLULU
ISLAND OF OAHU

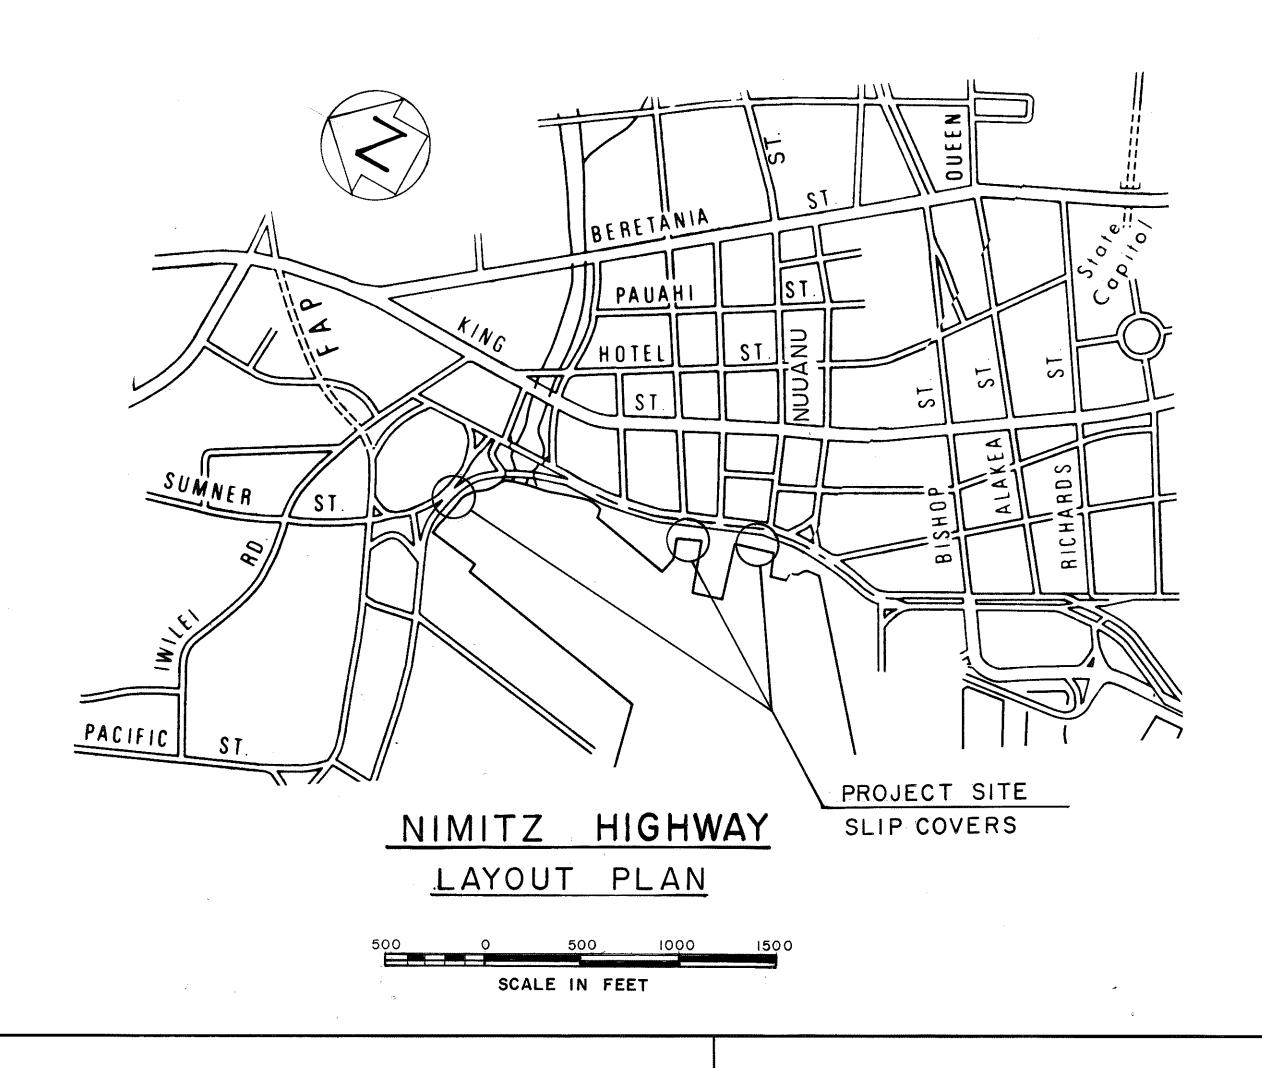

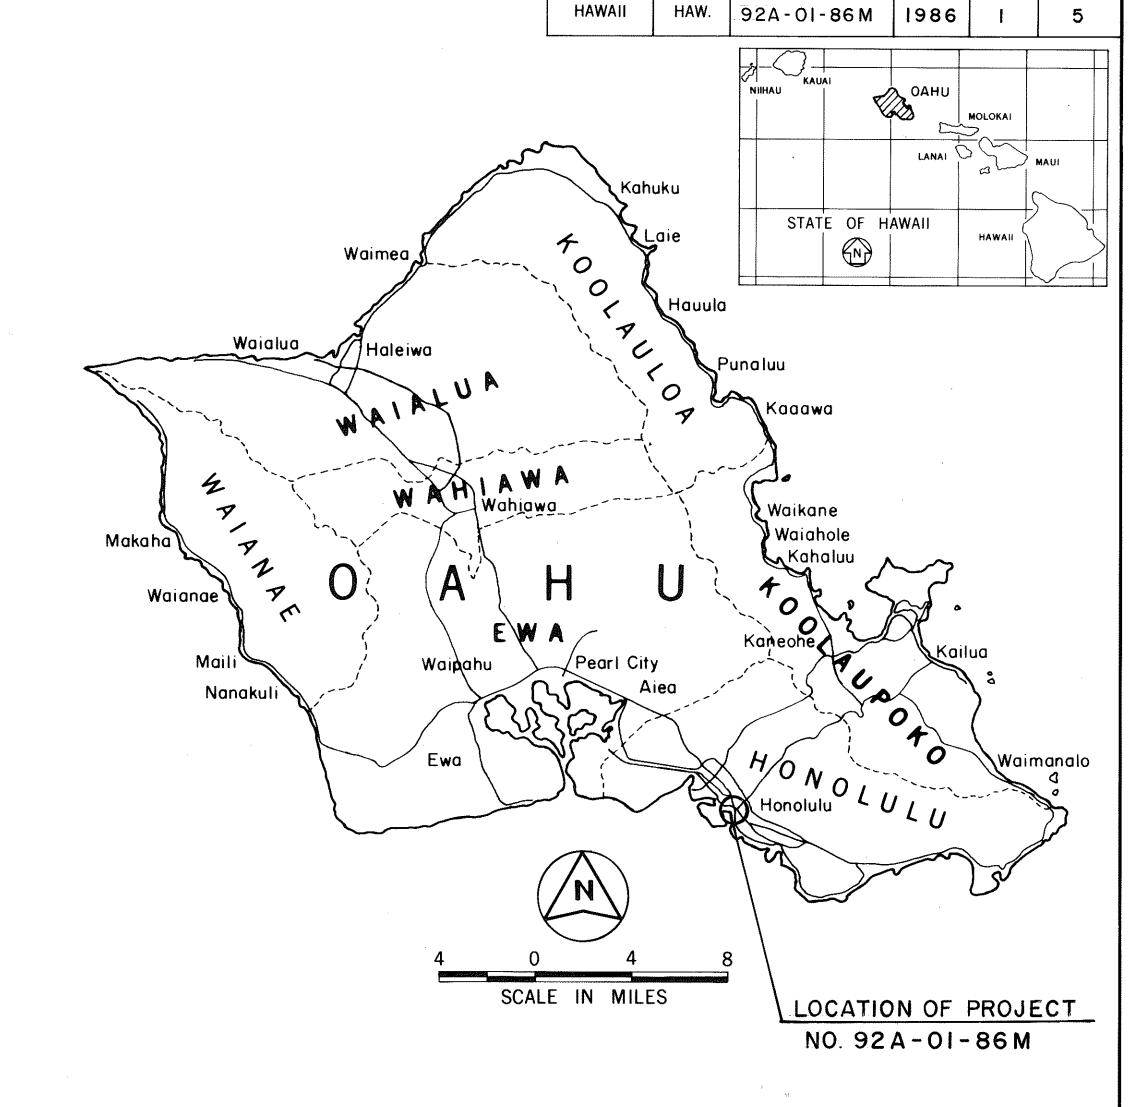

NO SIGNIFICANT CHANGES WERE MADE DURING CONSTRUCTION ON THESE PLANS EXCEPT CHANGES IN THE ORIGINAL THEORETICAL QUANTITIES. FOR ACTUAL QUANTITIES, REFER TO PROJECT LEDGER AND/OR COMPUTATION BOOK.

RESIDENT ENGINEER DATE

DEPARTMENT OF TRANSPORTATION
STATE OF HAWAII

APPROVED:

Mathen Chunich

LI-6-85

GORDIR. OF TRANSPORTATION

DATE

FISCAL SHEET TOTAL YEAR NO. SHEETS

PROJ. NO.

1-6-7-6