
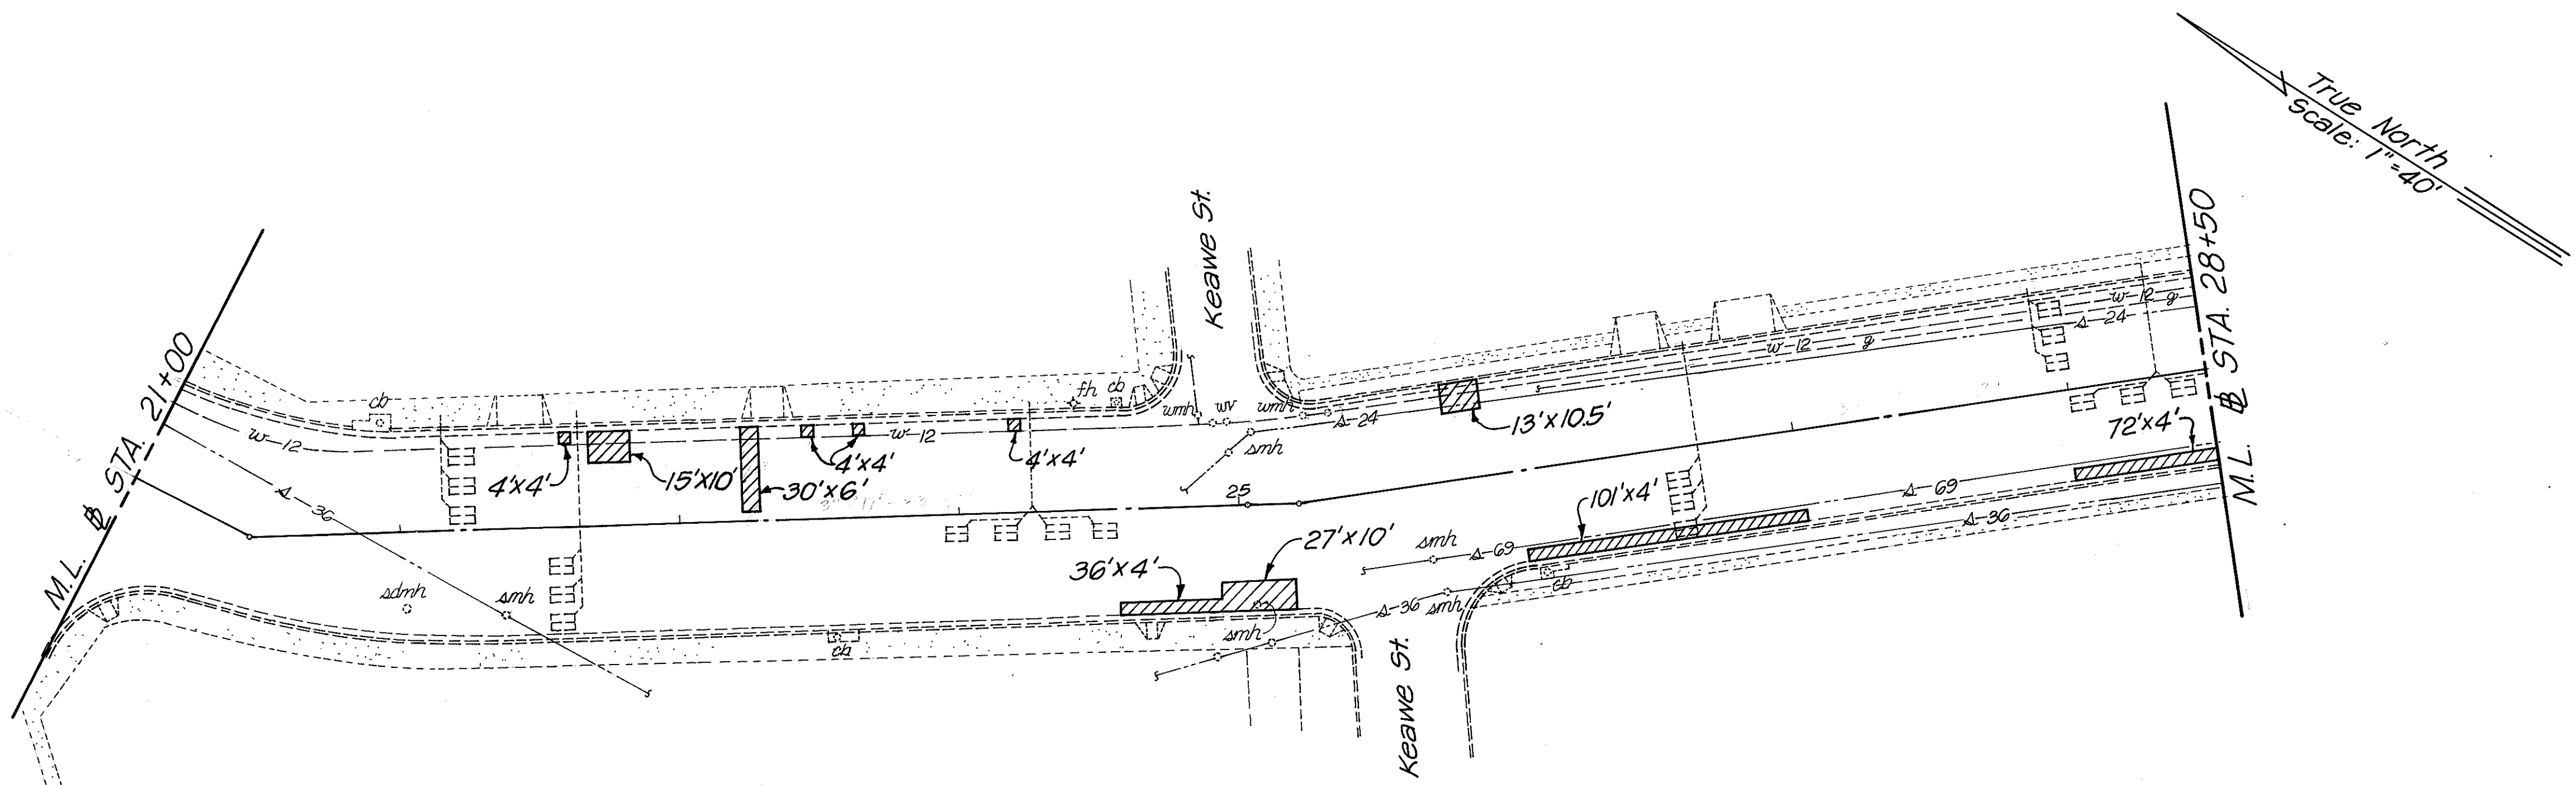


FED. ROAD DIST. NO.	STATE	FED-AID- PROJ. NO.	FISCAL YEAR	SHEET NO.	TOTAL SHEETS
HAWAII	HAW.	92A-01-88M	1988	C.O.351	9

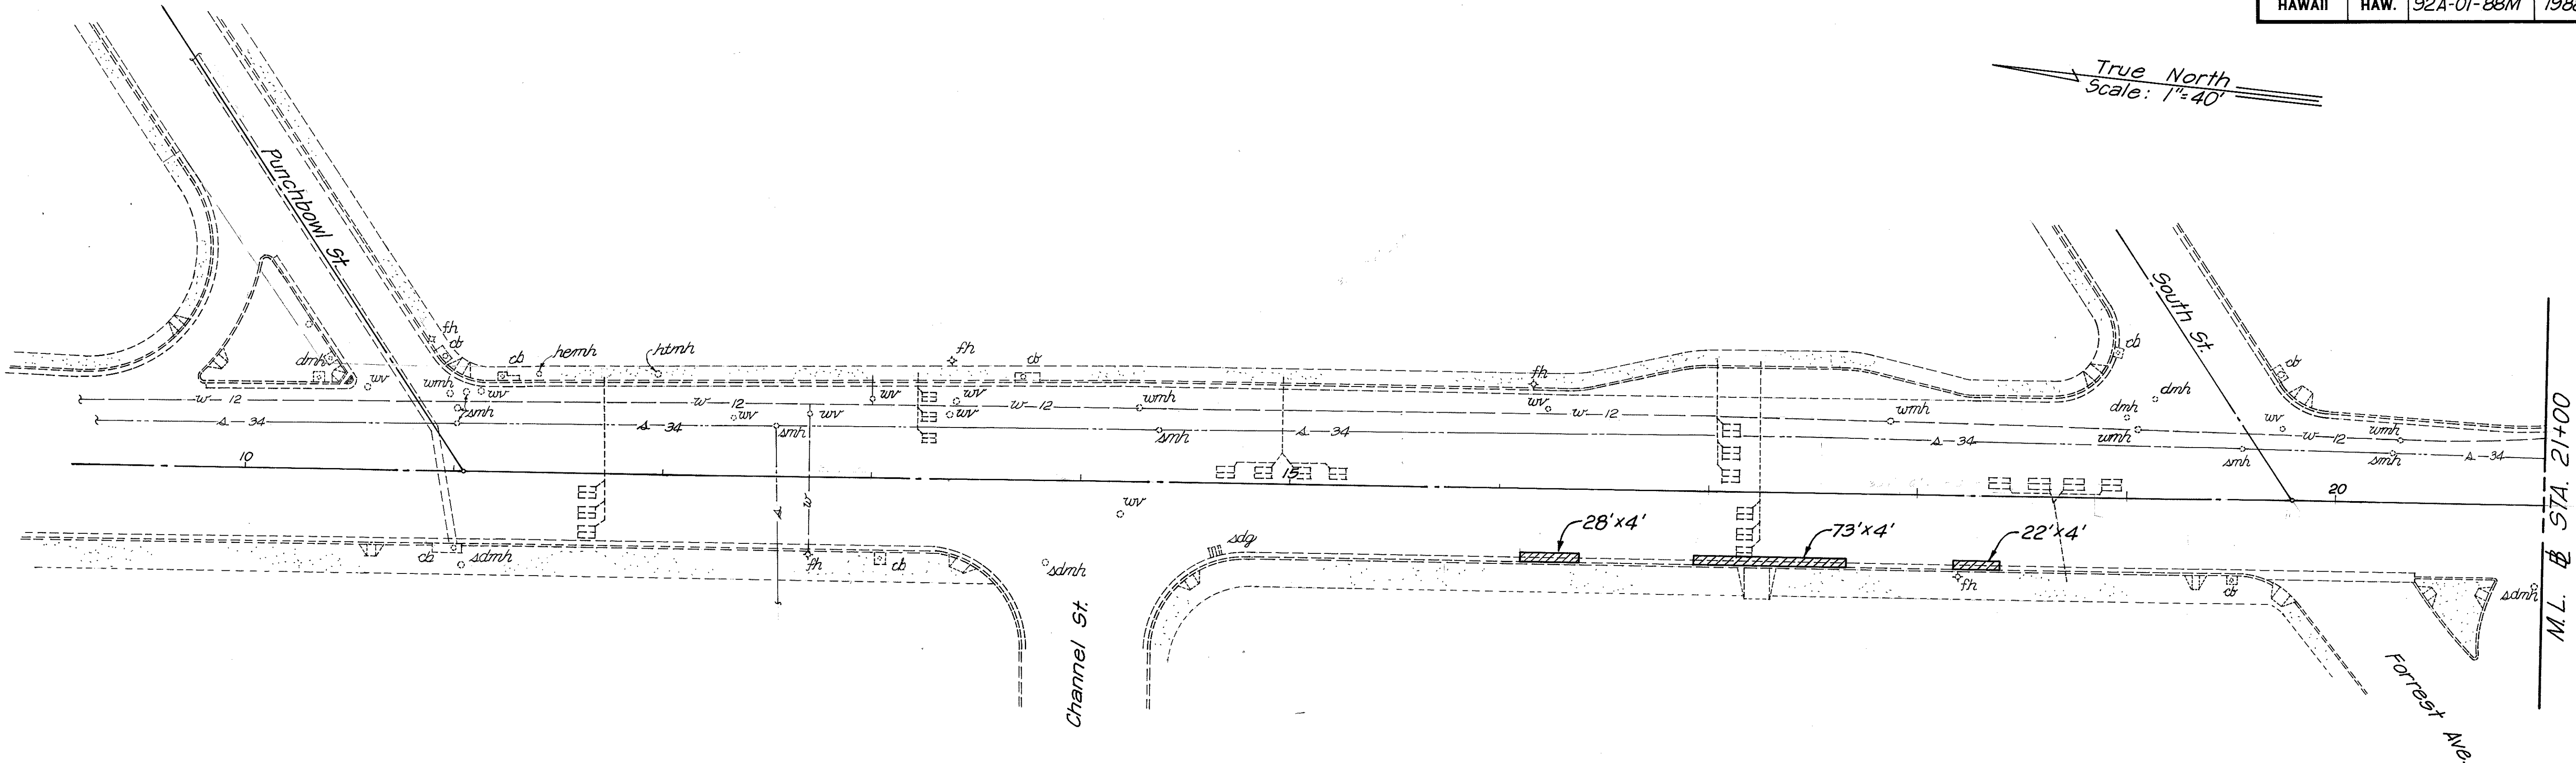


11/23/88	Added Reconstructed Areas From Punchbowl St. To Ahui St.
DATE	REVISION

STATE OF HAWAII
DEPARTMENT OF TRANSPORTATION
HIGHWAYS DIVISION

ROADWAY PLANS
ALA MOANA BLVD. RECONSTRUCTION
AHUI STREET TO HOBRON LANE
PROJECT NO. 92A-01-88M
Scale: 1"=40' Date: NOV. 1988
SHEET NO. OF SHEETS

FED. ROAD DIST. NO.	STATE	FED-AID PROJ. NO.	FISCAL YEAR	SHEET NO.	TOTAL SHEETS
HAWAII	HAW.	02A-01-88M	1988	C0352	9

True North
Scale: 1"=40'

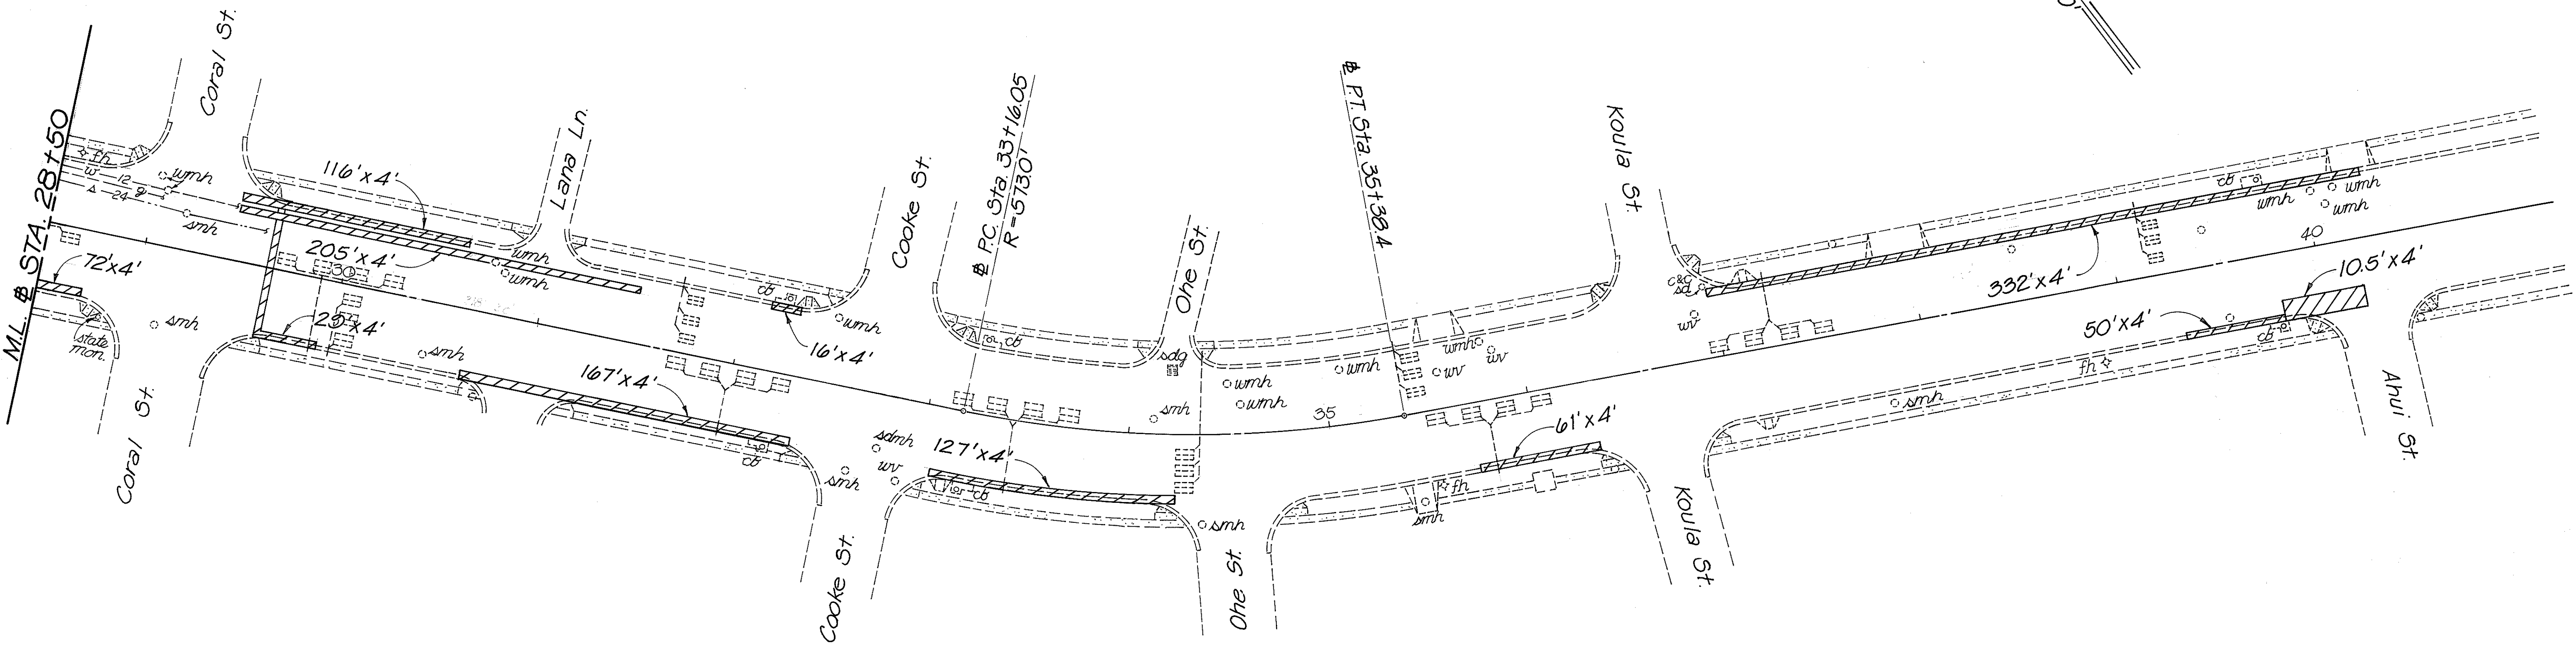

11/23/88	Added Reconstructed Areas From Punchbowl St. To Ahui St.
DATE	REVISION

STATE OF HAWAII
DEPARTMENT OF TRANSPORTATION
HIGHWAYS DIVISION

ROADWAY PLANS

ALA MOANA BLVD. RECONSTRUCTION
AHUI STREET TO HOBRON LANE

PROJECT No. 02A-01-88M


Scale: 1"=40' Date: NOV. 1988

SHEET No. OF SHEETS

C.0.3 S-2

ORIGINAL PLAN	SURVEY PLOTTED BY	DATE
NOTE BOOK	DRAWN BY	
No.	DESIGNED BY	
	CHECKED BY	

FED. ROAD DIST. NO.	STATE	PROJ. NO.	FISCAL YEAR	SHEET NO.	TOTAL SHEETS
HAWAII	HAW.	72A-01-88M	1988	4	7

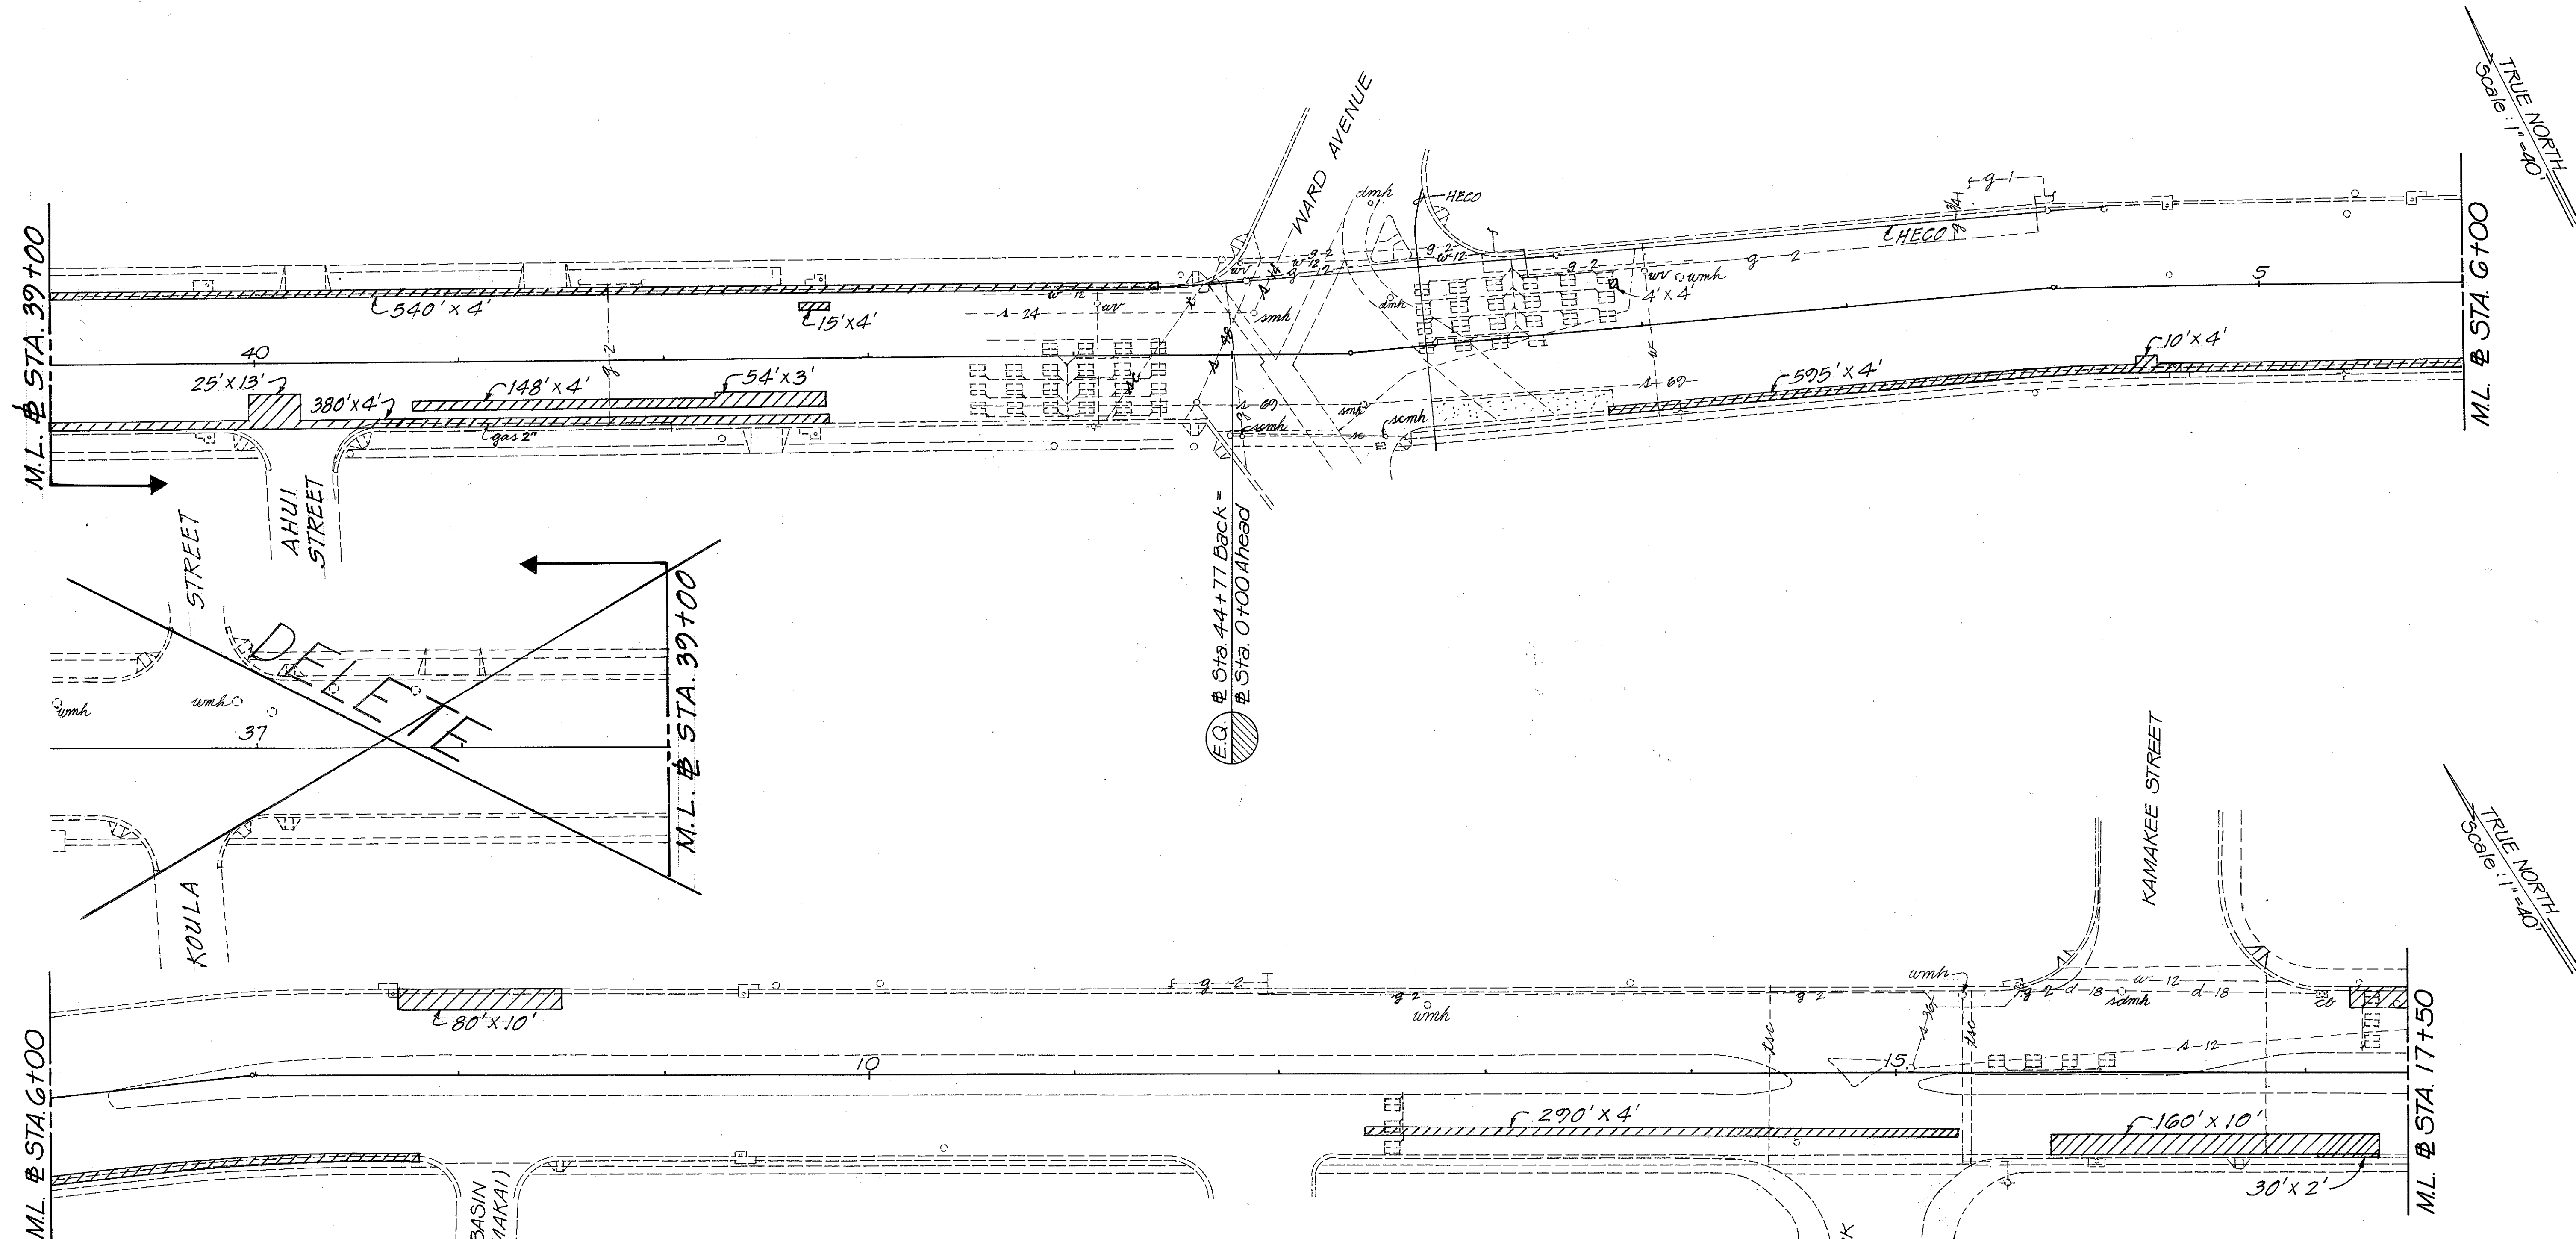

TRUE NORTH
Scale: 1"=40'

TRUE NORTH
Scale: 1"=40'

LEGEND

- s- Existing Sewer Line
- w- Existing Water Line
- smh Existing Sewer Manhole
- wmh Existing Water Manhole
- wv Existing Water Valve Box
- sdmh Existing Storm Drain Manhole
- scmhc Existing Signal Corps Manhole
- hemhc Existing Hawaiian Electric Co. Manhole
- sdg Existing Storm Drain Gate
- EE EE EE Existing Detector Loop
- Reconstruction Area
- tw- Existing Traffic Signal Cable

DATE	REVISION
11/23/88	Delete & Add to Sht. C0.3 S-2
6/16/88	Revised to include roadway from Kaula

STATE OF HAWAII
DEPARTMENT OF TRANSPORTATION
HIGHWAYS DIVISION

ROADWAY PLANS
ALA MOANA BLVD RECONSTRUCTION
AHUI STREET TO HOBRON LANE
PROJECT NO. 72A-01-88M


Scale: 1"=40' Date: May, 1988

SHEET NO. 1 OF 4 SHEETS


ORIGINAL PLAN	DATE
SURVEY PLOTTED BY	
DRAWN BY	
DESIGNED BY	
QUANTITIES BY	
CHECKED BY	
NO.	

DD-D-4-5

FED. ROAD DIST. NO.	STATE	PROJ. NO.	FISCAL YEAR	SHEET NO.	TOTAL SHEETS
HAWAII	HAW.	92A-01-88M	1988	5	9

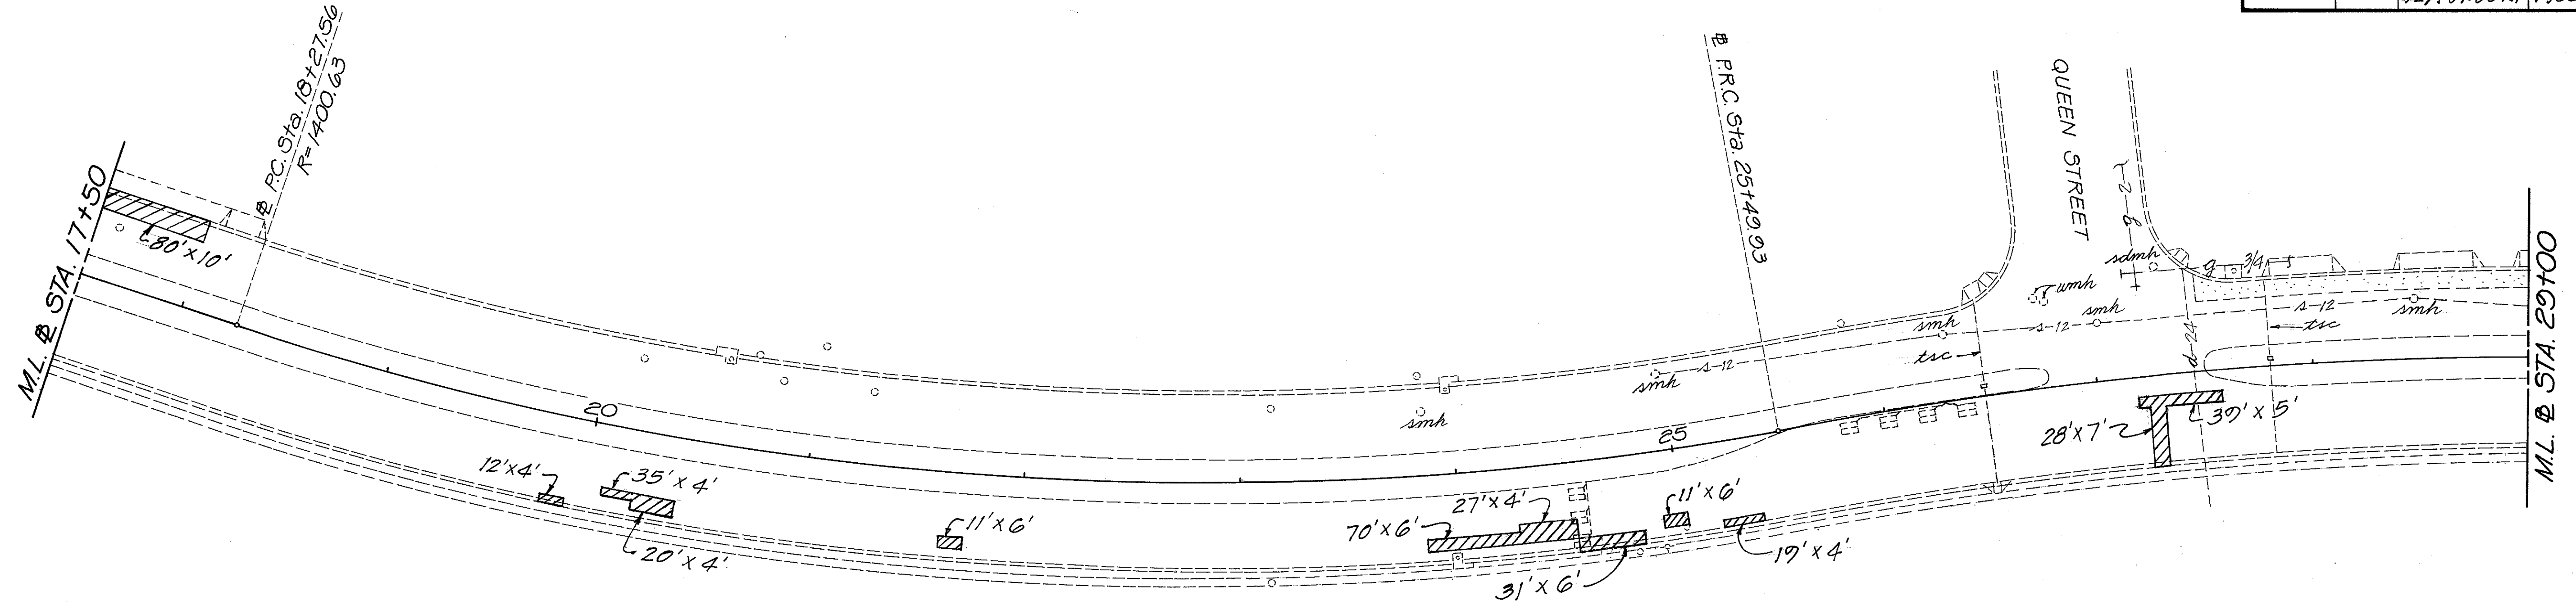

TRUE NORTH
Scale: 1"=40'

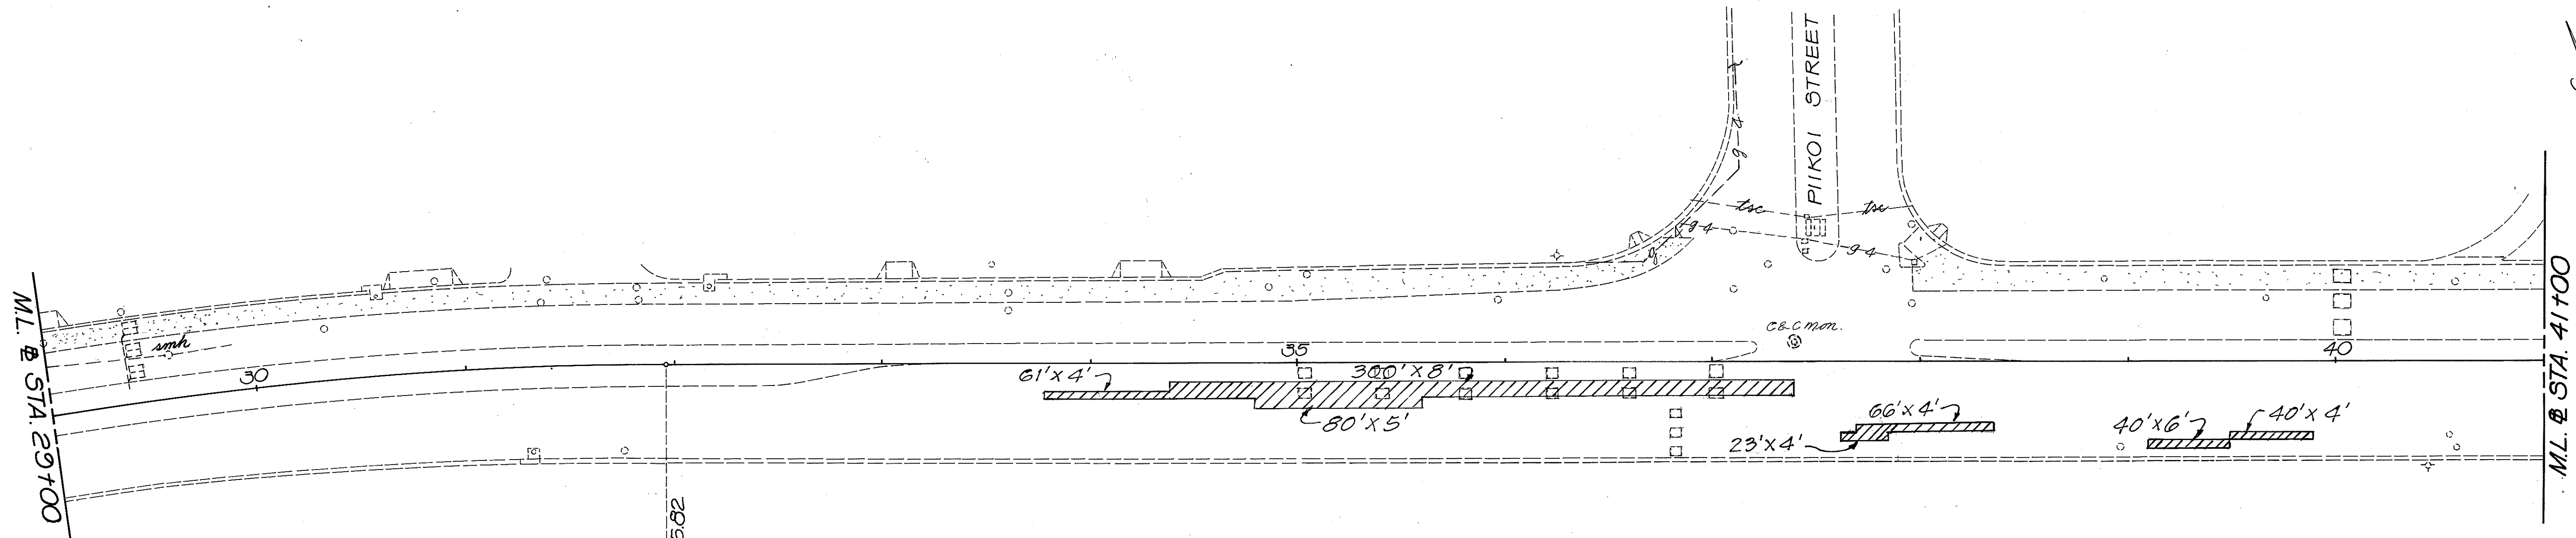

TRUE NORTH
Scale: 1"=40'

ORIGINAL PLAN	DATE
SURVEY PLOTTED BY	
DRAWN BY	
DESIGNED BY	
QUANTITIES BY	
CHECKED BY	
NO.	

6/10/88	Revised to show existing loop detectors.
DATE	REVISION

STATE OF HAWAII
DEPARTMENT OF TRANSPORTATION
HIGHWAYS DIVISION

ROADWAY PLANS

ALAMOANA BLVD RECONSTRUCTION
AHUI STREET TO HOBRON LANE

PROJECT NO. 92A-01-88M

Scale: 1"=40' Date: May 1988

SHEET NO. 2 OF 4 SHEETS

FED. ROAD DIST. NO.	STATE	PROJ. NO.	FISCAL YEAR	SHEET NO.	TOTAL SHEETS
HAWAII	HAW.	72A-01-88M	1988	6	7

TRUE NORTH
Scale: 1" = 40'

TRUE NORTH
Scale: 1" = 40'

6/16/88	Revised to show existing loop detectors.
DATE	REVISION

STATE OF HAWAII
DEPARTMENT OF TRANSPORTATION
HIGHWAYS DIVISION



ROADWAY PLANS

ALA MOANA BLVD RECONSTRUCTION
AHUI STREET TO HOBSON LANE

PROJECT NO. 72A-01-88M


Scale: 1" = 40' Date: May, 1988

SHEET NO. 3 OF 4 SHEETS

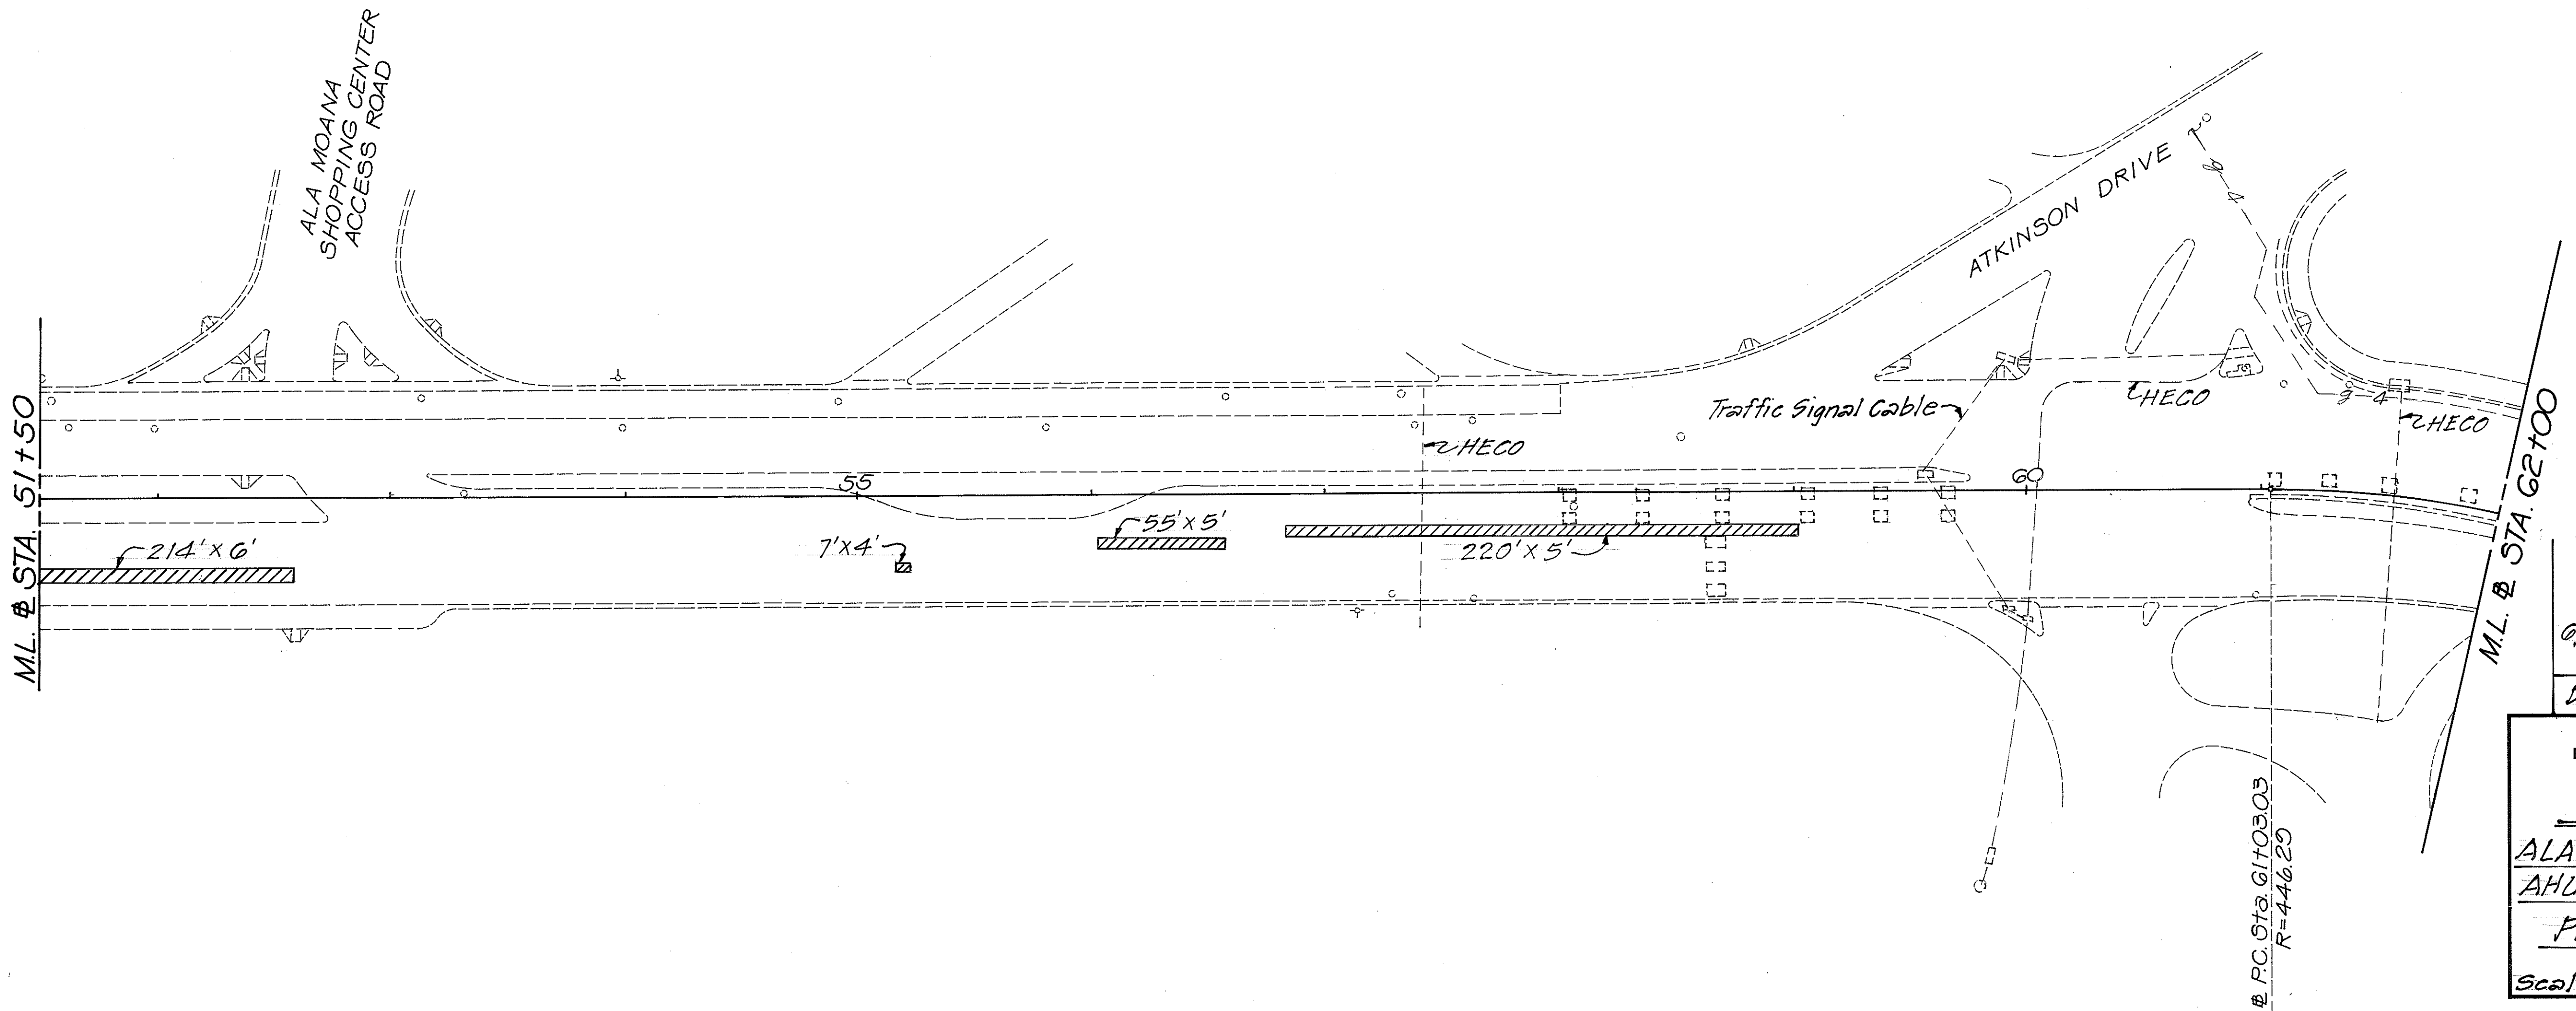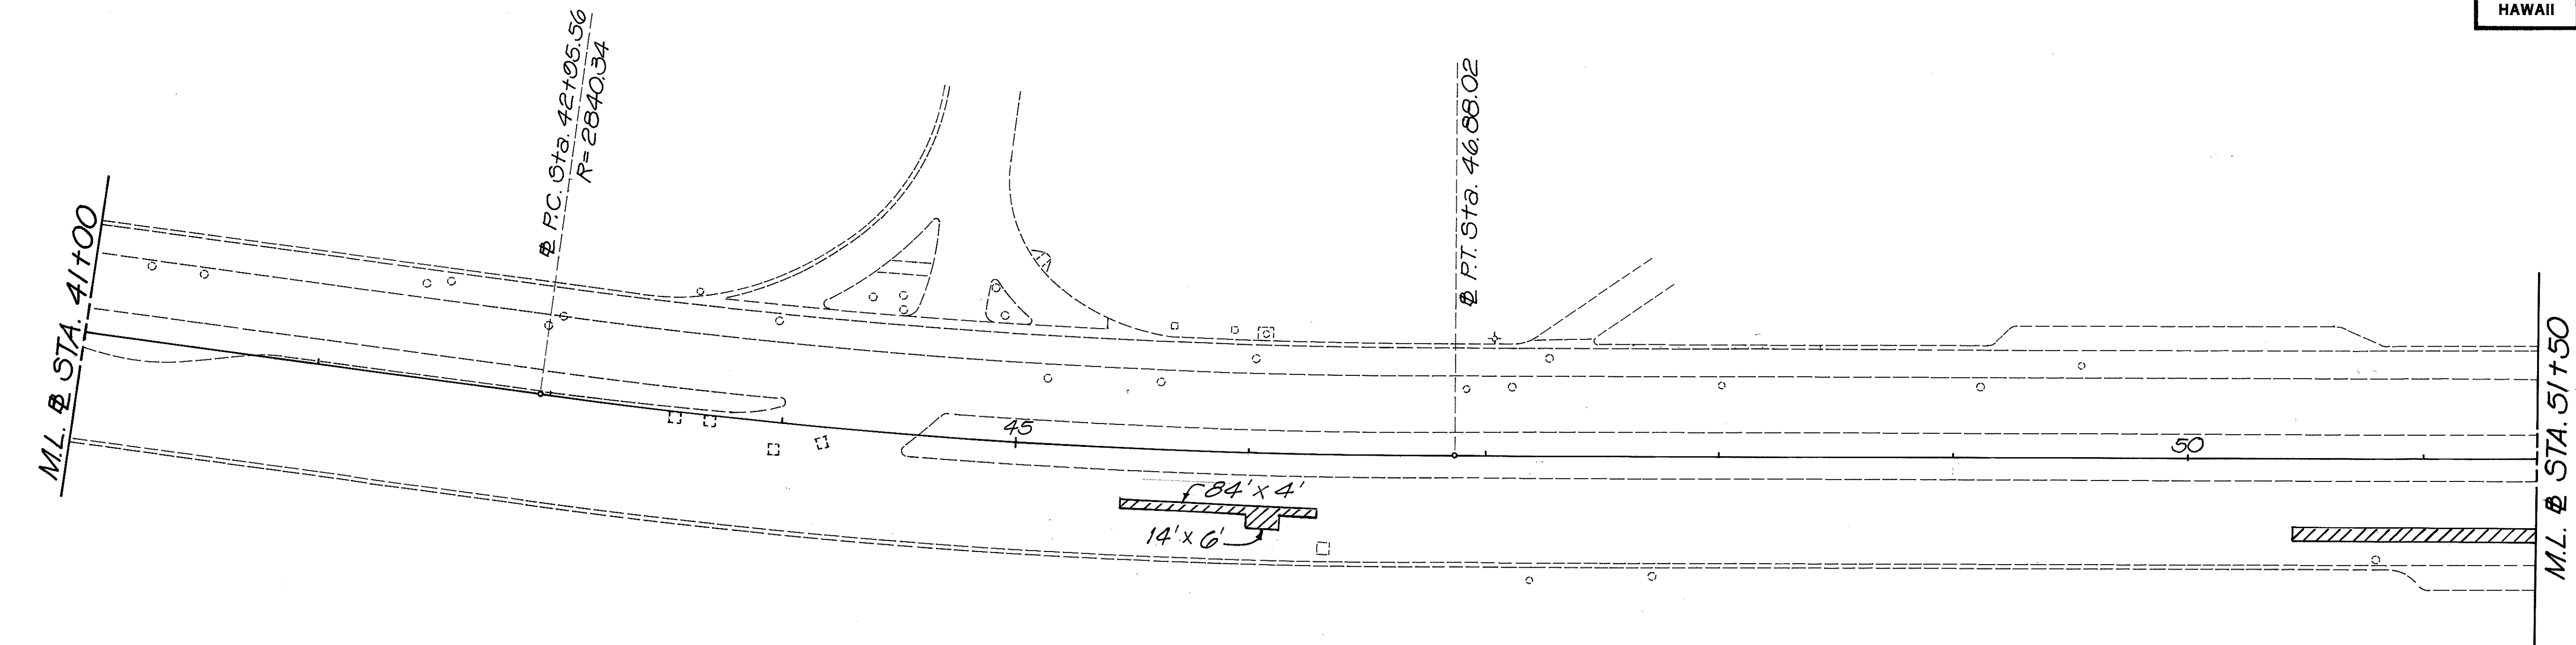

ORIGINAL PLAN	DATE
NOTED BY	
DESIGNED BY	
CHECKED BY	


FED. ROAD DIST. NO.	STATE	PROJ. NO.	FISCAL YEAR	SHEET NO.	TOTAL SHEETS
HAWAII	HAW.	92A-01-88M	1988	7	9

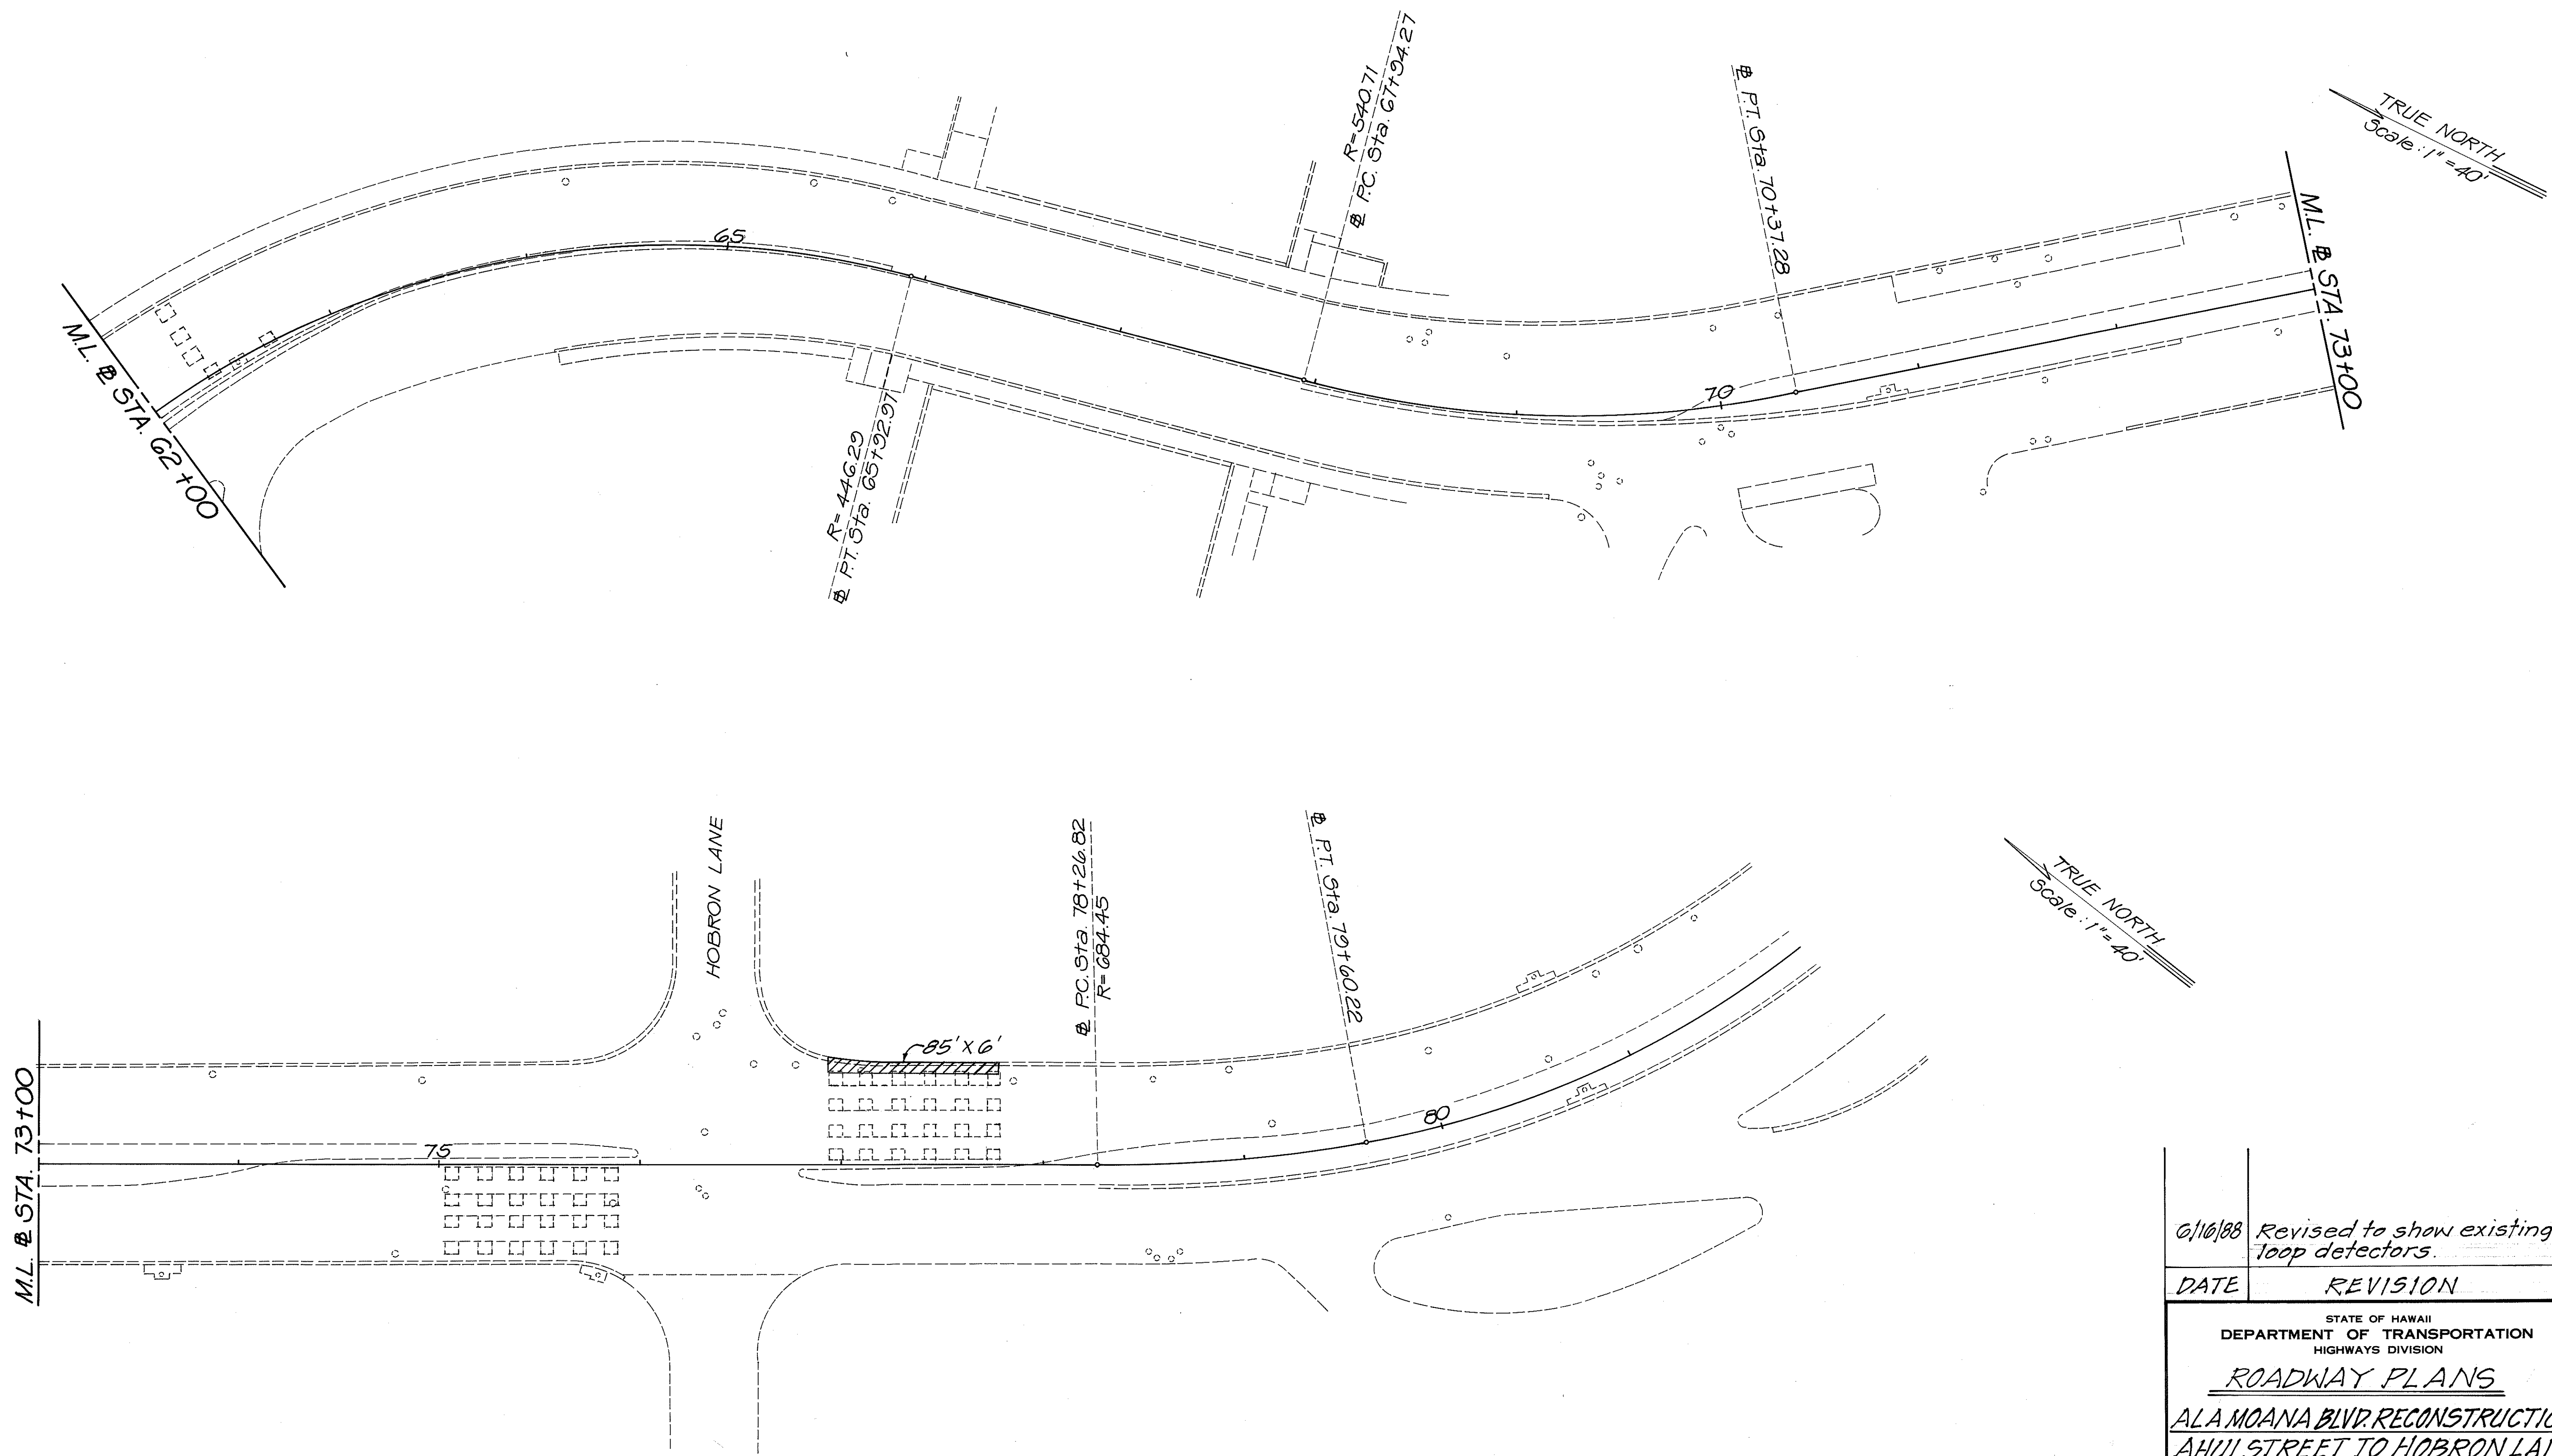

ORIGINAL PLAN	DATE
DESIGNED BY	
DRAWN BY	
CHECKED BY	
NOTED BY	
QUANTITIES BY	
CHECKED BY	
NO.	

6/16/88	Revised to show existing loop detectors.
DATE	REVISION
STATE OF HAWAII DEPARTMENT OF TRANSPORTATION HIGHWAYS DIVISION	
ROADWAY PLANS	
ALAMOANA BLVD. RECONSTRUCTION	
AHUI STREET TO HOBRON LANE	
PROJECT NO. 92A-01-88M	
Scale: 1" = 40'	Date: May, 1988
SHEET No. 4 OF 4 SHEETS	

FED. ROAD DIST. NO.	STATE	FED-AID- PROJ. NO.	FISCAL YEAR	SHEET NO.	TOTAL SHEETS
HAWAII	HAW.	92A-01-88M	1988	C07 S-1	9

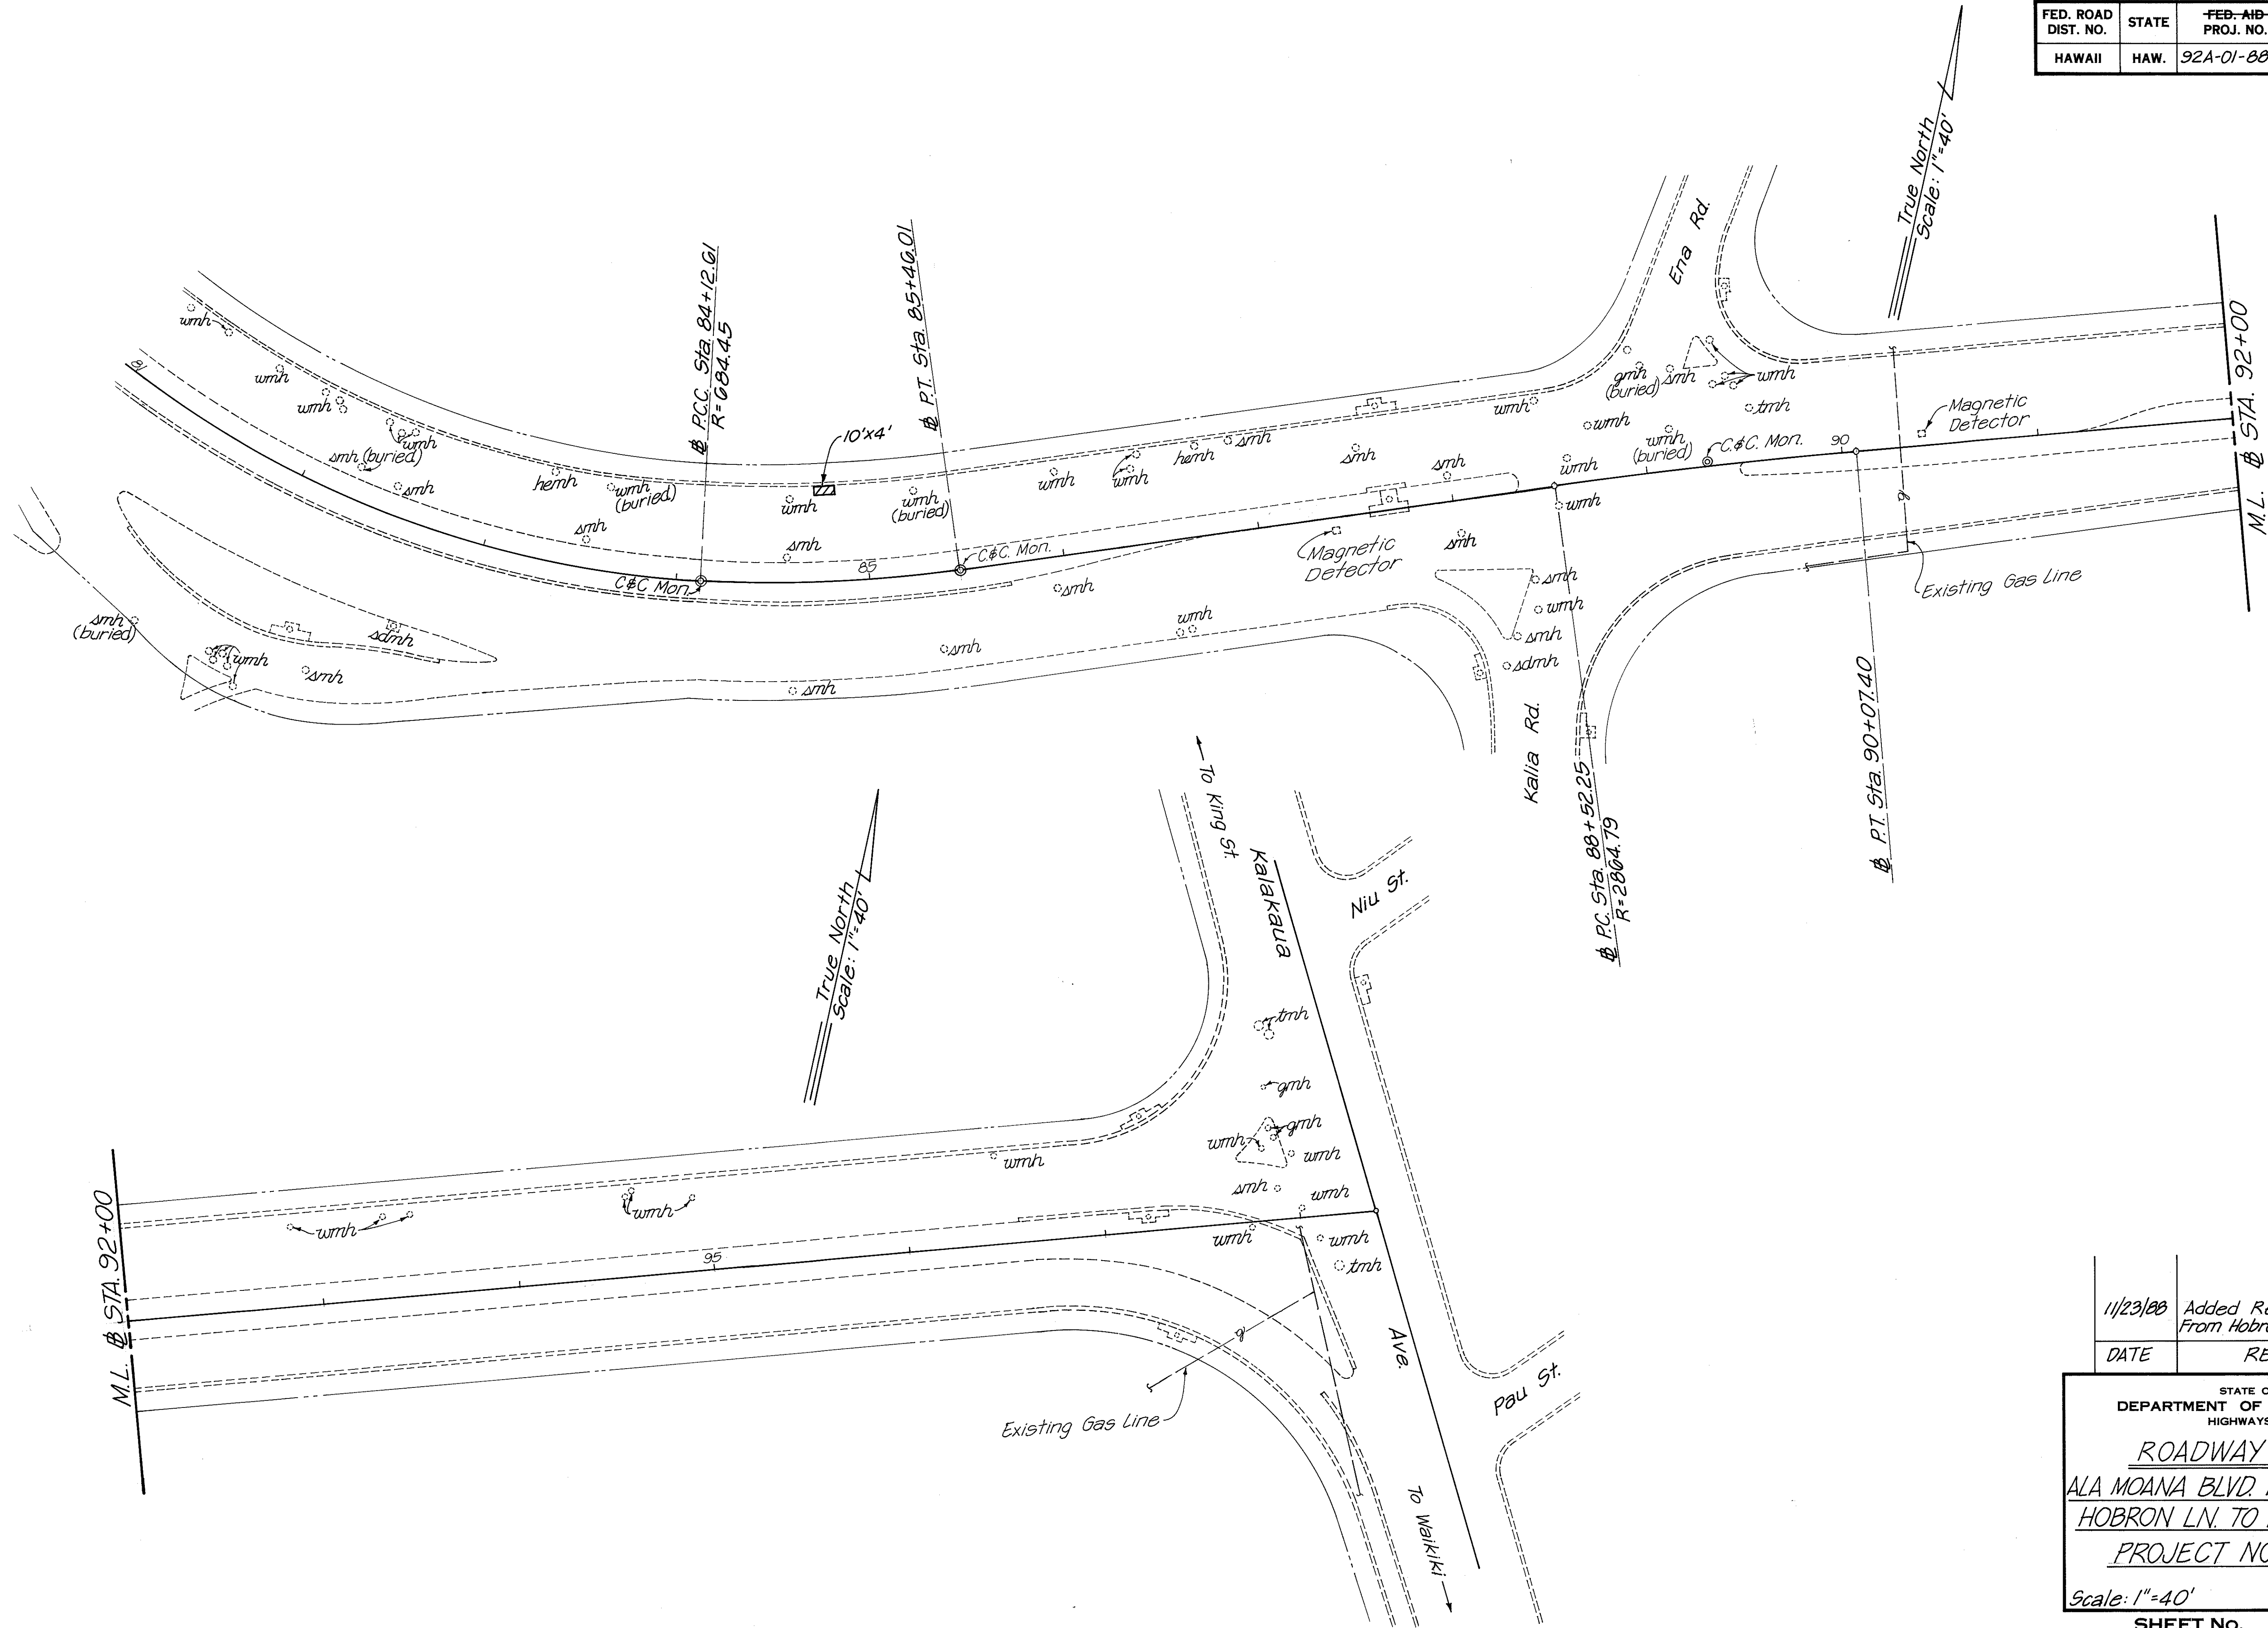

ORIGINAL PLAN	SURVEY PLOTTED BY	DATE
NOTE BOOK	DRAWN BY	
No.	DESIGNED BY	
	CHECKED BY	

11/23/88	Added Reconstructed Areas From Hobron Ln. to Ena Rd.
DATE	REVISION

STATE OF HAWAII
DEPARTMENT OF TRANSPORTATION
HIGHWAYS DIVISION

ROADWAY PLANS
ALA MOANA BLVD. RECONSTRUCTION
HOBRON LN. TO KALAKAUA AVE.
PROJECT NO. 92A-01-88M
Scale: 1"=40' Date: Nov. 1988