




FED. ROAD DIST. NO.	STATE	PROJ. NO.	FISCAL YEAR	SHEET NO.	TOTAL SHEETS
HAWAII	HAW.	92AB-01-92M	1992	6	32

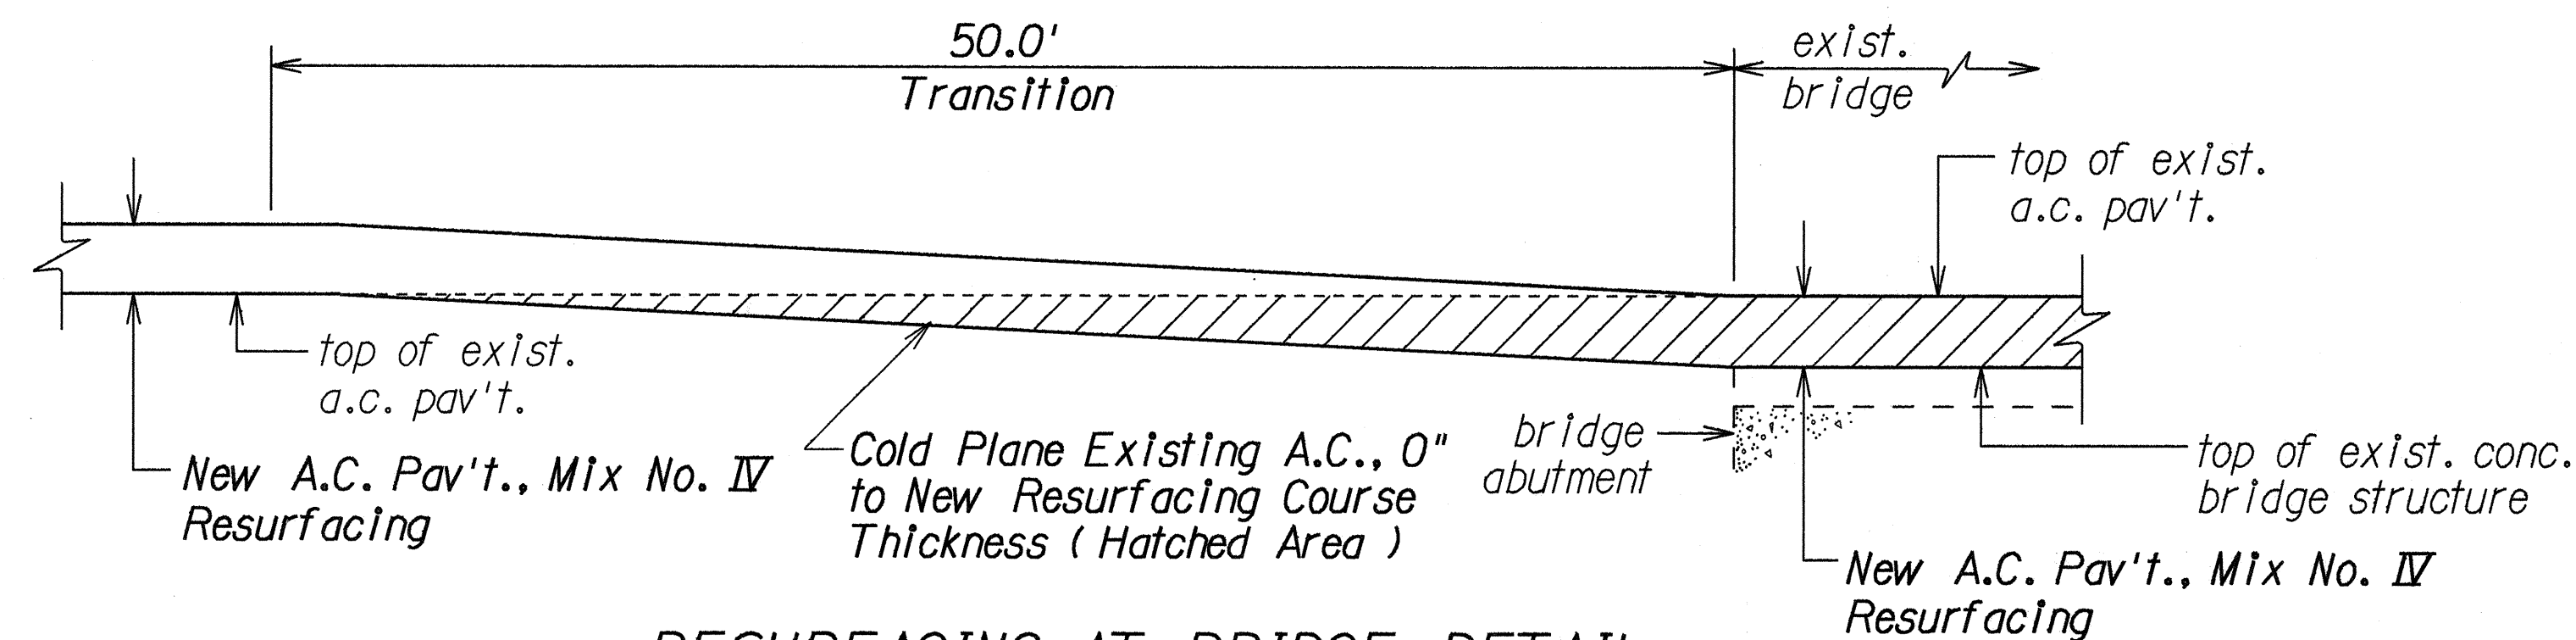


RESURFACING AT BRIDGE DETAIL
Not to Scale

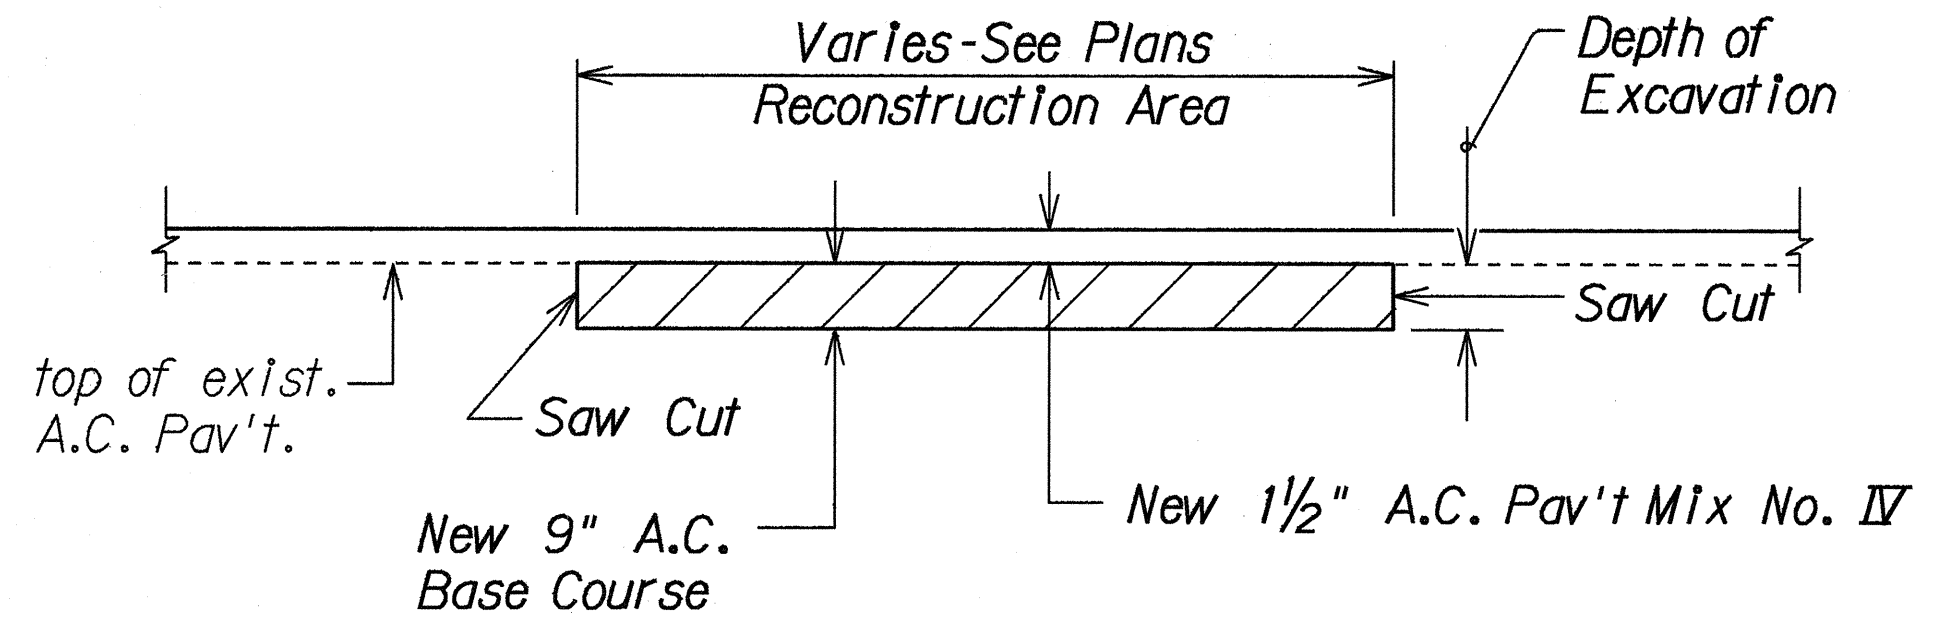


A.C. PAVEMENT RECONSTRUCTION DETAIL
Not To Scale

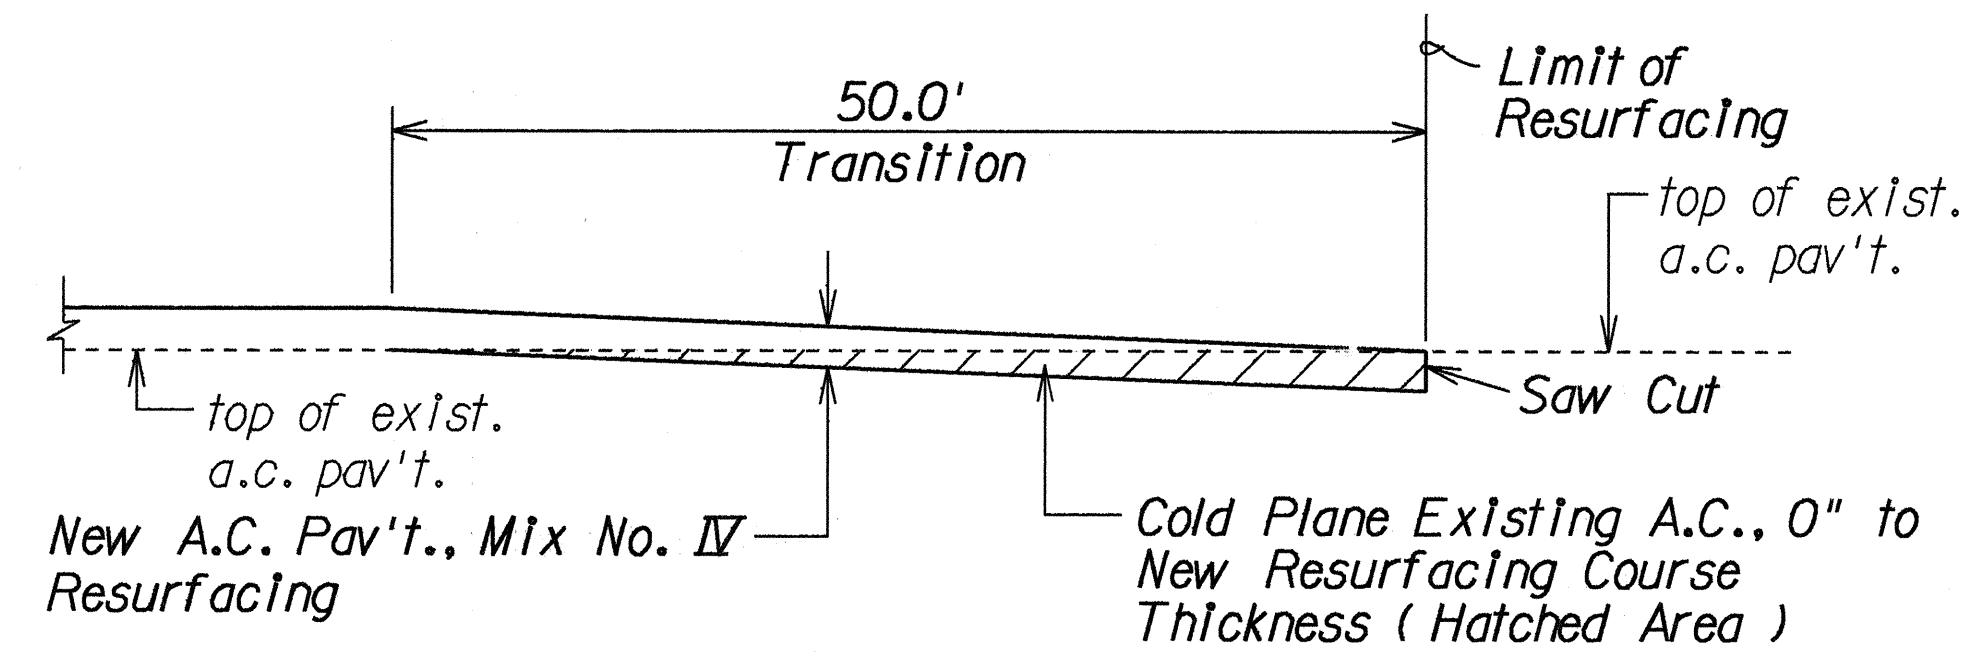


COLD PLANED TRANSITION TO EXISTING A.C. PAVEMENT DETAIL
Not To Scale

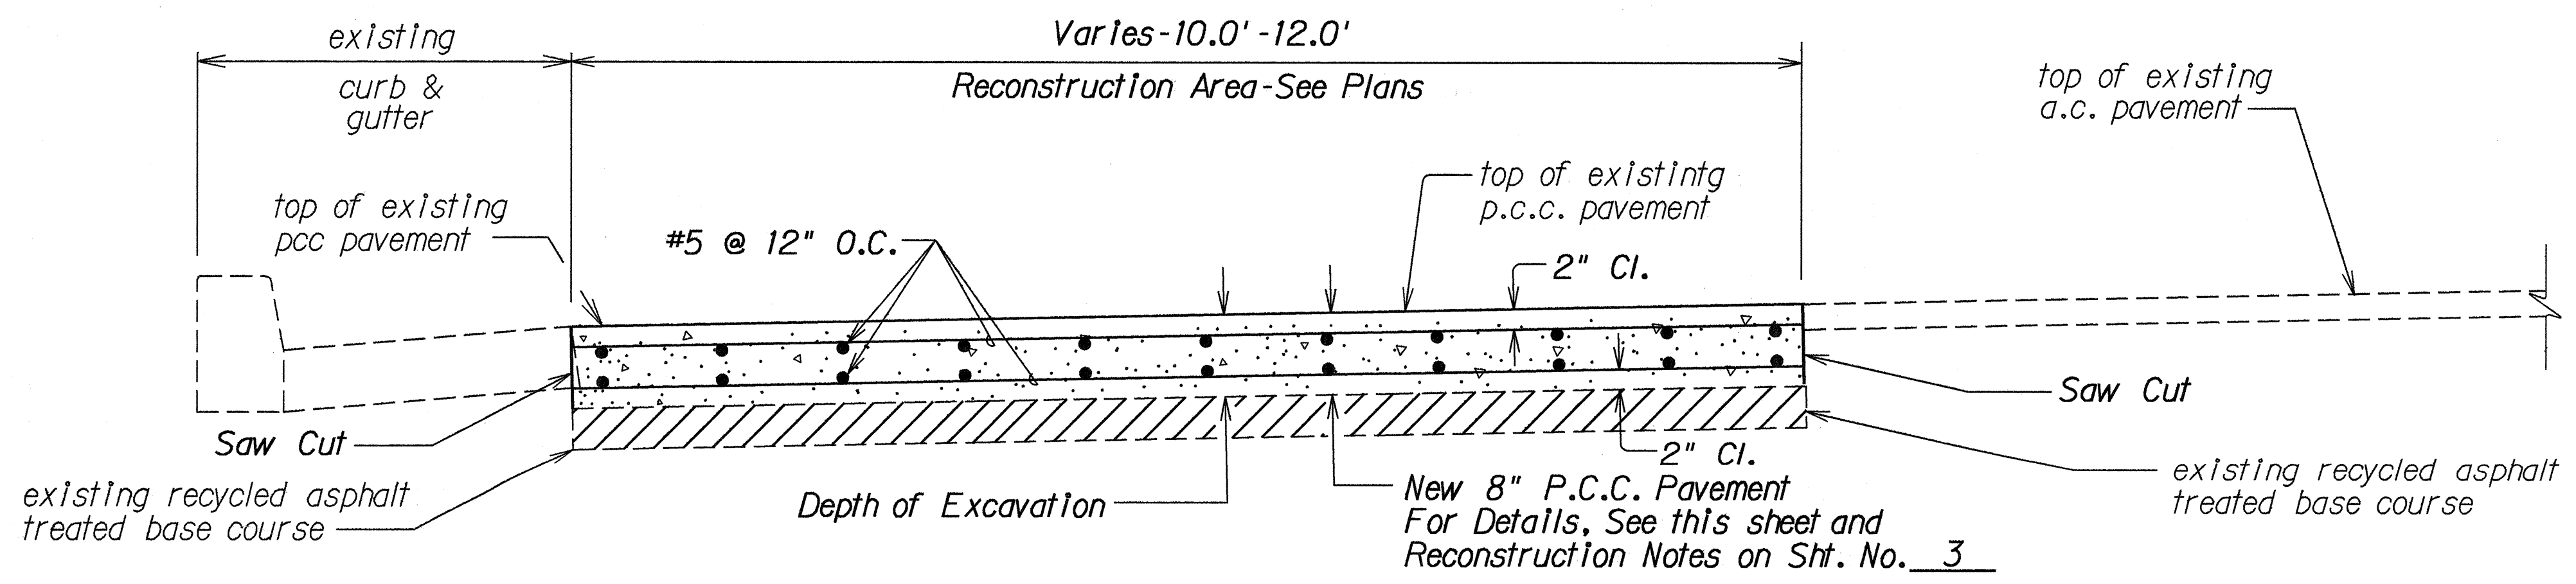


P.C.C. PAVEMENT RECONSTRUCTION DETAIL
Not to Scale

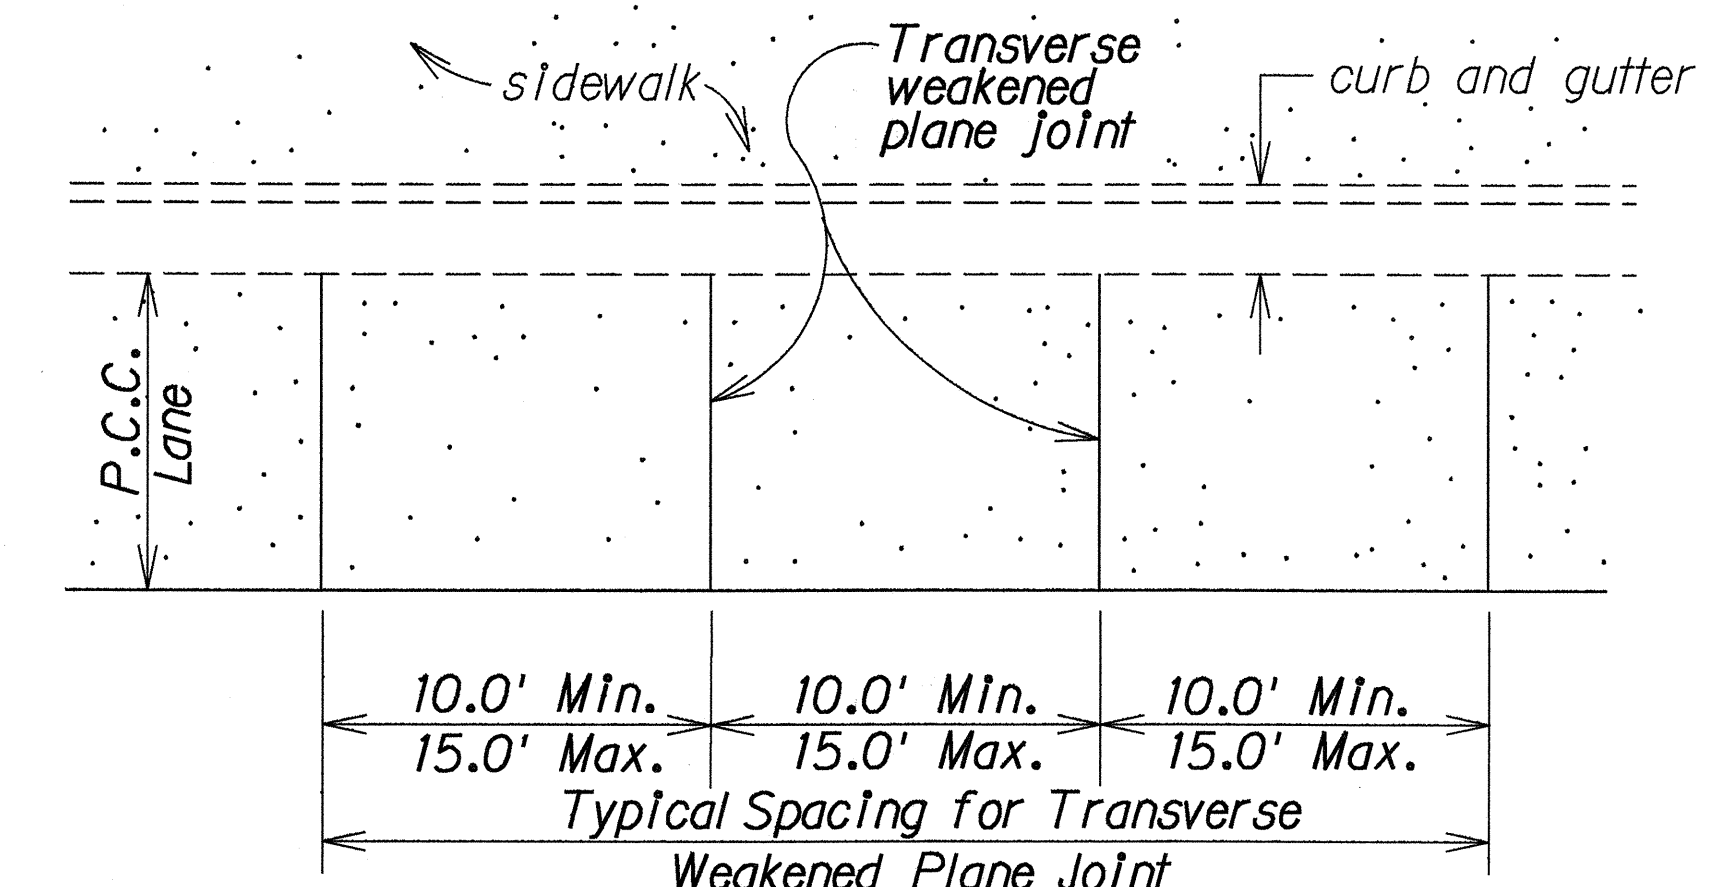

TYPICAL JOINT LOCATION AND LAYOUT PLAN
Not To Scale

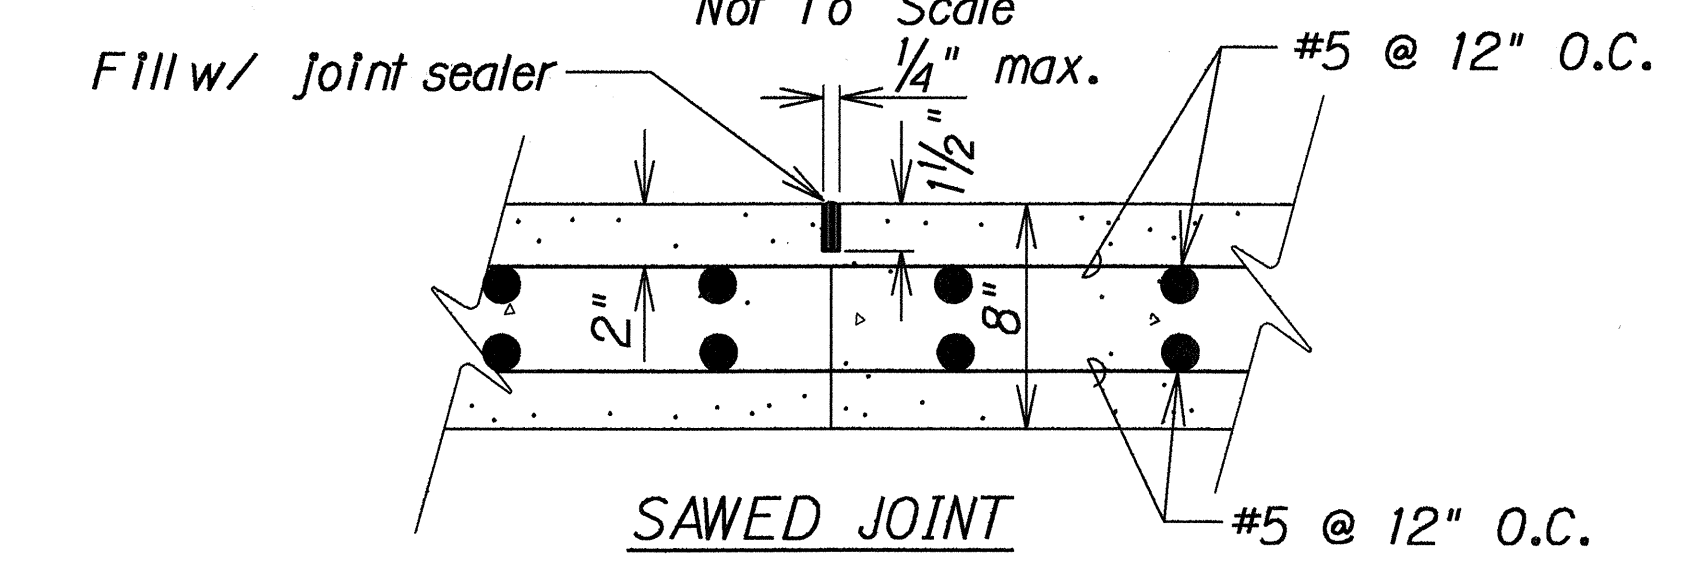

TRANSVERSE WEAKENED PLANE (CONTRACTION) JOINT
Not To Scale

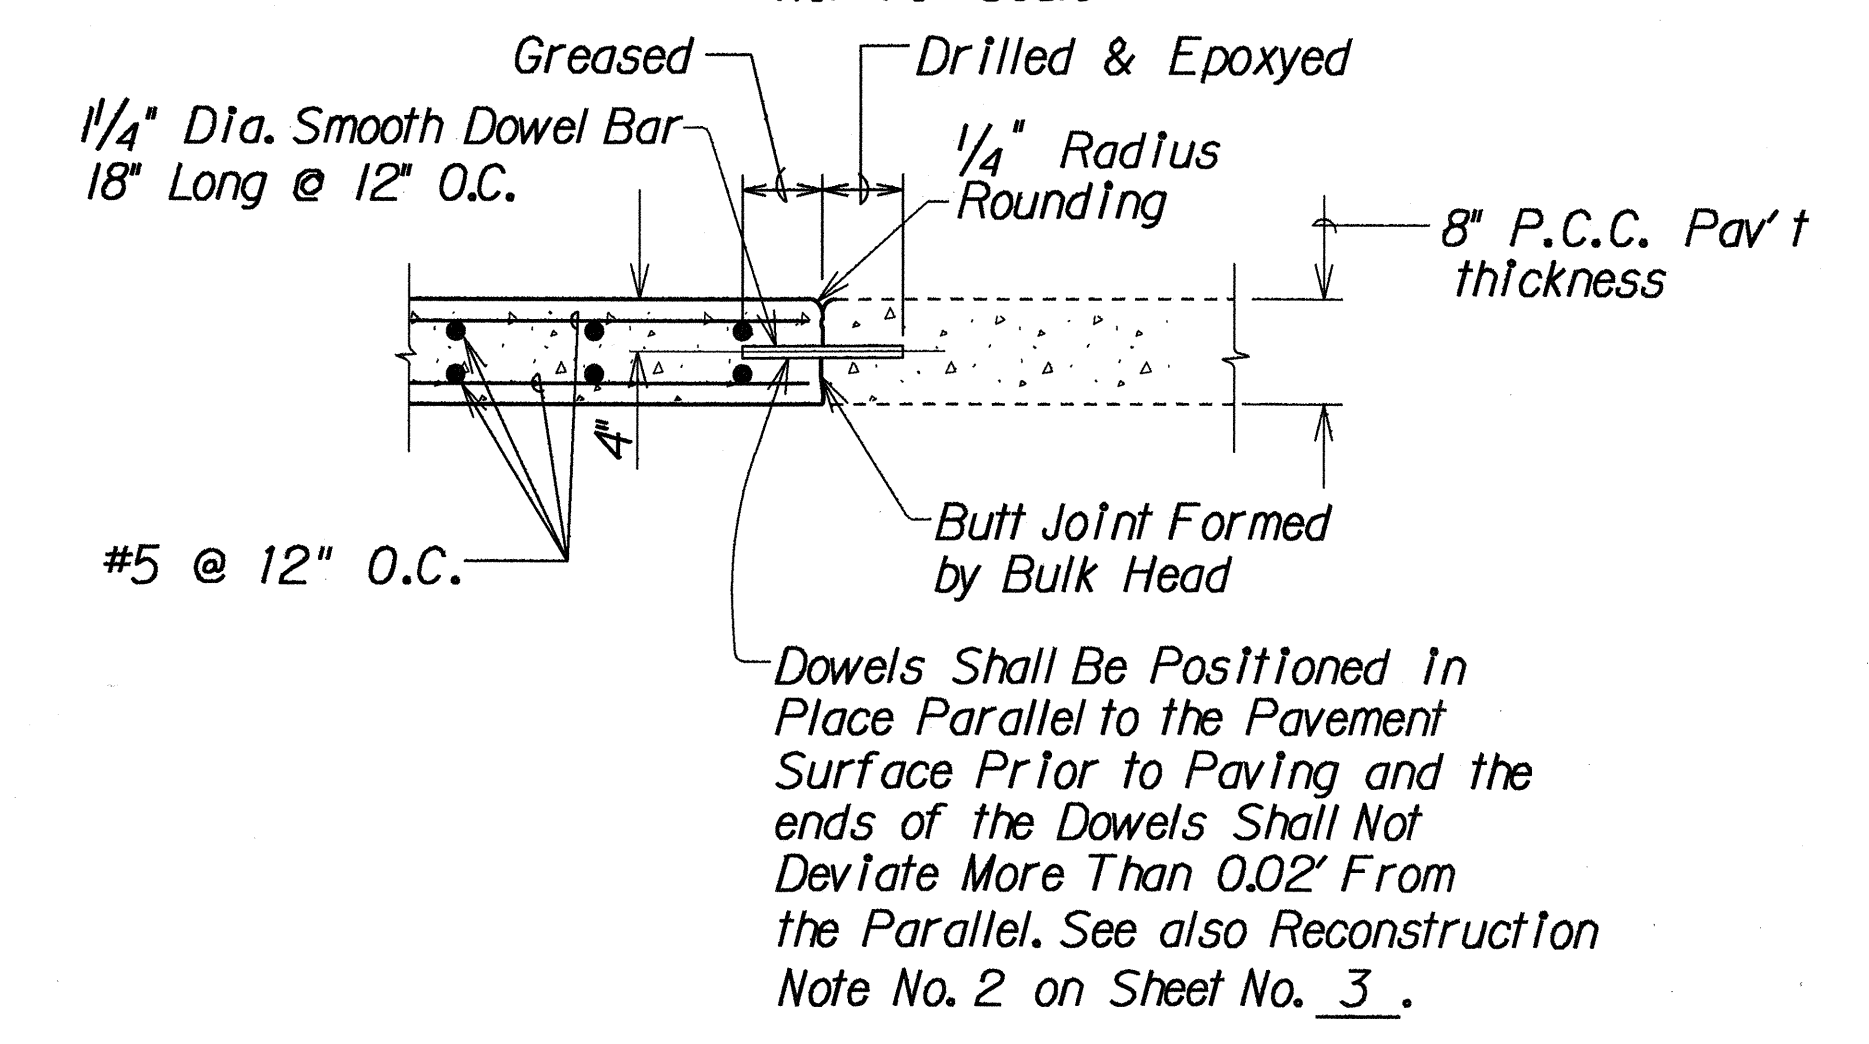

TRANSVERSE CONSTRUCTION JOINT
Not To Scale

STATE OF HAWAII
DEPARTMENT OF TRANSPORTATION
HIGHWAYS DIVISION

MISCELLANEOUS DETAILS

**ALA MOANA BOULEVARD
RESURFACING**

Keawe Street to Kalakaua Avenue

Project No. 92AB-01-92M

Scale: None Date: Dec., 1991

SHEET No. 1 OF 1 SHEETS