	INDEX TO DRAWINGS										
SHEET NO.	DESCRIPTION										
1	TITLE SHEET										
2	STANDARD PLANS SUMMARY										
3	GENERAL NOTES										
4	NPDES GENERAL NOTES										
5 – 14	TYPICAL SECTIONS & DETAILS										
15 – 22	MISCELLANEOUS DETAILS										
23	GUARDRAIL SCHEDULE										
24	LEGEND										
25	PLAN SHEET KEY MAP										
26 – 43	PLANS										
44 – 76	PAVEMENT MARKING AND SIGNING PLANS, DETAILS AND SCHEDULES										
	·										
,											

STATE OF HAWAII

## DEPARTMENT OF TRANSPORTATION


HIGHWAYS DIVISION HONOLULU, HAWAII "AS-BUILT"

PLANS FOR

## NIMITZ HIGHWAY RESURFACING

NIMITZ GATE TO RODGERS BOULEVARD AND RAMPS FEDERAL AID PROJECT NO. NH-092-1(22)

> DISTRICTS OF EWA & HONOLULU ISLAND OF OAHU

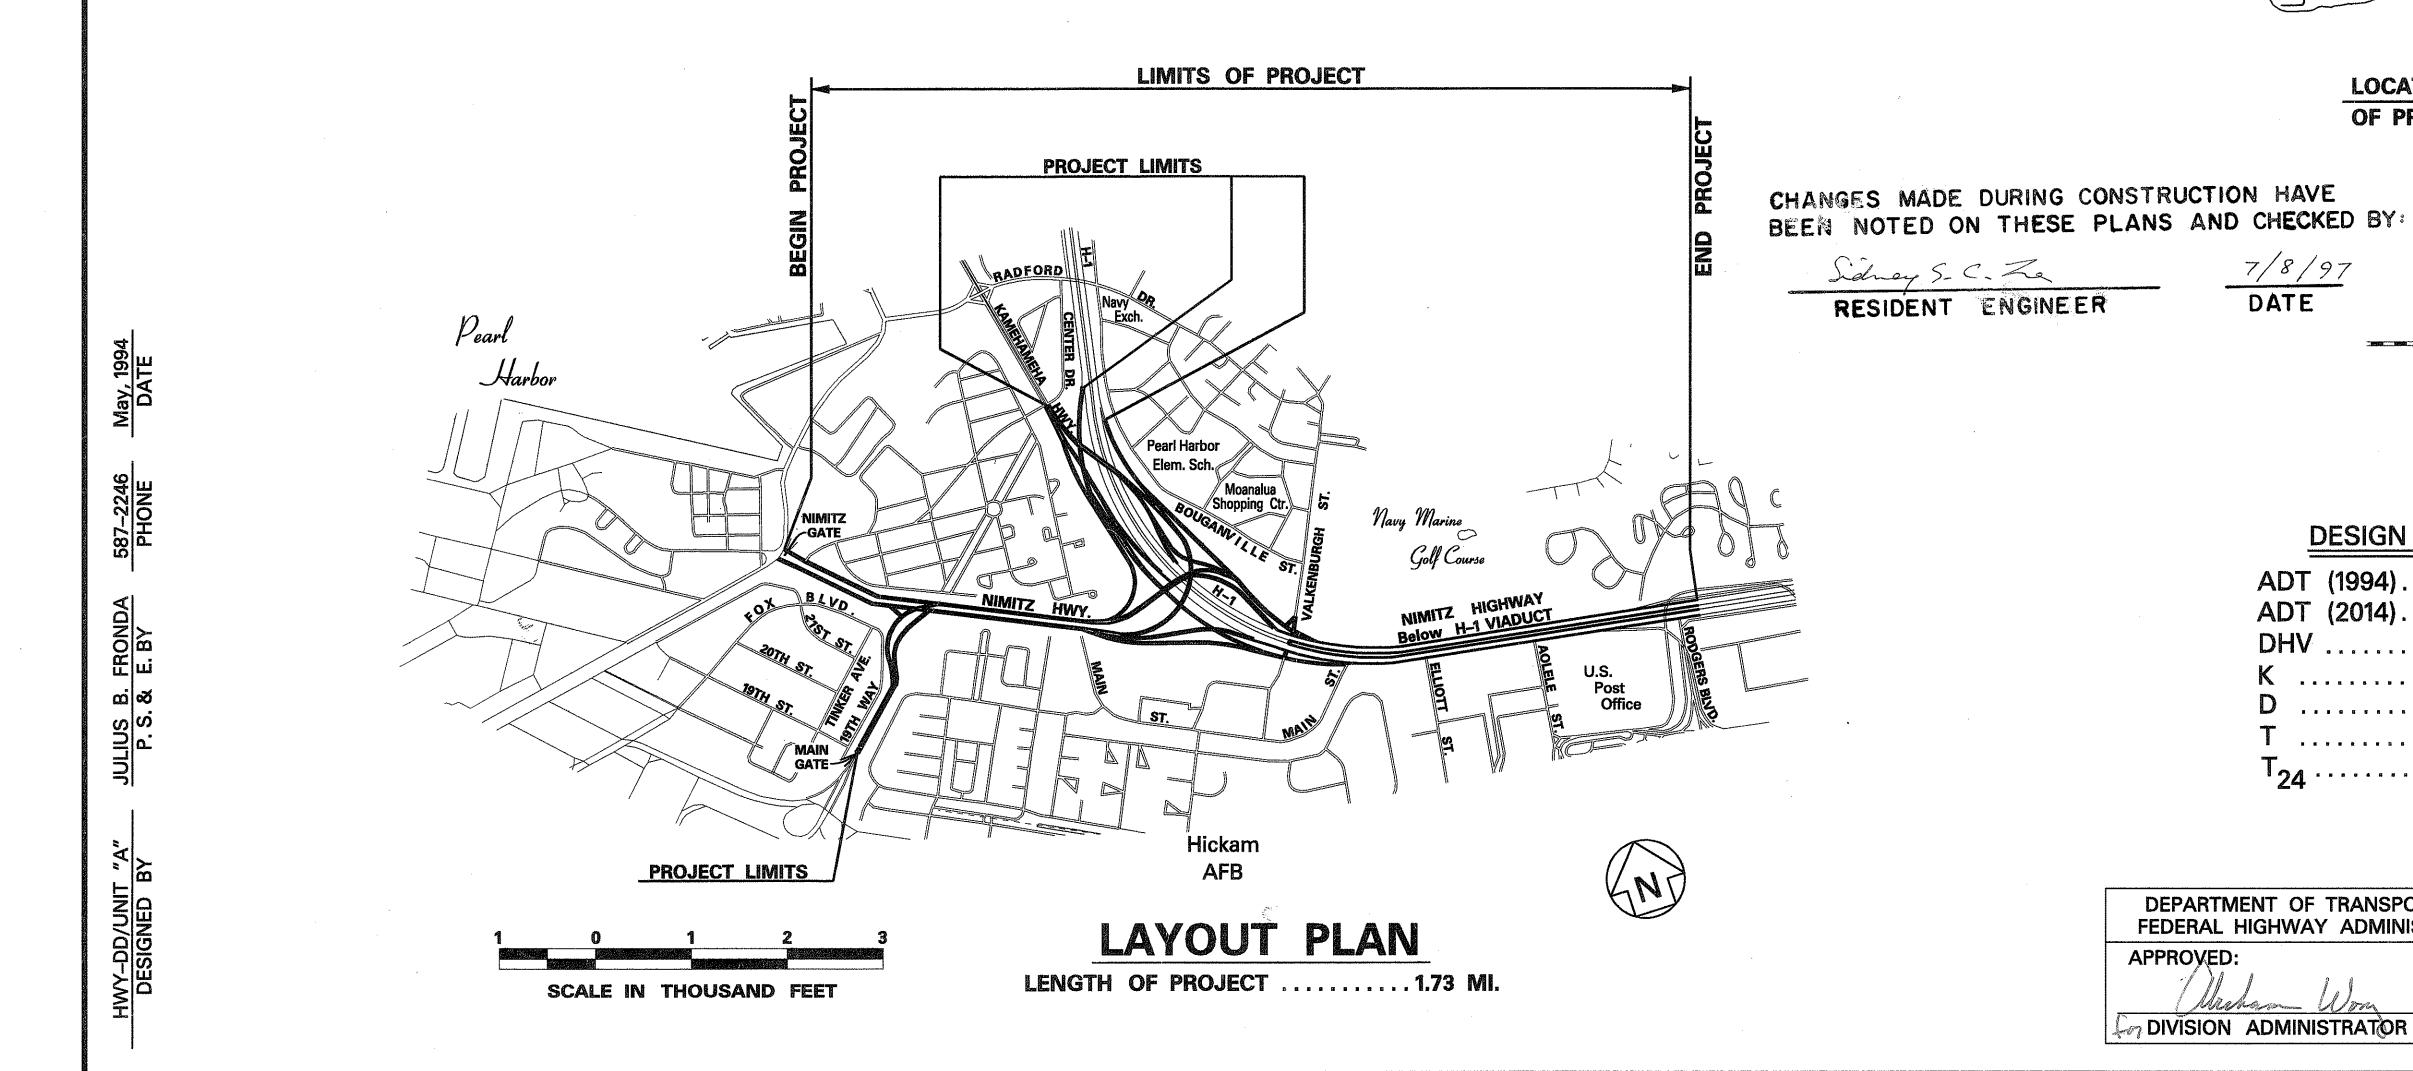

STATE OF HAWAII LOCATION OF PROJECT CHANGES MADE DURING CONSTRUCTION HAVE

FED. ROAD DIST. NO.

FED. AID PROJ. NO.

NH-092-1(22)

FISCAL YEAR

FEDERAL AID PROJECTS PREVIOUSLY CONSTRUCTED OR UNDER CONSTRUCTION

MILE POST 0.00 TO MILE POST 1.73

## DESIGN DESIGNATION

AD		(	1	9	9	4	l)							R					n			35,2	28
AD'	1	(	2	0	1	4	l)							â	*	2		Ħ	=	æ		50,2	0.
DH	V	4	*							•					9	2	2		s	B	8	5,77	70
K																		ĸ	•			11.5	
D			₽	а					•				×				*					70/3	30
		-			•		n		u	m	N	n						¥			Ħ	2.0	9
T <sub>24</sub>	1 "			a			Ħ	#	9	Ħ			8			n		#		8		3.5	9

DEPARTMENT OF TRANSPORTATION FEDERAL HIGHWAY ADMINISTRATION

DIVISION ADMINISTRATOR

7/8/97 DATE

	DEPARTMENT OF TRANSPOR	RTATIO
	APPROVED:	
	- Harano	5/12/
4	FOR DIR. OF TRANSPORTATION	DAT

5/13/9% DATE

SCALE IN MILES