

INDEX TO DRAWINGS	
SHEET NO.	DESCRIPTION
1	TITLE SHEET
2	STANDARD PLANS SUMMARY
3	GENERAL NOTES AND LEGEND
4	CITY & COUNTY NOTES
5	TYPICAL SECTION & LANDSCAPING DETAILS
6	ISLAND DETAILS
7	PLAN
8	DRAINAGE DETAILS
9	PAVEMENT MARKING LEGEND, DETAILS & NOTES
10	PAVEMENT MARKING & SIGNING PLAN
11	TRAFFIC SIGNAL & HWY. LIGHTING LEGEND, DETAILS & NOTES
12	TRAFFIC SIGNAL PLAN
13	LOOP DETECTOR DETAILS
14	TRAFFIC SIGN SUMMARIES

STATE OF HAWAII

DEPARTMENT OF TRANSPORTATION

HIGHWAYS DIVISION

HONOLULU, HAWAII

"AS-BUILT"

PLANS FOR



ALA MOANA BOULEVARD

INSTALL DOUBLE RIGHT-TURN LANES ON PUNCHBOWL ST.

FEDERAL AID PROJECT NO. NH-092-1(23)

DISTRICT OF HONOLULU

ISLAND OF OAHU

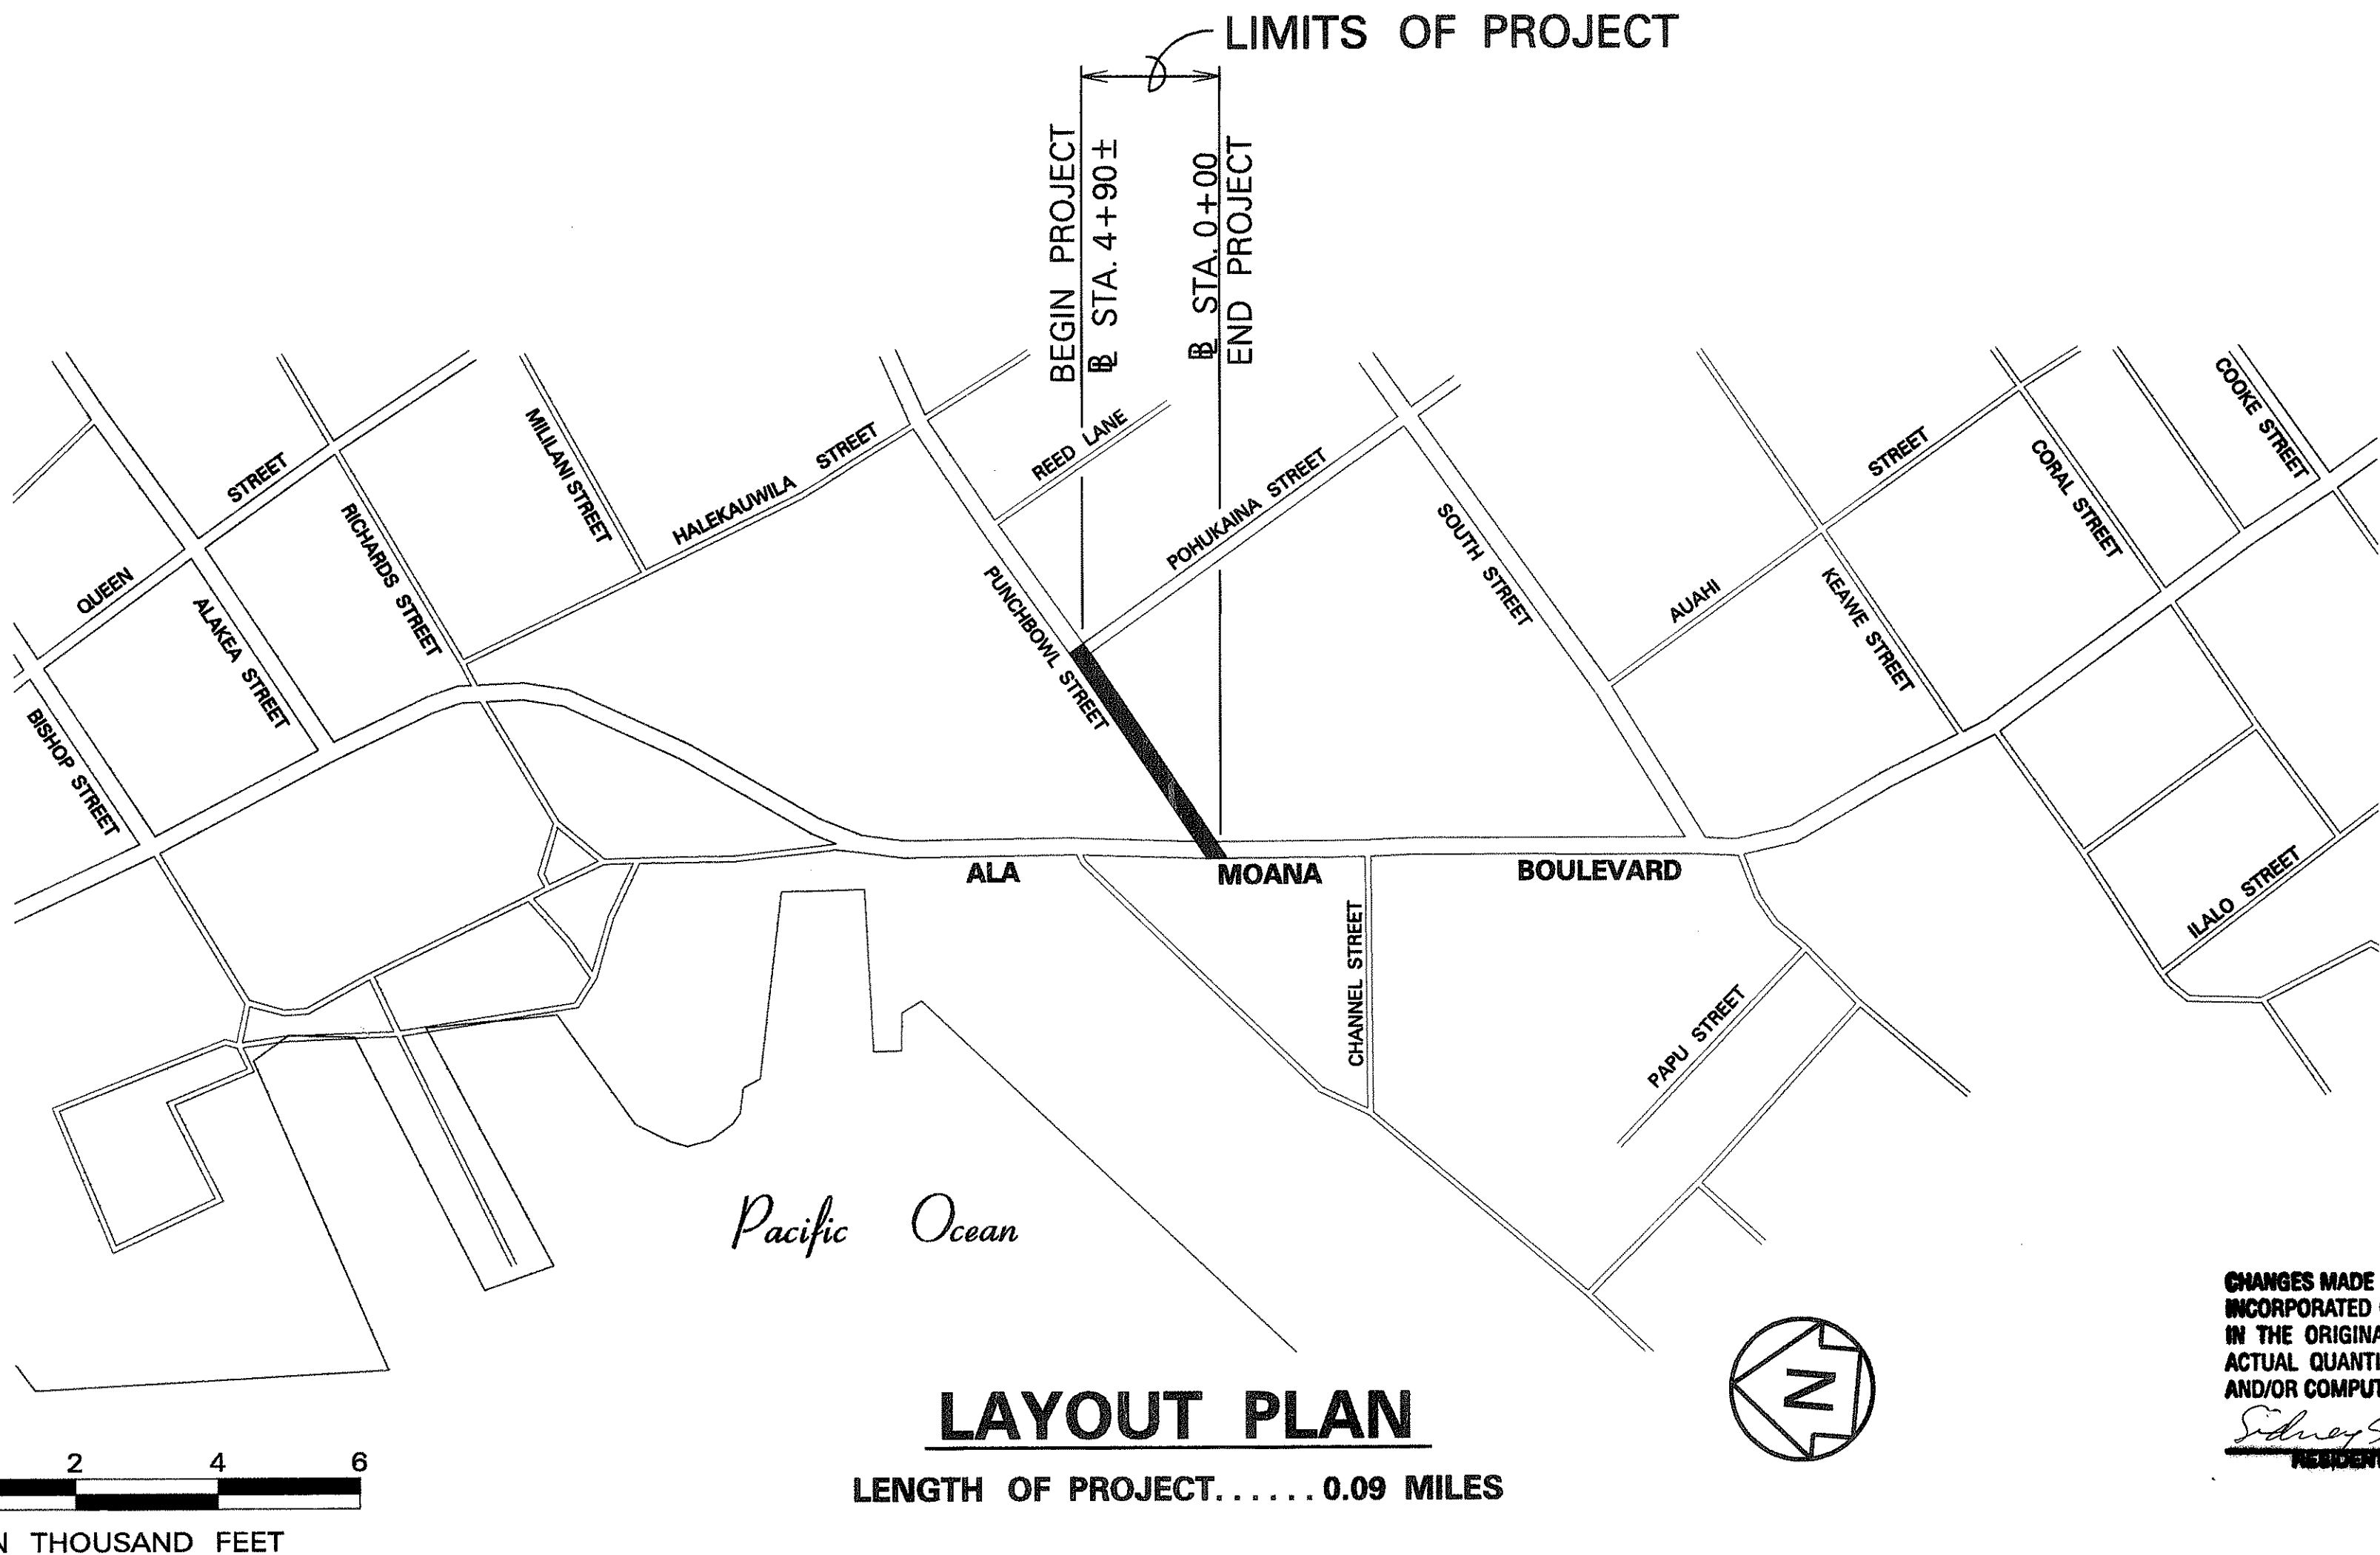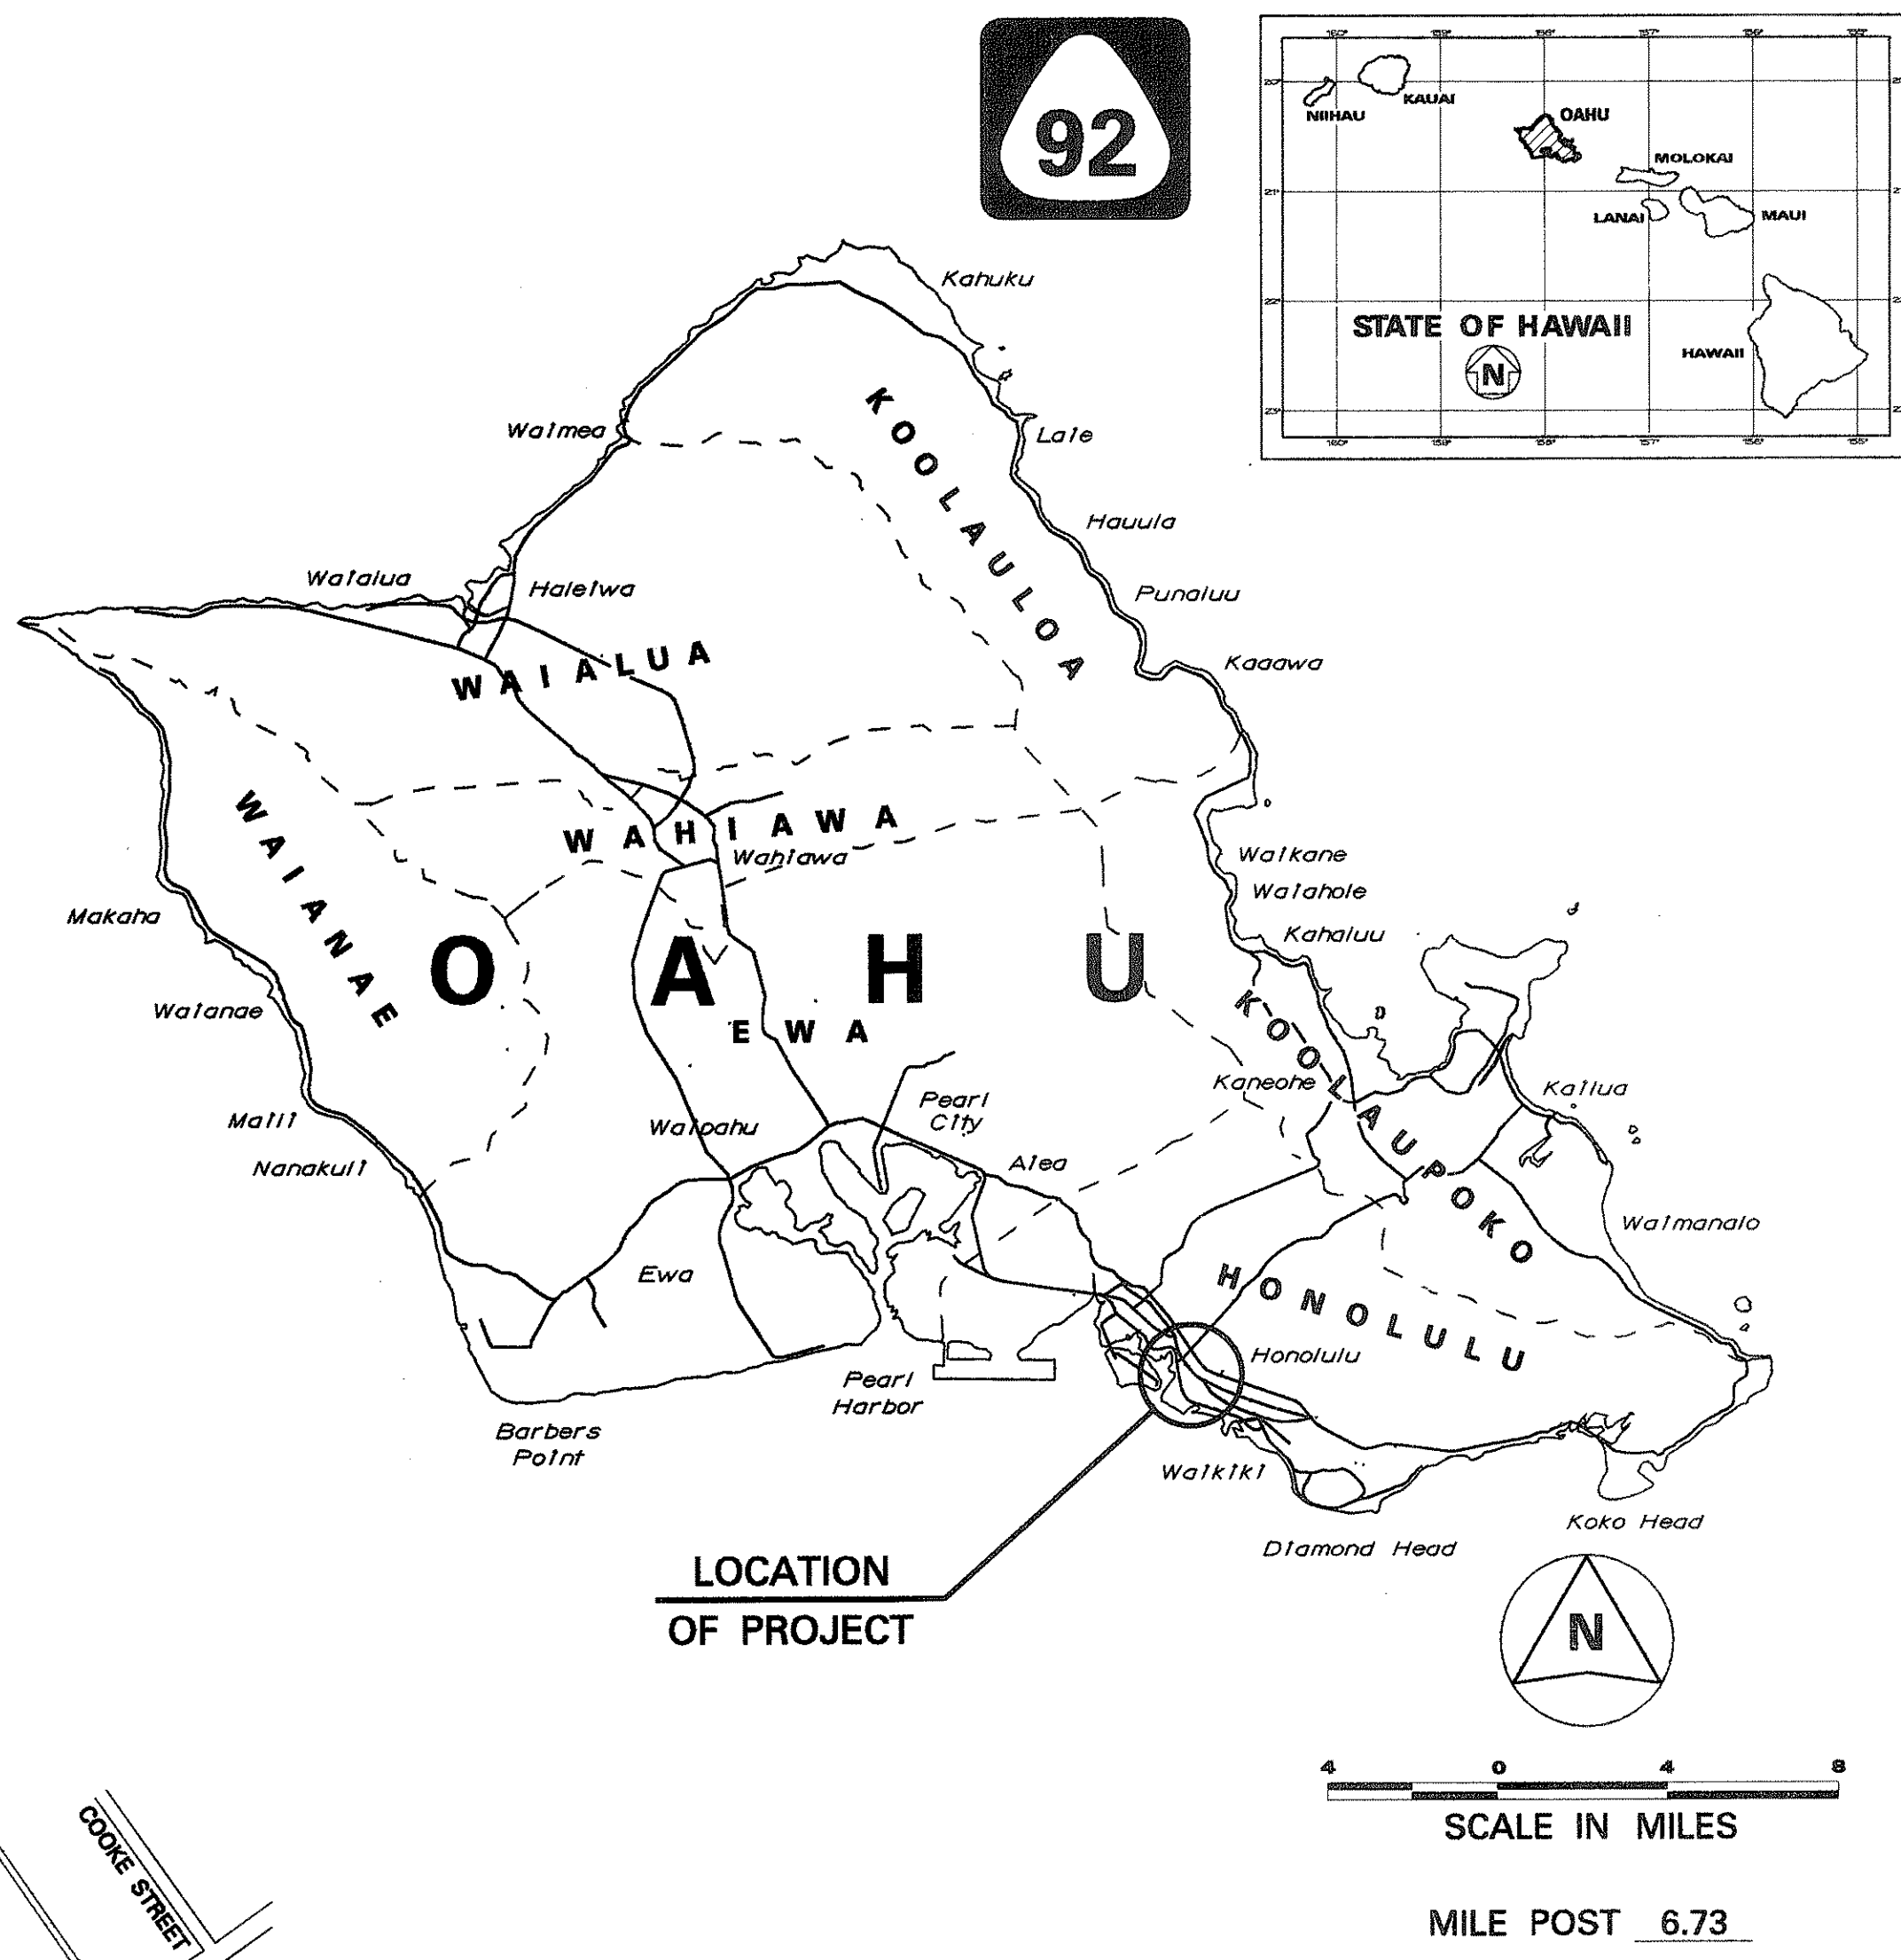

FED. ROAD DIST. NO.	STATE	FED. AID PROJ. NO.	FISCAL YEAR	SHEET NO.	TOTAL SHEETS
HAWAII	HAW.	NH-092-1(23)	1995	1	14



DESIGN DESIGNATION	
ADT (1995)	6,265
ADT (2015)	8,457
DHV	1,162
D	100/0
T	2.5 %

HWY-DD UNIT A

DESIGNED BY

JULIUS B. FRONDA

P.S. & E. BY

587-2246

PHONE

SEPT., 1995

DATE

CHANGES MADE DURING CONSTRUCTION HAVE BEEN INCORPORATED ON THESE PLANS EXCEPT CHANGES IN THE ORIGINAL THEORETICAL QUANTITIES. FOR ACTUAL QUANTITIES, REFER TO PROJECT LEDGER AND/OR COMPUTATION BOOK.

Sidney C. Lee

3/2/00

RESIDENT ENGINEER

DATE

DEPARTMENT OF TRANSPORTATION

STATE OF HAWAII

APPROVED:

Kayn Uyehiro

10/4/95

DIR. OF TRANSPORTATION

DATE