



FED. ROAD DIST. NO.	STATE	FED. AID PROJ. NO.	FISCAL YEAR	SHEET NO.	TOTAL SHEETS
HAWAII	HAW.	NH-092-1(23)	1995	5	14

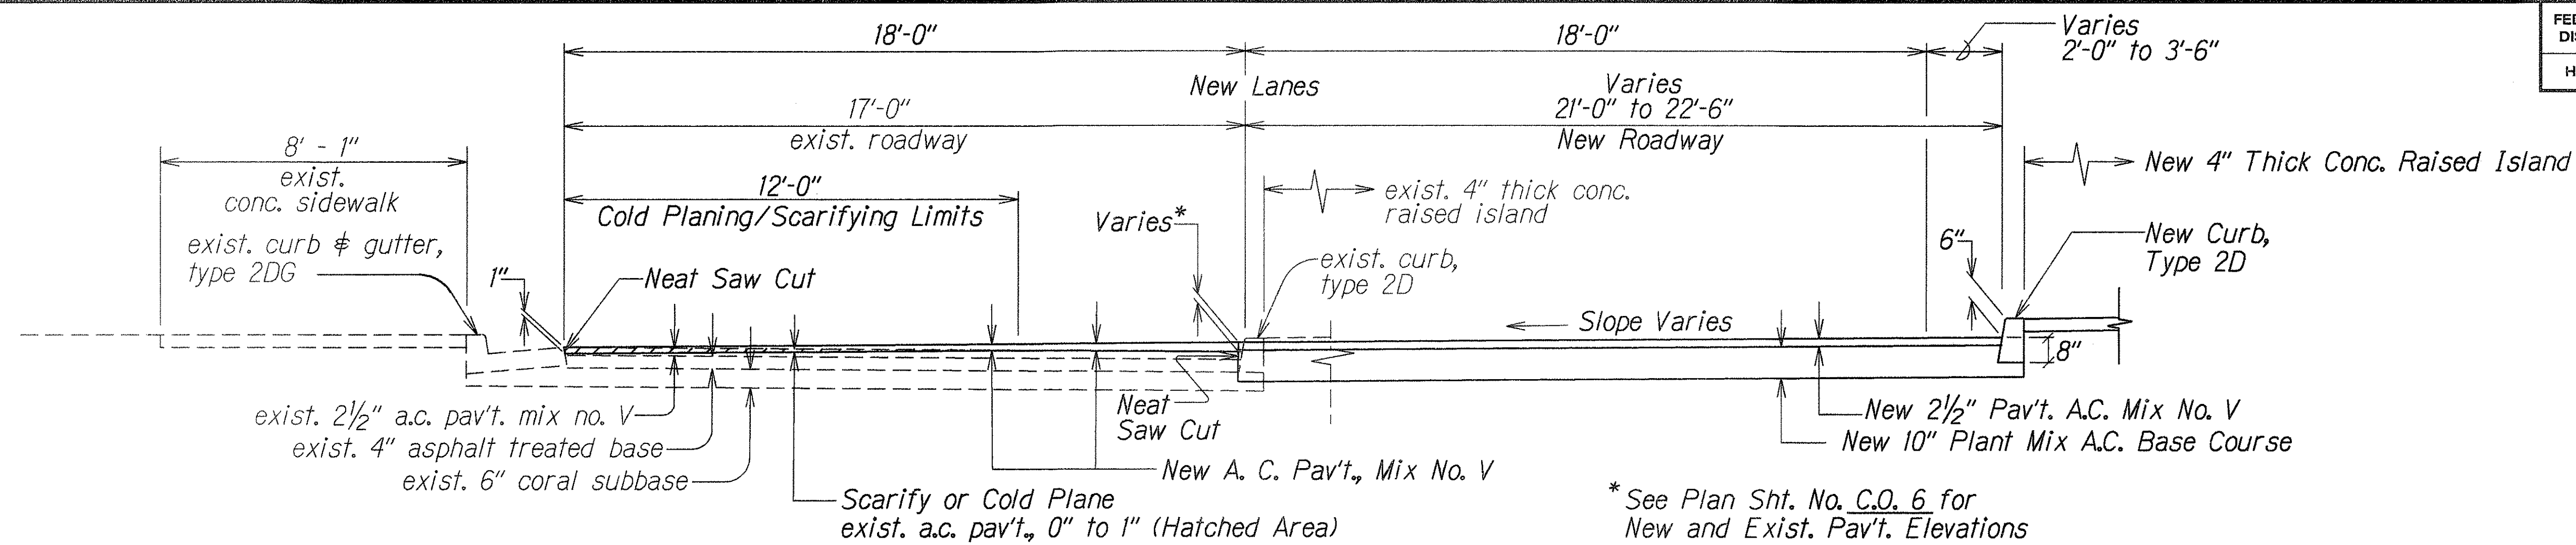


**TYPICAL SECTION
RAMP "P"**
Scale: $\frac{3}{8}" = 1'-0"$

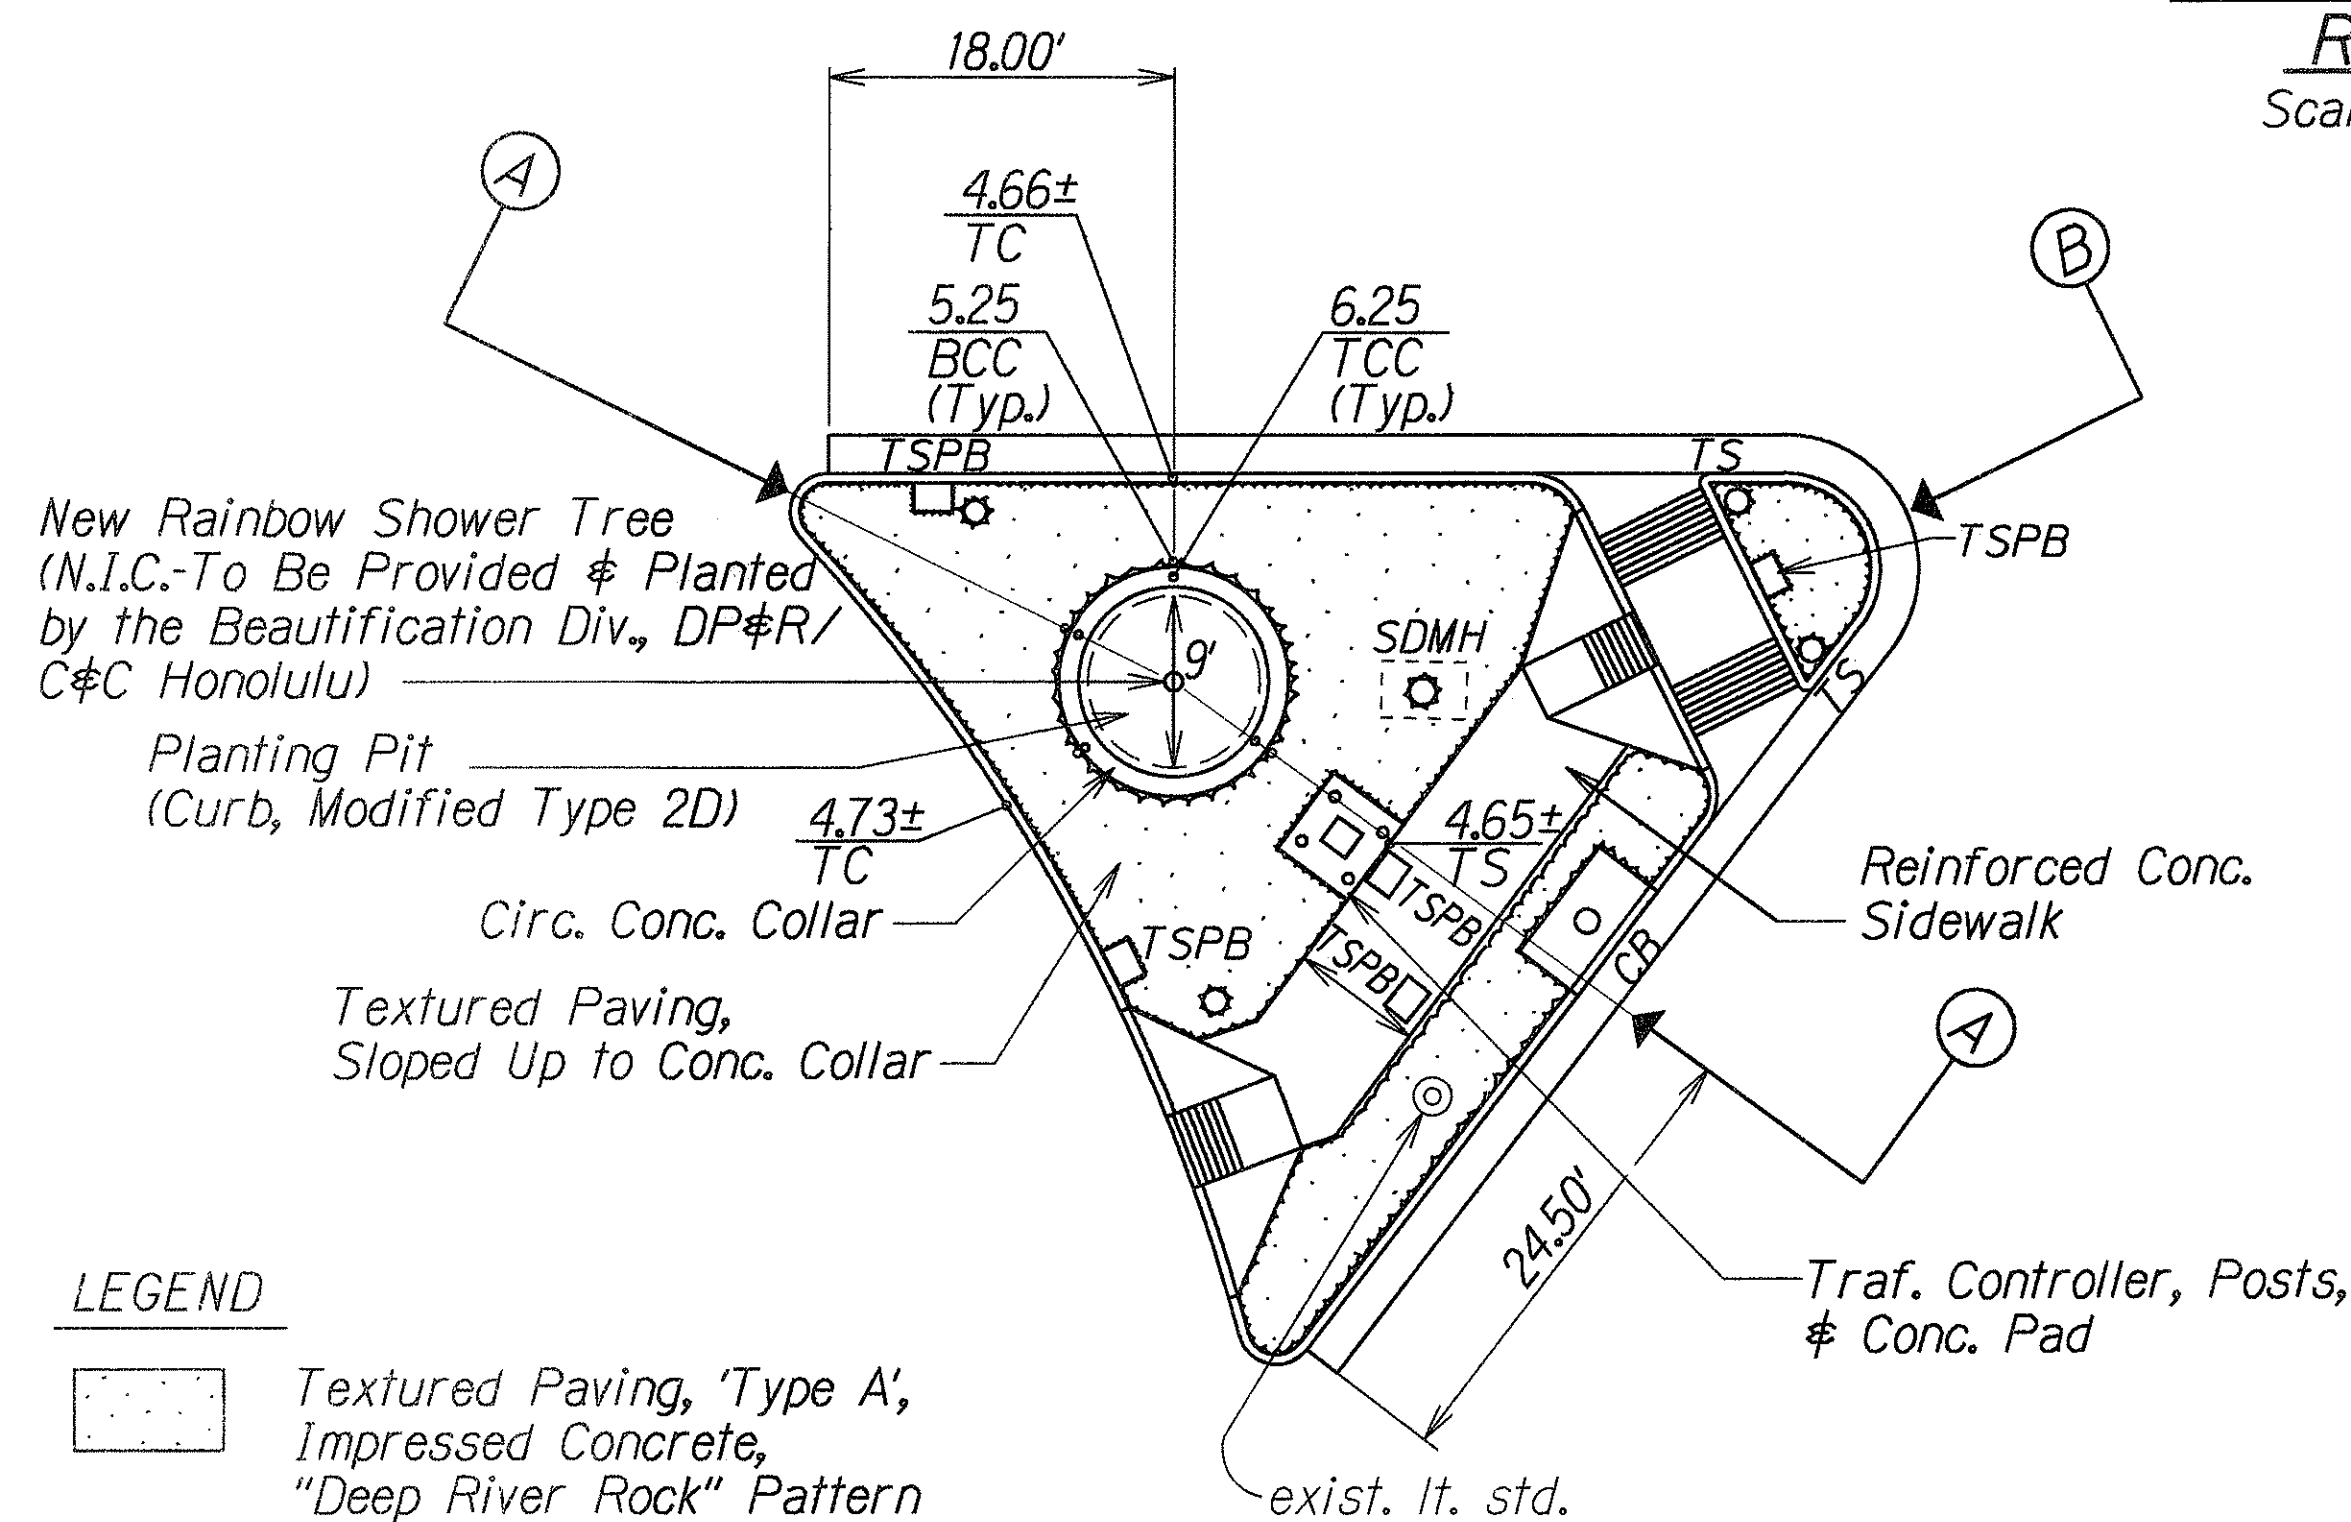


LEGEND

Textured Paving, 'Type A',
Impressed Concrete,
"Deep River Rock" Pattern


PAVING & TREE PLANTING AREA PLAN
Scale: $1" = 10'$

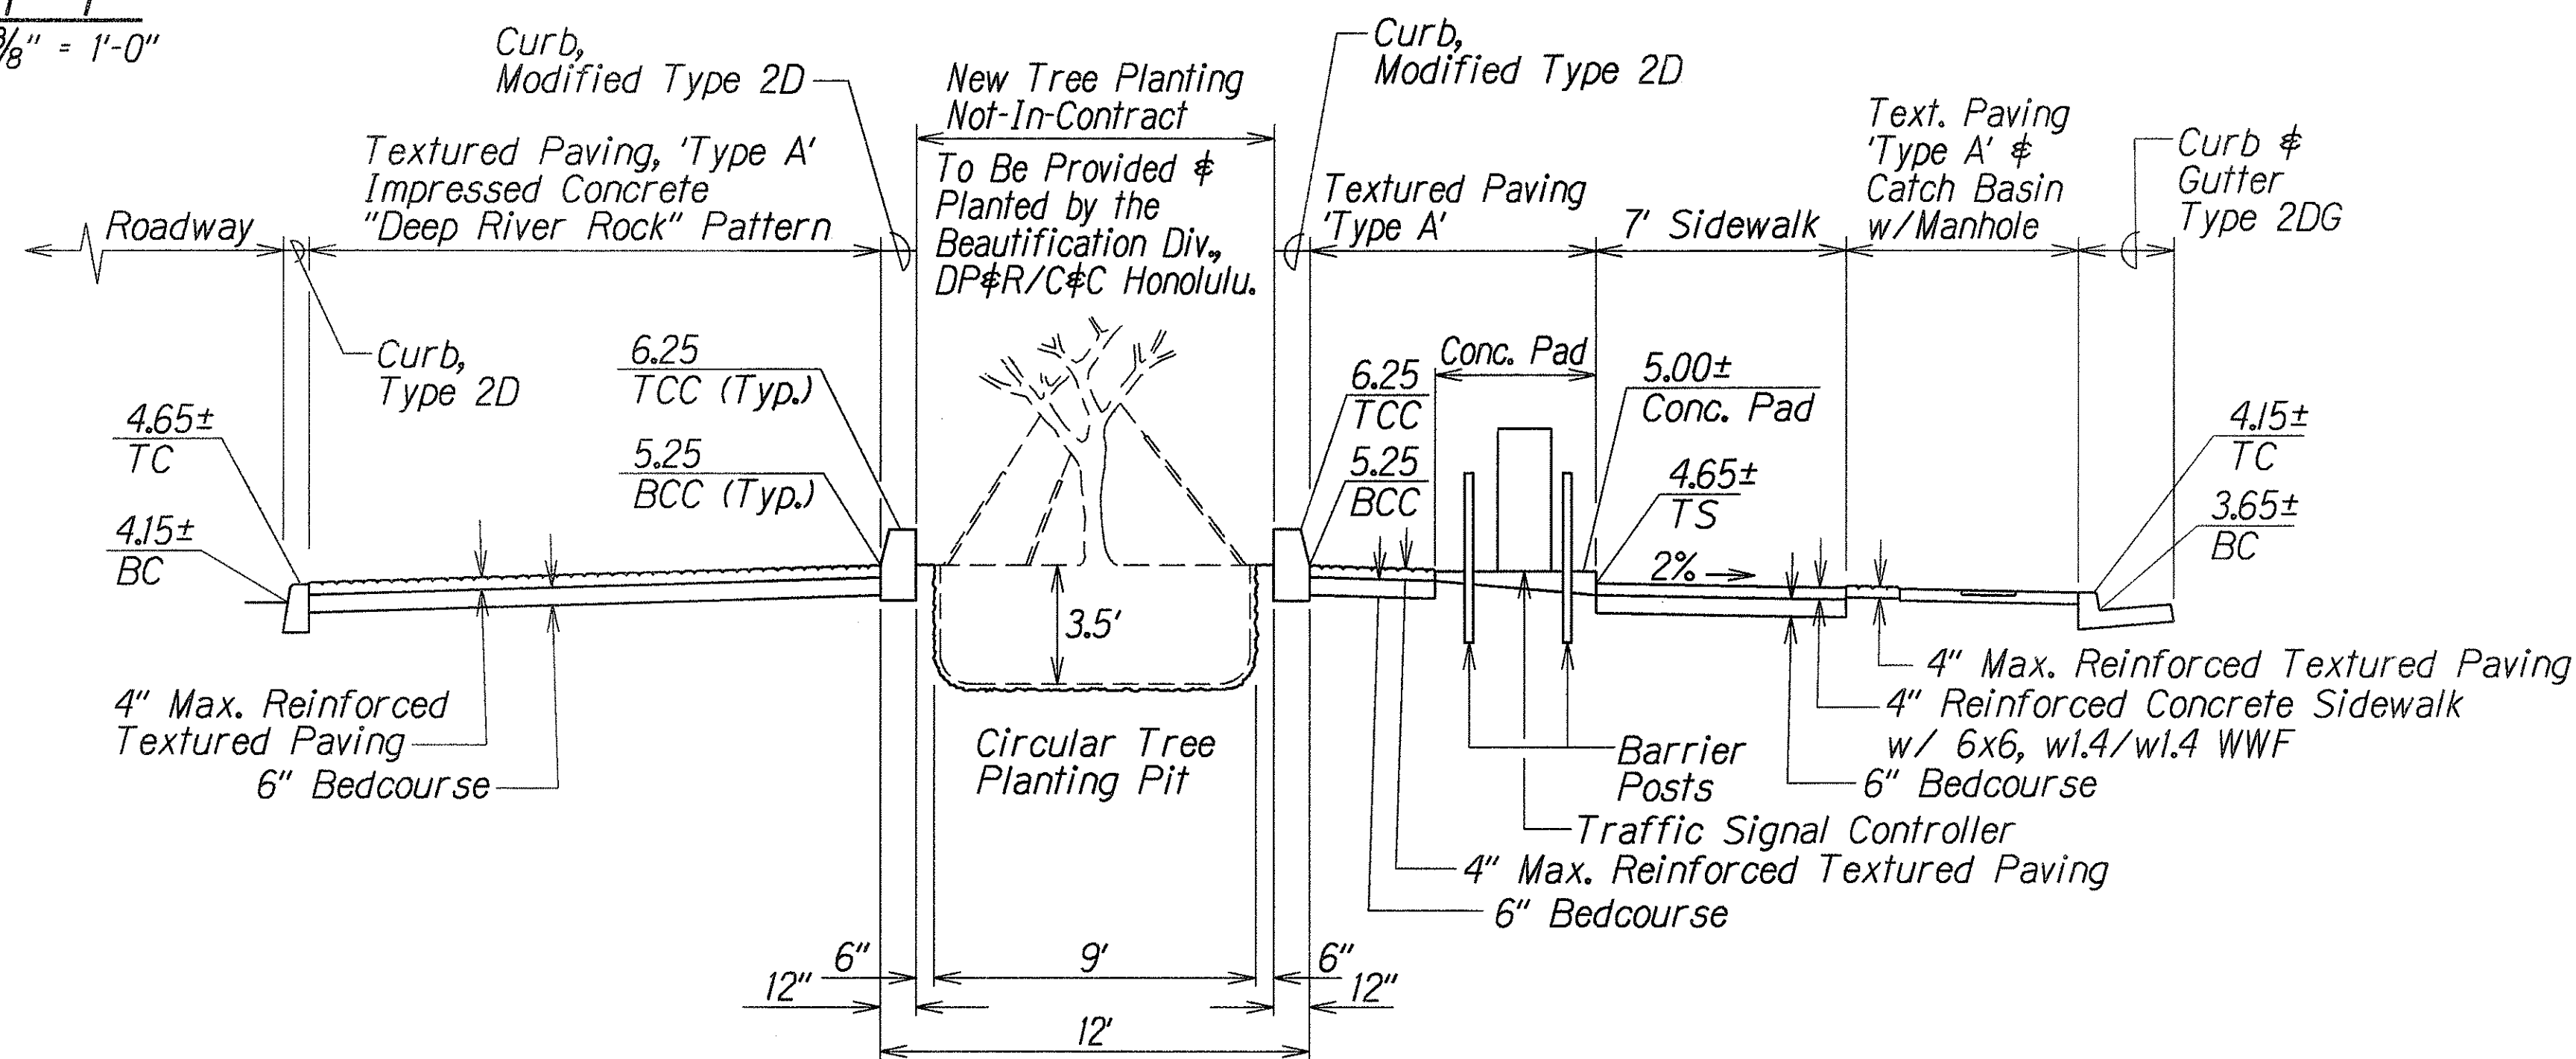


SECTION A
Scale: $\frac{1}{4}" = 1'$

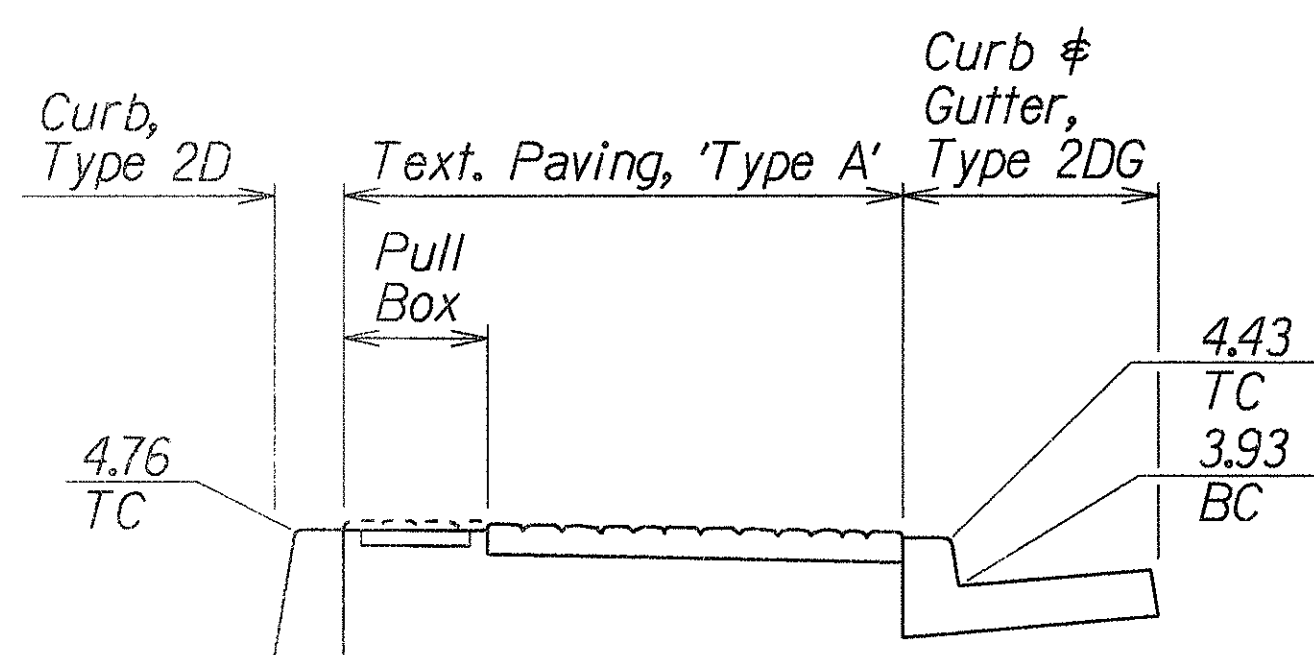

SECTION B
Scale: $\frac{1}{2}" = 1'$

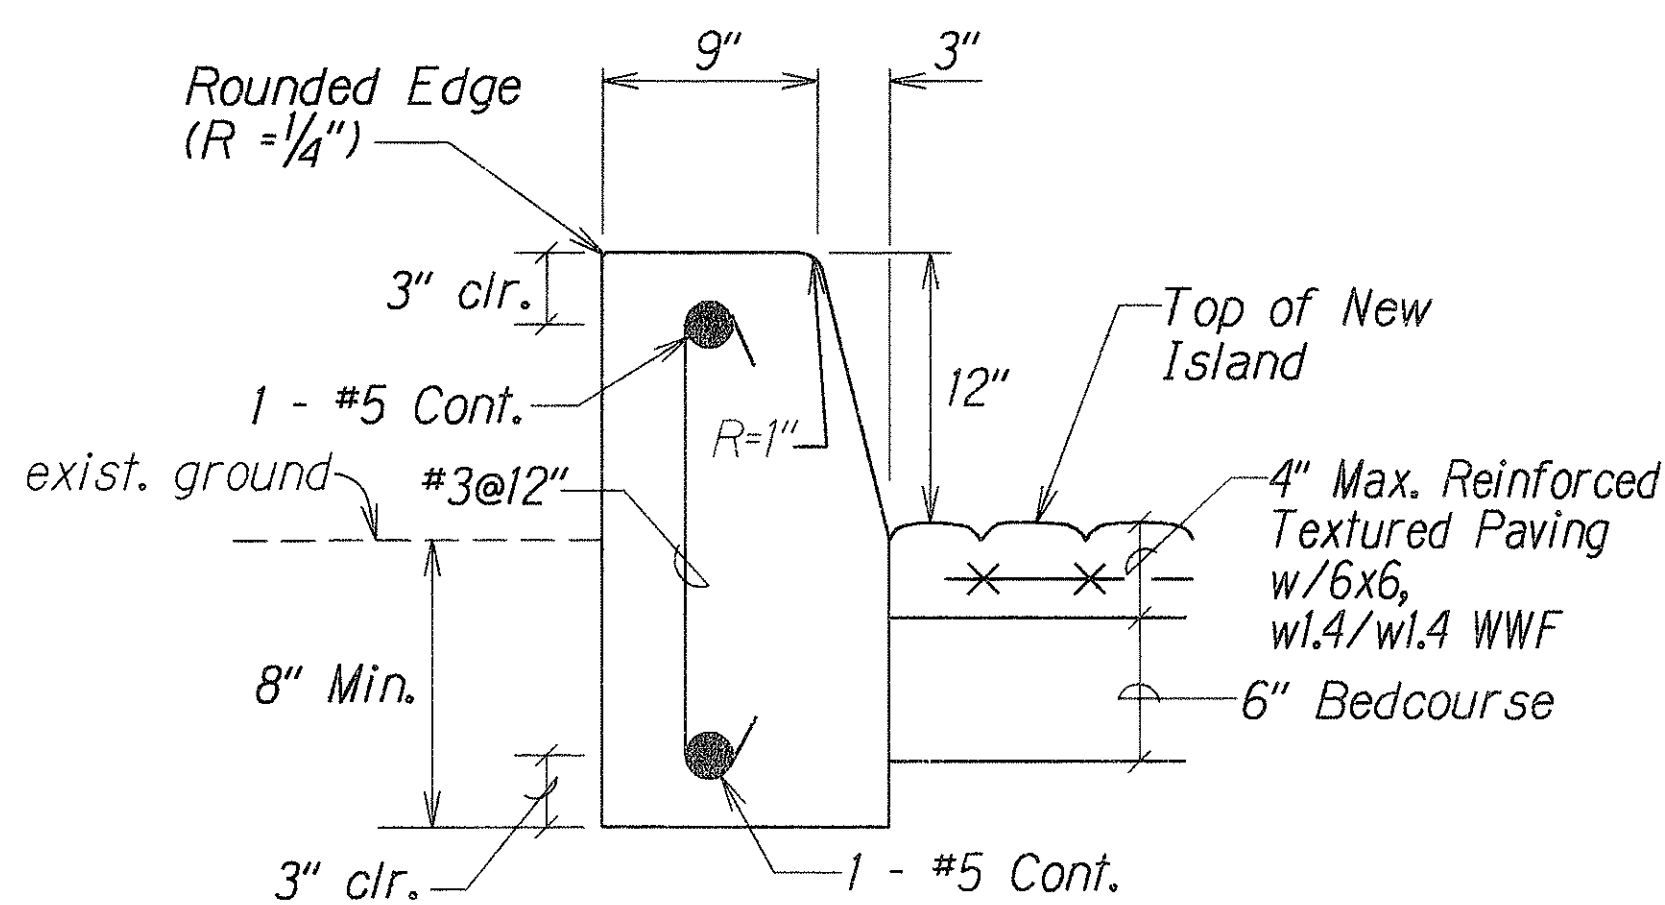

MODIFIED TYPE 2D CURB DETAIL
Scale: $1\frac{1}{2}" = 1'-0"$

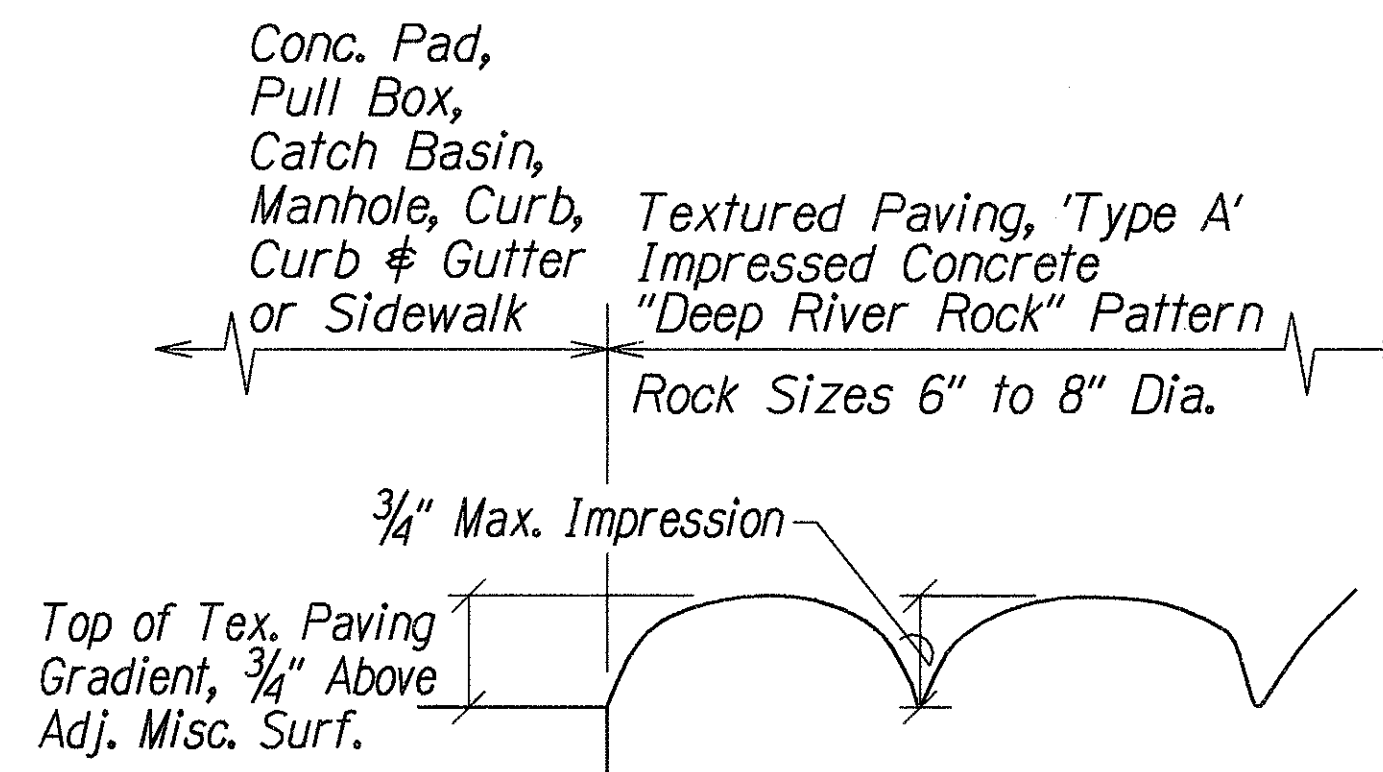

TEXTURED PAVING DETAIL
Not To Scale

DATE	REVISION
5/11/96	Revised Typical Section (Ramp "P"), and Revised Elevations on Paving & Tree Planting Area Plan & Section.
STATE OF HAWAII DEPARTMENT OF TRANSPORTATION HIGHWAYS DIVISION TYPICAL SECTIONS & LANDSCAPING DETAILS ALA MOANA BOULEVARD Install Double Right-Turn Lanes On Punchbowl Street F. A. PROJECT NO. NH-092-1(23) Scale: As Shown Date: Sept., 1995	
SHEET No. 1 OF 1 SHEETS	