



FED. ROAD DIST. NO.	STATE	FED. AID PROJ. NO.	FISCAL YEAR	SHEET NO.	TOTAL SHEETS
HAWAII	HAW.	NH-092-1(21)	1994	3	11

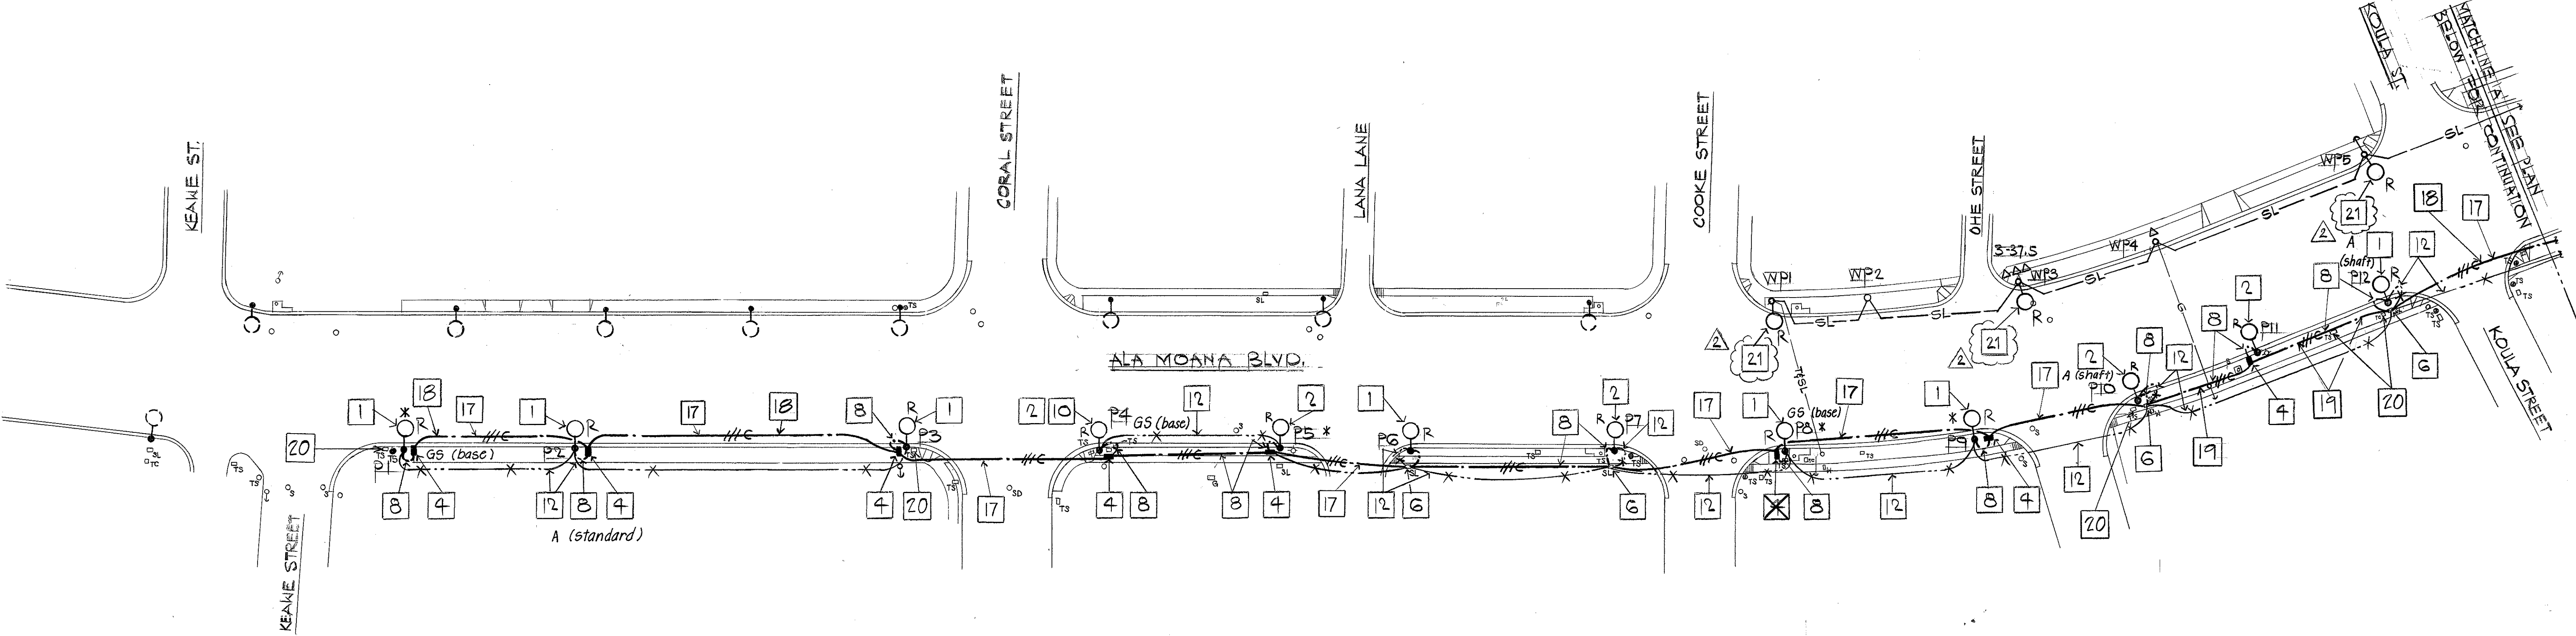

PARTIAL STREET LIGHT PLAN (PART I) SCALE: 1" = 40'

- *: Anchor bolt splice repair done
- A: New aluminum light standard part(s)
- GS: New galvanized steel light standard part(s)

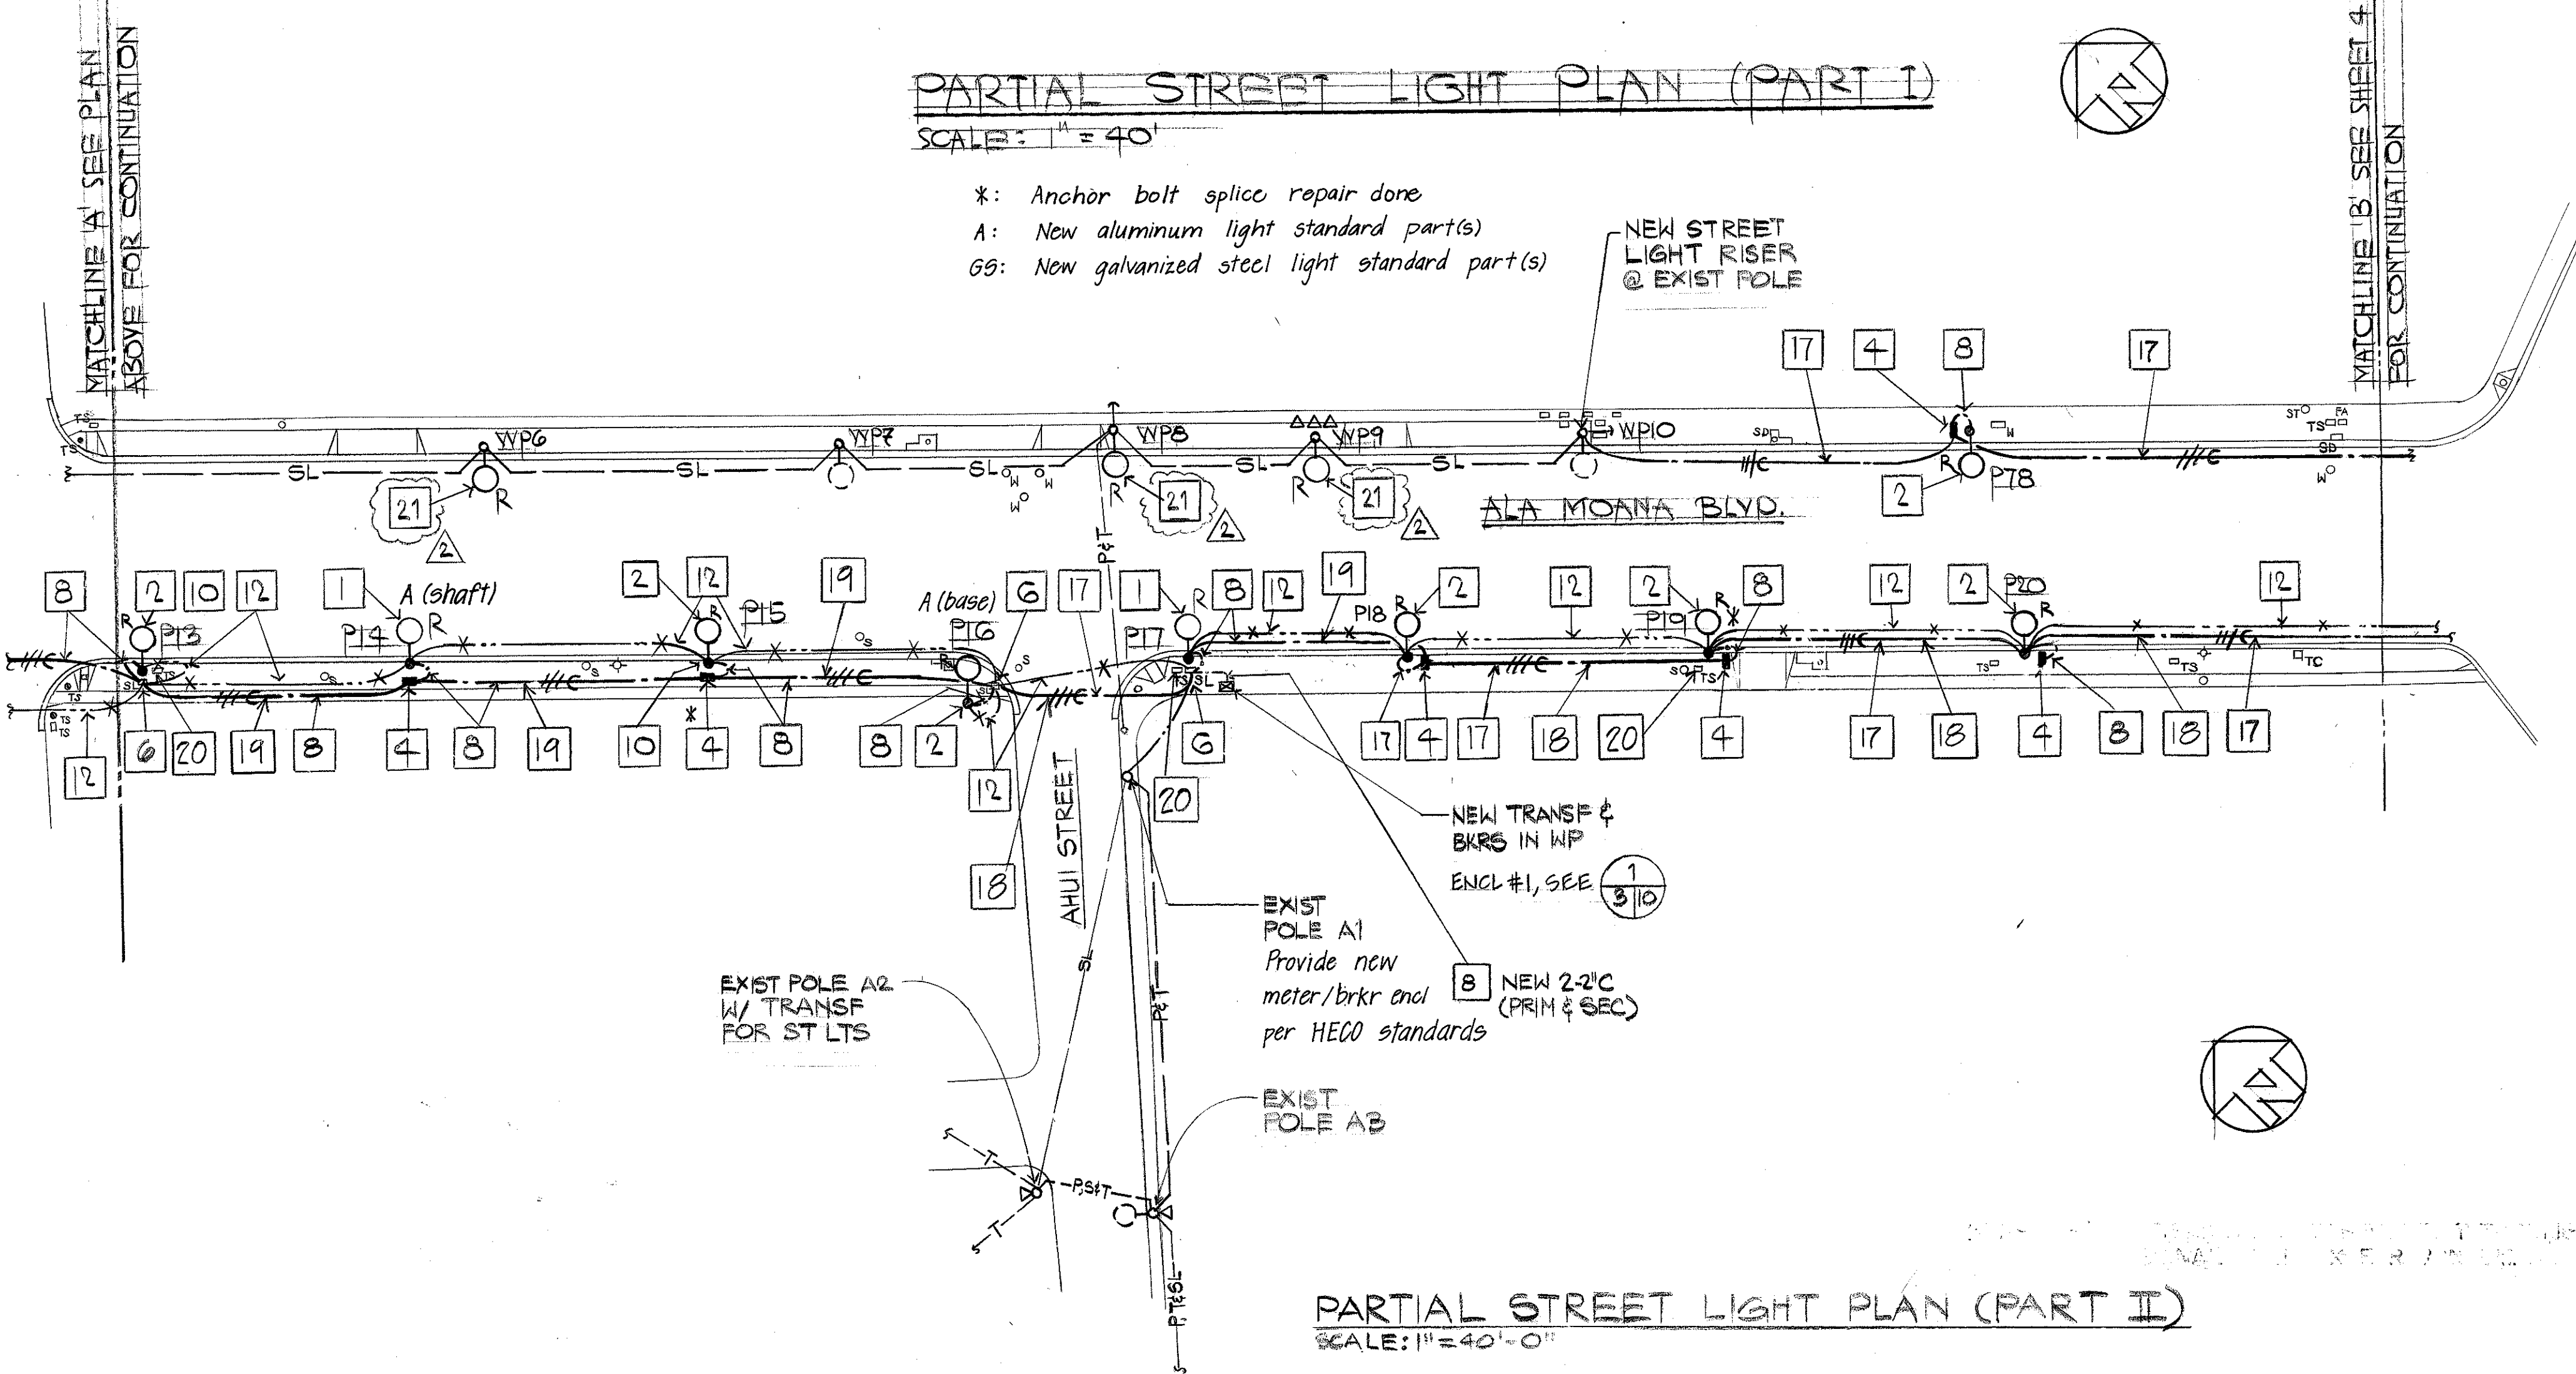


- NOTES:
- SEE STREET LIGHT DIAGRAM ON SHEET 7 FOR CONDUIT AND WIRE SIZES.

SYM	DATE	REVISION
2	5/23/95	CLARIFIED POWER SOURCE
	3/20/95	ADD 2" CONDUIT FOR TRAFFIC SIGNALS ALONG WITH STREET LIGHT RACEWAY. BREAK AND PATCH EXISTING TRAFFIC SIGNAL PULLBOX FOR CONDUIT.

STATE OF HAWAII
DEPARTMENT OF TRANSPORTATION
HIGHWAYS DIVISION
PARTIAL STREET LIGHT PLAN - PARTS I AND II


HIGHWAY LIGHTING IMPROVEMENTS AND REHABILITATION
ALA MOANA BOULEVARD
KEANE STREET TO ALA WAI CANAL

FED. ROAD DIST. NO.	STATE	FED. AID PROJ. NO.	FISCAL YEAR	SHEET NO.	TOTAL SHEETS
HAWAII	HAW.	NH-092-1(21)	1994	4	11

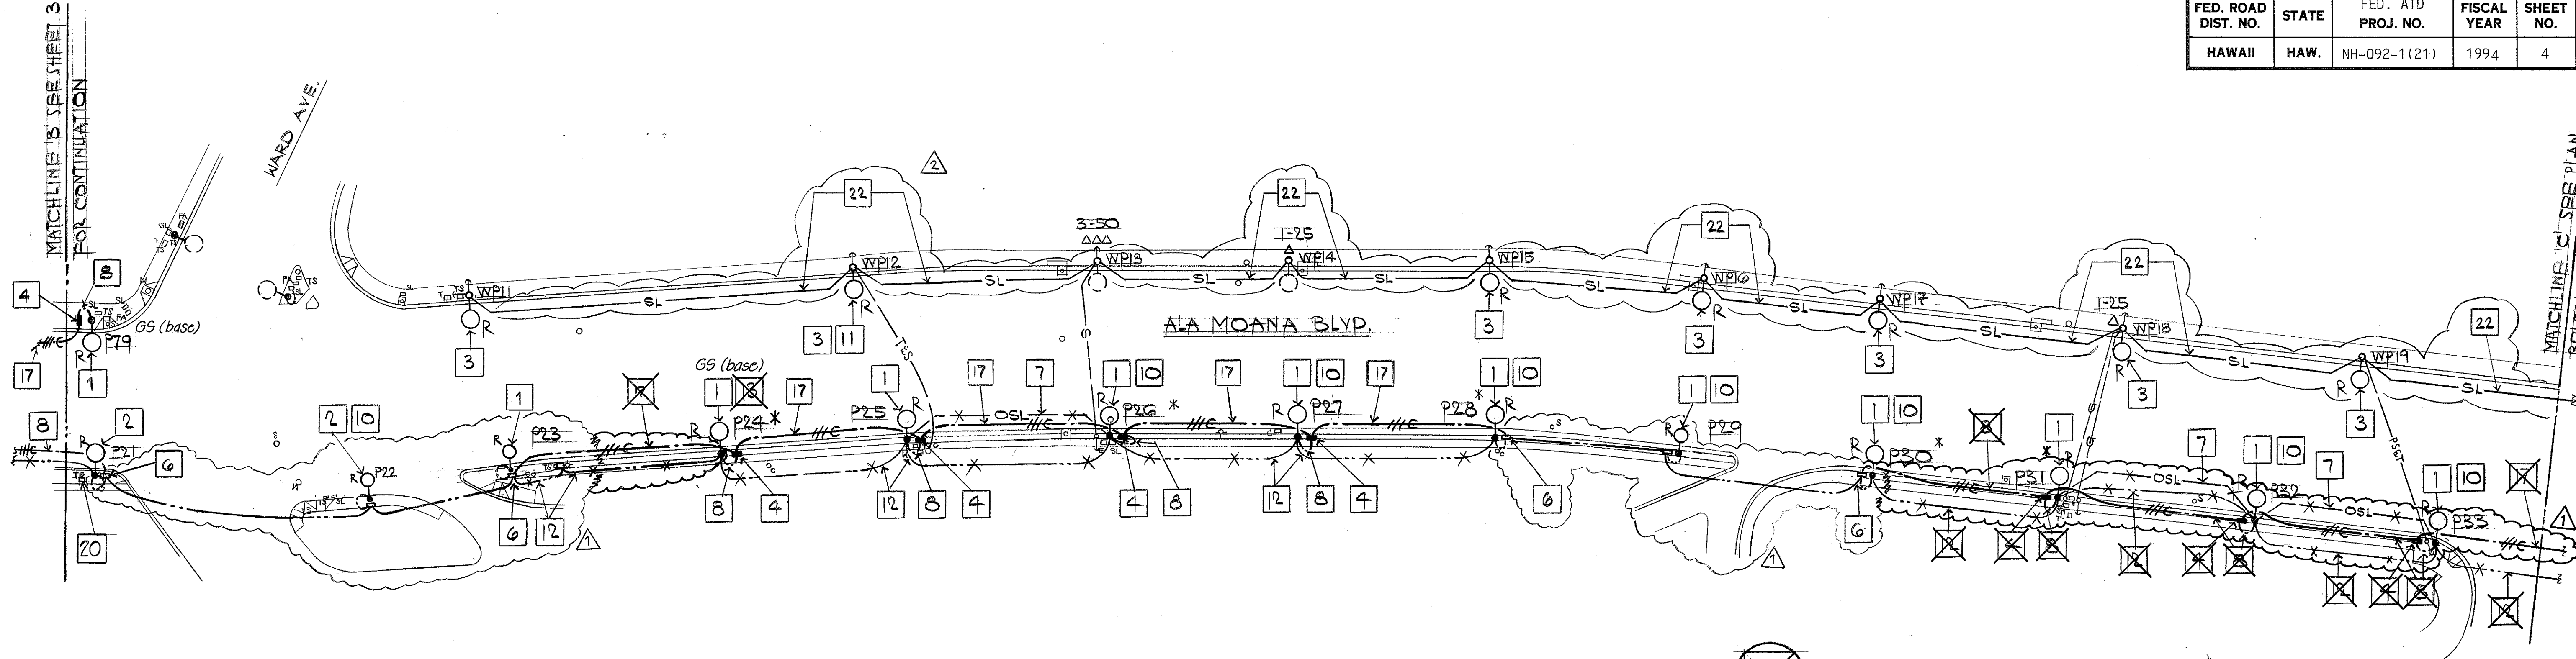

PARTIAL STREET LIGHT PLAN (PART III)
SCALE: 1" = 40'

- *: Anchor bolt splice repair done
- A: New aluminum light standard part(s)
- GS: New galvanized steel light standard part(s)

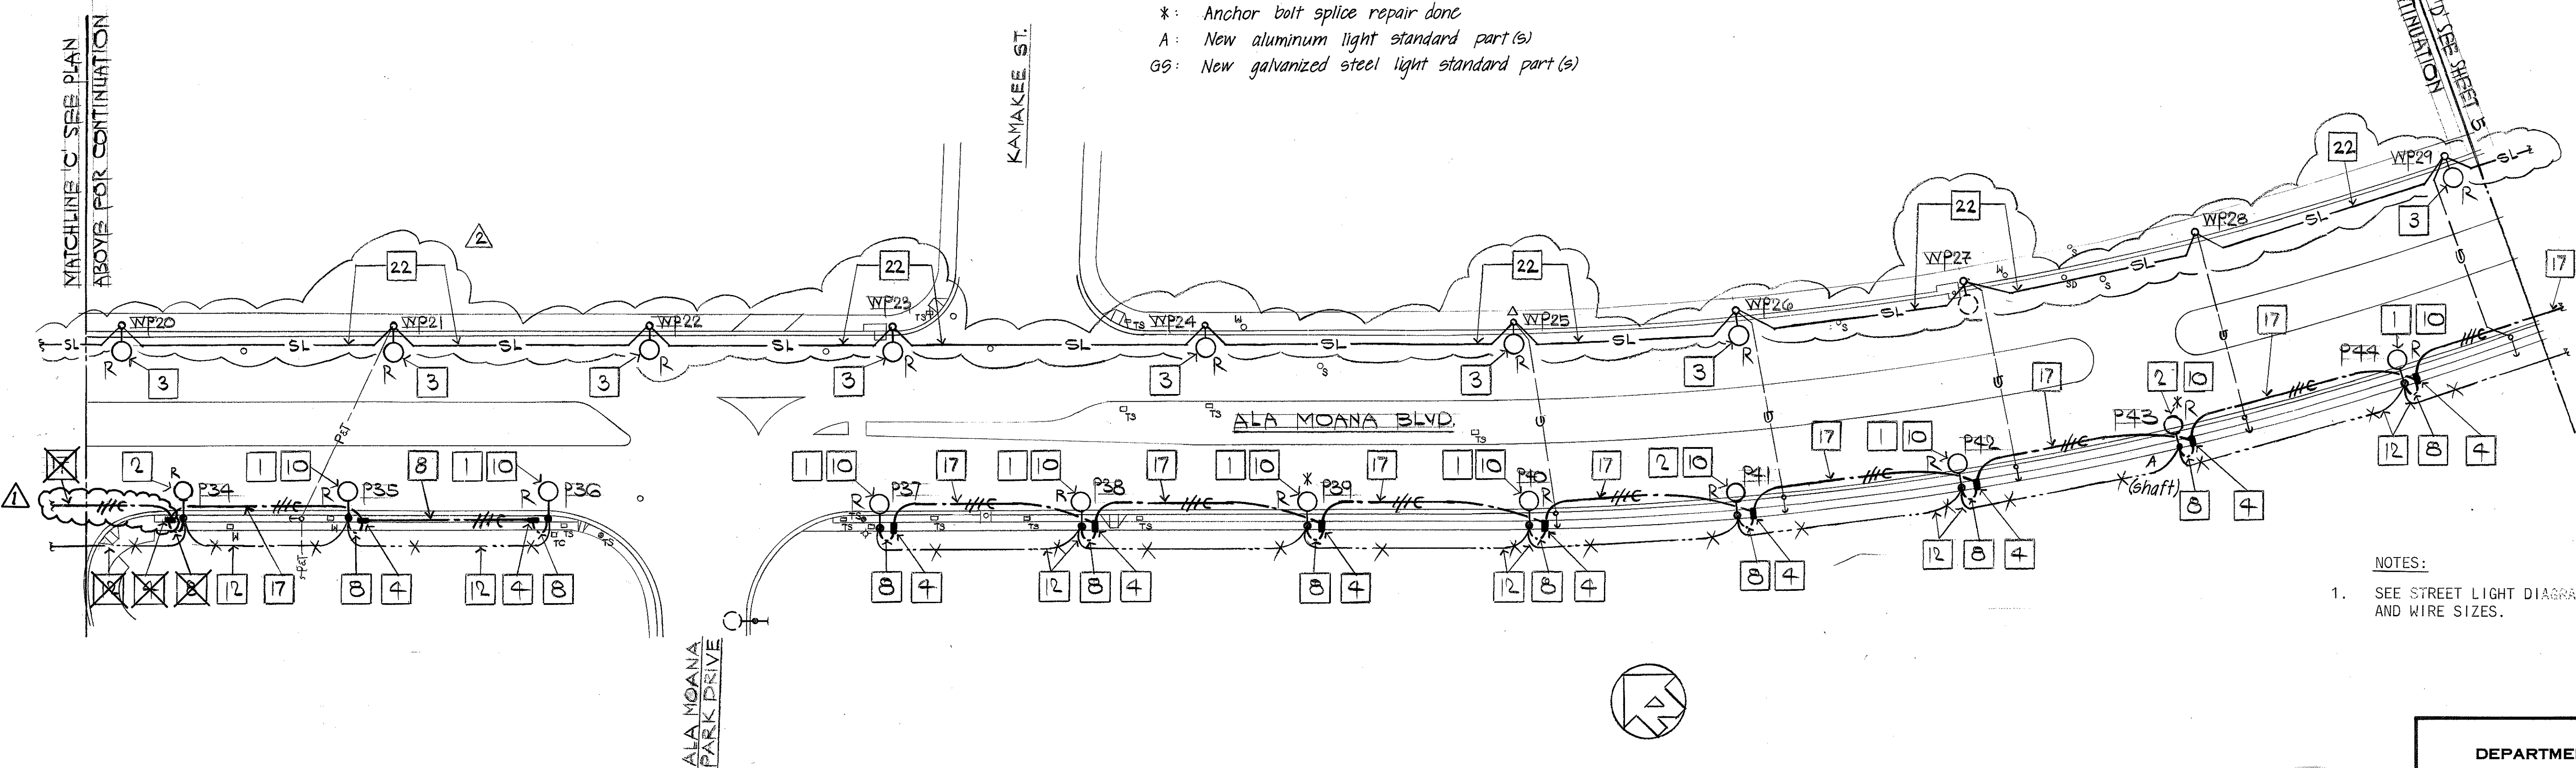


PARTIAL STREET LIGHT PLAN (PART IV)
SCALE: 1" = 40'

- NOTES:
- SEE STREET LIGHT DIAGRAM ON SHEET 7 FOR CONDUIT AND WIRE SIZES.


DATE	
SURVEY PLOTTED BY	
DRAWN BY	
DESIGNED BY	
QUANTITIES BY	
CHECKED BY	
ORIGINAL PLAN	
NOTE BOOK	
No.	

5/23/95	△	REPLACE OH ST LT WIRING	
3/20/95		BREAK AND PATCH EXISTING TRAFFIC SIGNAL PULLBOX FOR CONDUIT	
7-20-94	△	REVISIONS TO COORDINATE WITH KEWALO BASIN REVISION PROJECT	
DATE	SYM	REVISION	ENG

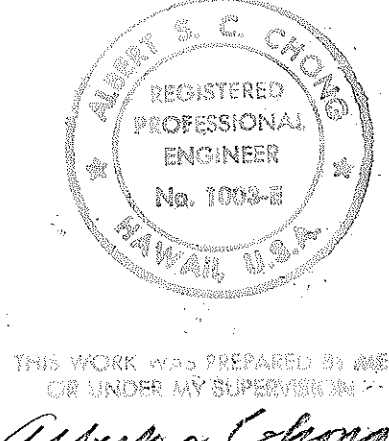

STATE OF HAWAII
DEPARTMENT OF TRANSPORTATION
HIGHWAYS DIVISION
PARTIAL STREET LIGHT PLAN - PARTS III AND IV
HIGHWAY LIGHTING IMPROVEMENTS AND REHABILITATION
ALA MOANA BOULEVARD
KEAWE STREET TO ALA WAI CANAL

REMOVE ALL EXIST STATE-OWNED -
EQUIPT & WIRING NO LONGER
REQUIRED & PROVIDE NEW
METER/BKR ENCL PER HECO
STANDARDS.

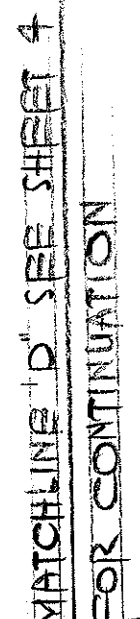

SCALE: $\frac{1}{40}$

-


SCALE: 1" = 40'

HIGHWAY LIGHTING IMPROVEMENTS AND REHABILITATION
ALA MOANA BOULEVARD
KEAWE STREET TO ALA WAI CANAL

C.O.5


ORIGINAL PLAN	SURVEY PLOTTED BY _____ DATE _____
NOTE BOOK	DRAWN BY _____
	TRACED BY _____
	DESIGNED BY _____
	QUANTITIES BY _____
No. _____	CHECKED BY _____

FED. ROAD DIST. NO.	STATE	FED. AID PROJ. NO.	FISCAL YEAR	SHEET NO.	TOTAL SHEETS
HAWAII	HAW.	NH-092-1(21)	1994	6	11

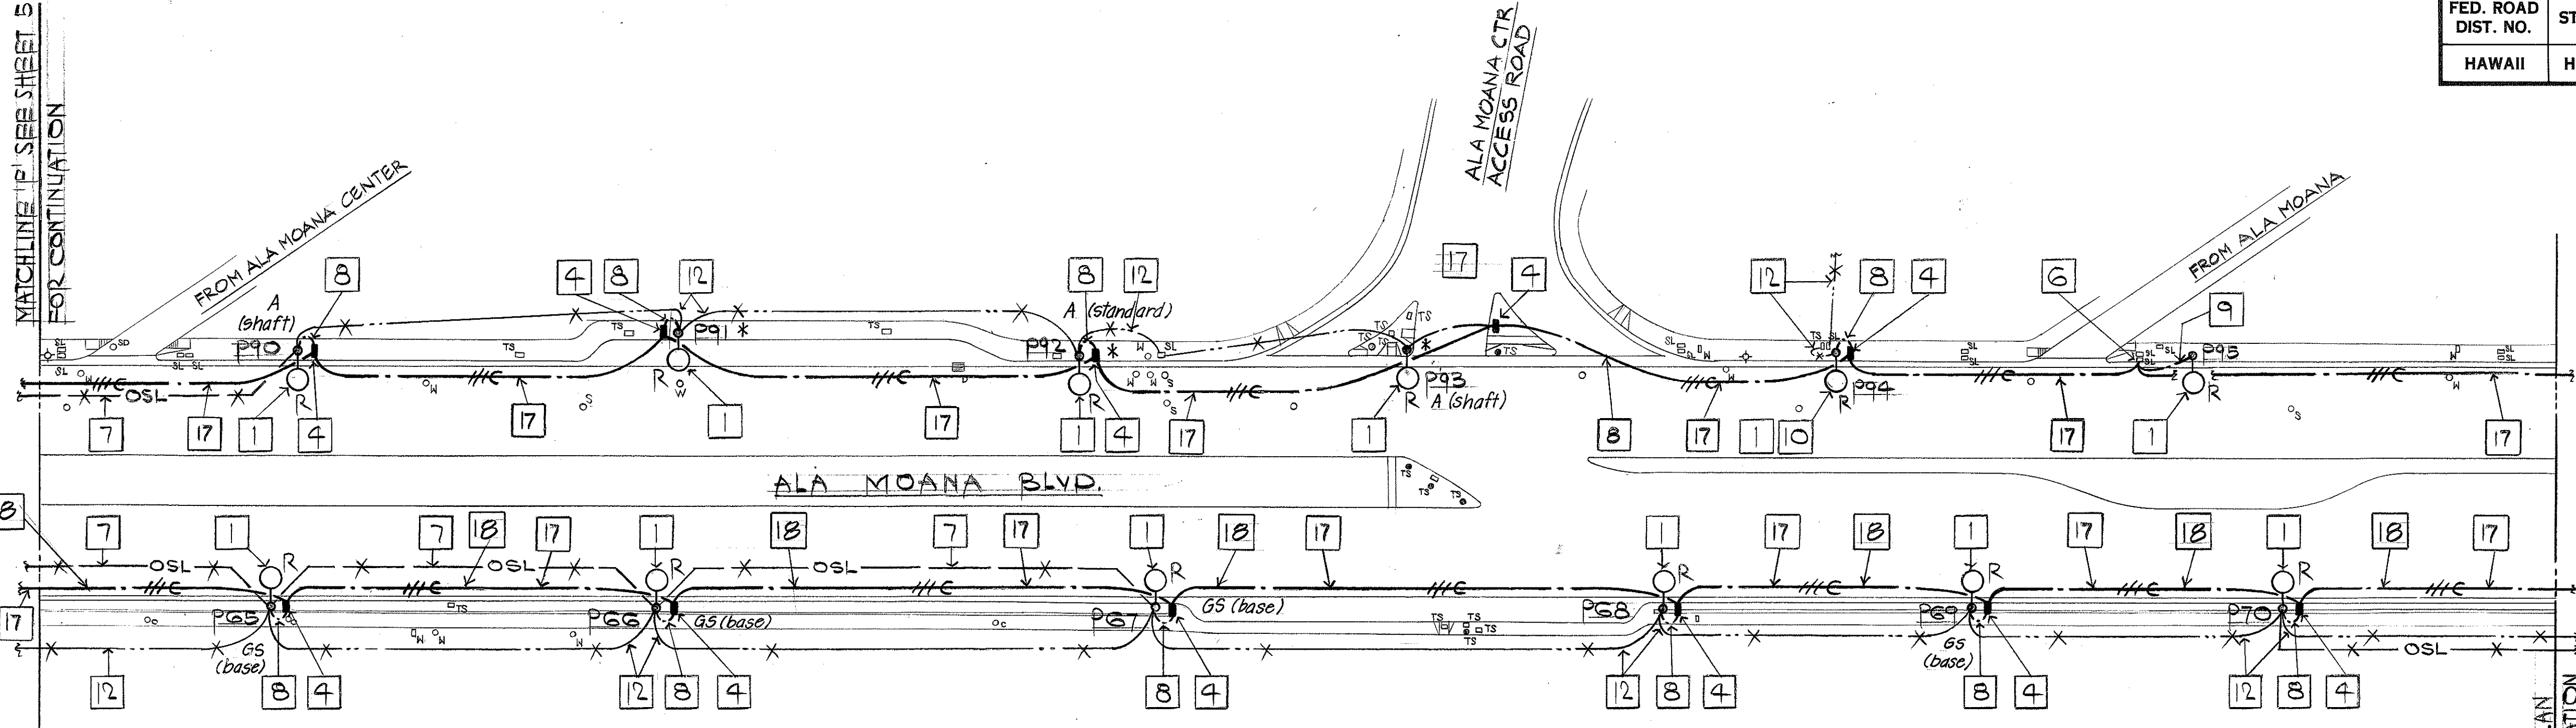

PARTIAL STREET LIGHT PLAN (PART VII)
SCALE: 1" = 40'

*: Anchor bolt splice repair done
A: New aluminum light standard part(s)
GS: New galvanized steel light standard part(s)

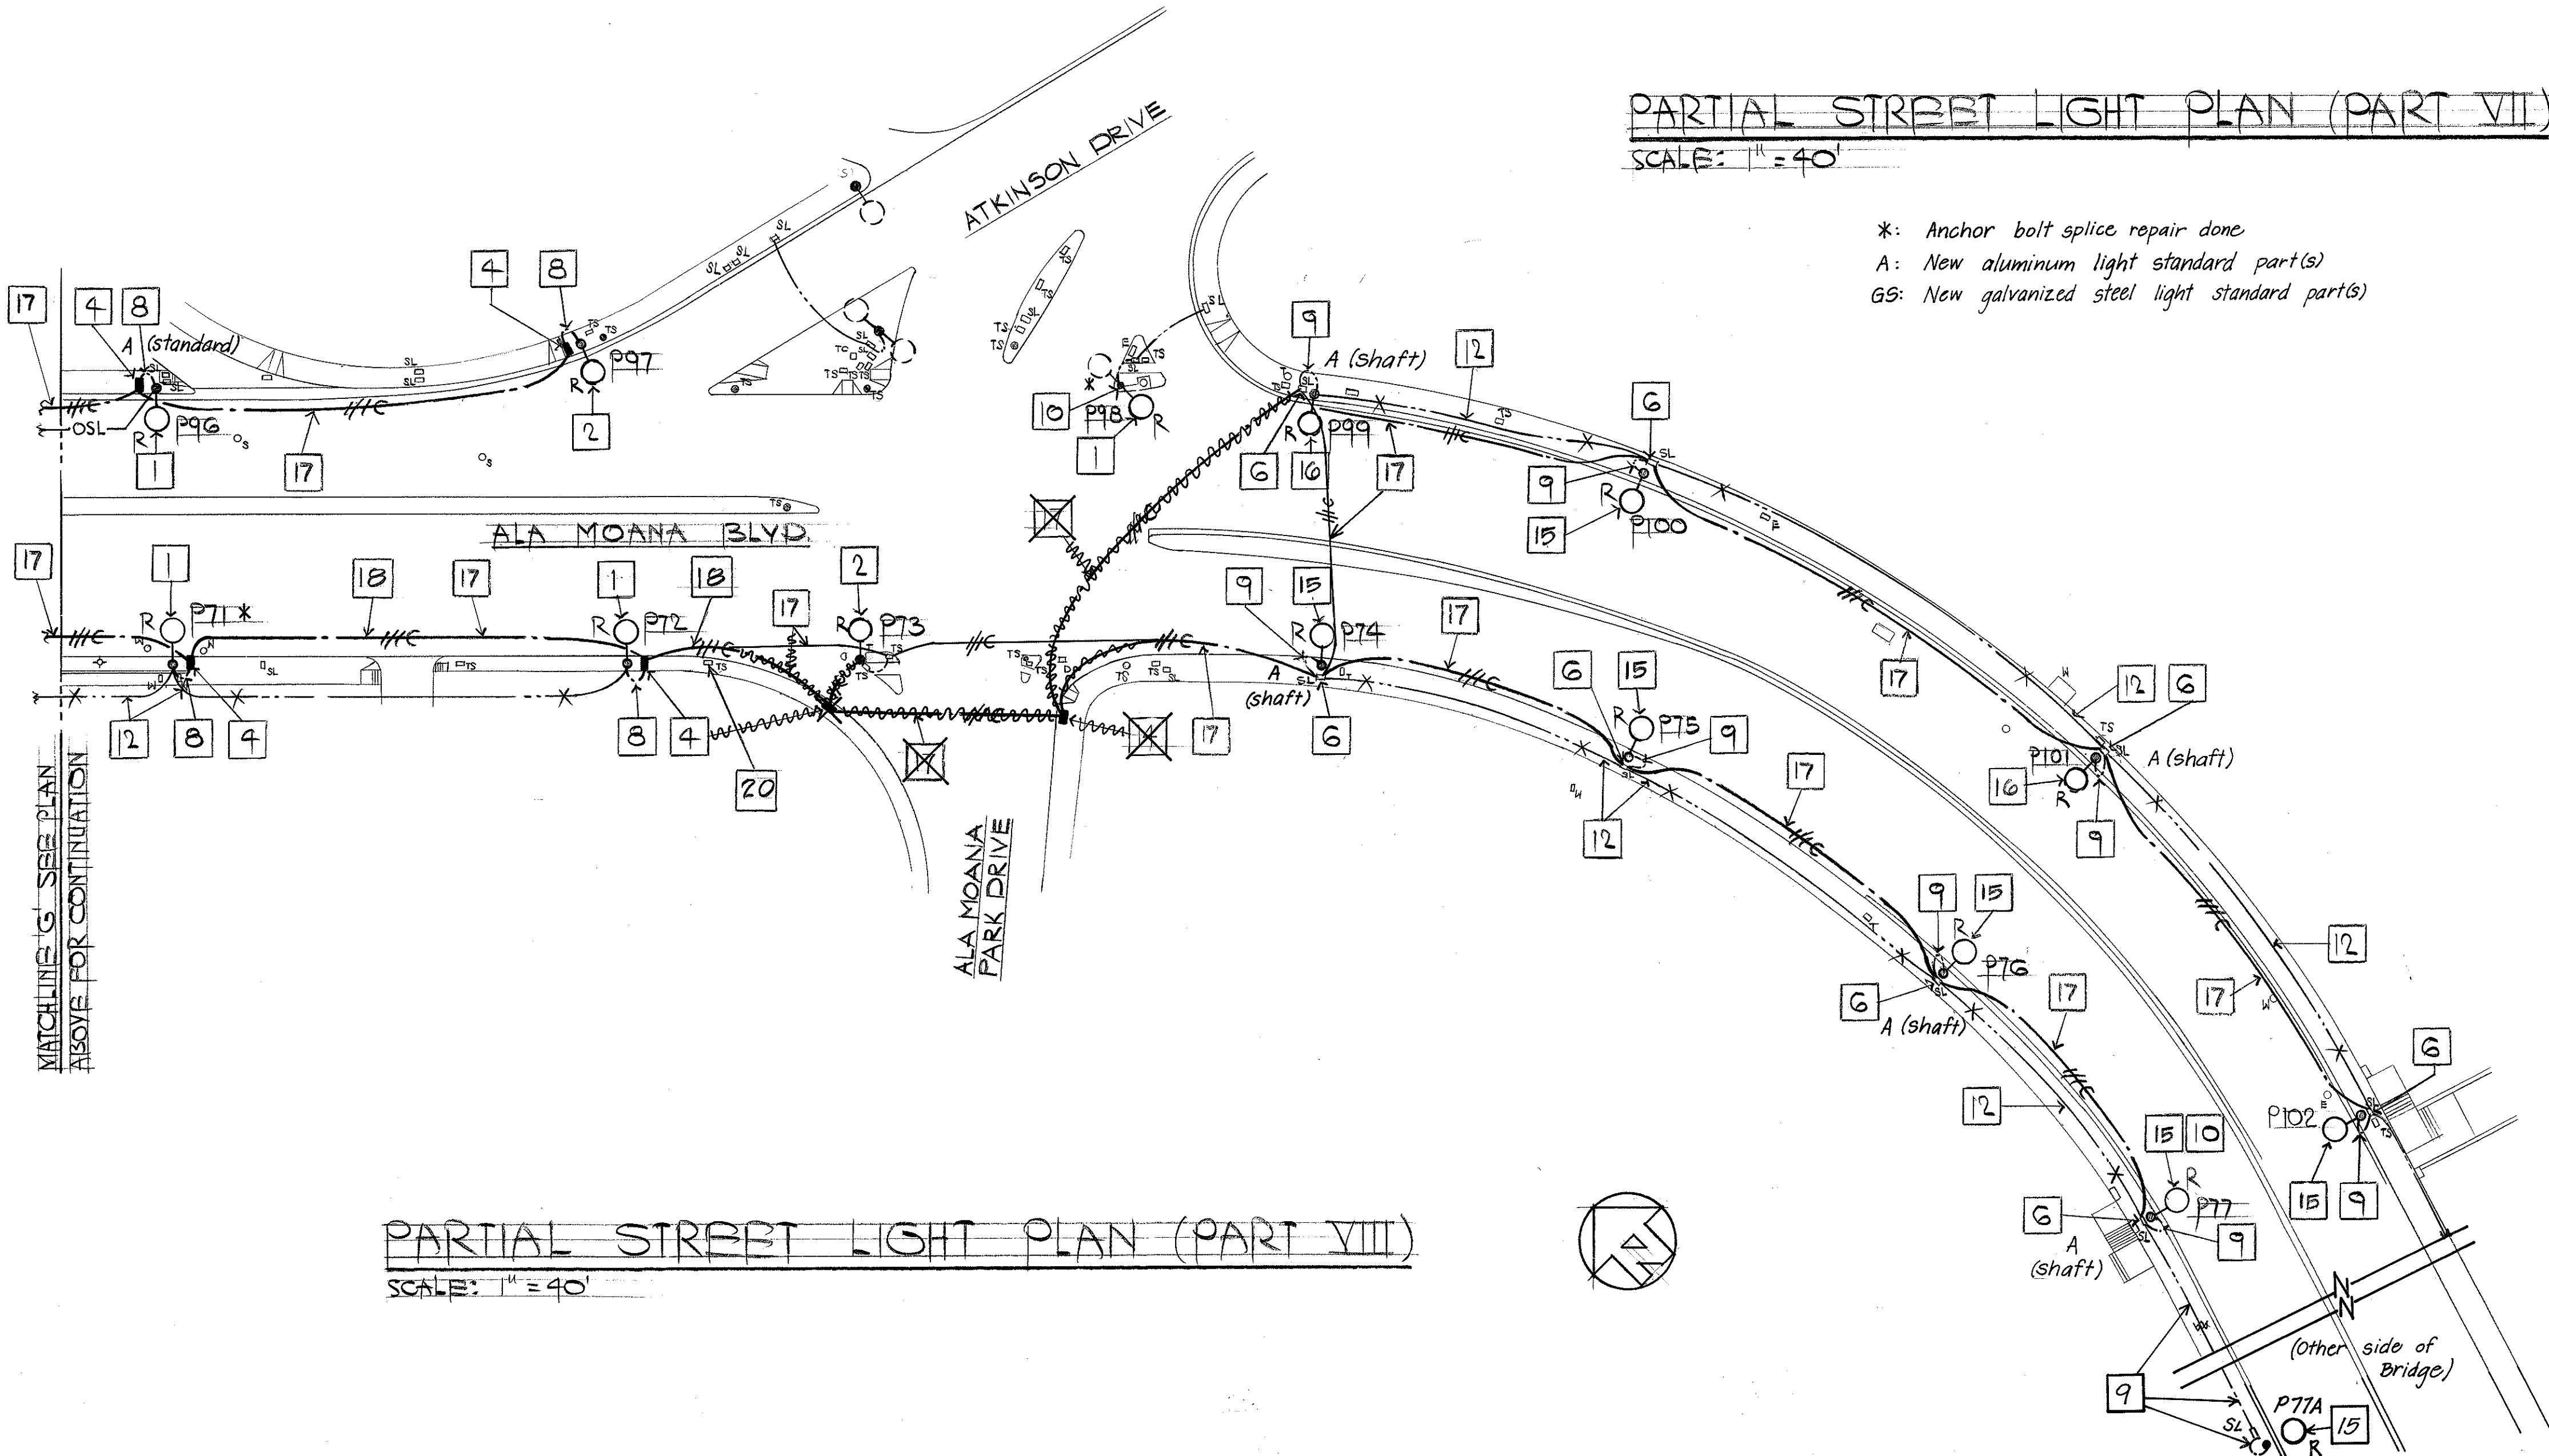

PARTIAL STREET LIGHT PLAN (PART VIII)
SCALE: 1" = 40'

NOTES:
1. SEE STREET LIGHT WIRING DIAGRAM ON SHEET 8 FOR CONDUIT AND WIRE SIZES.

3/20/95 ADD 2" CONDUIT FOR TRAFFIC SIGNALS ALONG WITH STREET LIGHT RACEWAY. BREAK AND PATCH EXISTING TRAFFIC SIGNAL PULLBOX FOR CONDUIT.

DATE REVISION

STATE OF HAWAII
DEPARTMENT OF TRANSPORTATION
HIGHWAYS DIVISION
PARTIAL STREET LIGHT PLAN - PARTS VII AND VIII
HIGHWAY LIGHTING IMPROVEMENTS AND REHABILITATION
ALA MOANA BOULEVARD
KEAKE STREET TO ALA WAI CANAL

ORIGINAL PLAN	SURVEY PLOTTED BY	DATE
TRACED BY		
DESIGNED BY		
CHECKED BY		
NO.		