


FED. ROAD DIST. NO.	STATE	FED. AID PROJ. NO.	FISCAL YEAR	SHEET NO.	TOTAL SHEETS
HAWAII	HAW.	NH-092-1(21)	1994	7	11

REFER TO SHEET 3

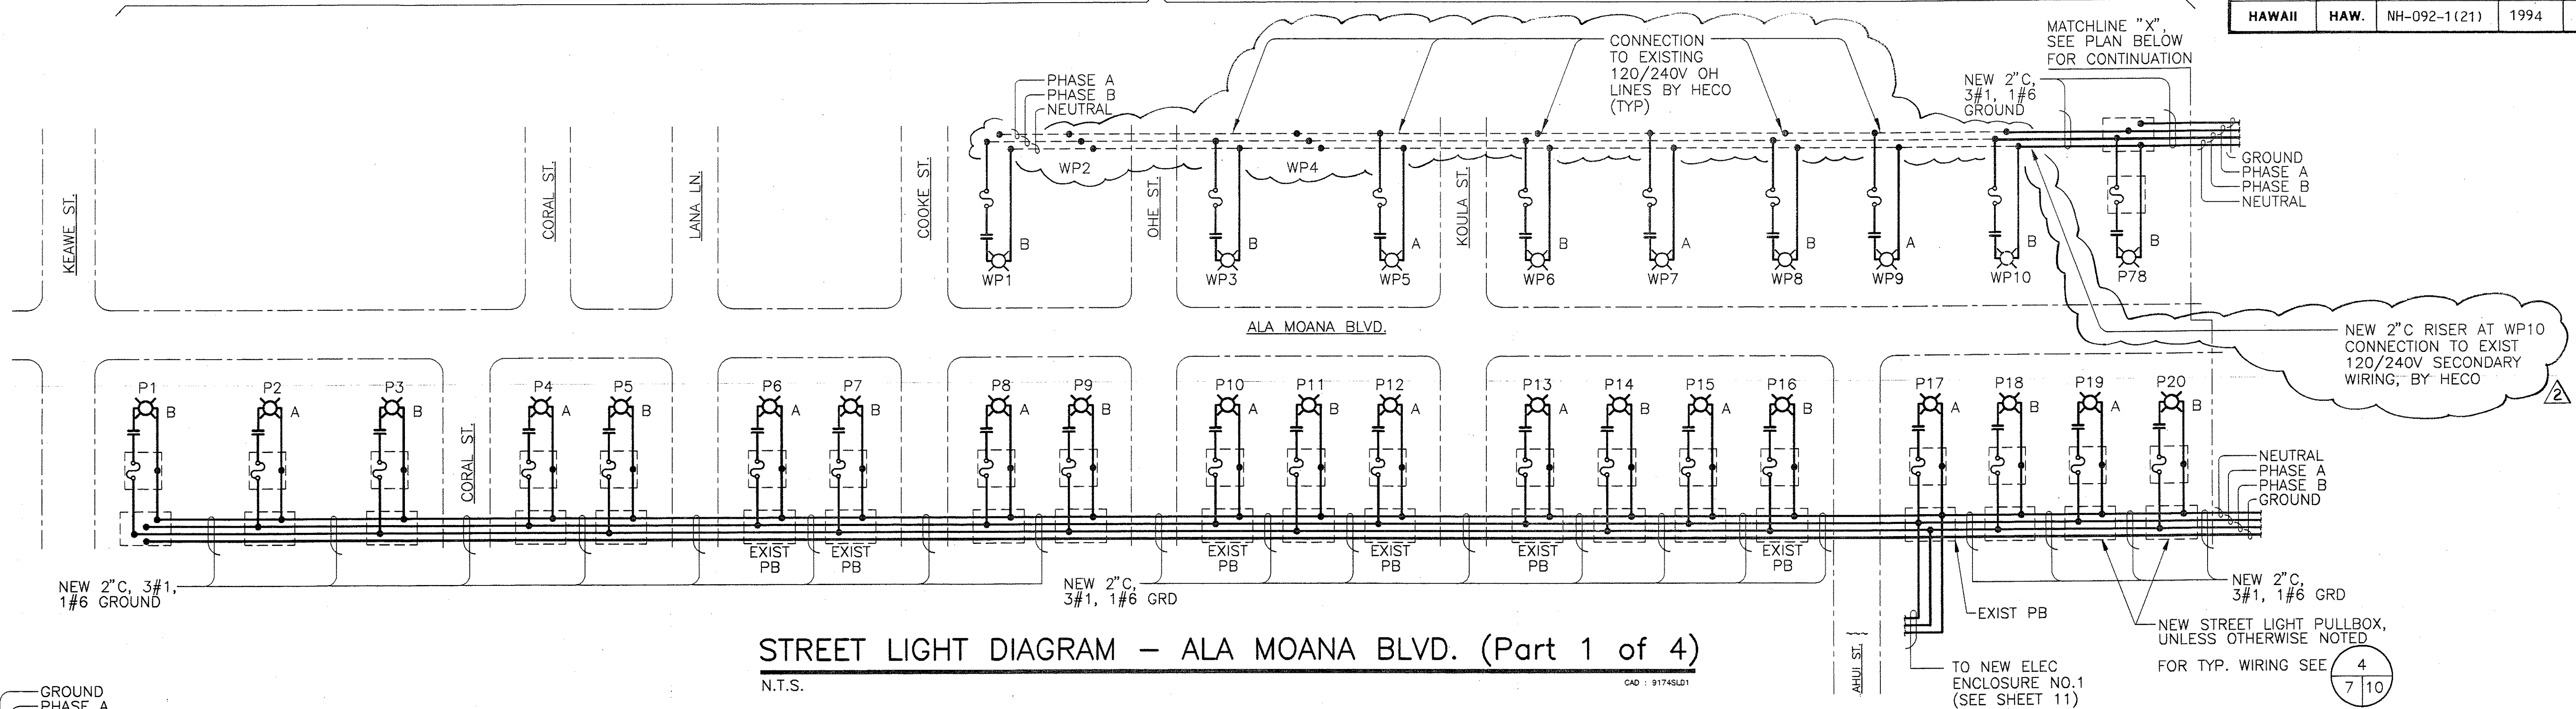


STREET LIGHT DIAGRAM - ALA MOANA BLVD. (Part 1 of 4)

N.T.S.

CAD : 9174SLD1

REFER TO SHEET 4

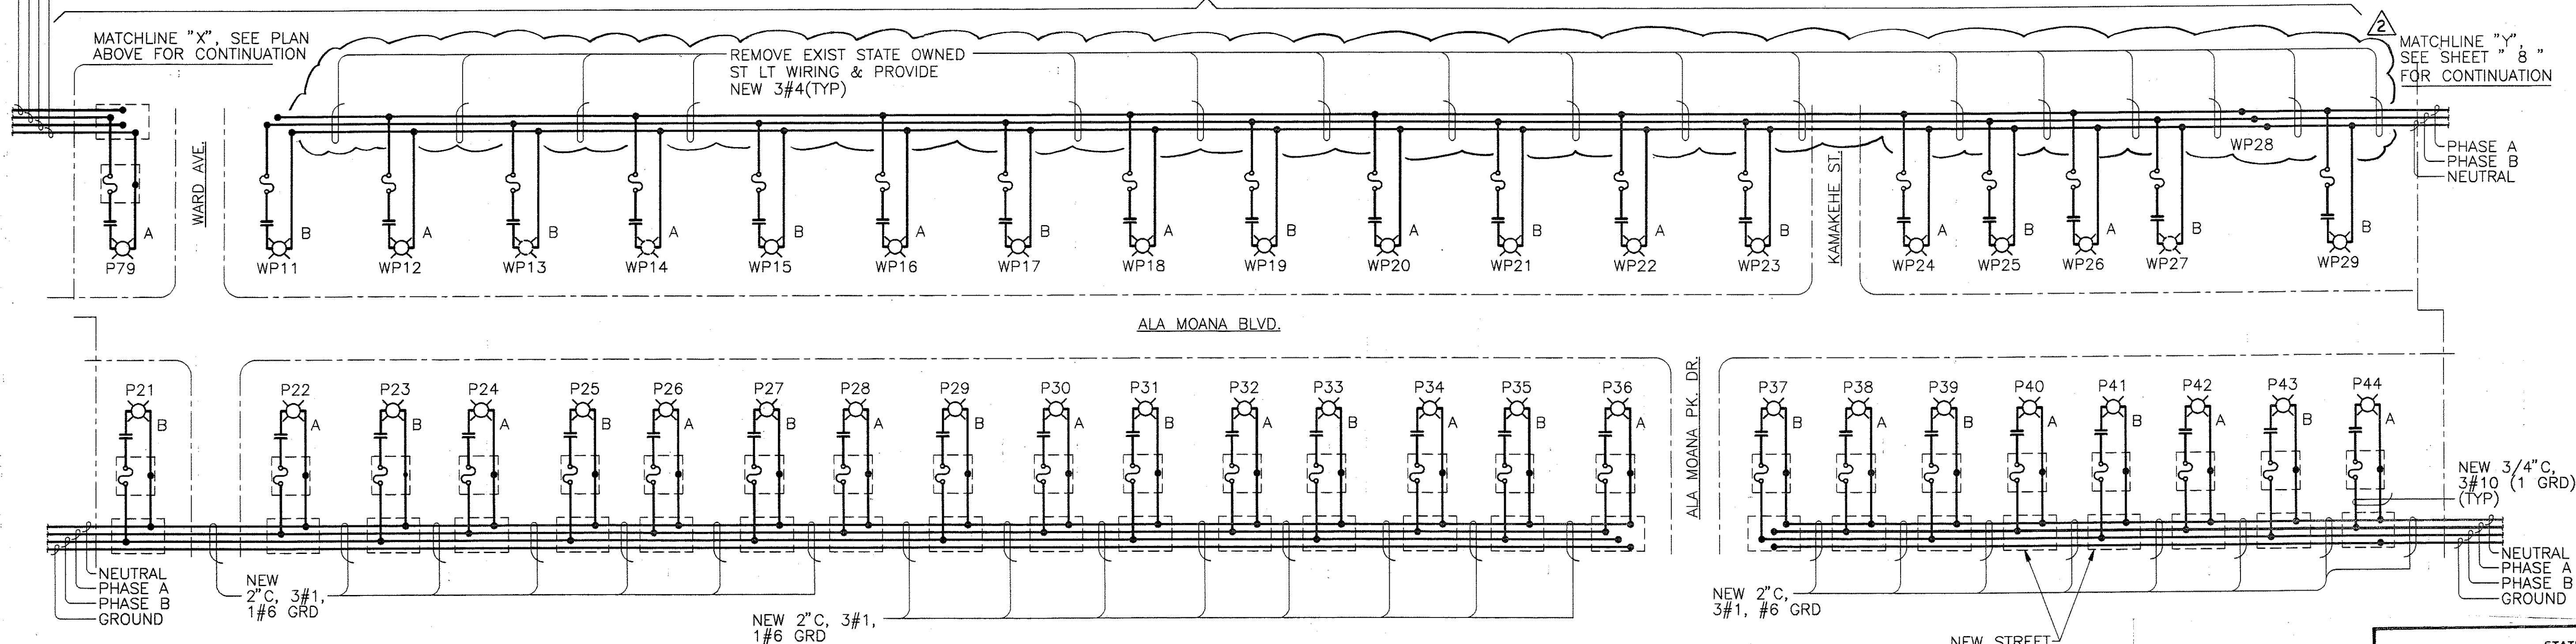


STREET LIGHT DIAGRAM - ALA MOANA BLVD. (Part 2 of 4)

N.T.S.

CAD : 9174SLD1

DATE	
SURVEY PLOTTED BY	
DRAWN BY	
DESIGNED BY	
QUANTITIES BY	
CHECKED BY	
ORIGINAL PLAN	
NOTE BOOK	
NO.	

5-23-95	△	REVISED STREET LIGHT DIAGRAM	
7-20-94	▲	REVISED STREET LIGHT DIAGRAM	
DATE	SYM	REVISION	ENG

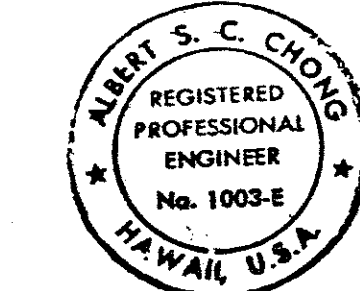

THIS WORK WAS PREPARED BY ME
OR UNDER MY SUPERVISION
Albert S. C. Chong

STATE OF HAWAII
DEPARTMENT OF TRANSPORTATION
HIGHWAYS DIVISION

STREET LIGHT DIAGRAM - PARTS 1 AND 2

HIGHWAY LIGHTING IMPROVEMENTS AND REHABILITATION
ALA MOANA BOULEVARD
KEAWE STREET TO ALA WAI CANAL

SHEET NO. 7 OF 11 SHEETS

