



FED. ROAD DIST. NO.	STATE	PROJ. NO.	FISCAL YEAR	SHEET NO.	TOTAL SHEETS
HAWAII	HAW.	92A-01-96M	1996	5	5

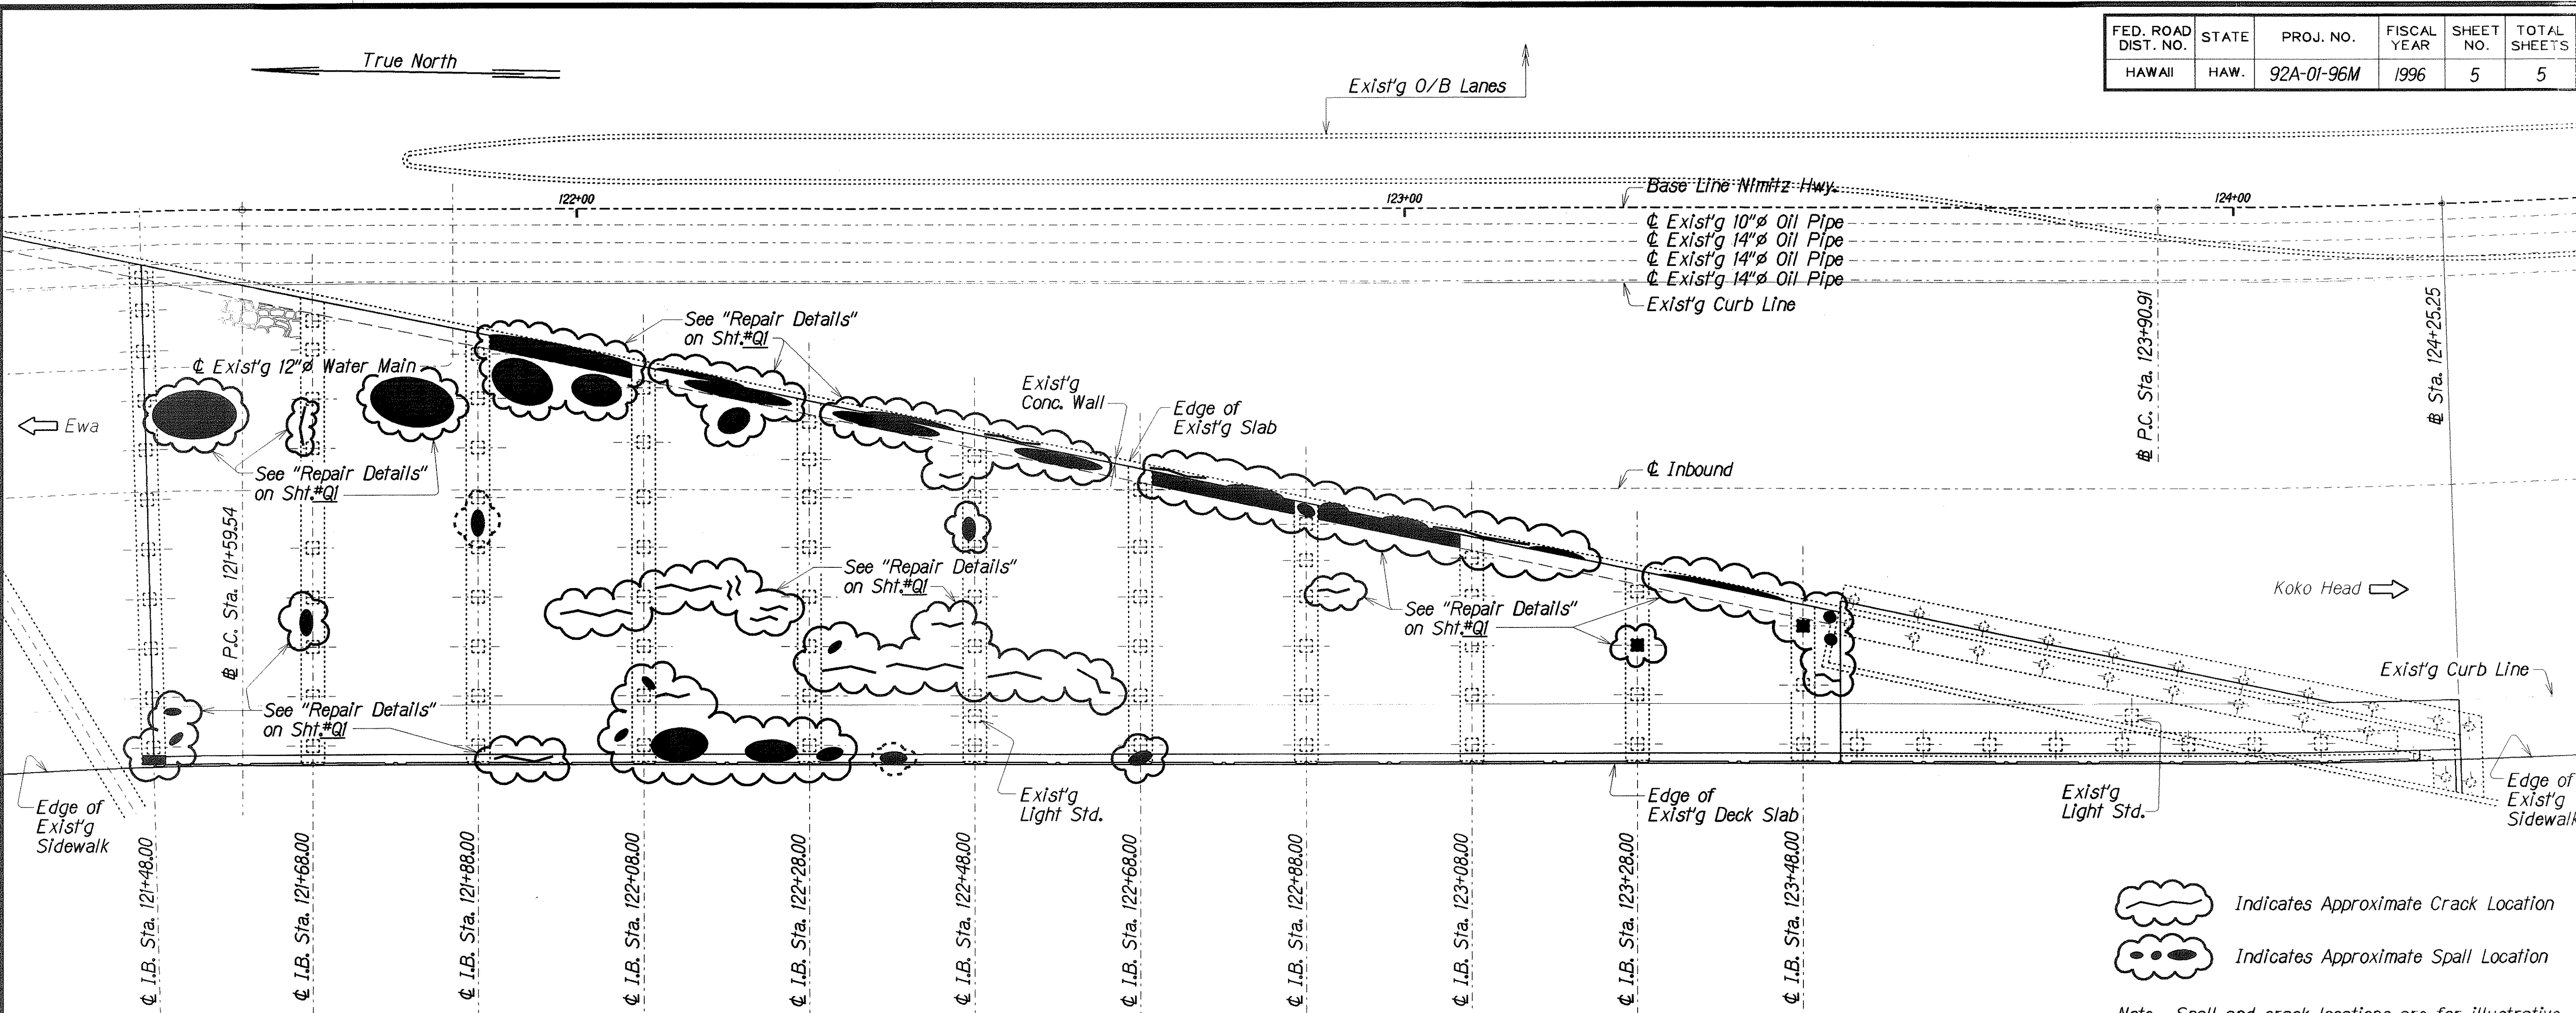

REFLECTED CEILING PLAN -- SLIP COVER NO. 1

Scale: 1" = 10'-0"

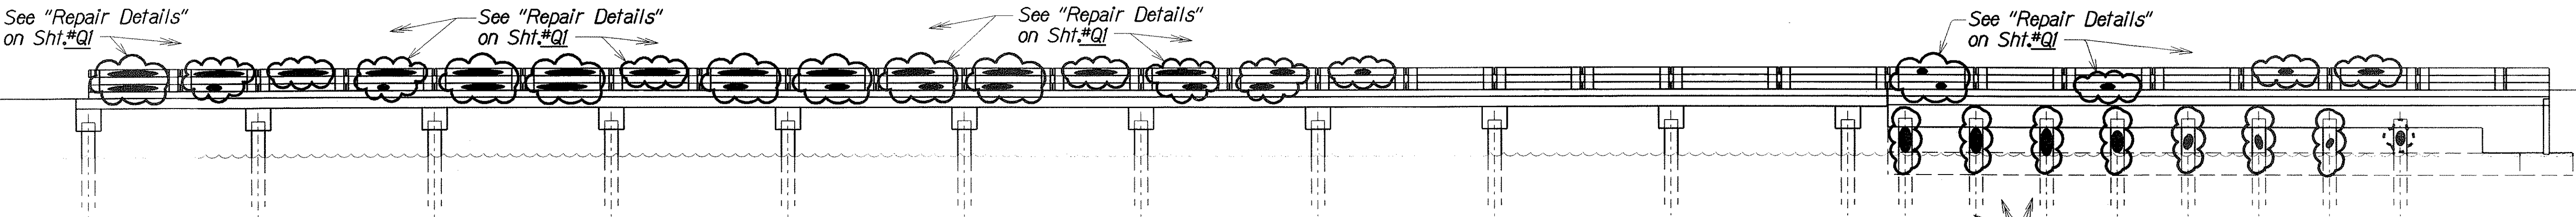

ELEVATION - SHOWING RAIL AND PILE SPALL LOCATIONS

(FACING MAUKA)

Scale: 1" = 10'-0"

ORIGINAL PLAN	DATE: MAR 1996
DRAWN BY: KSG	
TRACED BY: KBY	
QUANTITIES BY: DOO	
CHECKED BY: N. J. G. V. 2.00	

LEGEND FOR AS-BUILT POSTINGS	
	Squiggly line for as-built deletion
	Double line for as-built deletion
Roadway	Text for as-built posting

STATE OF HAWAII
DEPARTMENT OF TRANSPORTATION
HIGHWAYS DIVISION

SPALL REPAIR LOCATIONS
NIMITZ HIGHWAY, SLIP COVER NO. 1
Repair Spalls at Soffit, Piles and Pier Caps
Project No. 92A-01-96M

Scale: As Noted

Date: Mar, 1996