	INDEX TO DRAWINGS
SHEET NO.	DESCRIPTION
1	TITLE SHEET
2	STANDARD PLANS SUMMARY
3	GENERAL NOTES
4	TYPICAL CONC. REPAIRS GENERAL
	NOTES & ESTIMATED QUANTITIES
5	SPALL REPAIR LOCATIONS
	·
	·

STATE OF HAWAII

## DEPARTMENT OF TRANSPORTATION


HIGHWAYS DIVISION HONOLULU, HAWAII

PLANS FOR

## NIMITZ HIGHWAY

SLIP COVER AT RIVER STREET PROJECT NO. 92A-01-96M

DISTRICT OF HONOLULU ISLAND OF OAHU

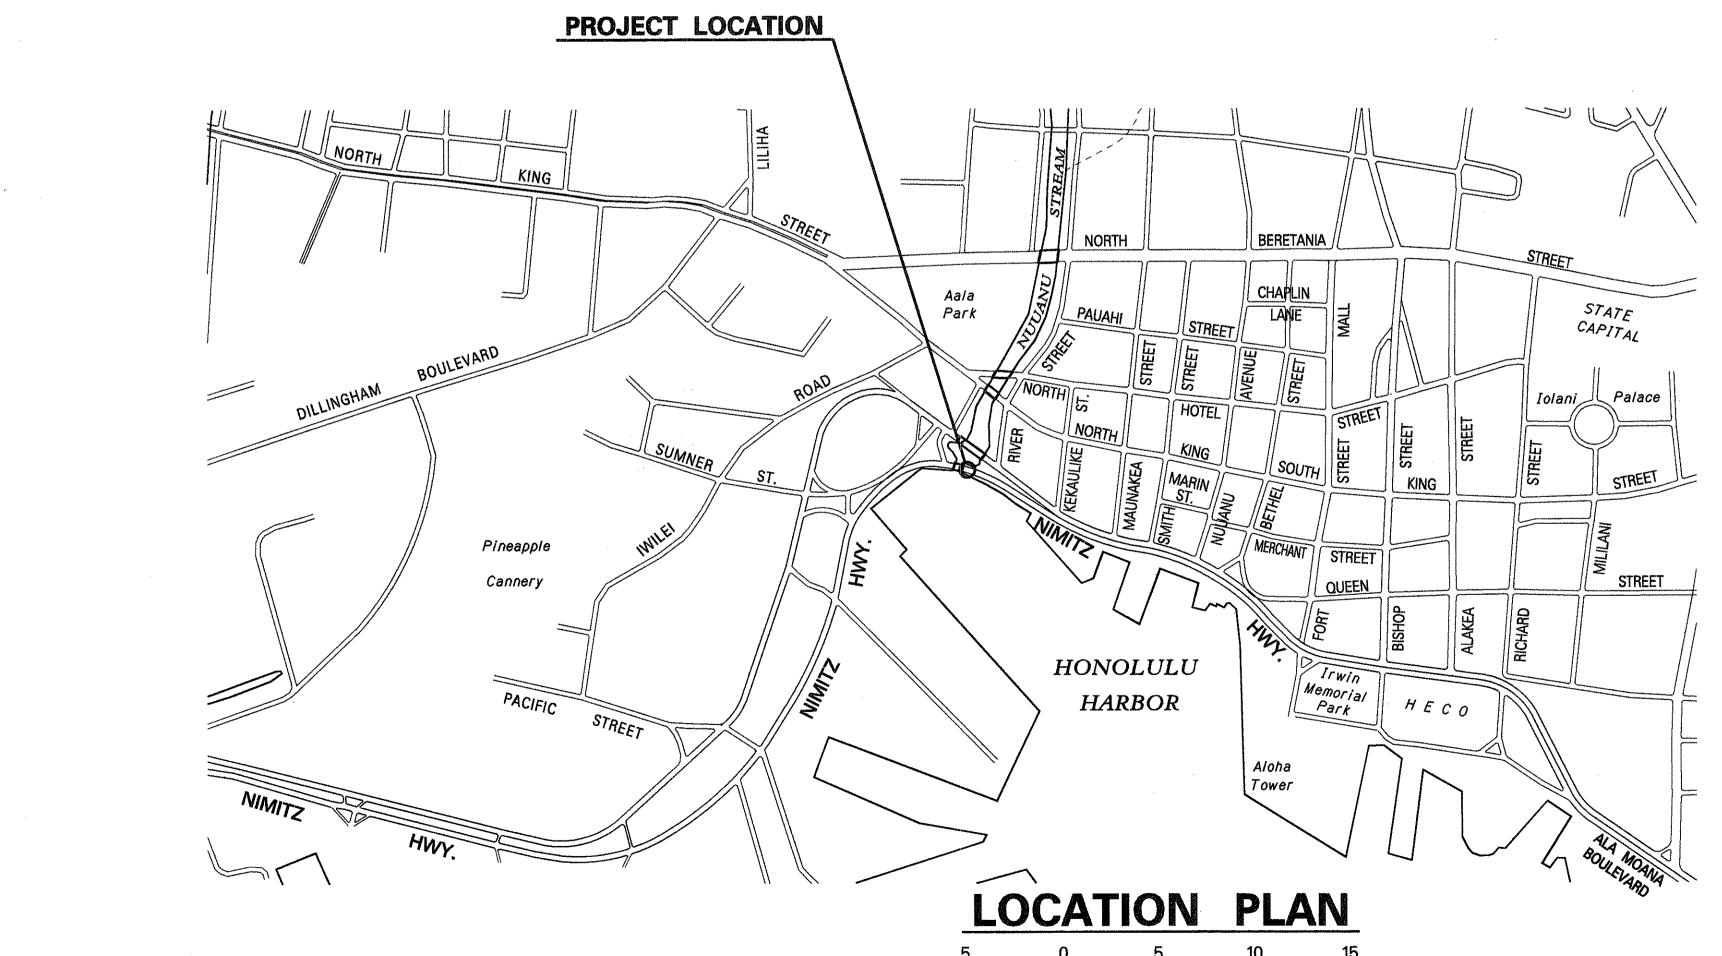

SCALE IN HUNDRED FEET

Wainen O A H Wainen Walnale Walnama Wa

FEDERAL AID PROJECTS PREVIOUSLY CONSTRUCTED OR UNDER CONSTRUCTION

92A--01--96M

MILE POST 5.92

CHANGES MADE DURING CONSTRUCTION HAVE BEEN INCORPORATED ON THESE PLANS EXCEPT CHANGES IN THE ORIGINAL THEORETICAL QUANTITIES. FOR ACTUAL QUANTITIES, REFER TO PROJECT LEDGER AND/OR COMPUTATION BOOK.

Kelvin akagawa 11-28-01
FOR RESIDENT ENGINEER DATE

DEPARTMENT OF TRANSPORTATION STATE OF HAWAII

APPROVED:

DIR. OF TRANSPORTATION DATE