




15 NOT TO SCALE

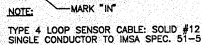

WIRING DIAGRAM
NOT TO SCALE

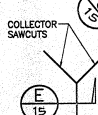


SAW CUT DETAIL
NOT TO SCALE

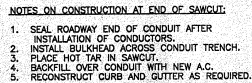

15 NOT TO SCALE



D SECTION
15 NOT TO SCALE

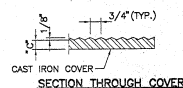

NOTE:
COVER TO BE CAST FROM GREY IRON


	TYPE "A"	TYPE "B"	TYPE "C"
A	19-3/4"	23-1/2"	30"
B	12"	15-3/4"	20"
C	1/2"	1/2"	5/8"
D	22-1/2"	26-1/4"	33-3/4"
E	14-3/4"	18-1/2"	23-3/4"
F	1"	1"	2"
G	1-1/4"	1-1/4"	1-1/2"
H	1/2"	1/2"	1-3/8"



15 NOT TO SCALE




SECTION "A"

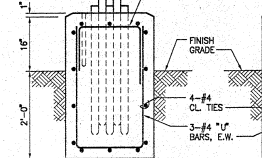

SECTION "B"



15) NOT TO SCALE

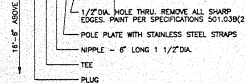

TYPICAL VERTICAL MOUNT OF
EVP DETECTOR
NOT TO SCALE

