

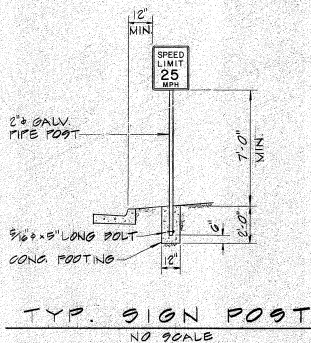


NOTES

1. ALL STREET SIGNS AND PAVEMENT MARKINGS SHALL BE IN ACCORDANCE WITH MANUAL ON UNIFORM TRAFFIC CONTROL DEVICES FOR STREET AND HIGHWAYS.
2. RAISED PAVEMENT MARKERS SHALL BE INSTALLED IN ACCORDANCE WITH THE DTS STANDARDS.
3. SIGNS SHALL BE ATTACHED TO BRACKET WITH 5/16" ZINC PLATED STEEL BOLTS, NUTS AND WASHERS.
4. SIGNS 48" WIDE OR LARGER THAN 10 SQ. FT. IN AREA SHALL BE MOUNTED ON 2-2" Ø GALV. PIPE POST. THE SIGN SHALL BE INSTALLED WITH AT LEAST (1) ONE FOOT CLEARANCE FROM THE SIGN EDGE OF THE CURB FACE.
5. ALL TRAFFIC SIGNS SHALL BE REFLECTORIZED.
6. WHITE AND YELLOW PAINT (PAVEMENT MARKINGS) SHALL BE REFLECTORIZED AND CONFORM TO THE STANDARD SPECIFICATION ON FILE IN THE DEPARTMENT OF TRANSPORTATION SERVICES.
7. PAVEMENT WORD AND SYMBOL MARKINGS SHALL BE IN ACCORDANCE WITH THE DTS STANDARDS.

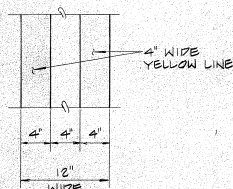

DOUBLE YELLOW LINES

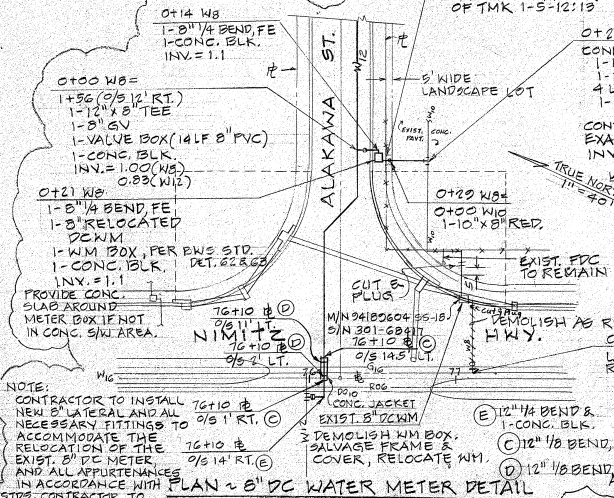

EXIST. W2 MOUNTED TO BOX CULVERT WALL TO BE REROUTED AS REQUIRED SEE DETAIL 2/8

NOTE: CONTRACTOR SHALL MAINTAIN UNINTERRUPTED WATER SERVICE THROUGH W2 LATERAL

WATER CONNECTION
8+95 TO CONN. TO EXIST. 12" WATER REMOVE & SALVAGE CLEANOUT W/CAP. REMOVE CONC. BLK. INSTALL: 8 LF 12" PVC PIPE, CL. 150 1-12" SLEEVE 12" LONG TEMP. FOR TESTING 1-12" CAP W/4" CO.

PLAN & ENLARGEMENT

SCALE: 1"=20'

REVISION		DATE		BY	
1/1/11		ADDED 8" DC WM DET.		MEI	
M&E PACIFIC, INC. ENGINEERS & ARCHITECTS HONOLULU, HAWAII					
DOLE WHOLE CANNERY ALAKAWA ST. EXTENSION HONOLULU, HAWAII					
MISCELLANEOUS TRAFFIC DETAILS & NOTES					
DRAWN BY: G.P.		ENGINEER: P.I.		DATE: 3/13/45	
APPROVED BY: [Signature]		CHIEF PLANNING ENGR. P.W.S.		DATE: 3/13/45	