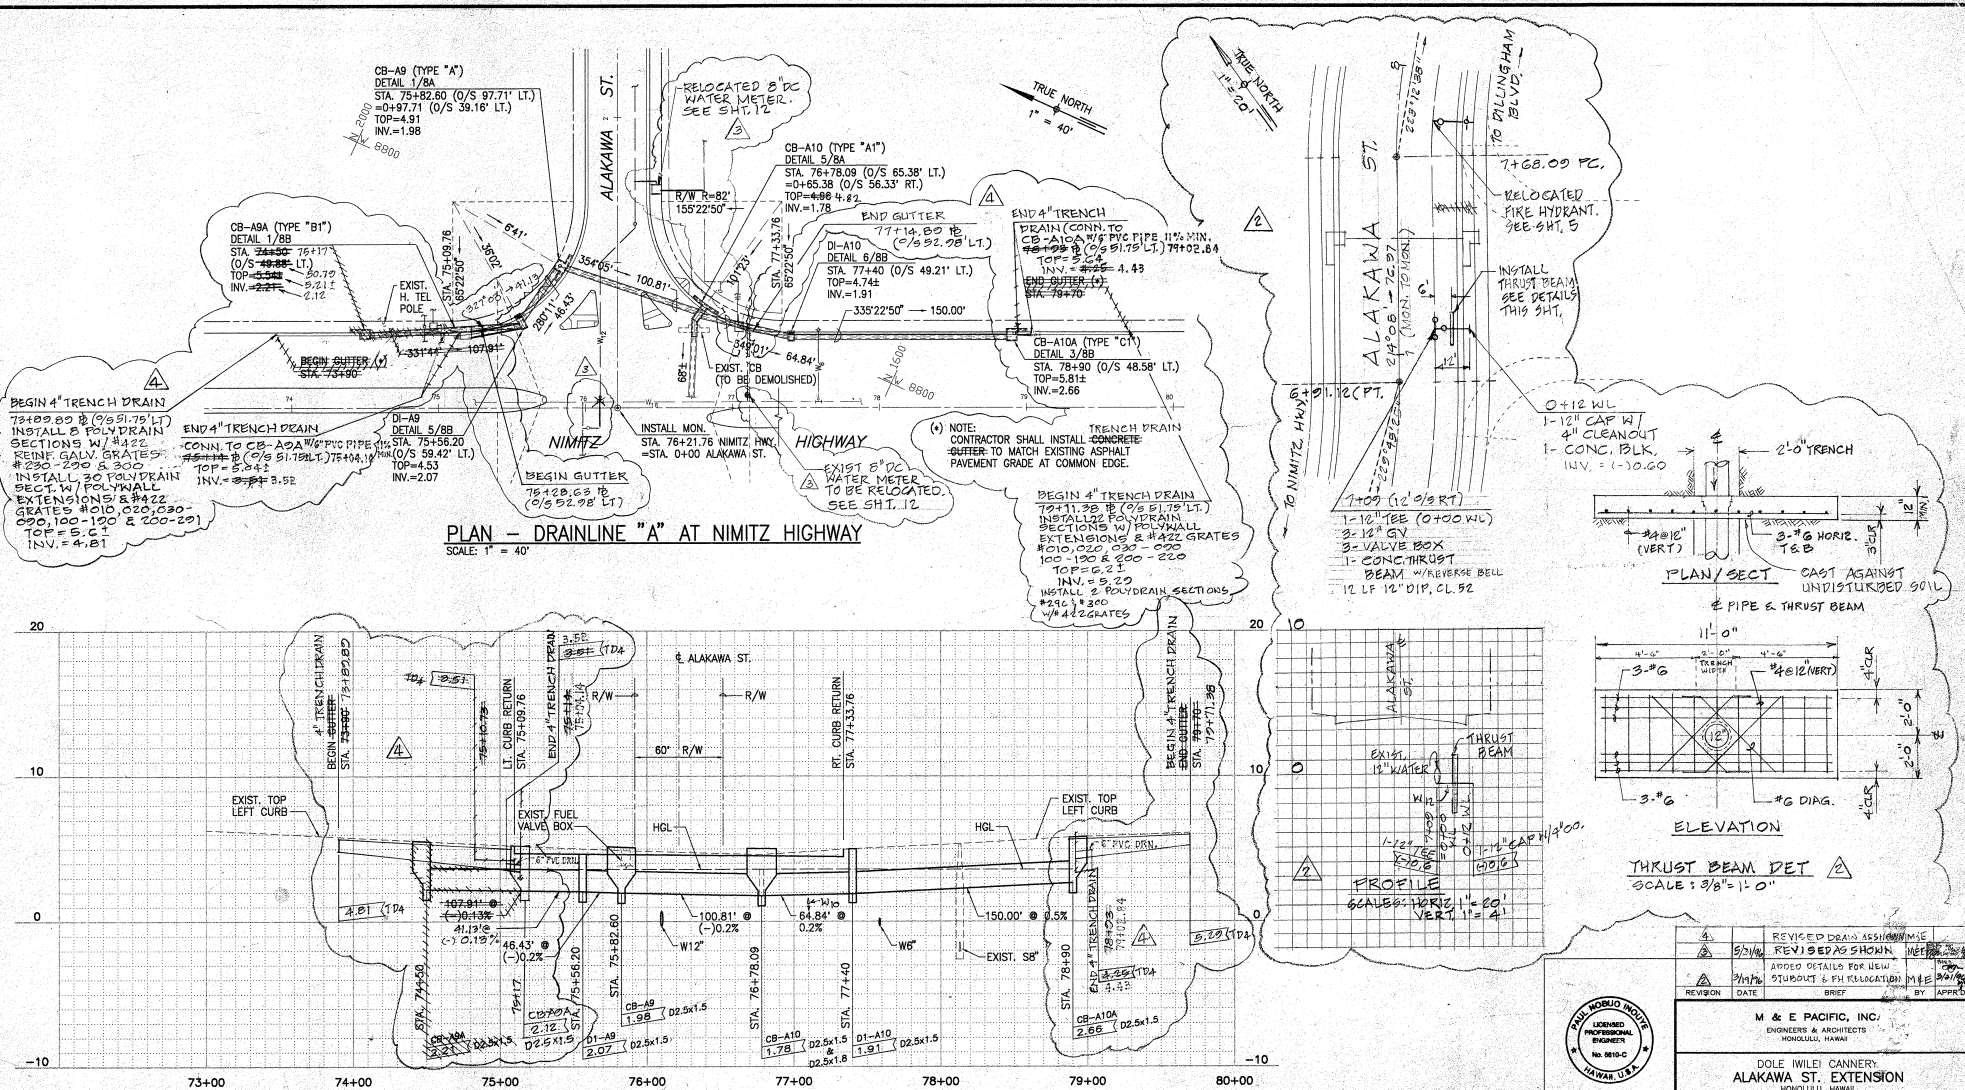


4	REVISED DRAINAGE	DATE	BY	APPROVED
3	ADDED DETAILS FOR NEW	DATE	BY	APPROVED
2	STUDY & PH RELOCATION	DATE	BY	APPROVED
1	DATE	DATE	DATE	DATE

M & E PACIFIC, INC.
ENGINEERS & ARCHITECTS
HONOLULU, HAWAII

DOLE (WILEI) CANNERY
ALAKAWA ST. EXTENSION
HONOLULU, HAWAII

PLAN & PROFILE
DRAINLINE "A" AT NIMITZ HIGHWAY

DRAWN BY: RA ENGINEER: PI

APPROVED BY: *[Signature]* 3/1/92