


CONSTRUCTION PLANS FOR DOLE IWILEI CANNERY ALAKAWA ST. EXTENSION

(STA. 0+00 TO STA. 8+66.12)
(PROPOSED PUBLIC ROAD)

HONOLULU, HAWAII

OWNER/DEVELOPER:
DOLE FOOD CO., INC.
CASTLE & COOKE, INC.

PREPARED BY:
M&E PACIFIC, INC.,
ENGINEERS & ARCHITECTS

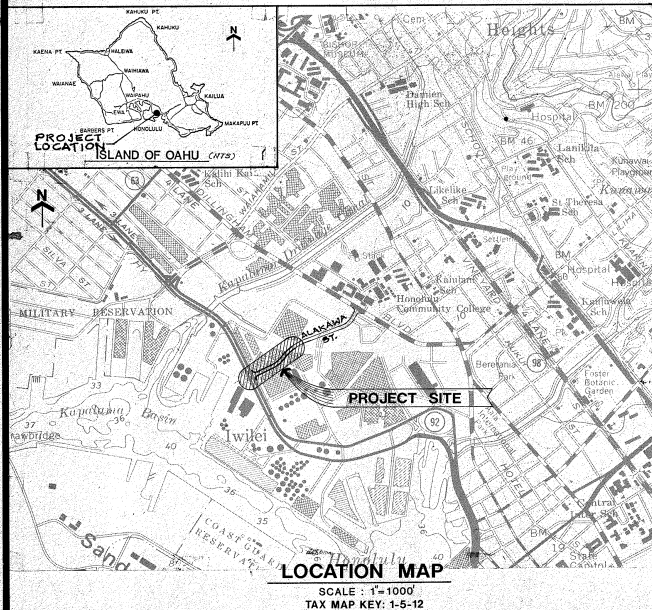

INDEX OF DRAWINGS	
SHT. NO.	TITLE
1	TITLE SHEET
2	CONSTRUCTION NOTES
3	CONSTRUCTION NOTES
4	GENERAL PLAN
5	PLAN & PROFILE ALA KAWA ST. EXT. (STA. 0+00 TO 8+66.12)
6	CURB RETURNS & MEDIAN DETAILS
7	MISCELLANEOUS DETAILS
8	DRAINAGE DETAILS - 1
9	EROSION CONTROL PLAN
10	CROSS SECTIONS
11	TRAFFIC SIGNS & PAVEMENT MARKING PLANS
12	MISCELLANEOUS TRAFFIC DETAILS & NOTES
13	TRAFFIC SIGNAL PLAN
14	TRAFFIC SIGNAL SYSTEM MISCELLANEOUS DETAILS
15	LOOP DETECTORS
16	TRAFFIC CONTROL PLANS - 1
17	ELECTRICAL PLAN & DETAILS
18	MISCELLANEOUS ELECTRICAL DETAILS
19	STREET TREE PLAN
19A	LANDSCAPE PLANTING PLAN
19B	LANDSCAPE IRRIGATION PLAN
19C	IRRIGATION EQUIPMENT LIST, PLANT LIST DETAILS AND NOTES
19D-19E	CATHODIC PROTECTION DETAILS - CP-1 & CP-2

APPROVED BY:

Raymond H. White
MANAGER & CHIEF ENGINEER, BOARD OF WATER SUPPLY

3-9-97
DATE

APPROVED BY:

Donald P. King
DIRECTOR, DEPARTMENT OF LAND UTILIZATION

8-2-97
DATE

Richard C. Johnson
FIRE DEPARTMENT, CITY AND COUNTY OF HONOLULU

OCT 20 1997
DATE

Donald P. King
DIRECTOR & CHIEF ENGINEER, DEPT. OF PUBLIC WORKS

10/14/97
DATE

Thomas E. Chappin
CHIEF, ENVIRONMENTAL MANAGEMENT DIVISION
STATE OF HAWAII

8-8-97
DATE

Sevanna
DIRECTOR, DEPT. OF TRANSPORTATION SERVICES
(FOR CONSTRUCTION WITHIN CITY ROW ONLY)

7/27/98
DATE

Deborah M. Smith ACTING
DIRECTOR, DEPT. OF WASTEWATER MANAGEMENT, C&C
(FOR SEWER WORK WITHIN CITY JURISDICTION ONLY)

8/22/94
DATE

William H. Morikawa
ADMINISTRATOR, HIGHWAY DIVISION STATE D.O.T.
(APPROVAL GRANTED FOR WORK WITHIN
STATE HIGHWAY RIGHT-OF-WAY ONLY. ID NO. 0-94-30
LETTER OF APPROVAL NO. HWY.-CM-26663
DATED 7-26-95)

28/2/95
DATE

SHEET 1 OF 30 SHEETS

RECORD DRAWINGS

File No. ~~2-2-97~~