 
 


**NOTE:**


1. Conduits shall protrude 2" max. above finished surface of foundation.
2. Conduits shall slope away from pole foundation.



## TYPICAL EQUIPMENT MOUNTINGS



## TYPICAL VEHICULAR AND PEDESTRIAN SIGNAL MOUNTINGS

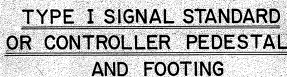

## TYPE II MAST ARM AND STANDARD



SHEET 14 OF 30 SHEETS **RECORD DRAWINGS**