

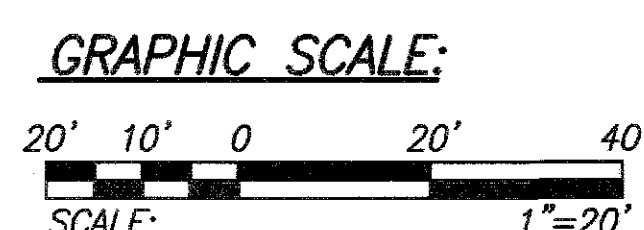
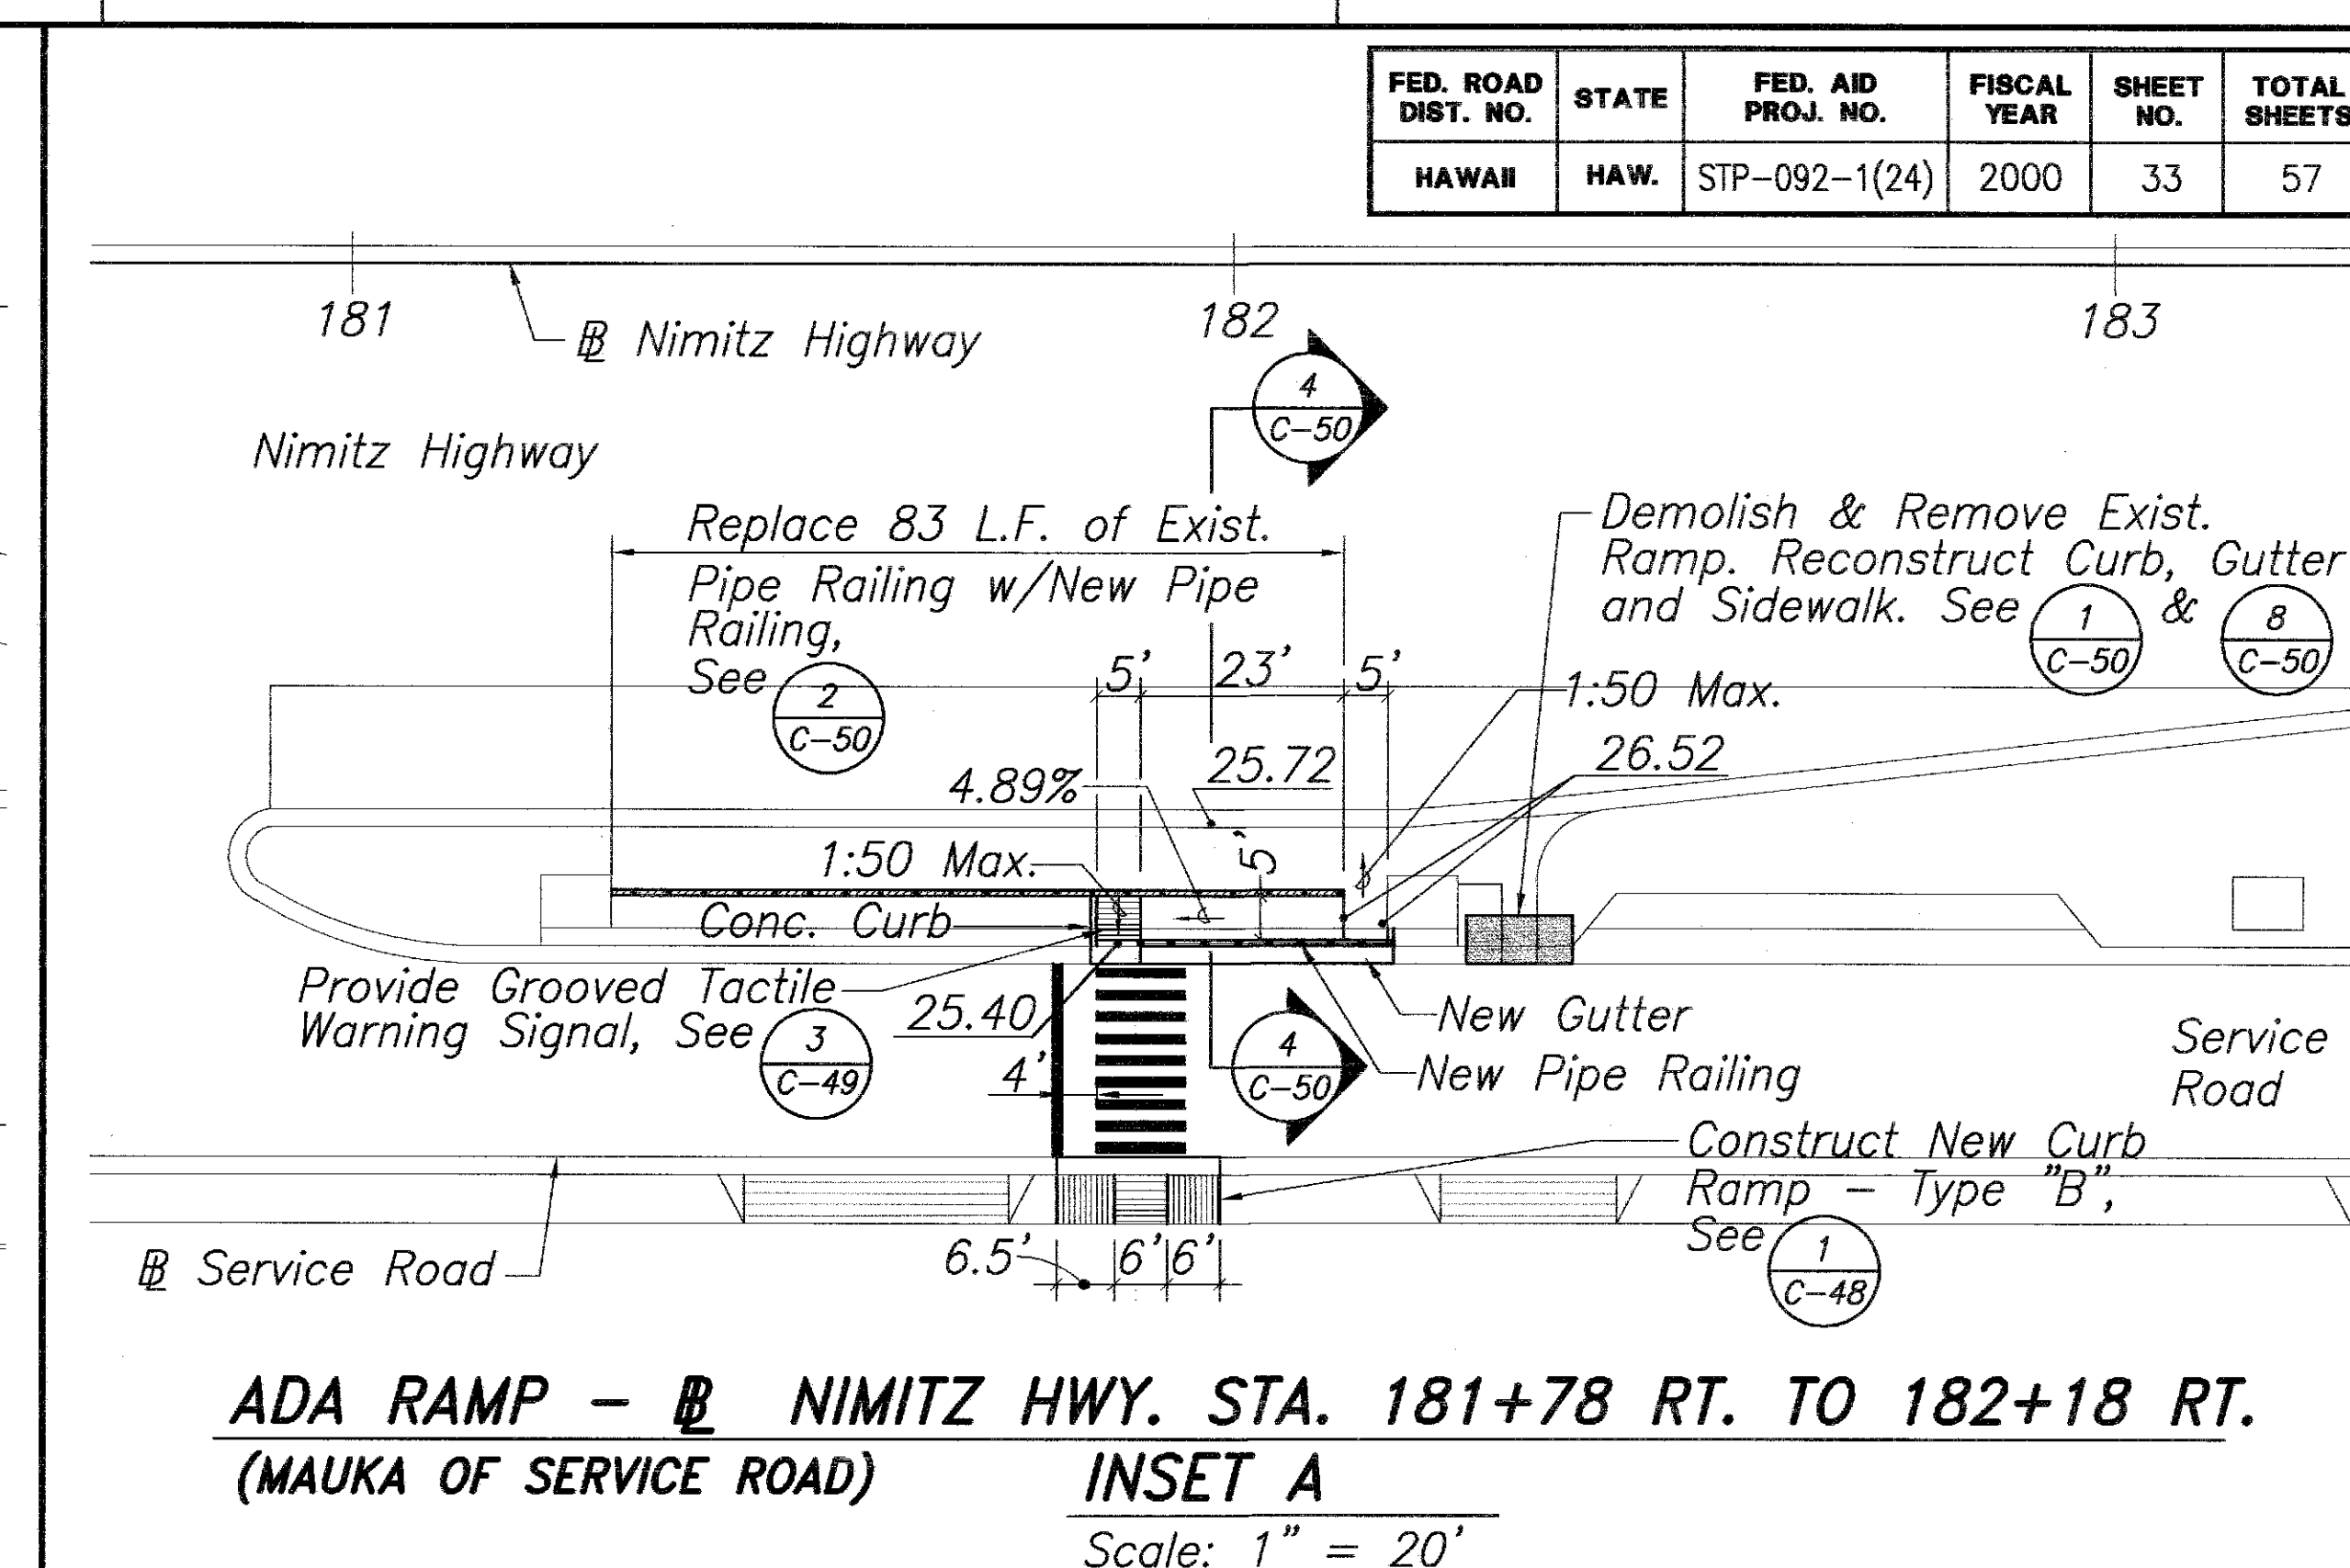
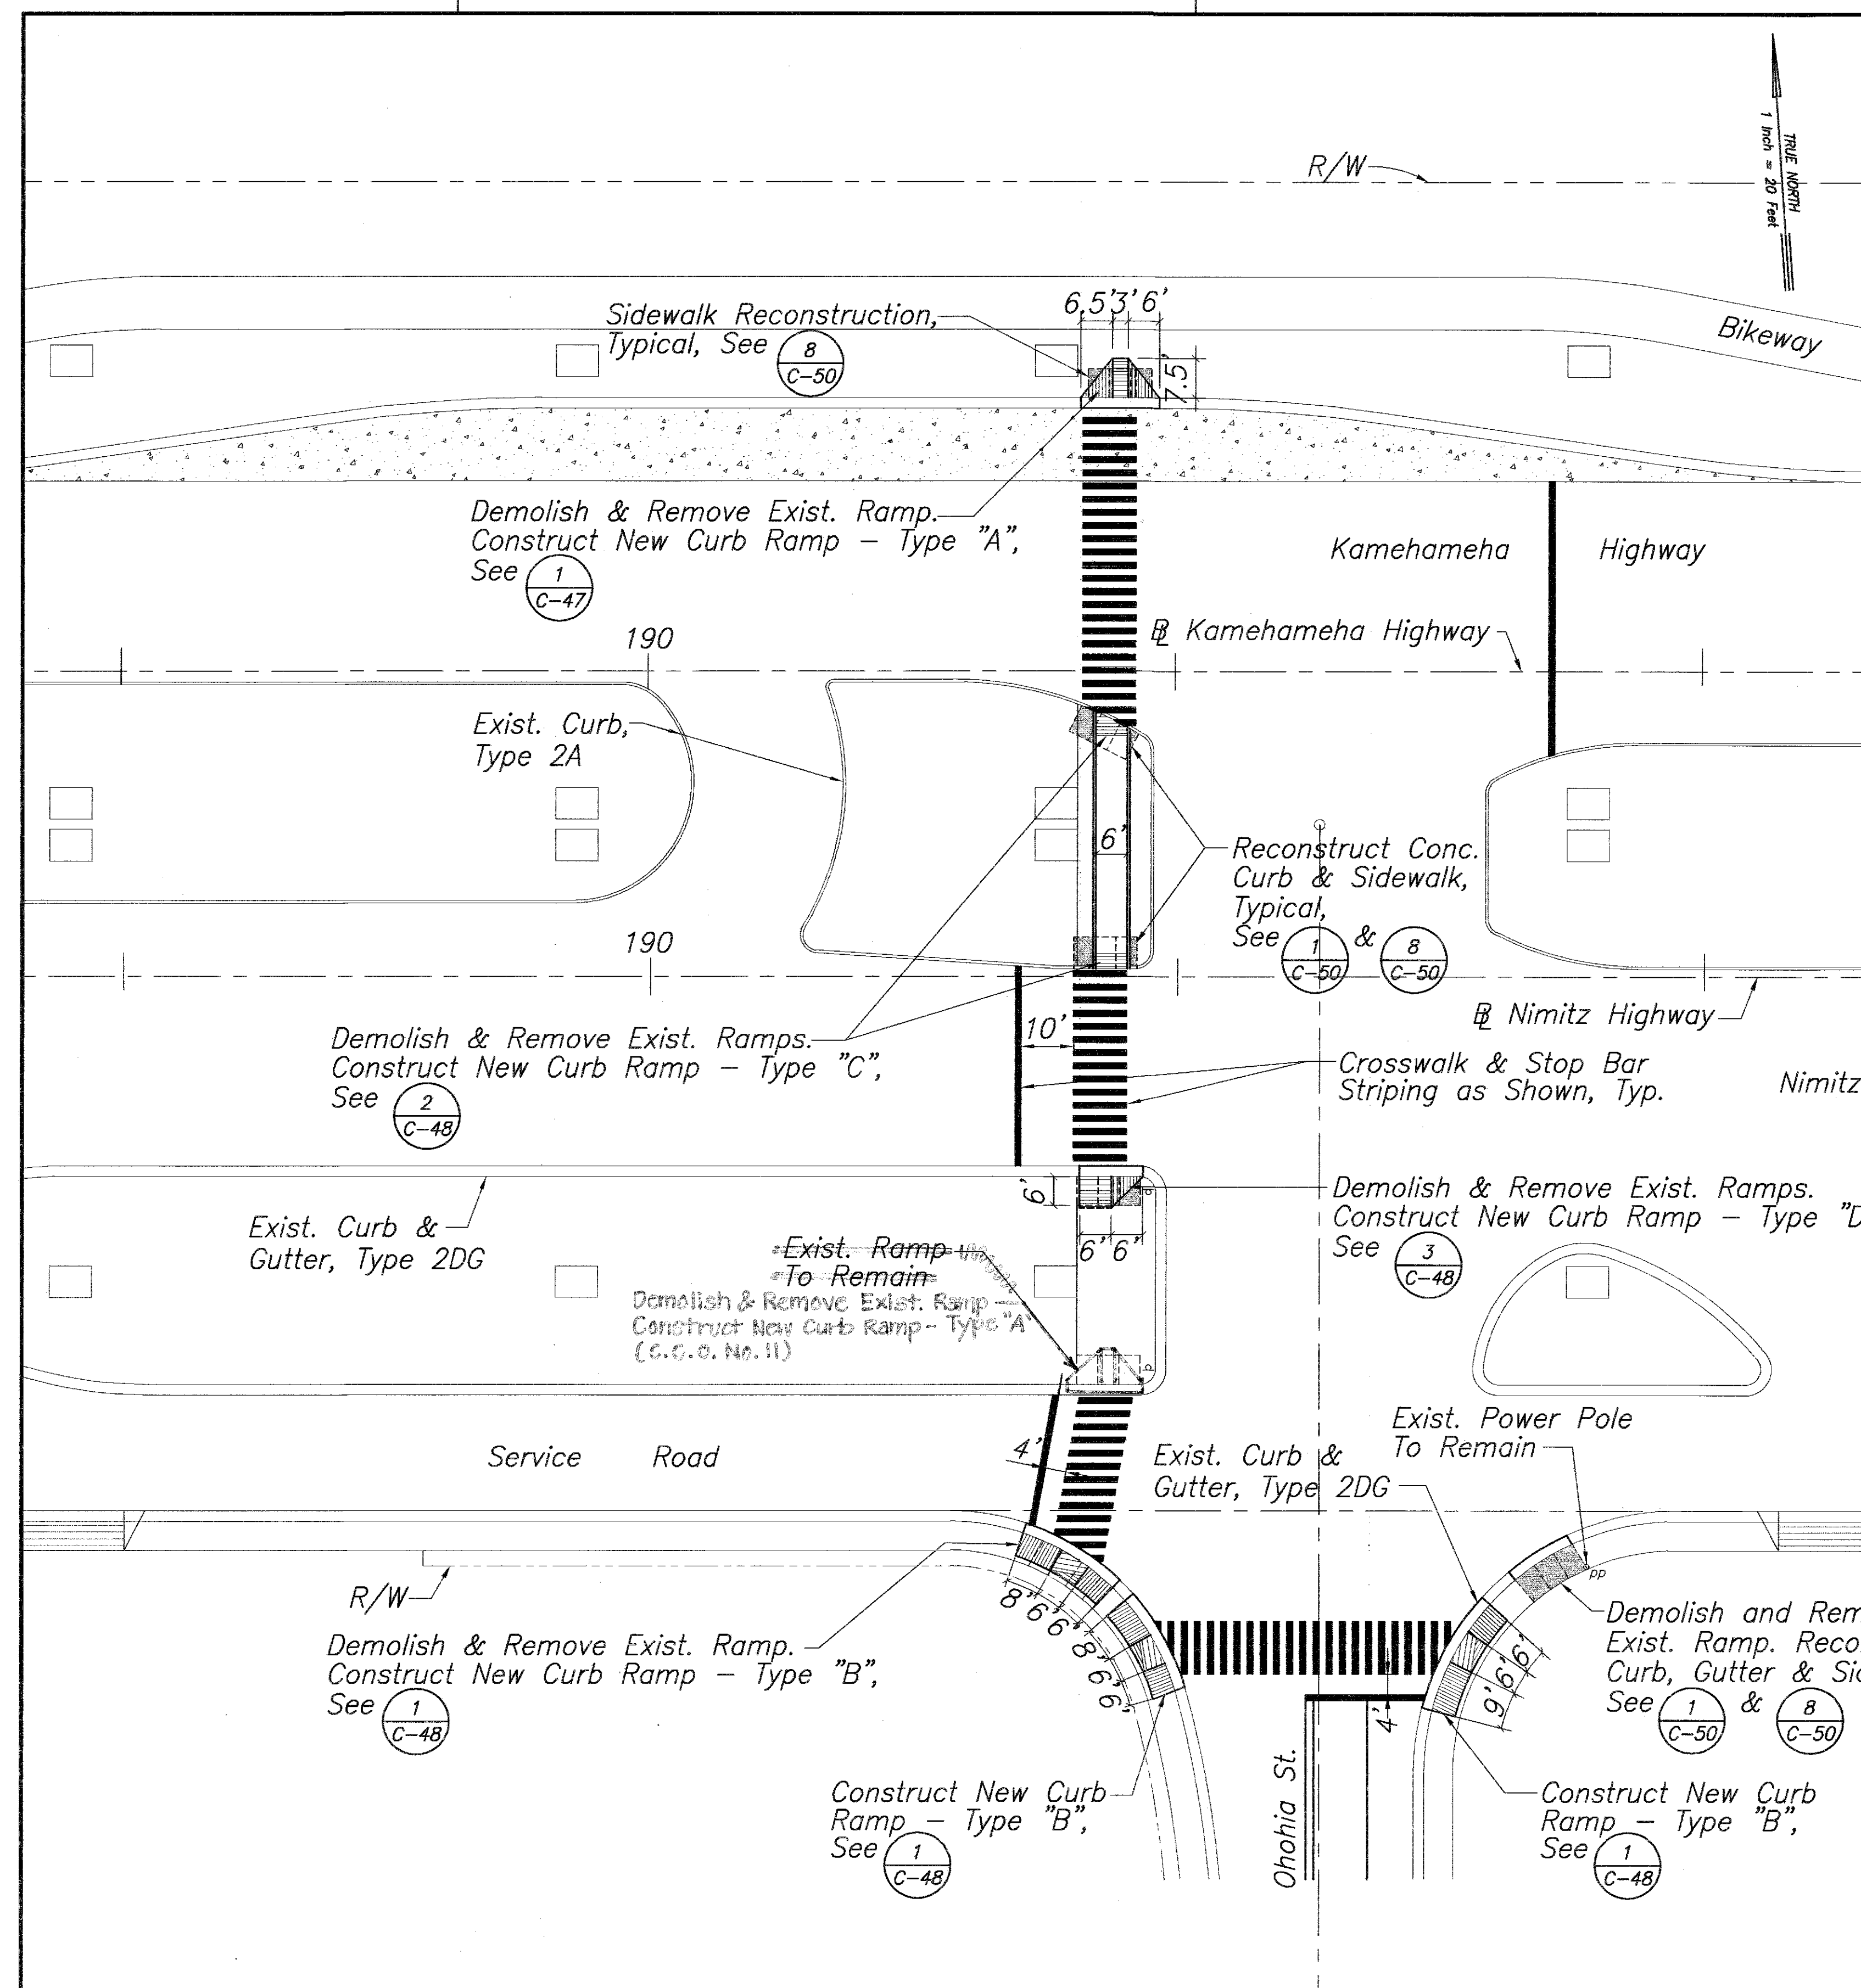


FED. ROAD DIST. NO.	STATE	FED. AID PROJ. NO.	FISCAL YEAR	SHEET NO.	TOTAL SHEETS
HAWAII	HAW.	STP-092-1(24)	2000	33	57

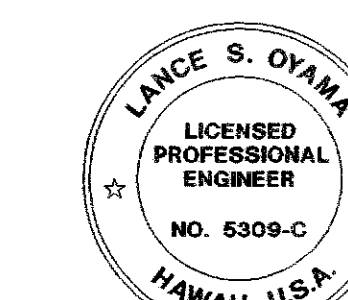

INTERSECTION PLAN - Ohohia Street

Scale: 1" = 20'

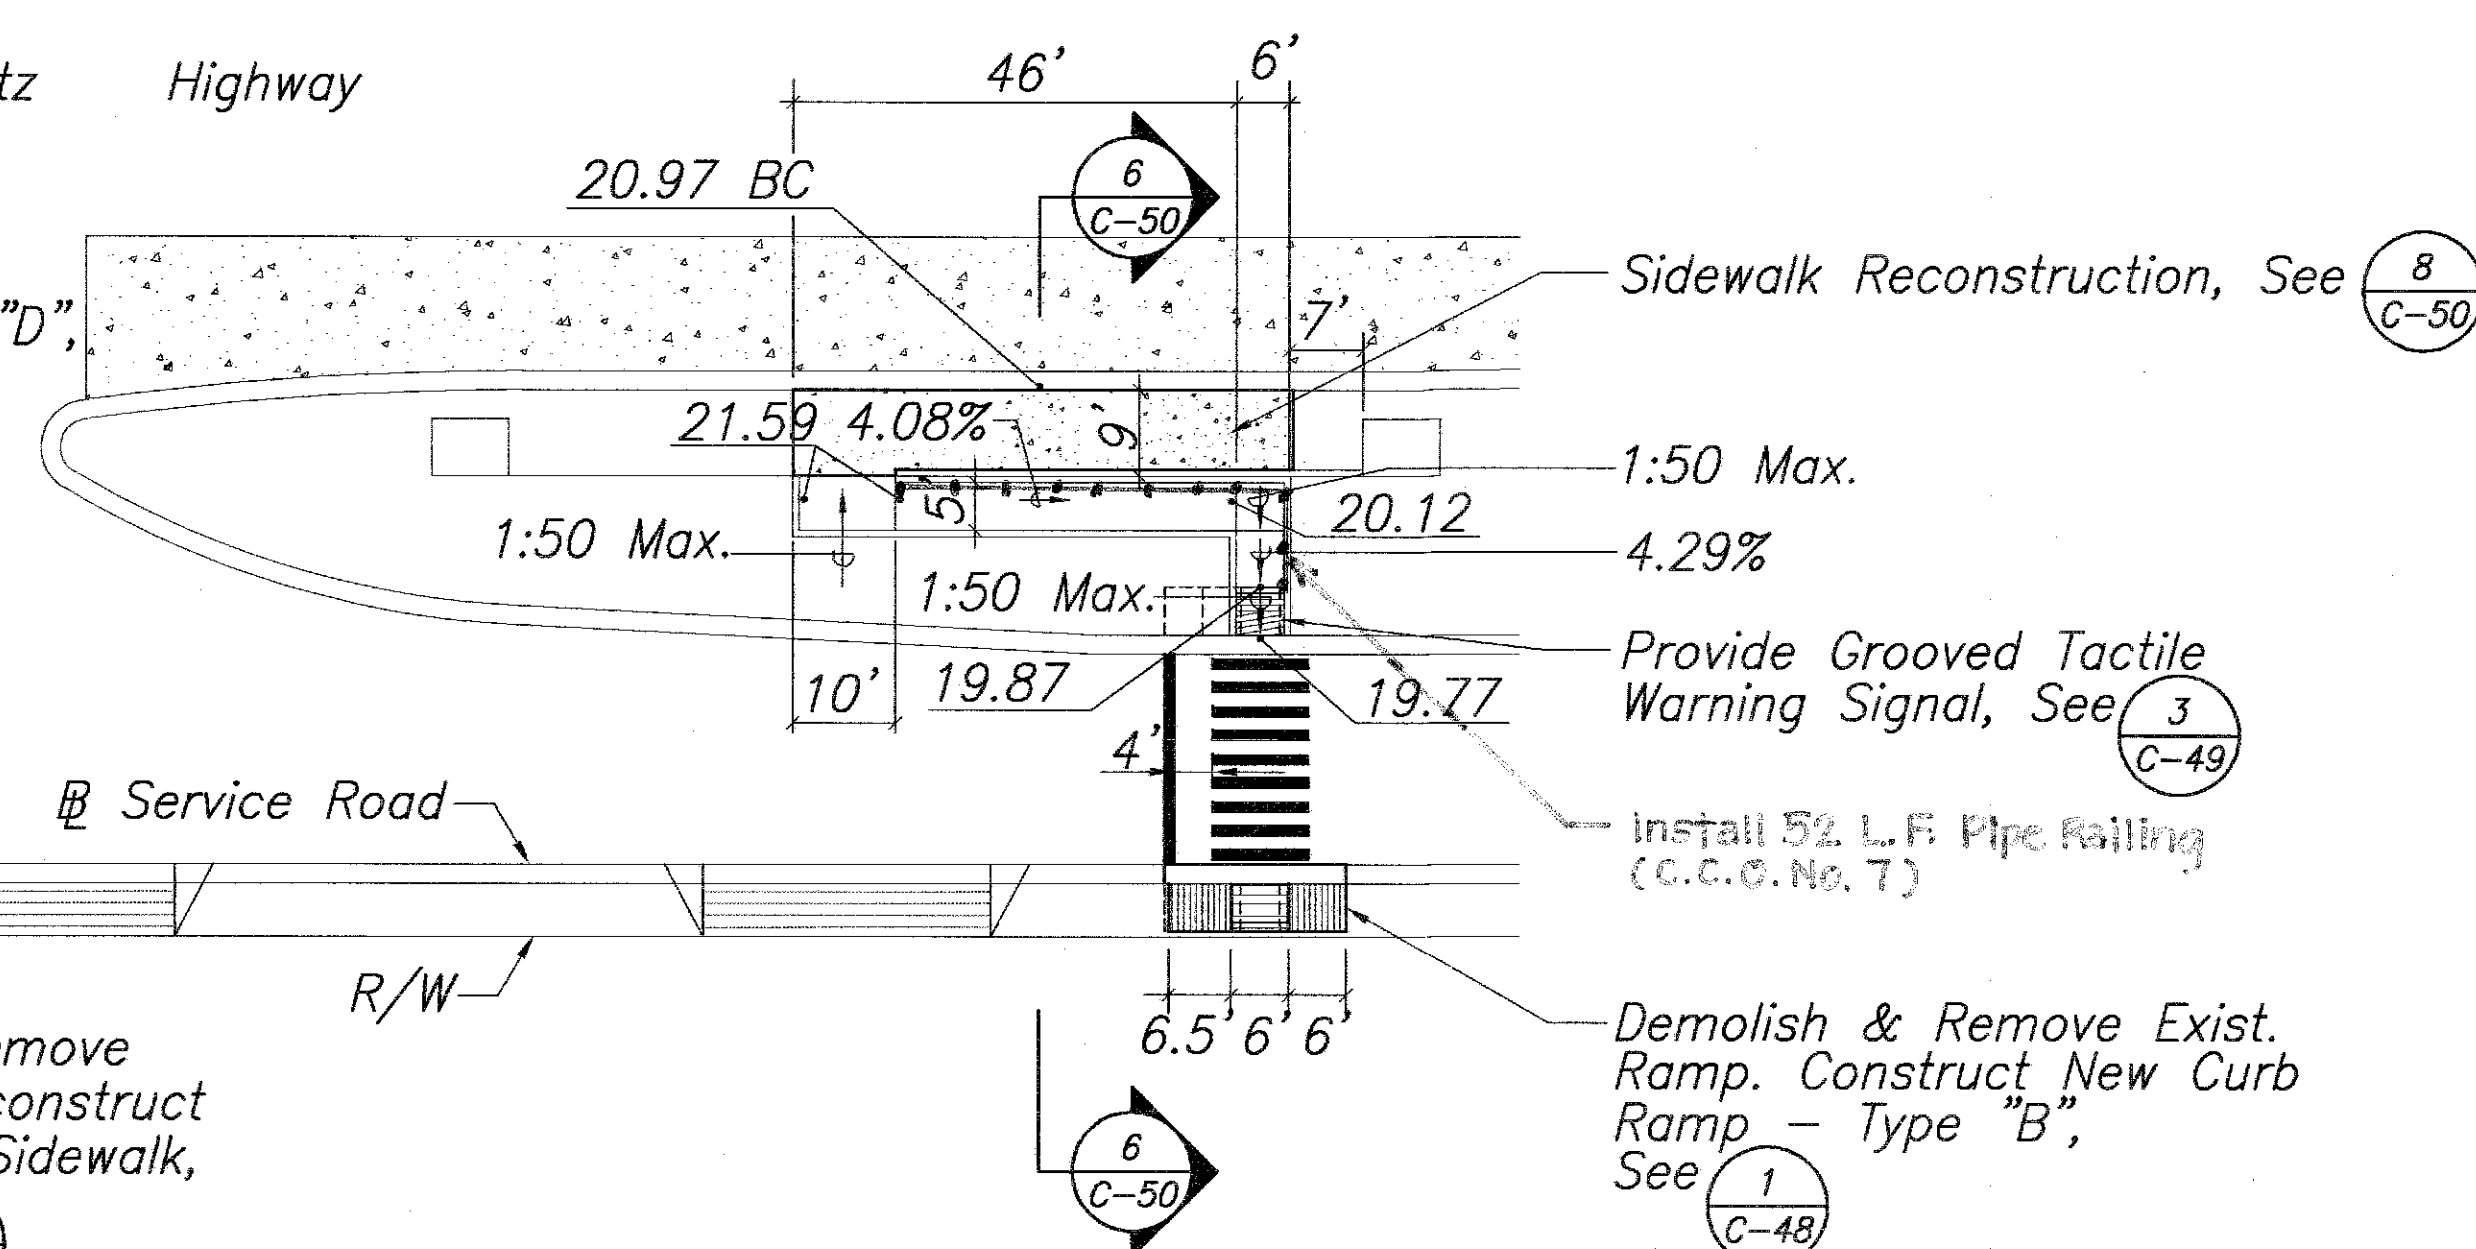

STATE OF HAWAII
DEPARTMENT OF TRANSPORTATION
HIGHWAYS DIVISION

**INTERSECTION PLAN
OHOHIA STREET**


NIMITZ HIGHWAY RESURFACING
RODGERS BOULEVARD TO AHUA STREET
FED. AID PROJECT NO. STP-092-1(24)

Scale: As Noted Date: Aug. 2, 1999



SHEET No. C-32 OF 57 SHEETS

AS-BUILT

FED. ROAD DIST. NO.	STATE	FED. AID PROJ. NO.	FISCAL YEAR	SHEET NO.	TOTAL SHEETS
HAWAII	HAW.	STP-092-1(24)	2000	34	57

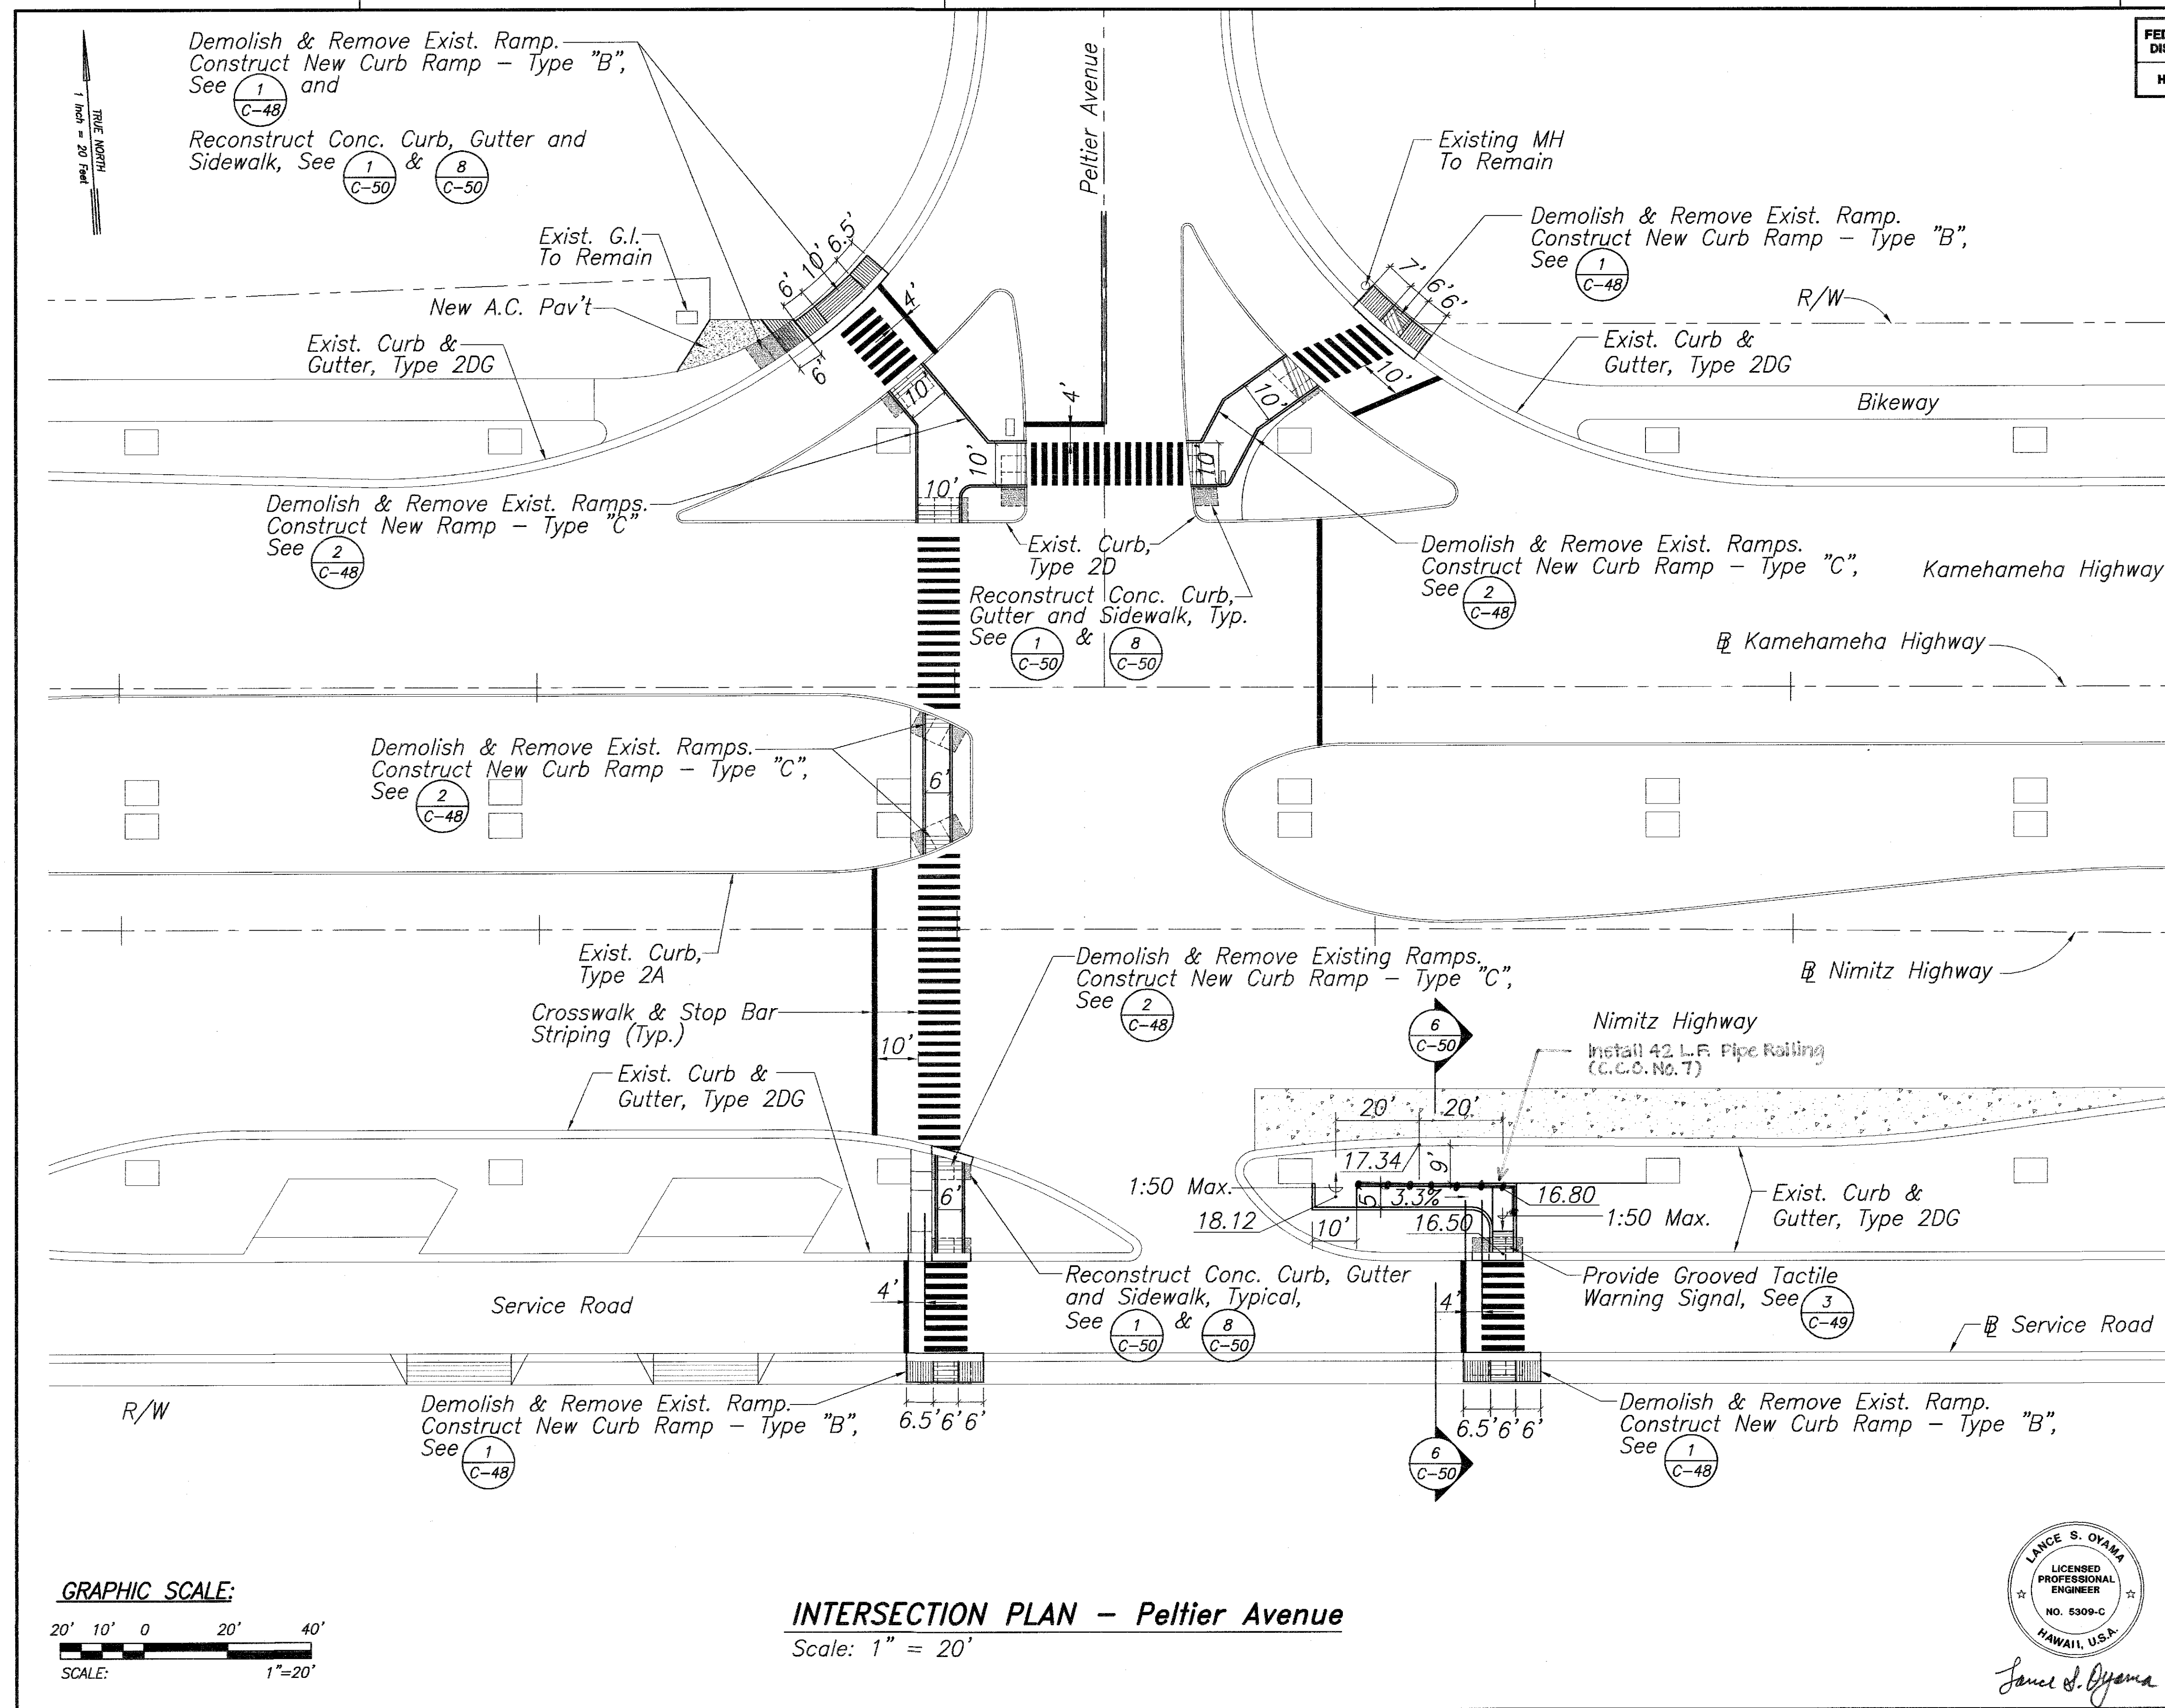

FED. ROAD DIST. NO.	STATE	FED. AID PROJ. NO.	FISCAL YEAR	SHEET NO.	TOTAL SHEETS
HAWAII	HAW.	STP-092-1(24)	2000	35	57

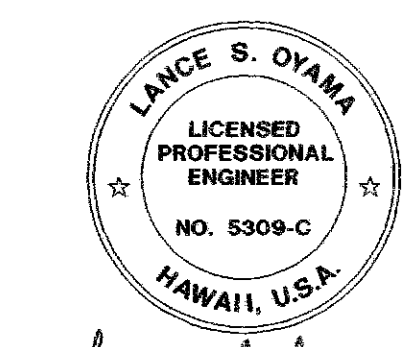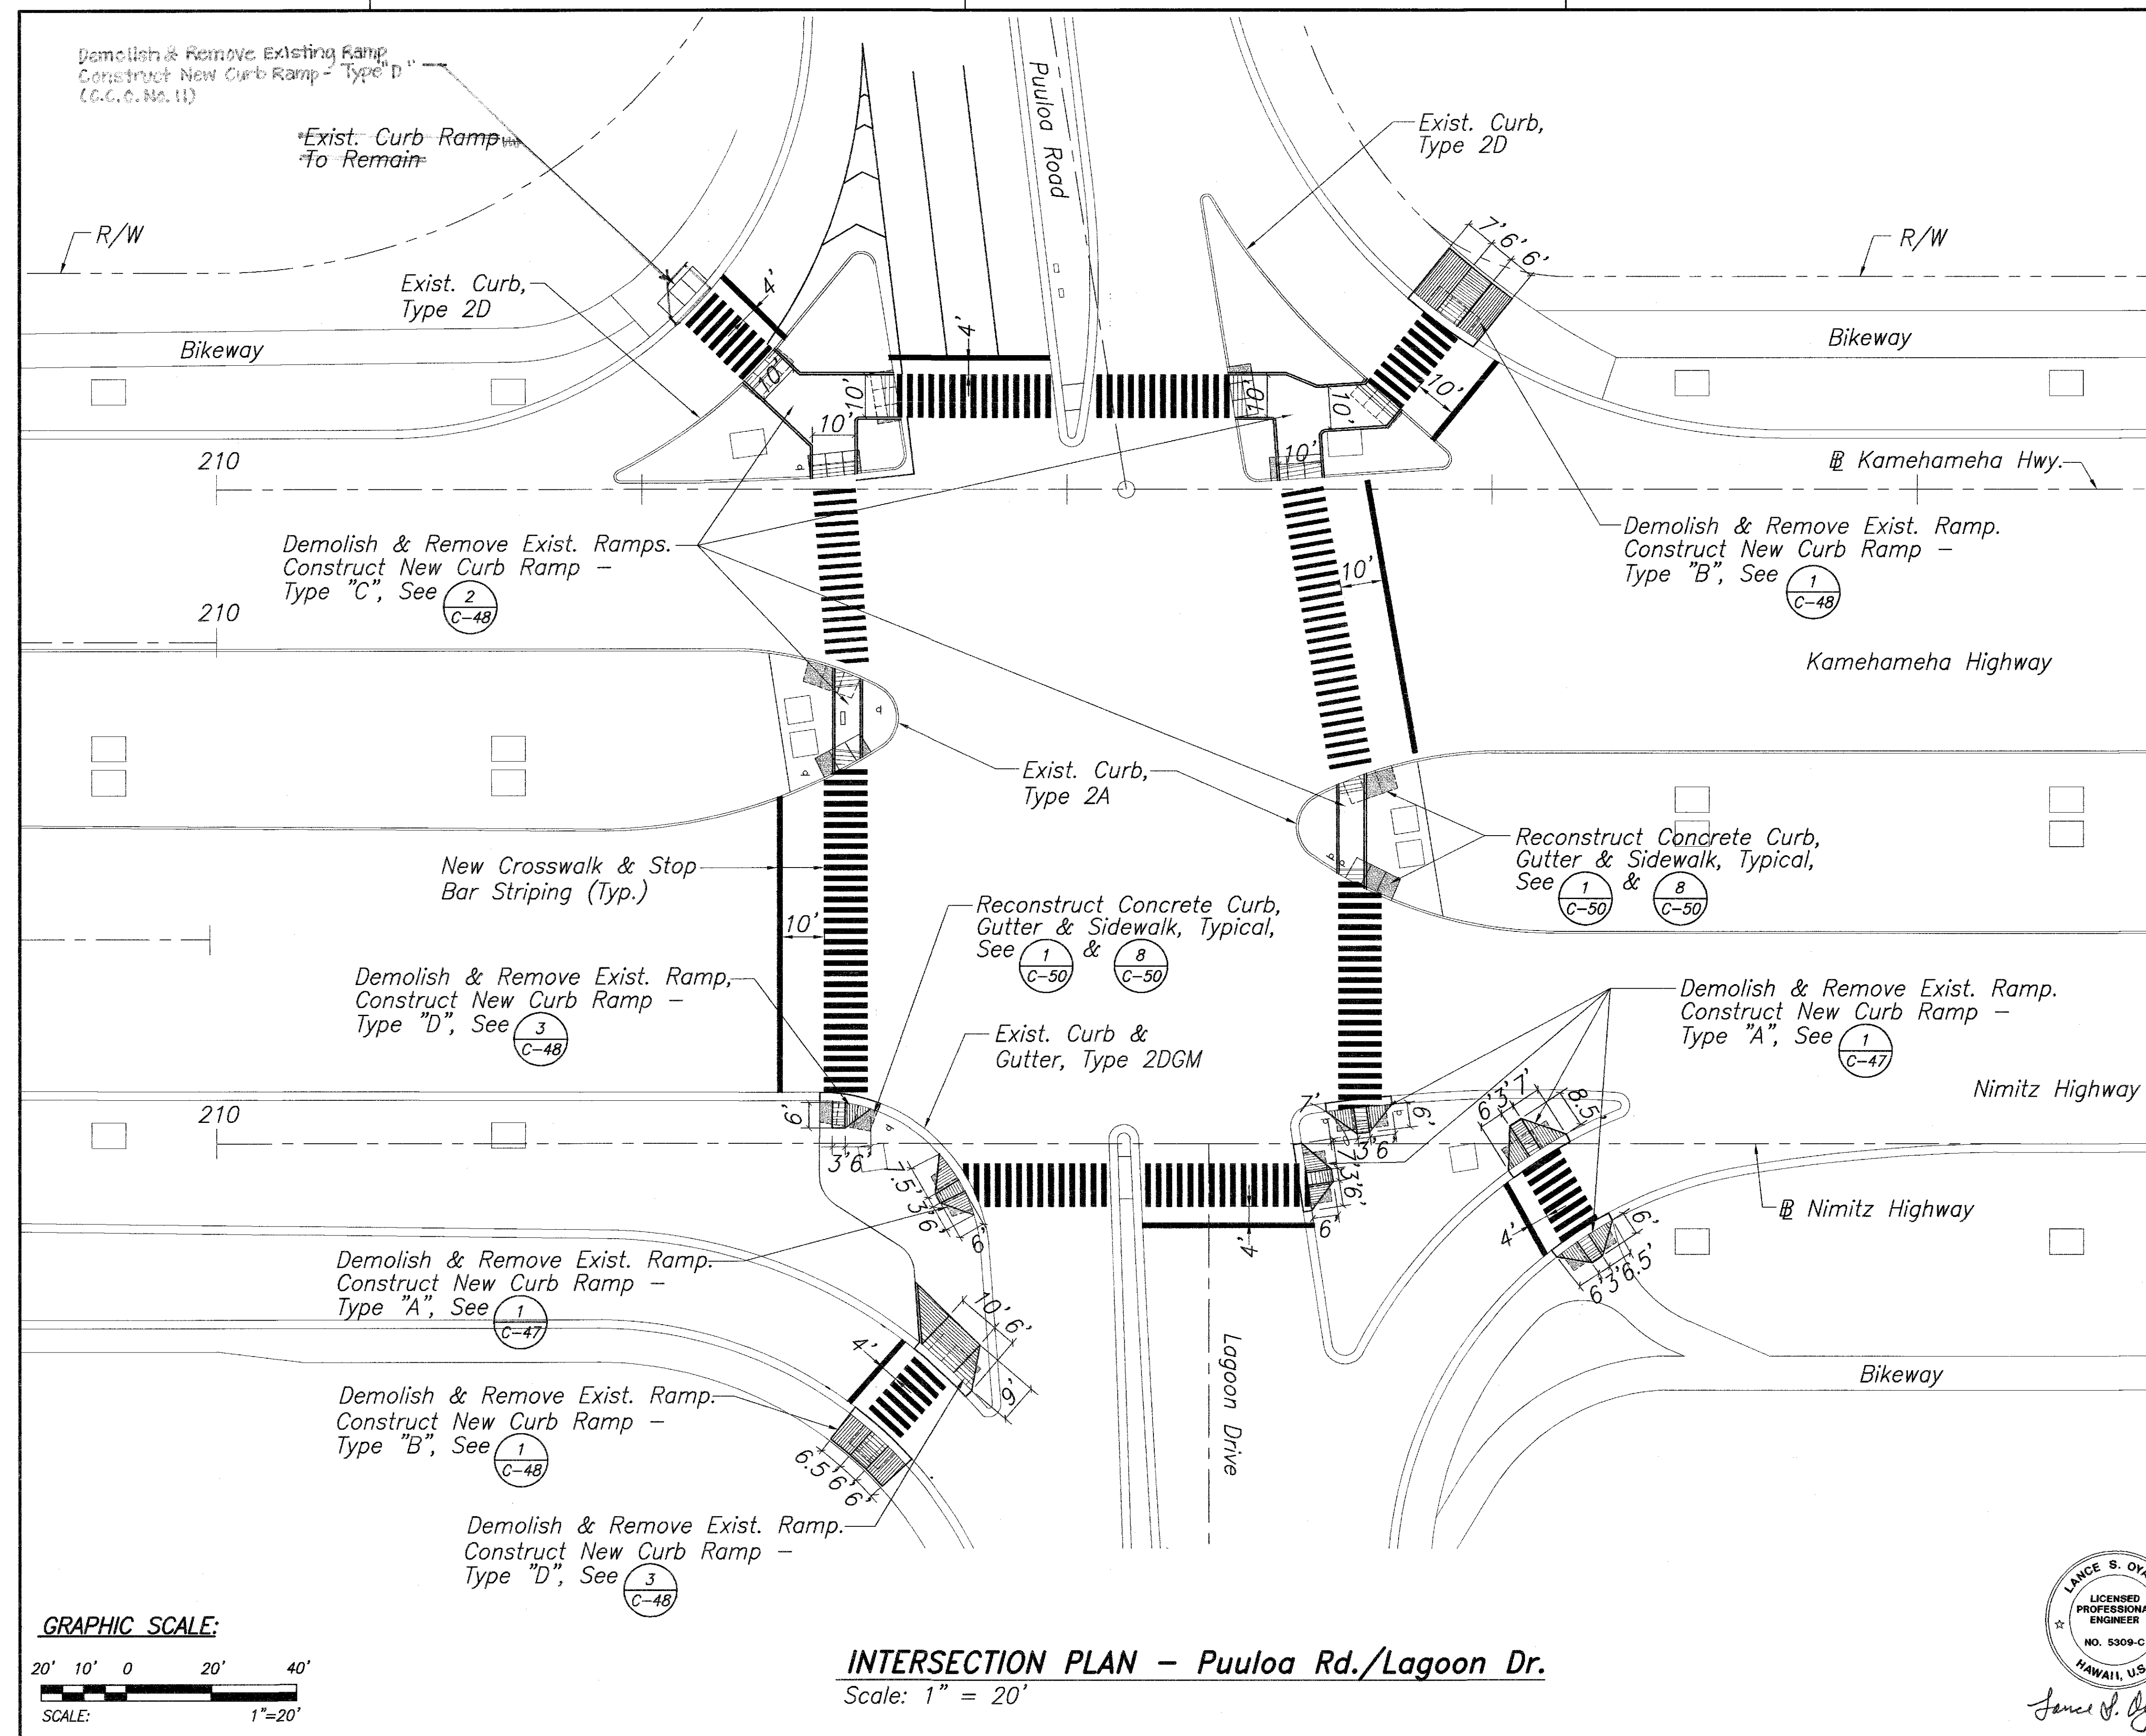

STATE OF HAWAII
DEPARTMENT OF TRANSPORTATION
HIGHWAYS DIVISION

**INTERSECTION PLAN
PUULOA ROAD/LAGOON DRIVE**

NIMITZ HIGHWAY RESURFACING
RODGERS BOULEVARD TO AHUA STREET
FED. AID PROJECT NO. STP-092-1(24)

Scale: As Noted Date: Aug. 2, 1999

SHEET No. C-34 OF 57 SHEETS

AS-BUILT

