



FED. ROAD DIST. NO.	STATE	FED. AID PROJ. NO.	FISCAL YEAR	SHEET NO.	TOTAL SHEETS
HAWAII	HAW.	STP-092-1(24)	2000	5	57

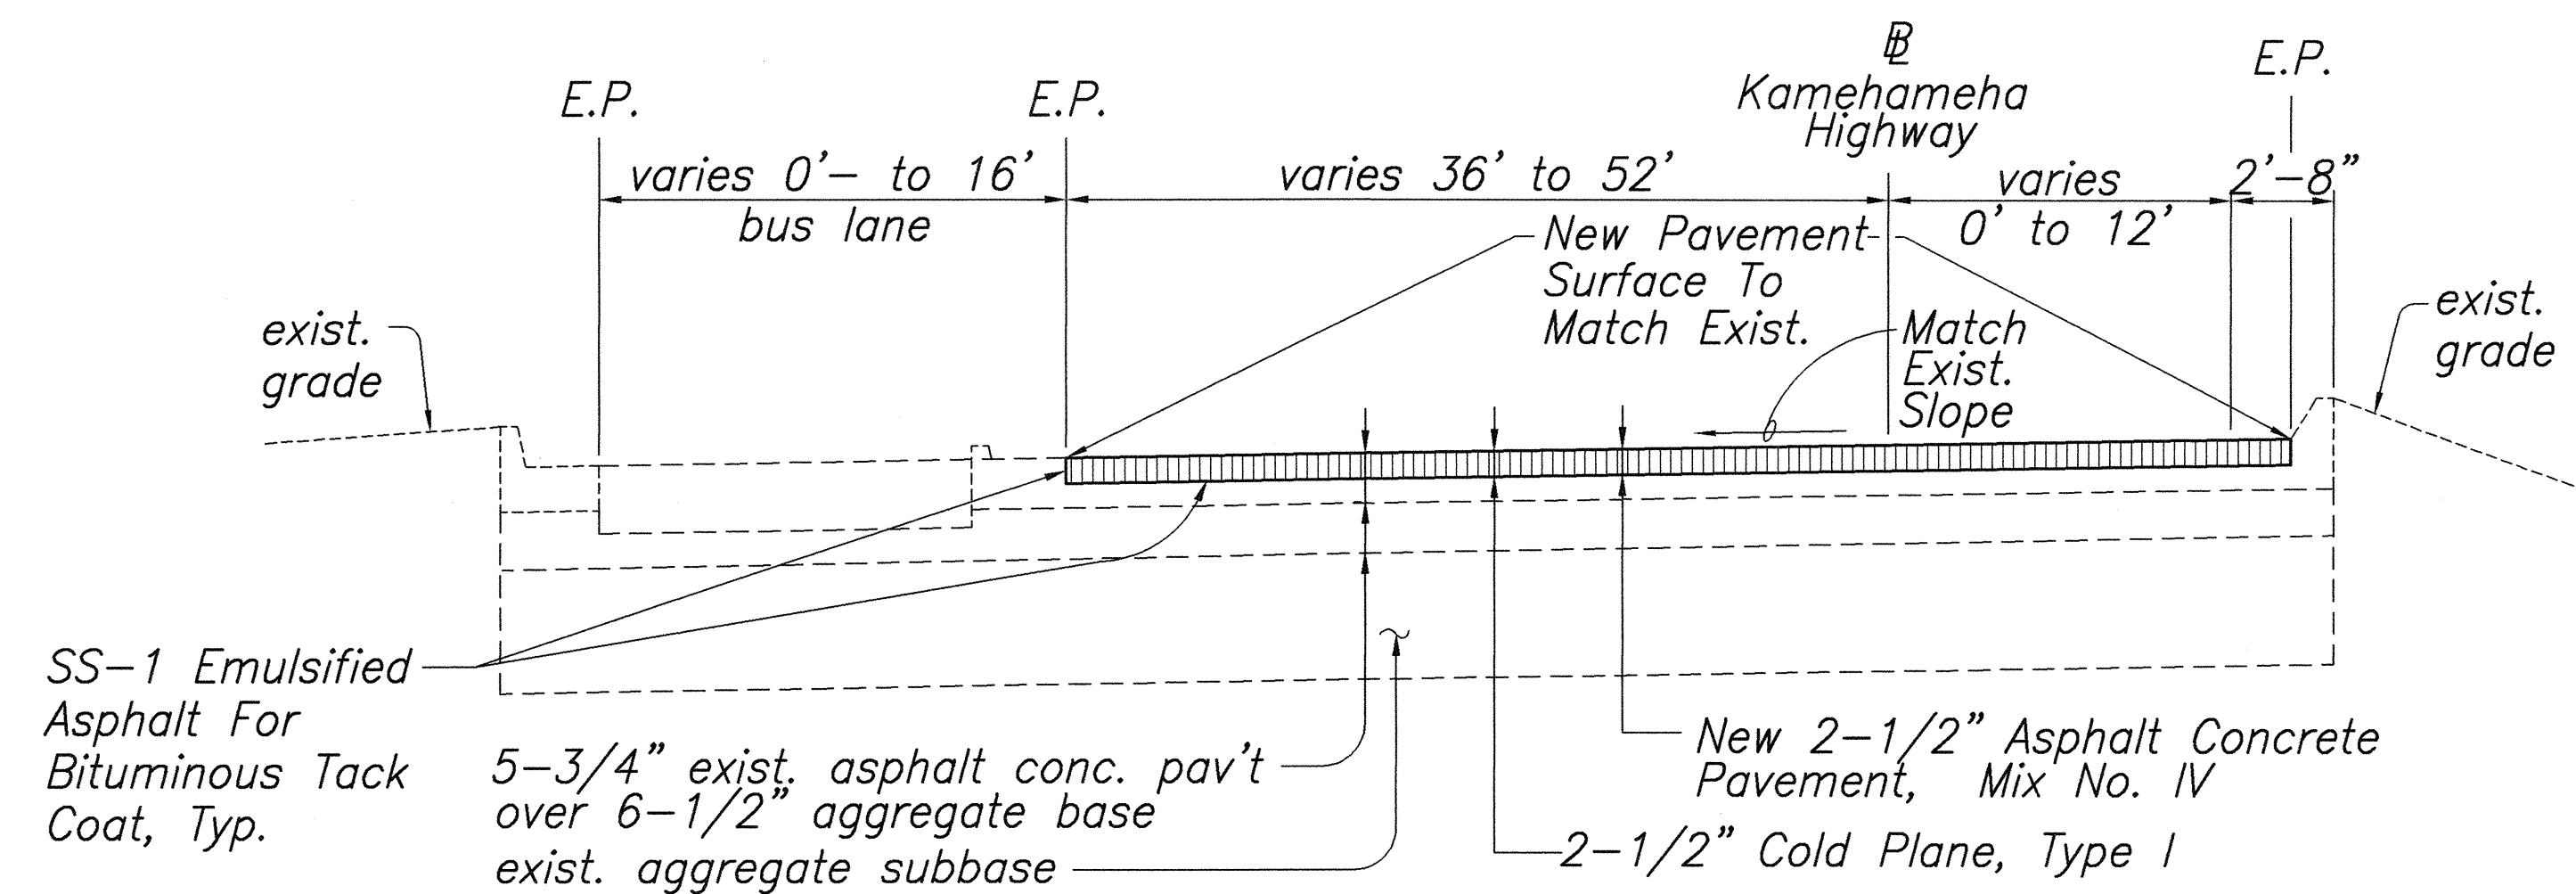

KAMEHAMEHA HIGHWAY

NOT TO SCALE


Ⓢ KAMEHAMEHA HIGHWAY STATION LIMITS
159+00 TO 210+00

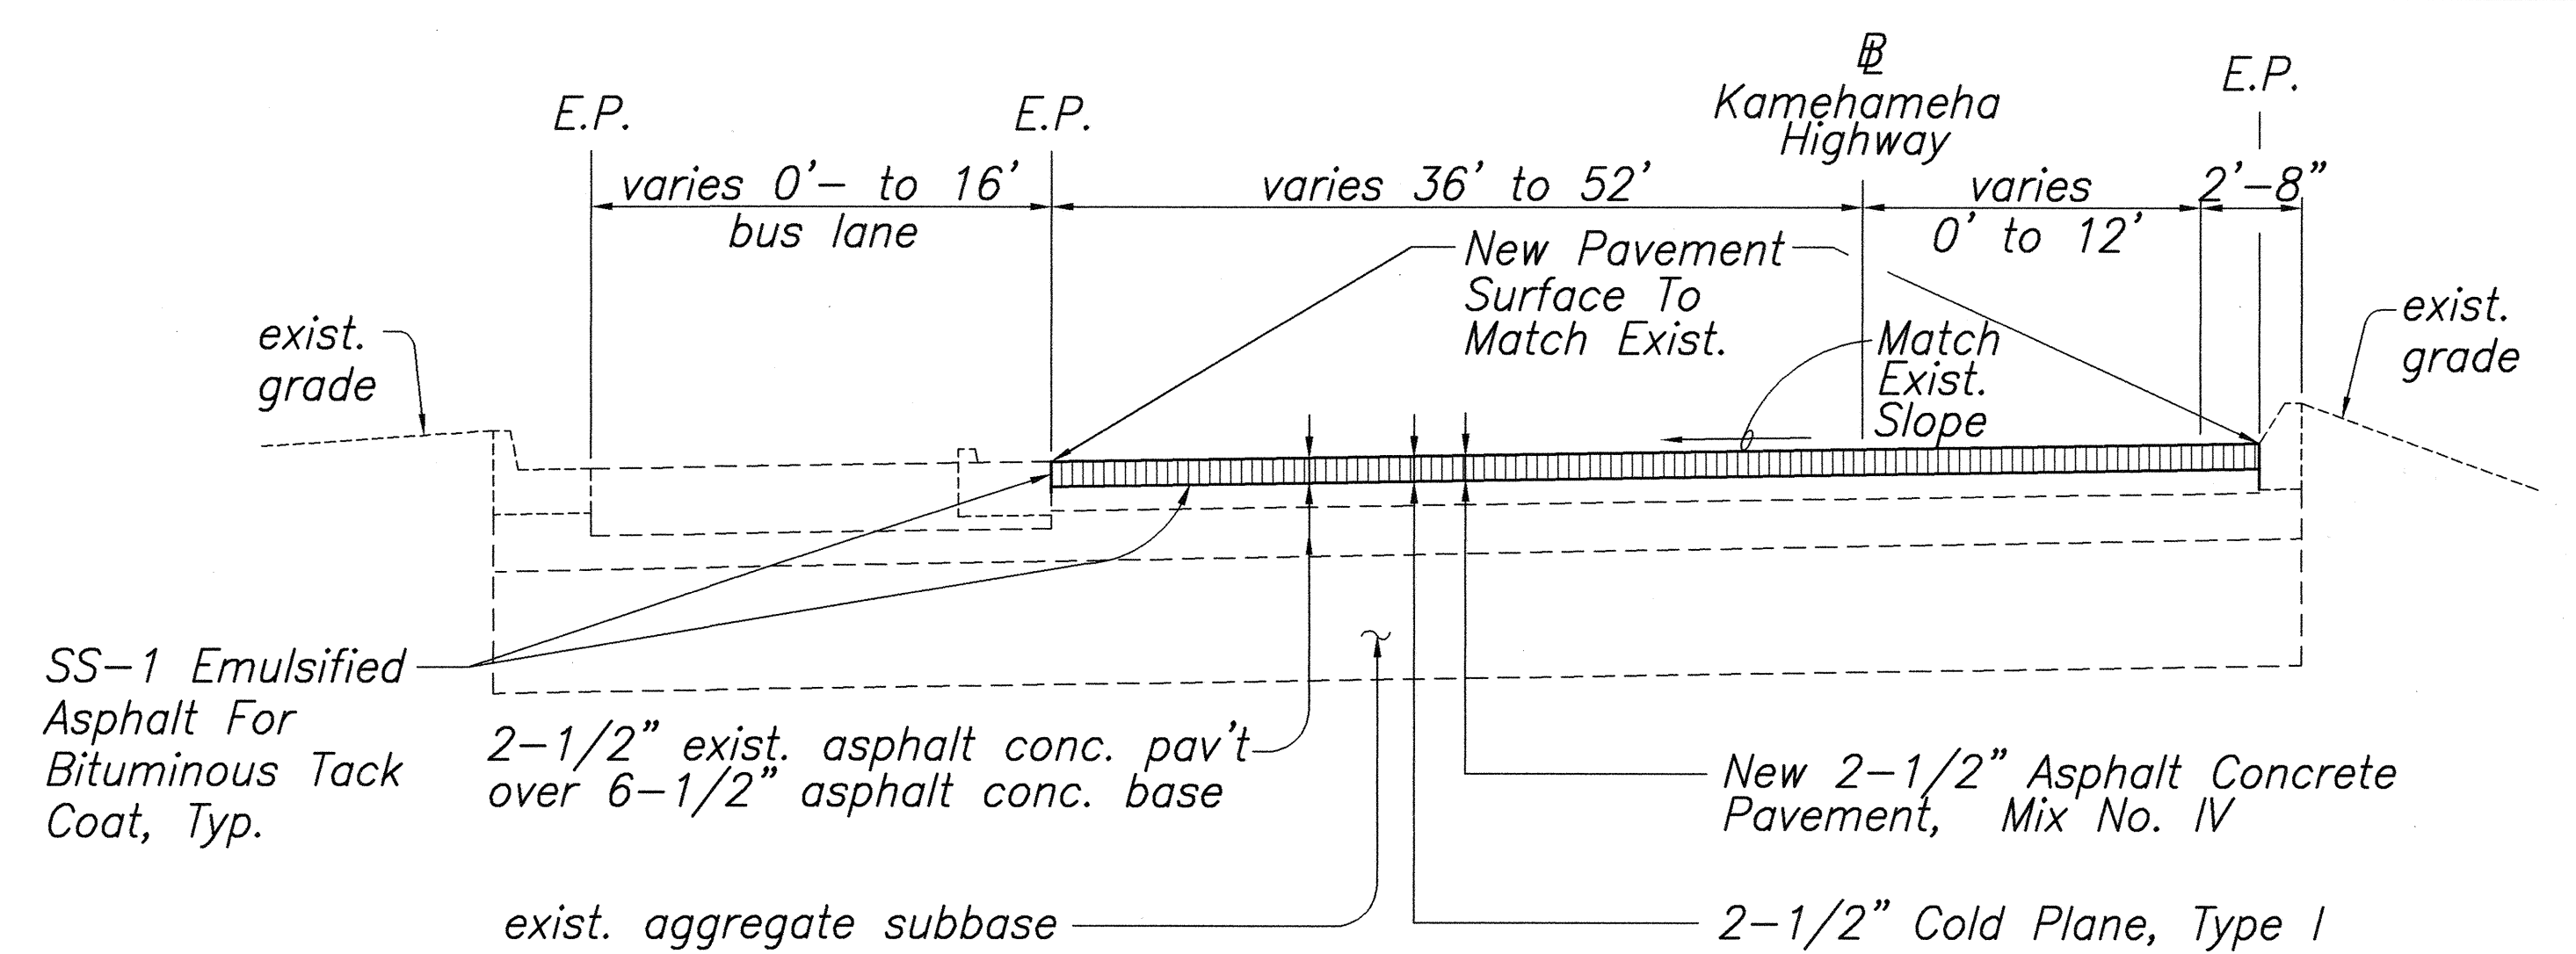

KAMEHAMEHA HIGHWAY

NOT TO SCALE


Ⓢ KAMEHAMEHA HIGHWAY STATION LIMITS
210+00 TO 221+60

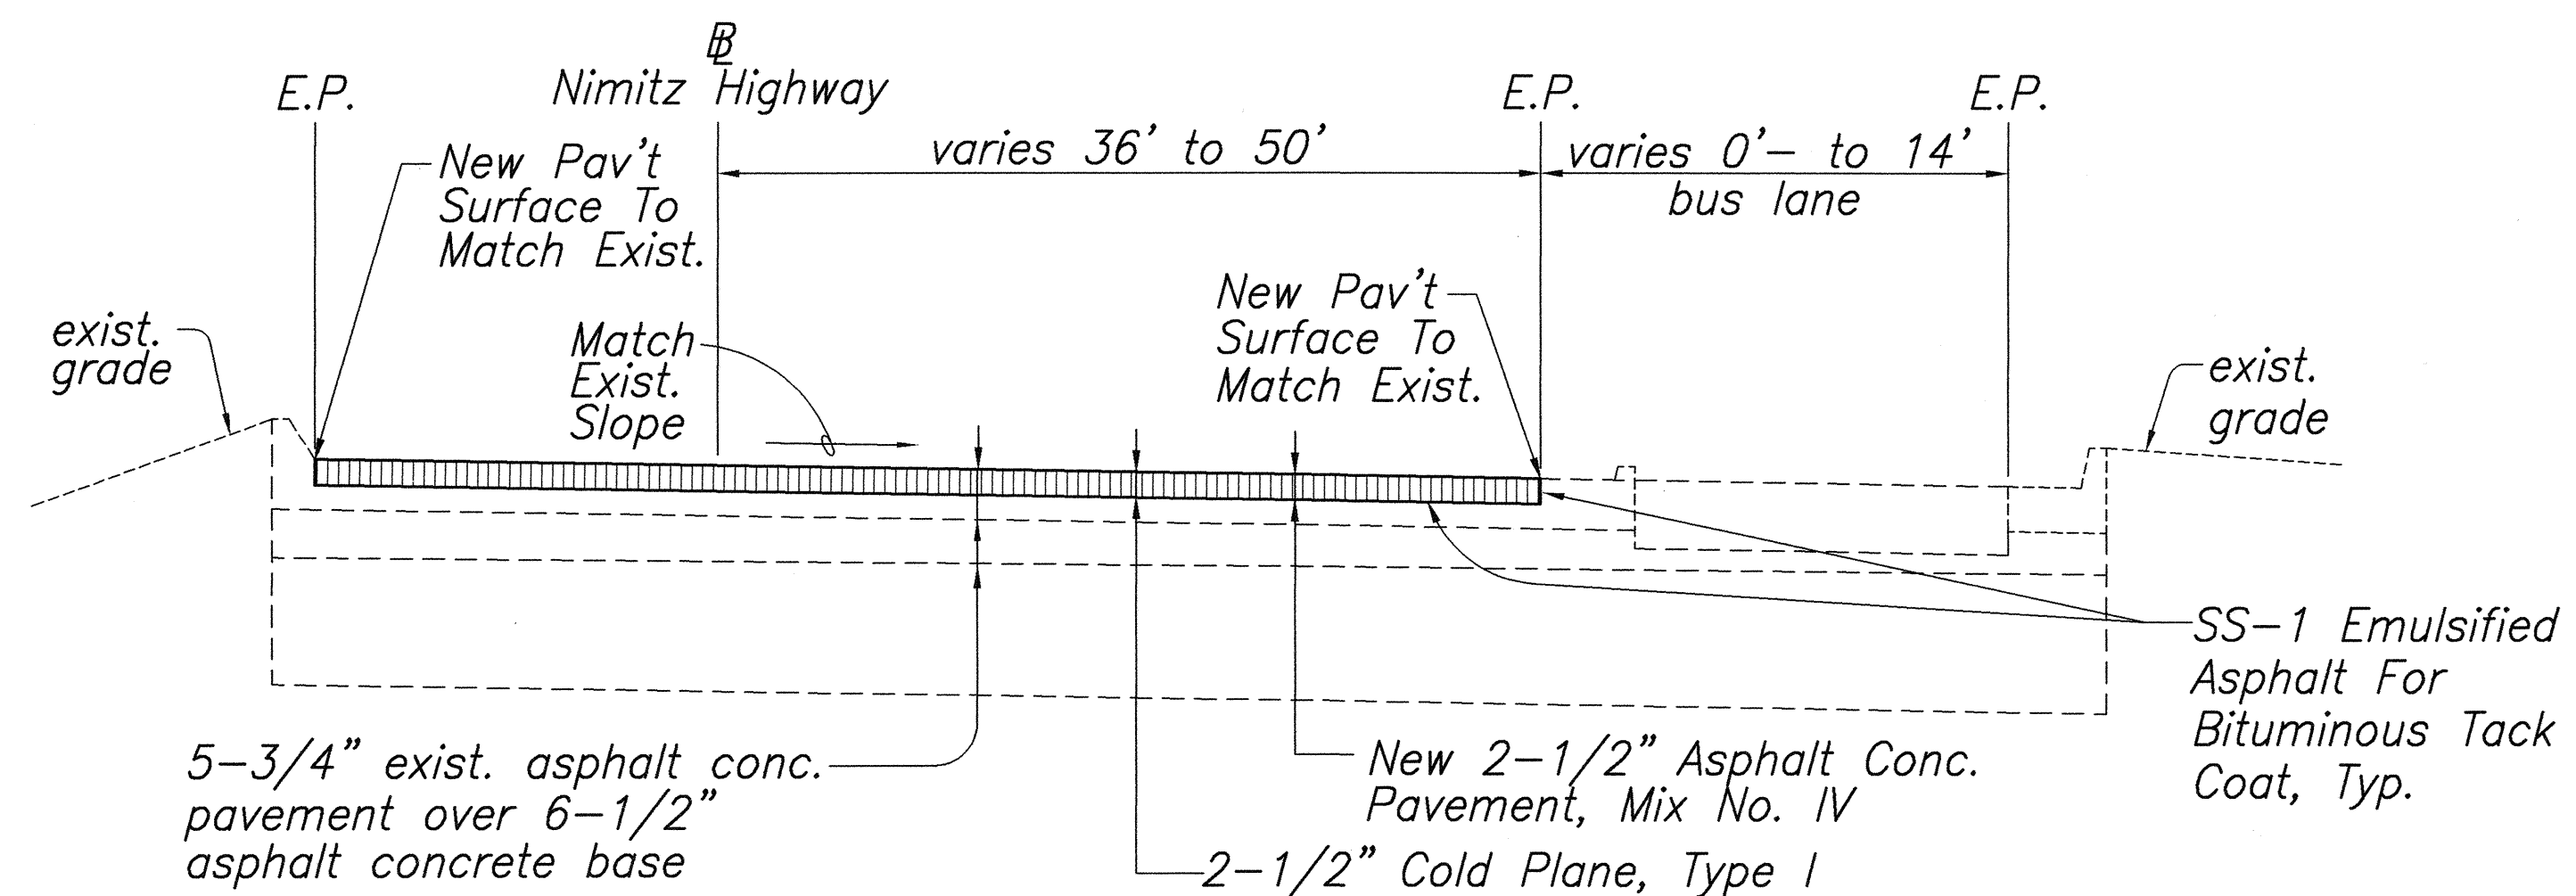

NIMITZ HIGHWAY

NOT TO SCALE

Ⓢ NIMITZ HIGHWAY STATION LIMITS
159+00 TO 211+71

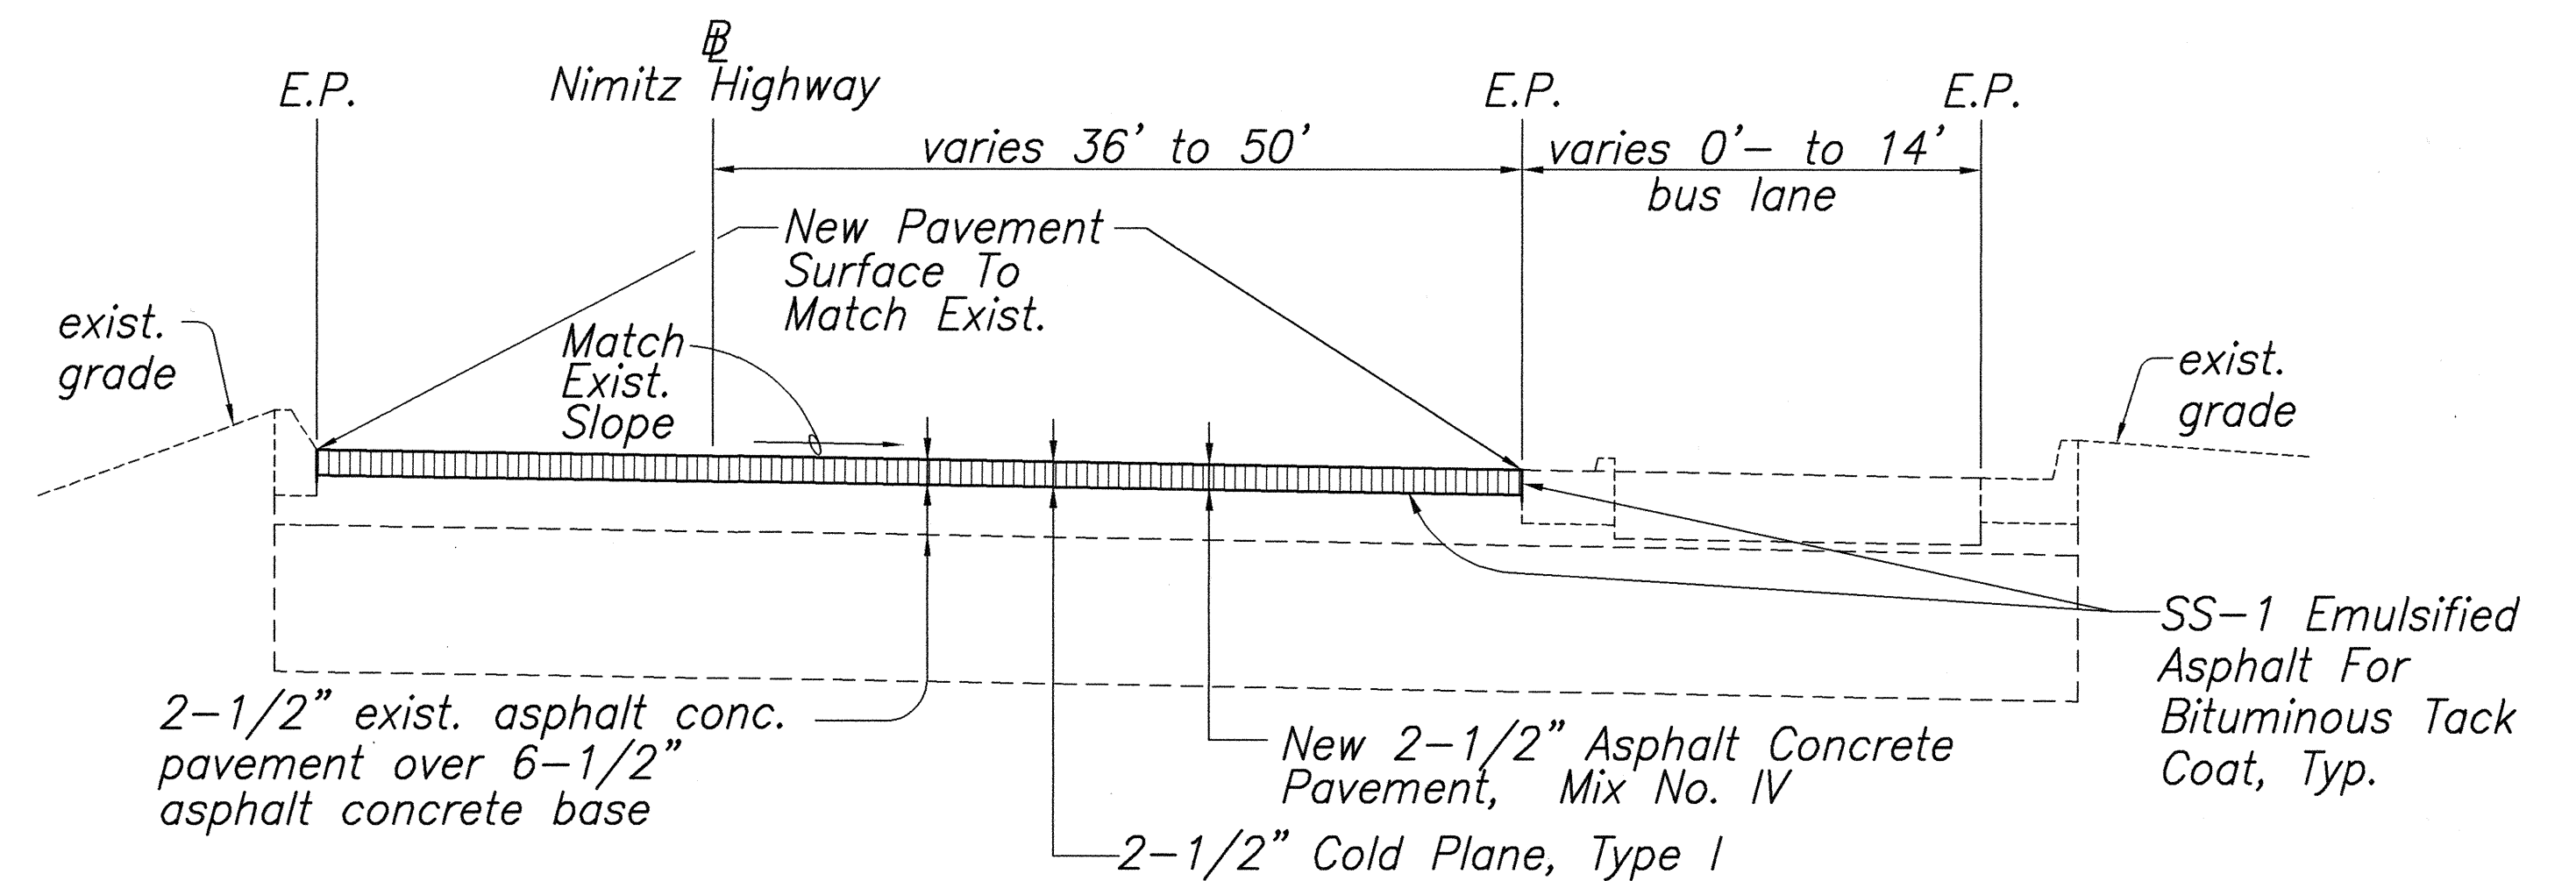

NIMITZ HIGHWAY

NOT TO SCALE







Ⓢ NIMITZ HIGHWAY STATION LIMITS
211+71 TO 223+50



Lance S. Oyama

STATE OF HAWAII DEPARTMENT OF TRANSPORTATION HIGHWAYS DIVISION	
TYPICAL PAVEMENT SECTIONS NIMITZ HIGHWAY RESURFACING RODGERS BOULEVARD TO AHUA STREET FED. AID PROJECT NO. STP-092-1(24)	
Scale: As Noted	Date: Aug. 2, 1999
SHEET No. C-4 OF 57 SHEETS	

FED. ROAD DIST. NO.	STATE	FED. AID PROJ. NO.	FISCAL YEAR	SHEET NO.	TOTAL SHEETS
HAWAII	HAW.	STP-092-1(24)	2000	6	57

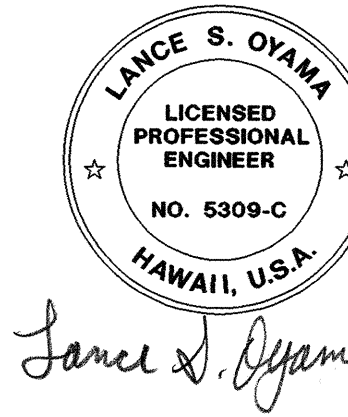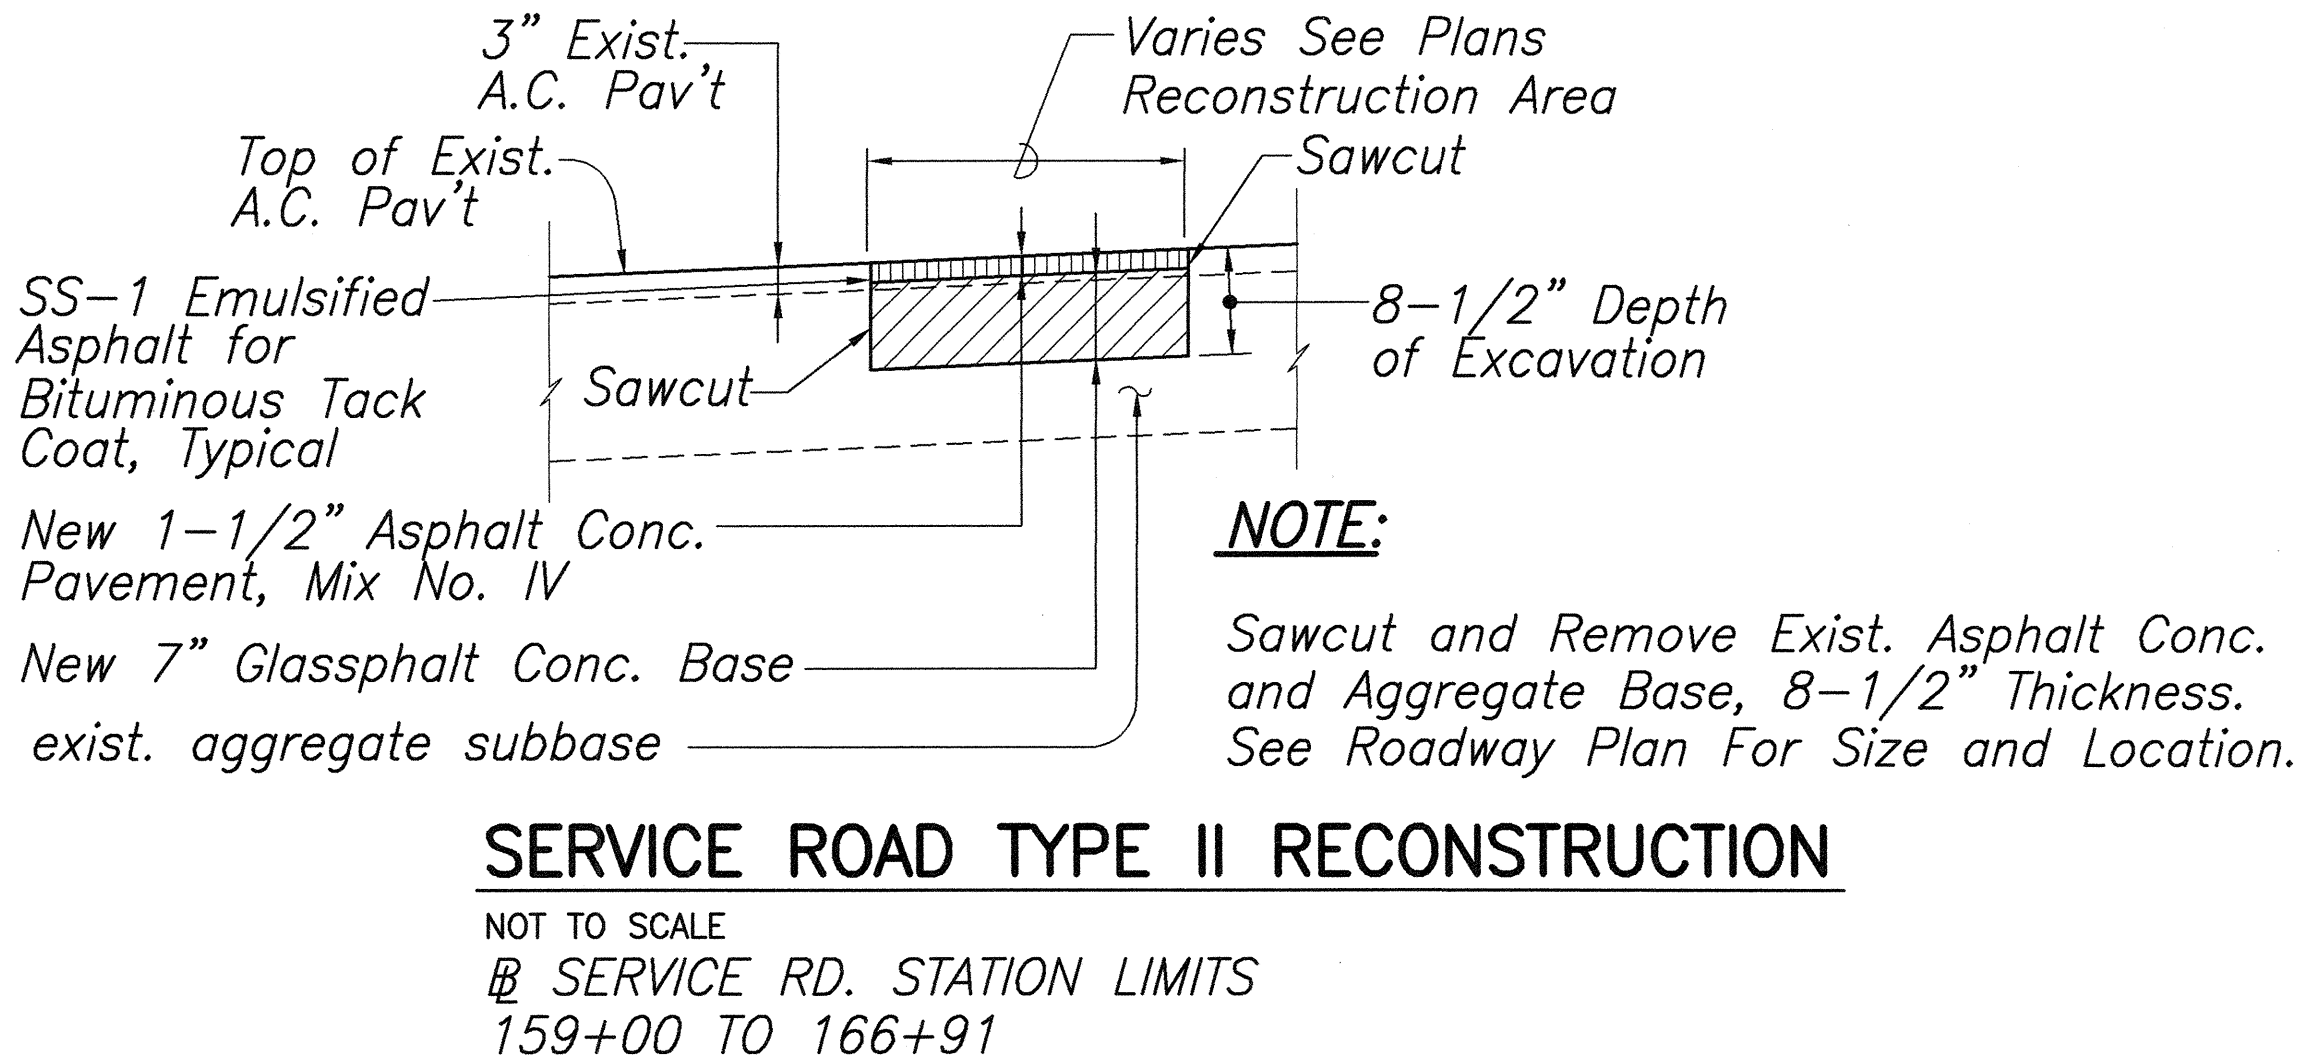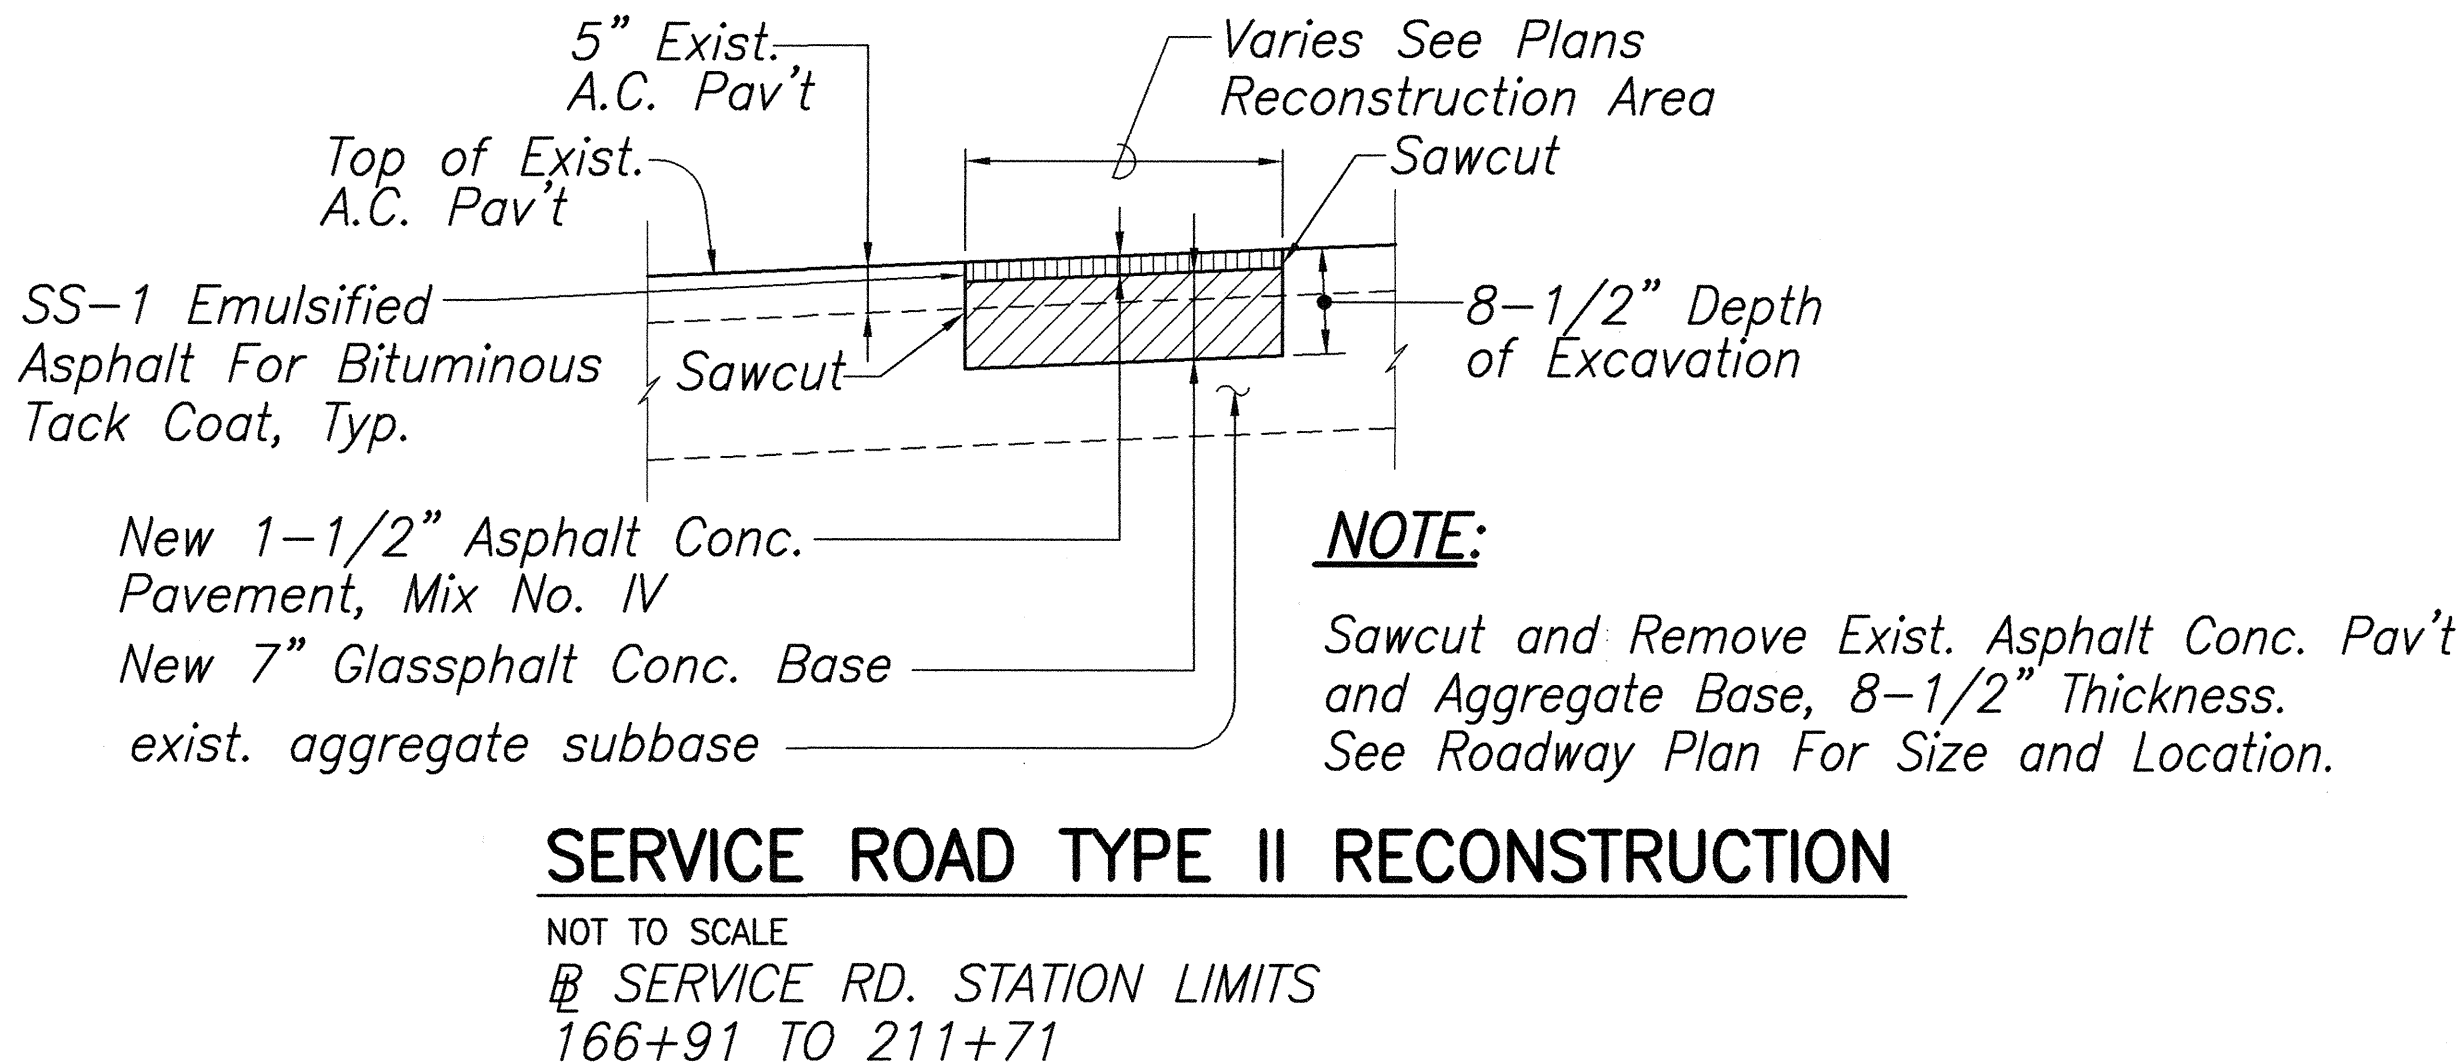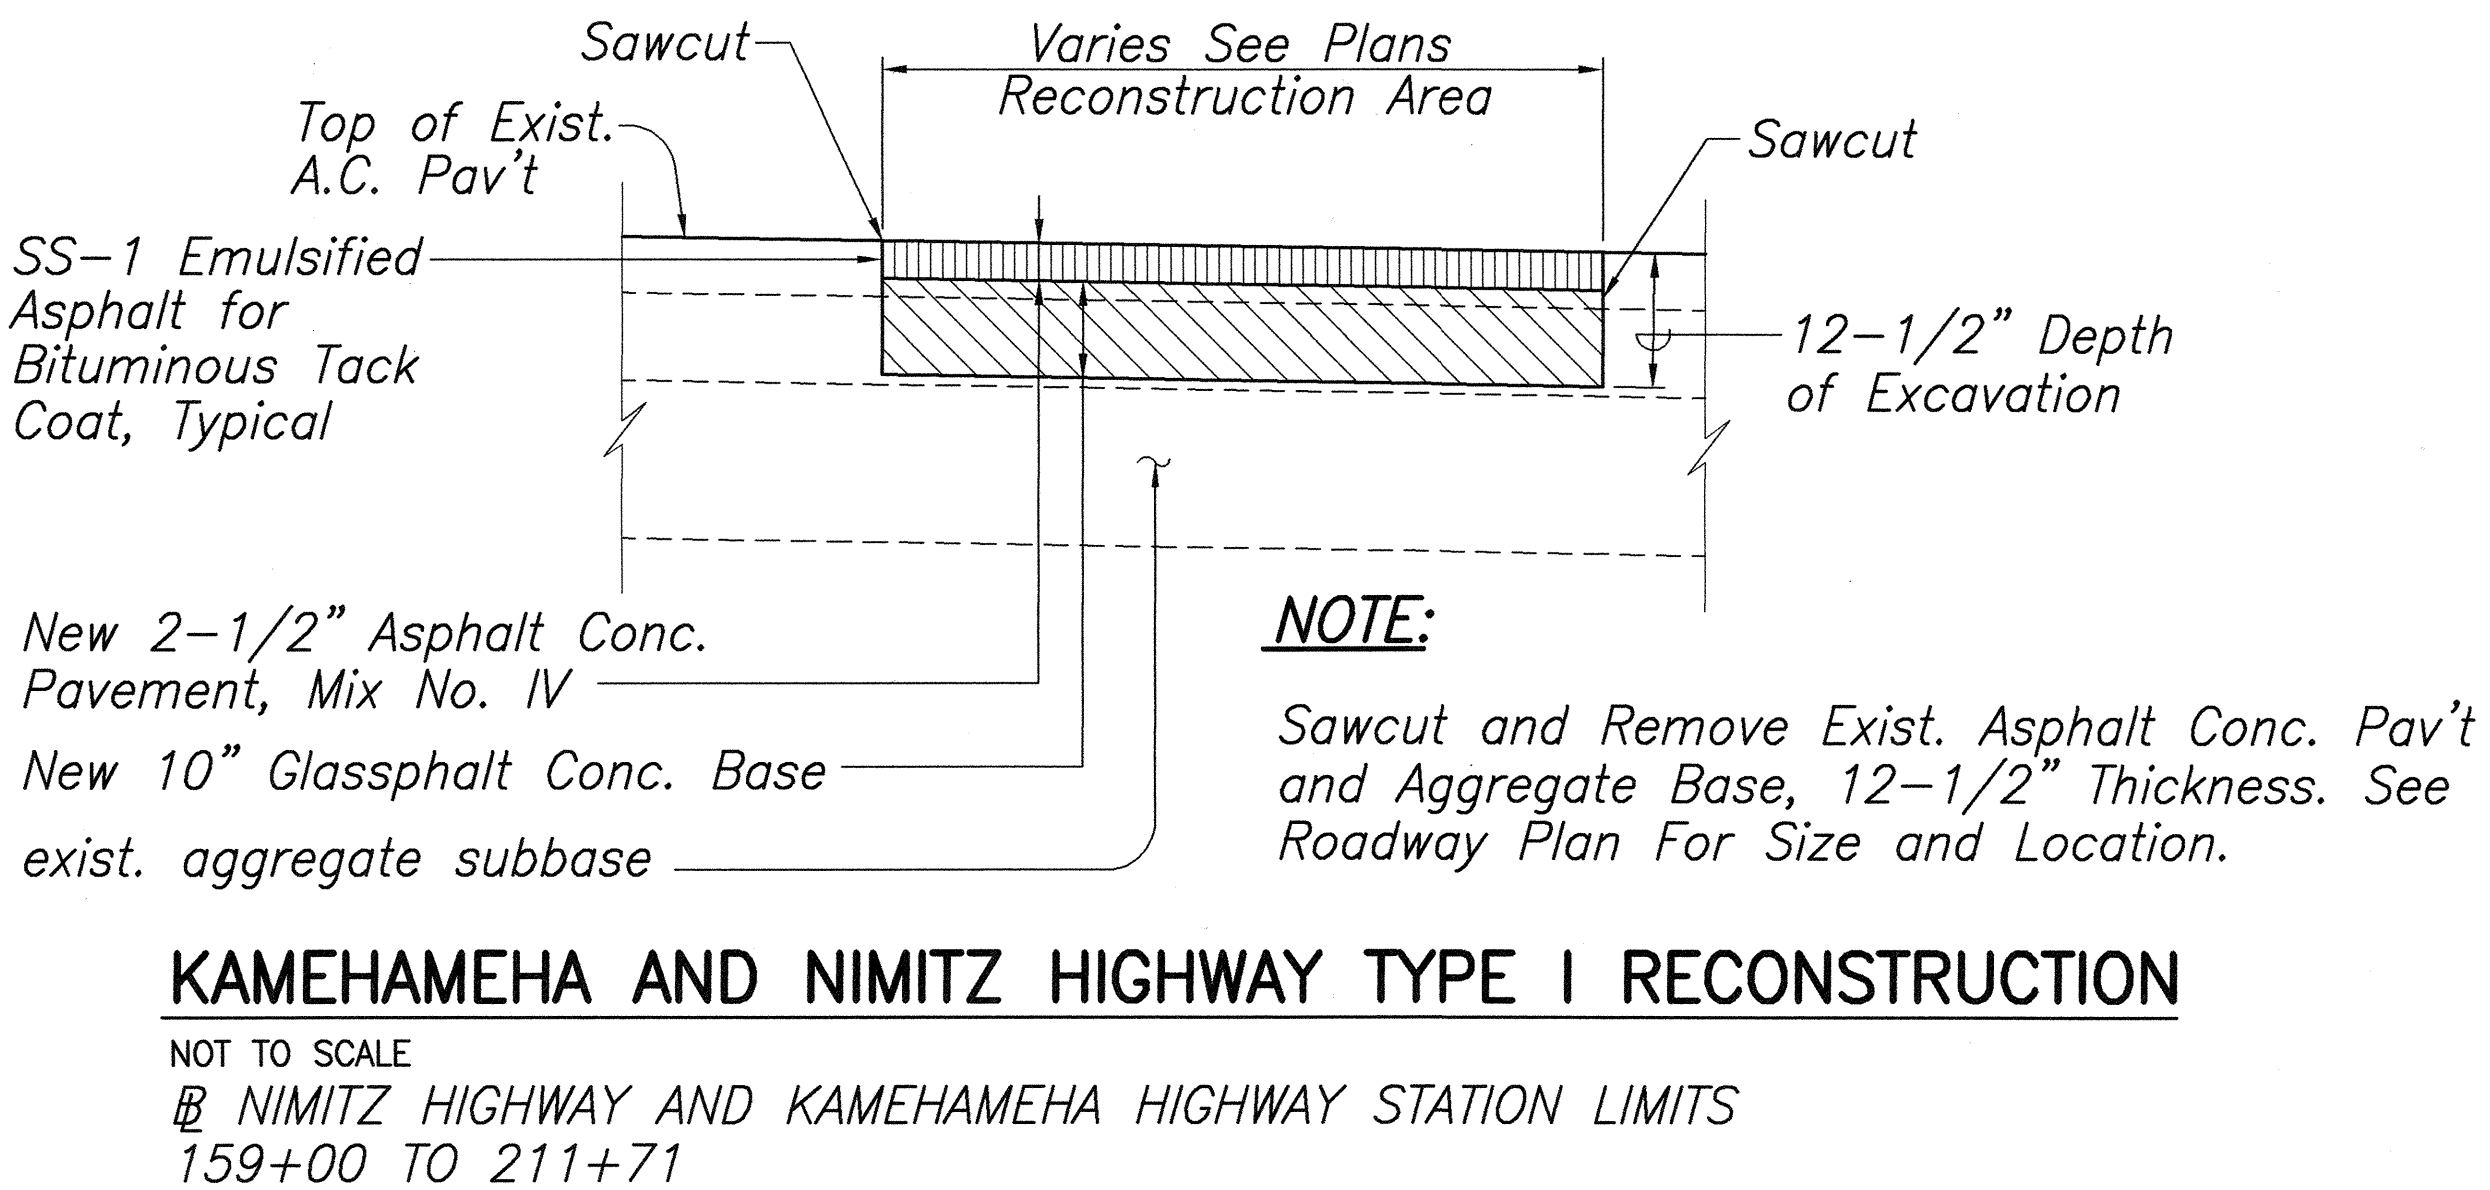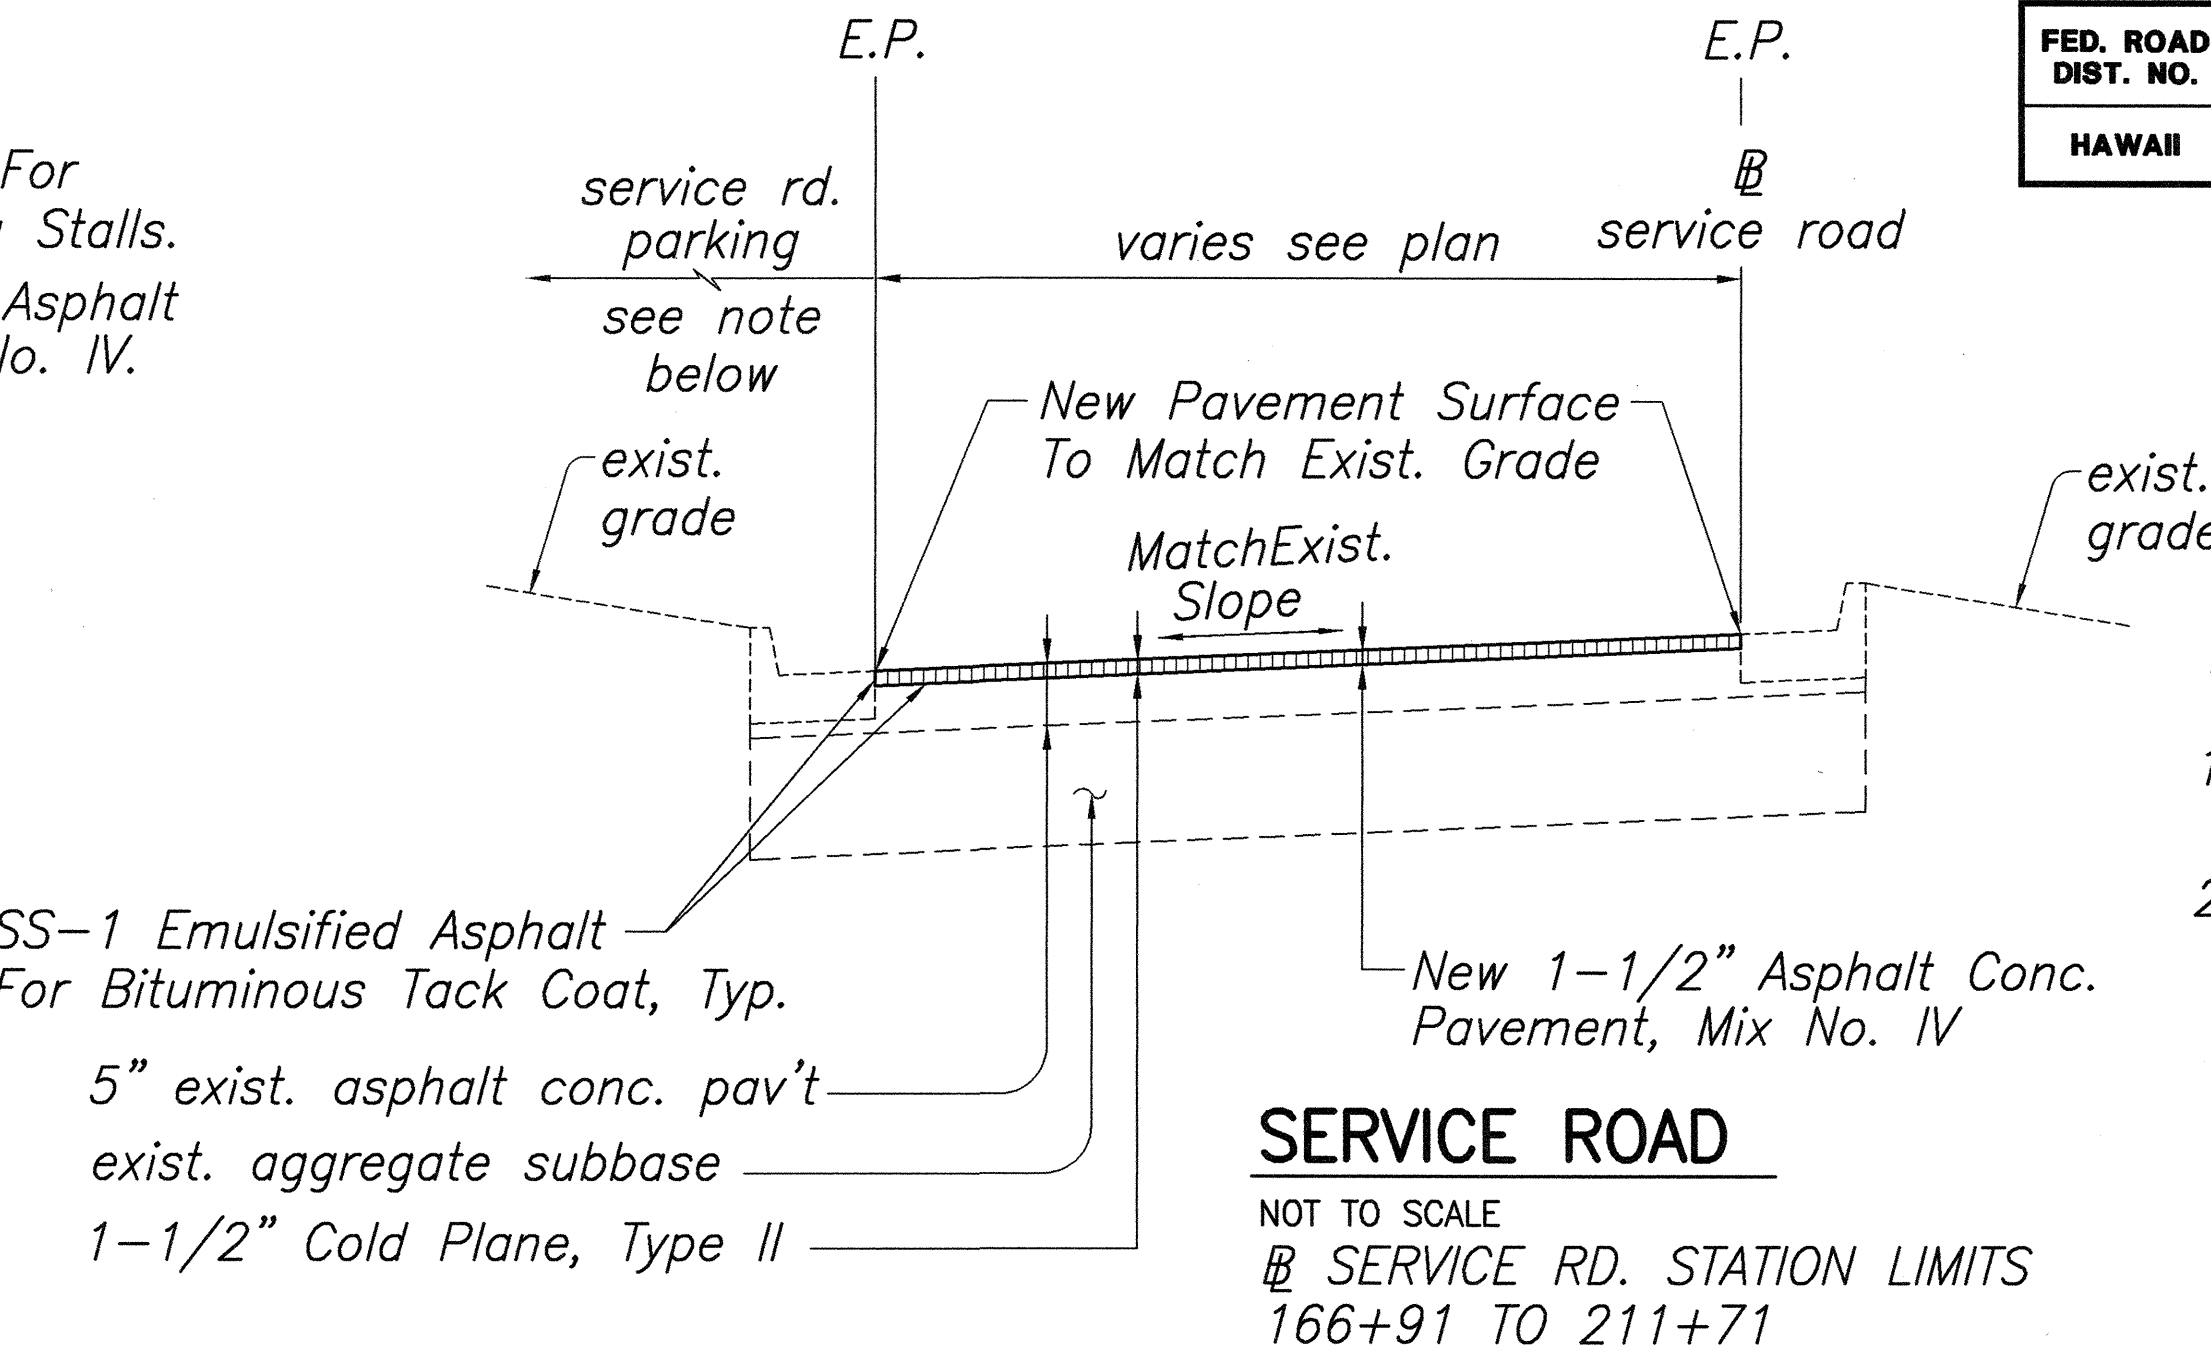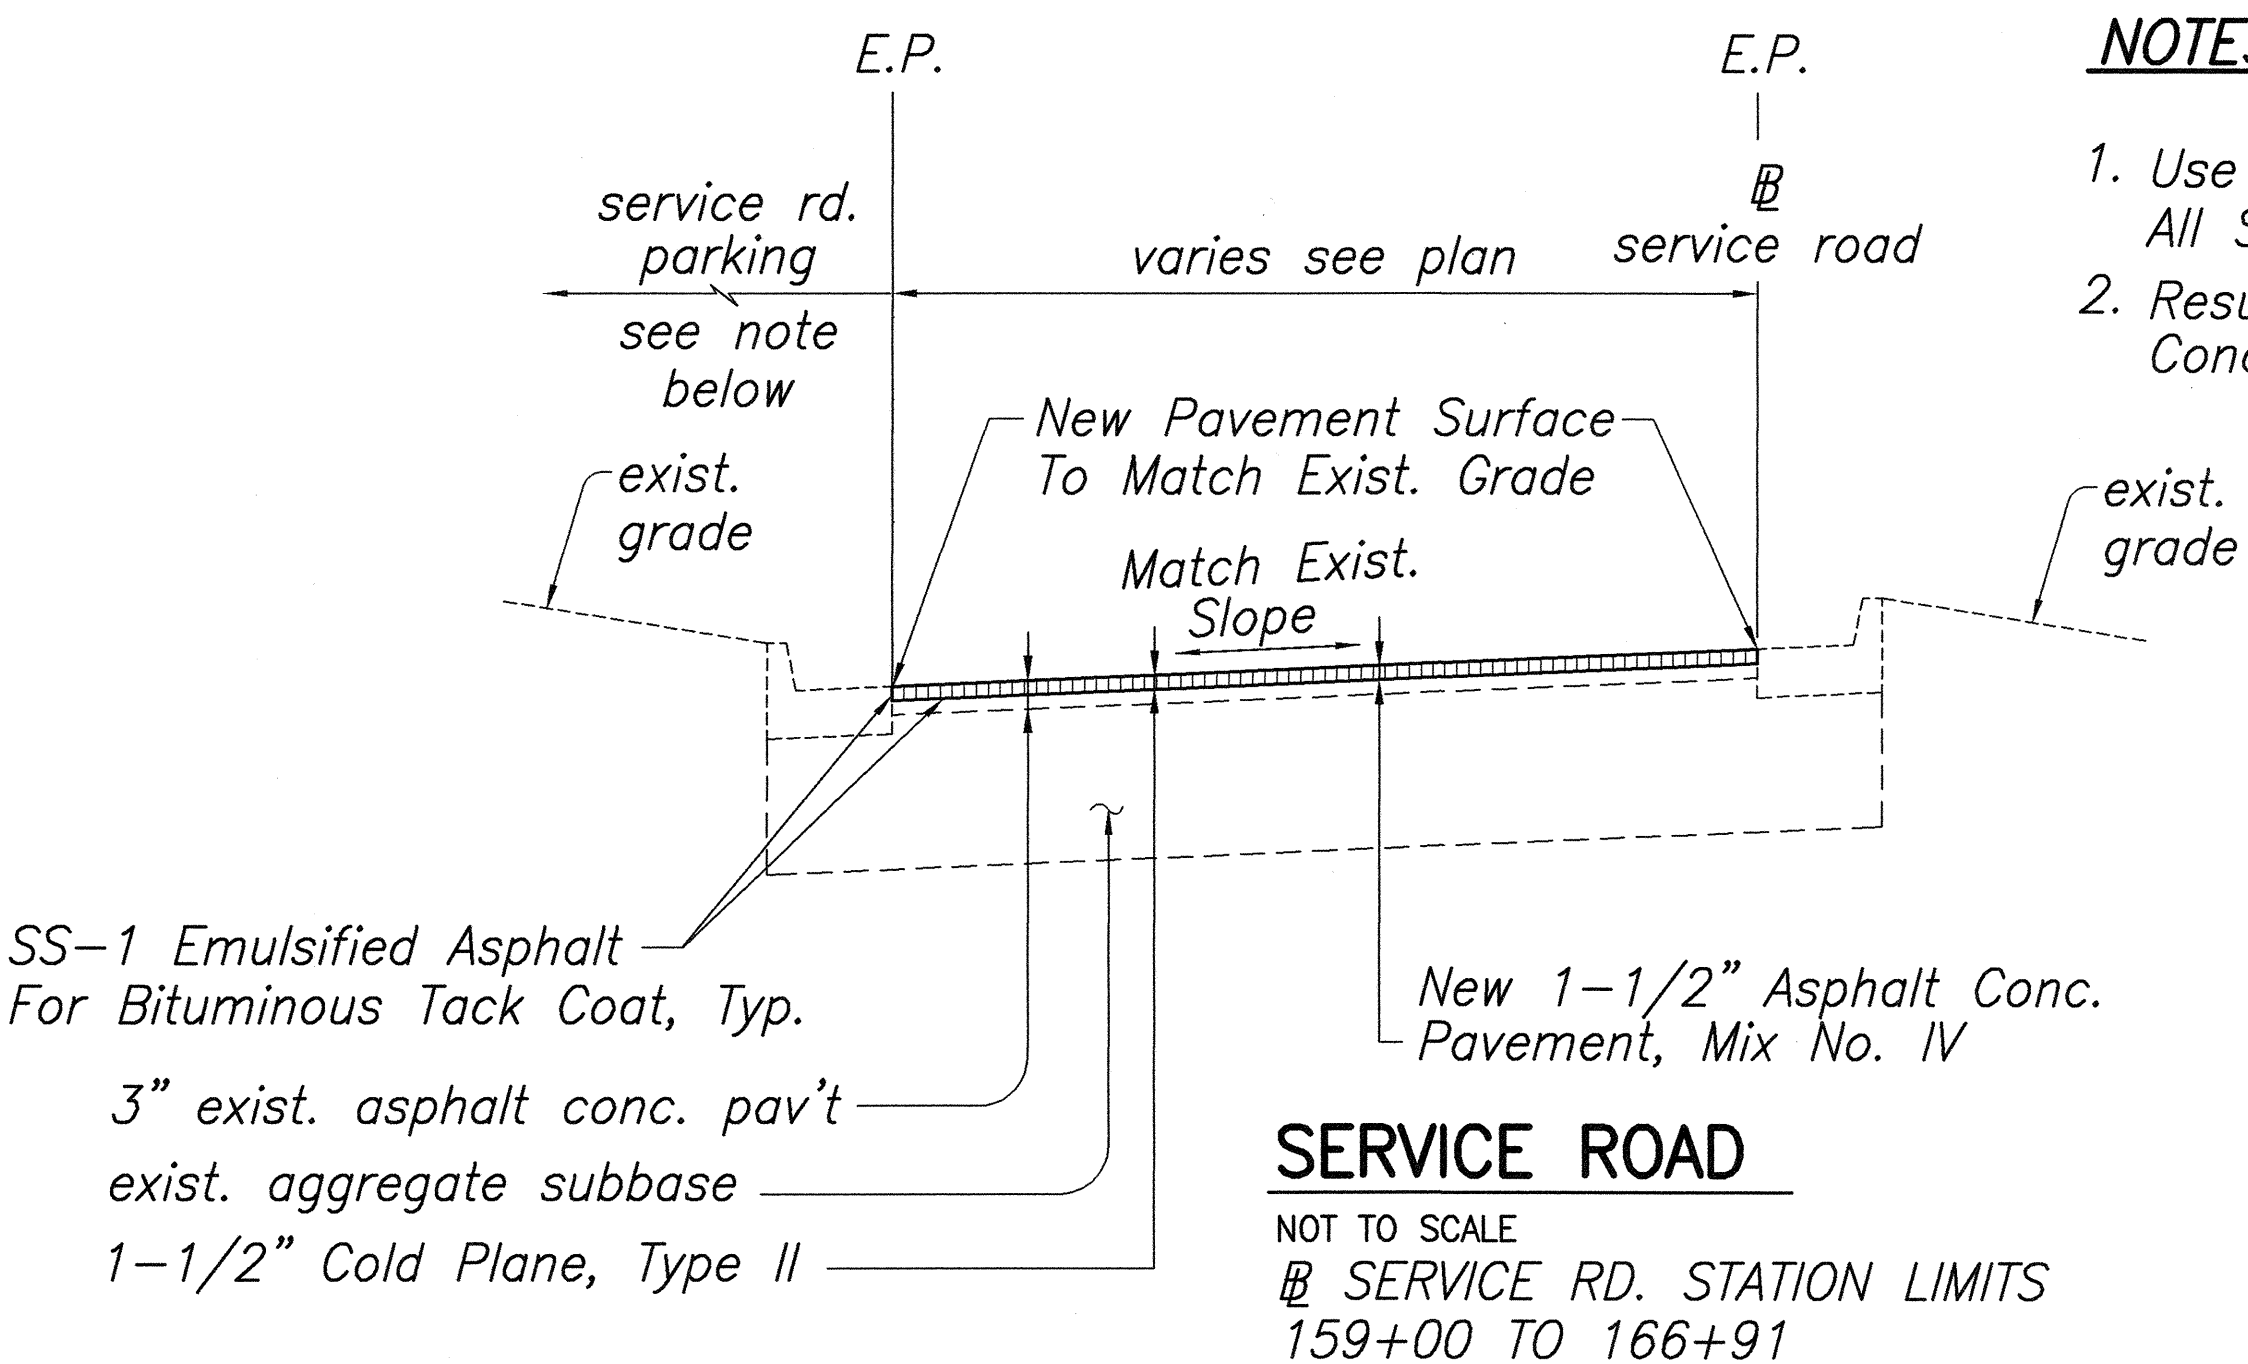


STATE OF HAWAII
DEPARTMENT OF TRANSPORTATION
HIGHWAYS DIVISION

TYPICAL PAVEMENT SECTIONS
NIMITZ HIGHWAY RESURFACING
RODGERS BOULEVARD TO AHUA STREET
FED. AID PROJECT NO. STP-092-1(24)

Scale: As Noted Date: Aug. 2, 1999


SHEET NO. C-5 OF 57 SHEETS

FED. ROAD DIST. NO.	STATE	FED. AID PROJ. NO.	FISCAL YEAR	SHEET NO.	TOTAL SHEETS
HAWAII	HAW.	STP-092-1(24)	2000	7	57

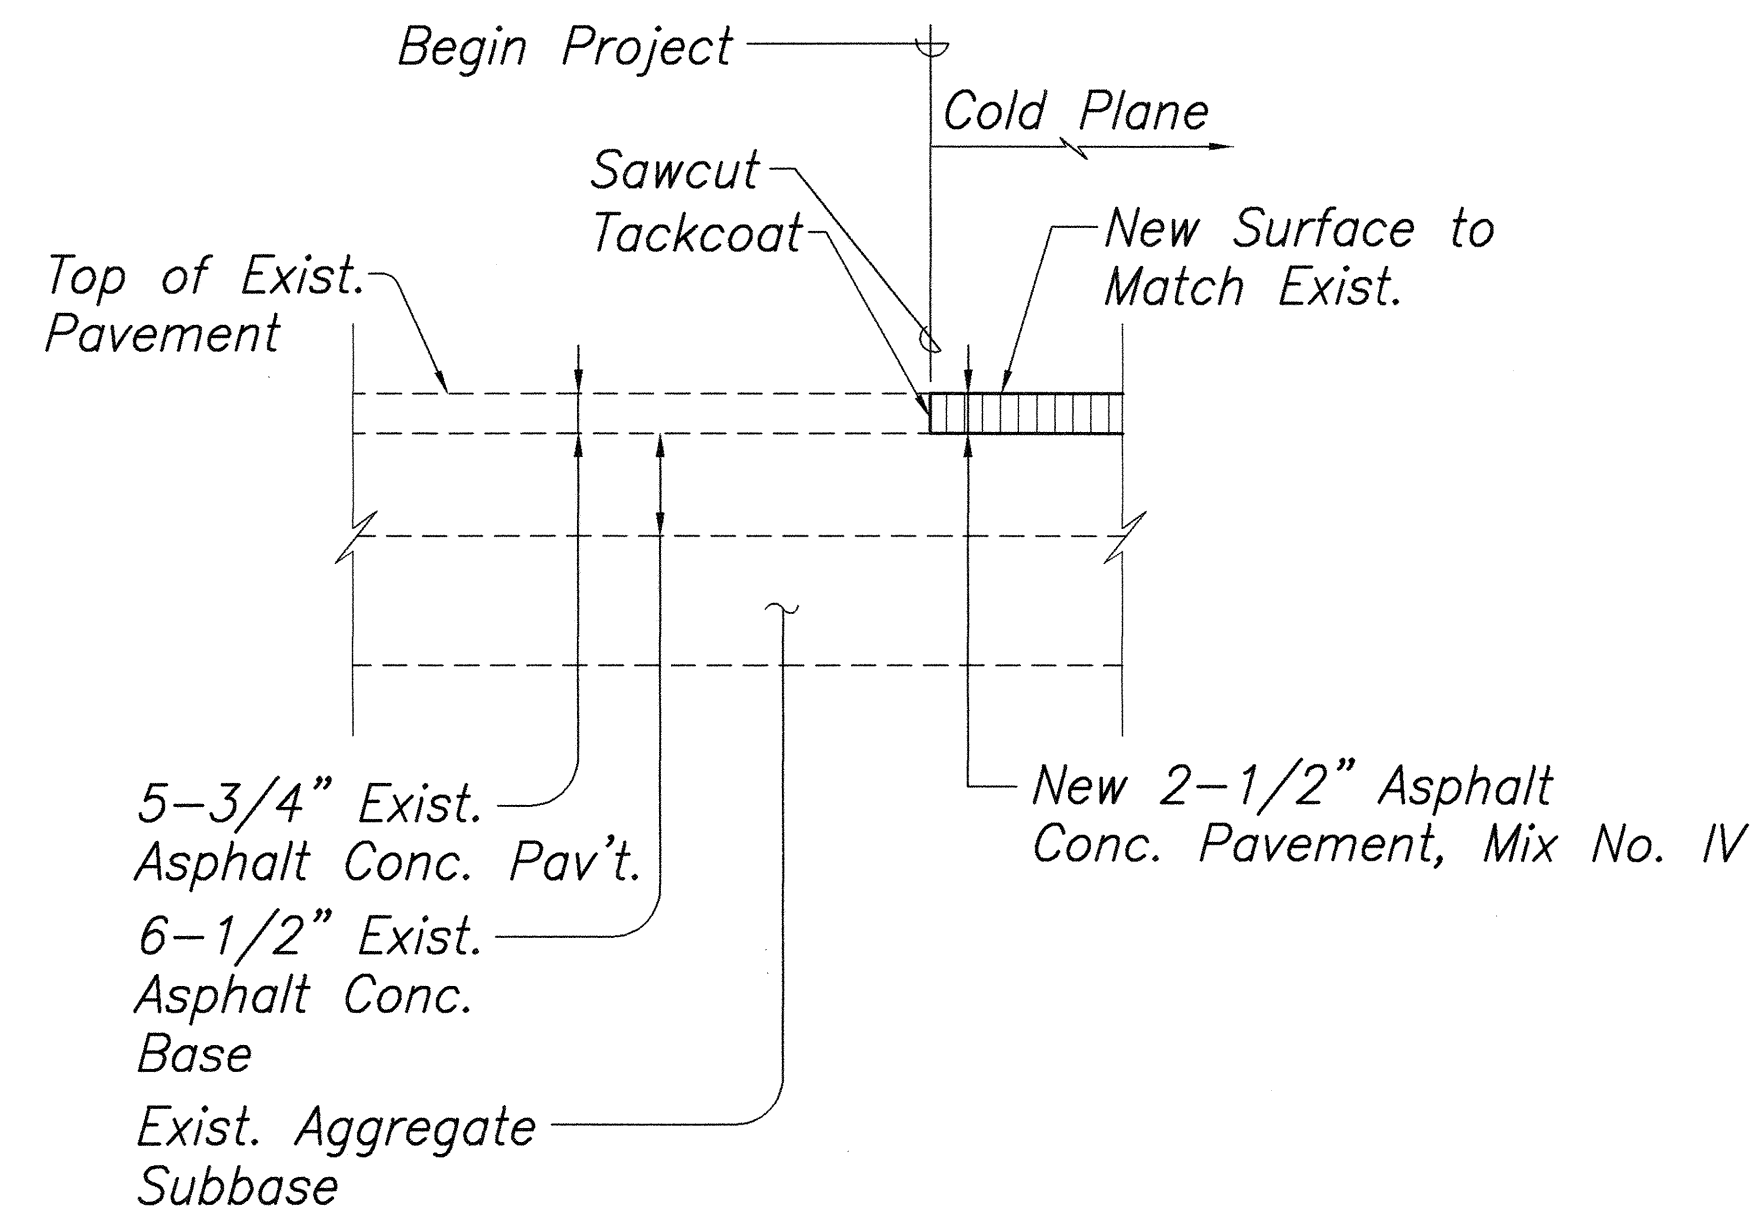


BEGIN PROJECT A.C. TRANSITION

SCALE: 1" = 1'-0"
 BEGIN PROJECT @ NIMITZ HIGHWAY AND KAMEHAMEHA HIGHWAY
 STA. 159+00

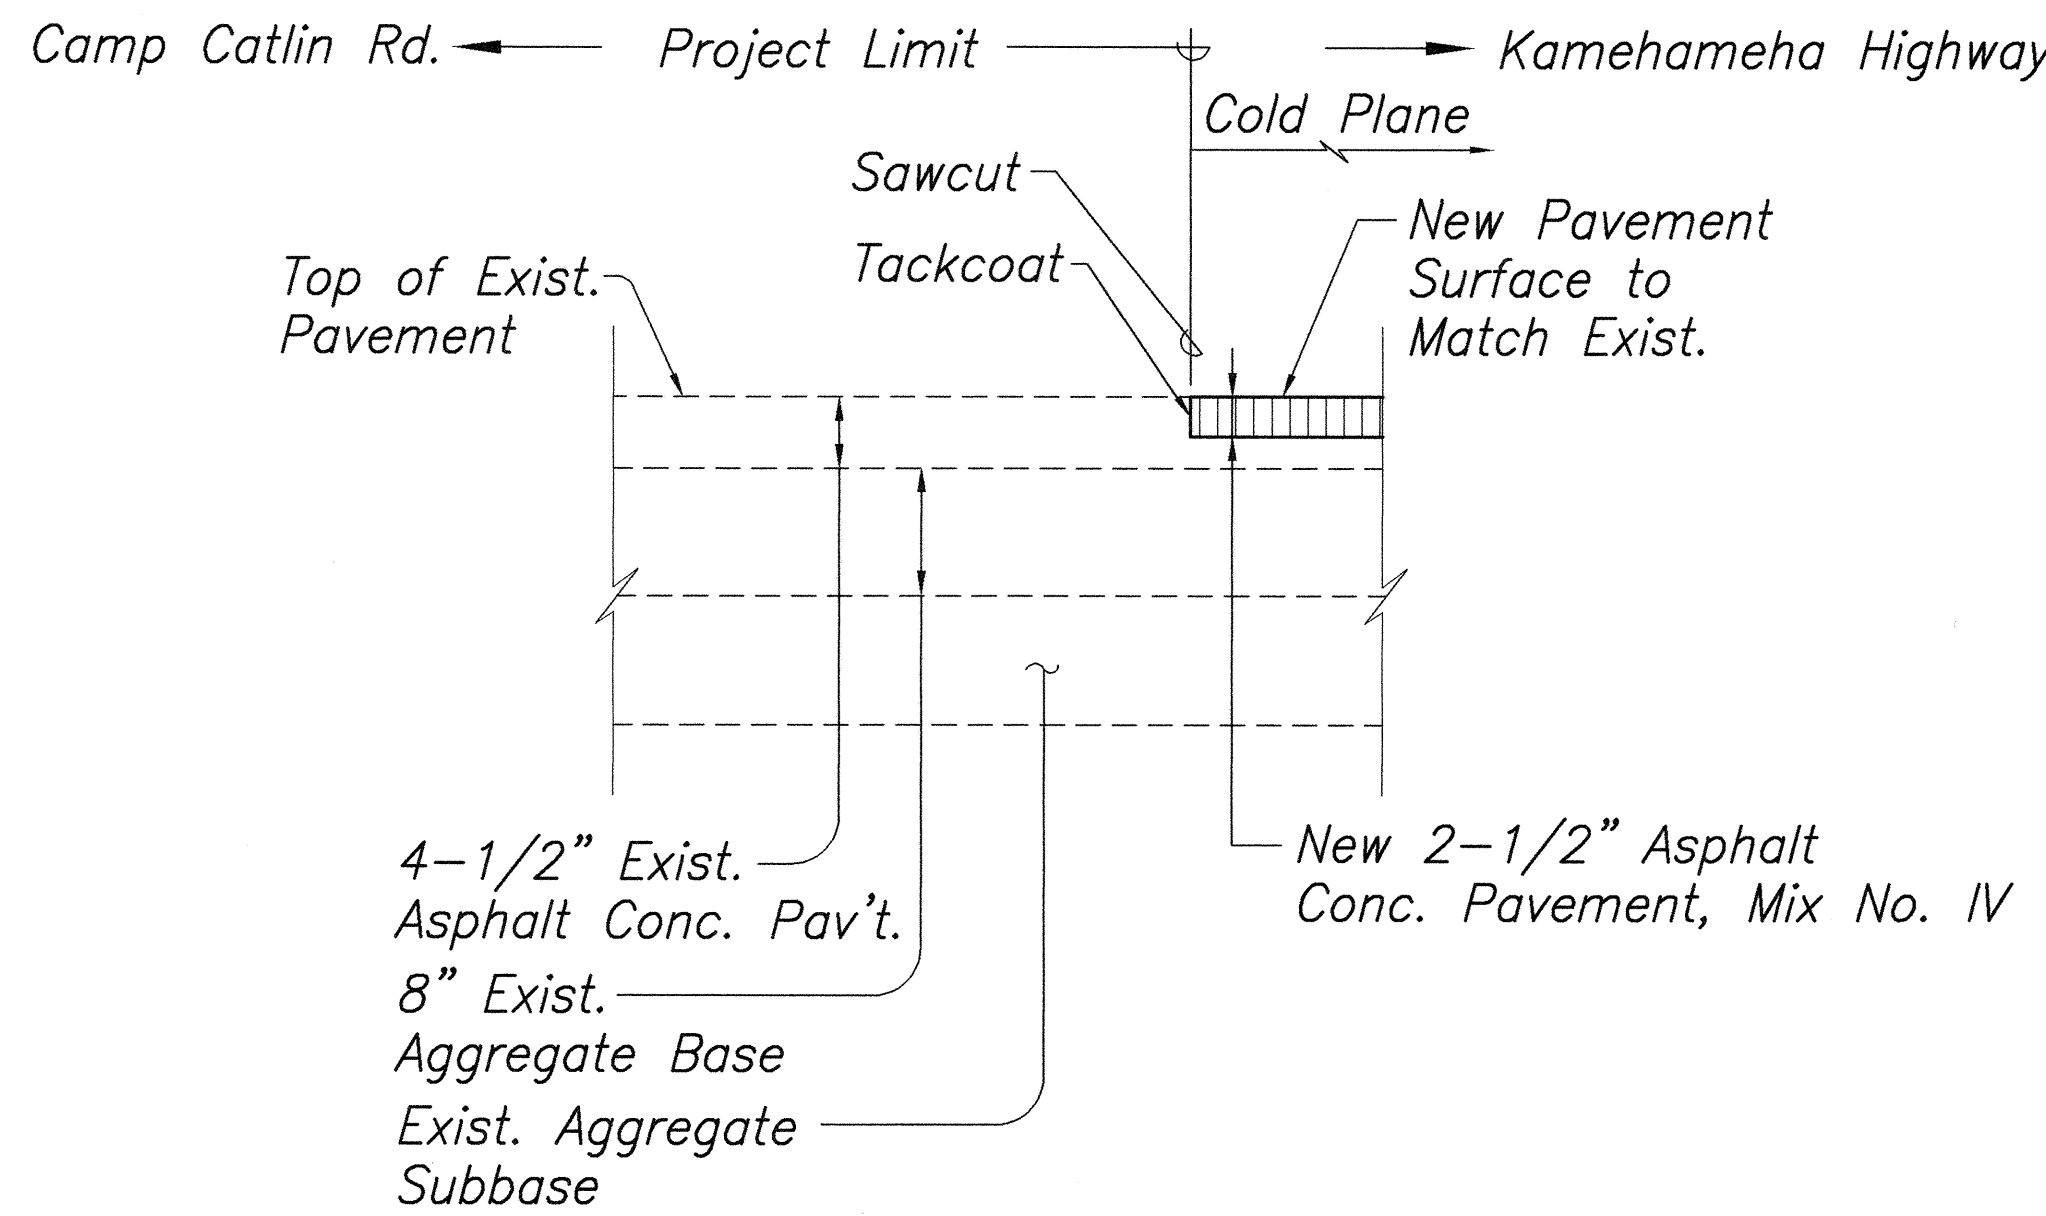


CAMP CATLIN RD. A.C. TRANSITION

SCALE: 1" = 1'-0"

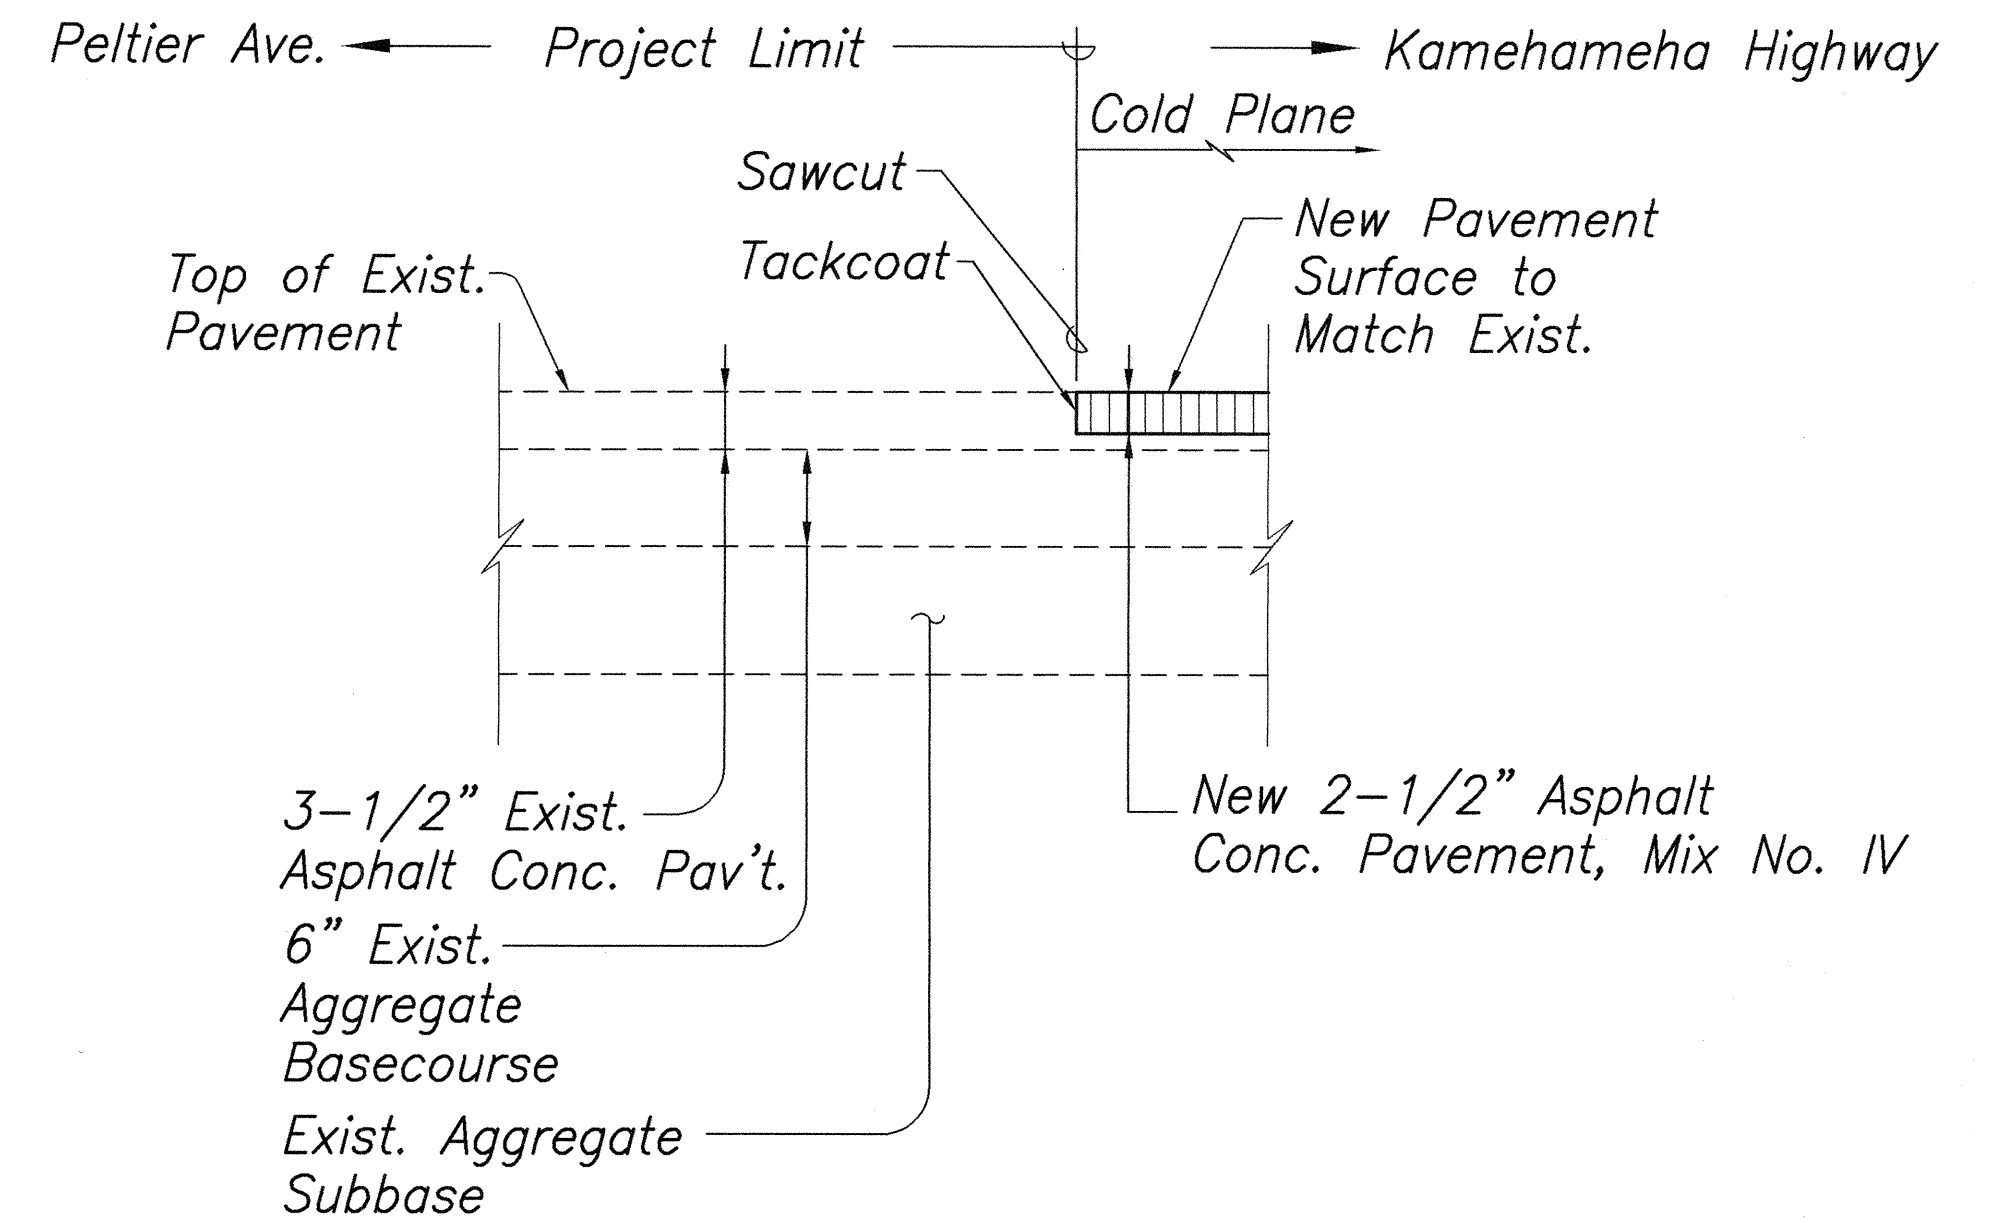


PELTIER AVE. A.C. TRANSITION

SCALE: 1" = 1'-0"

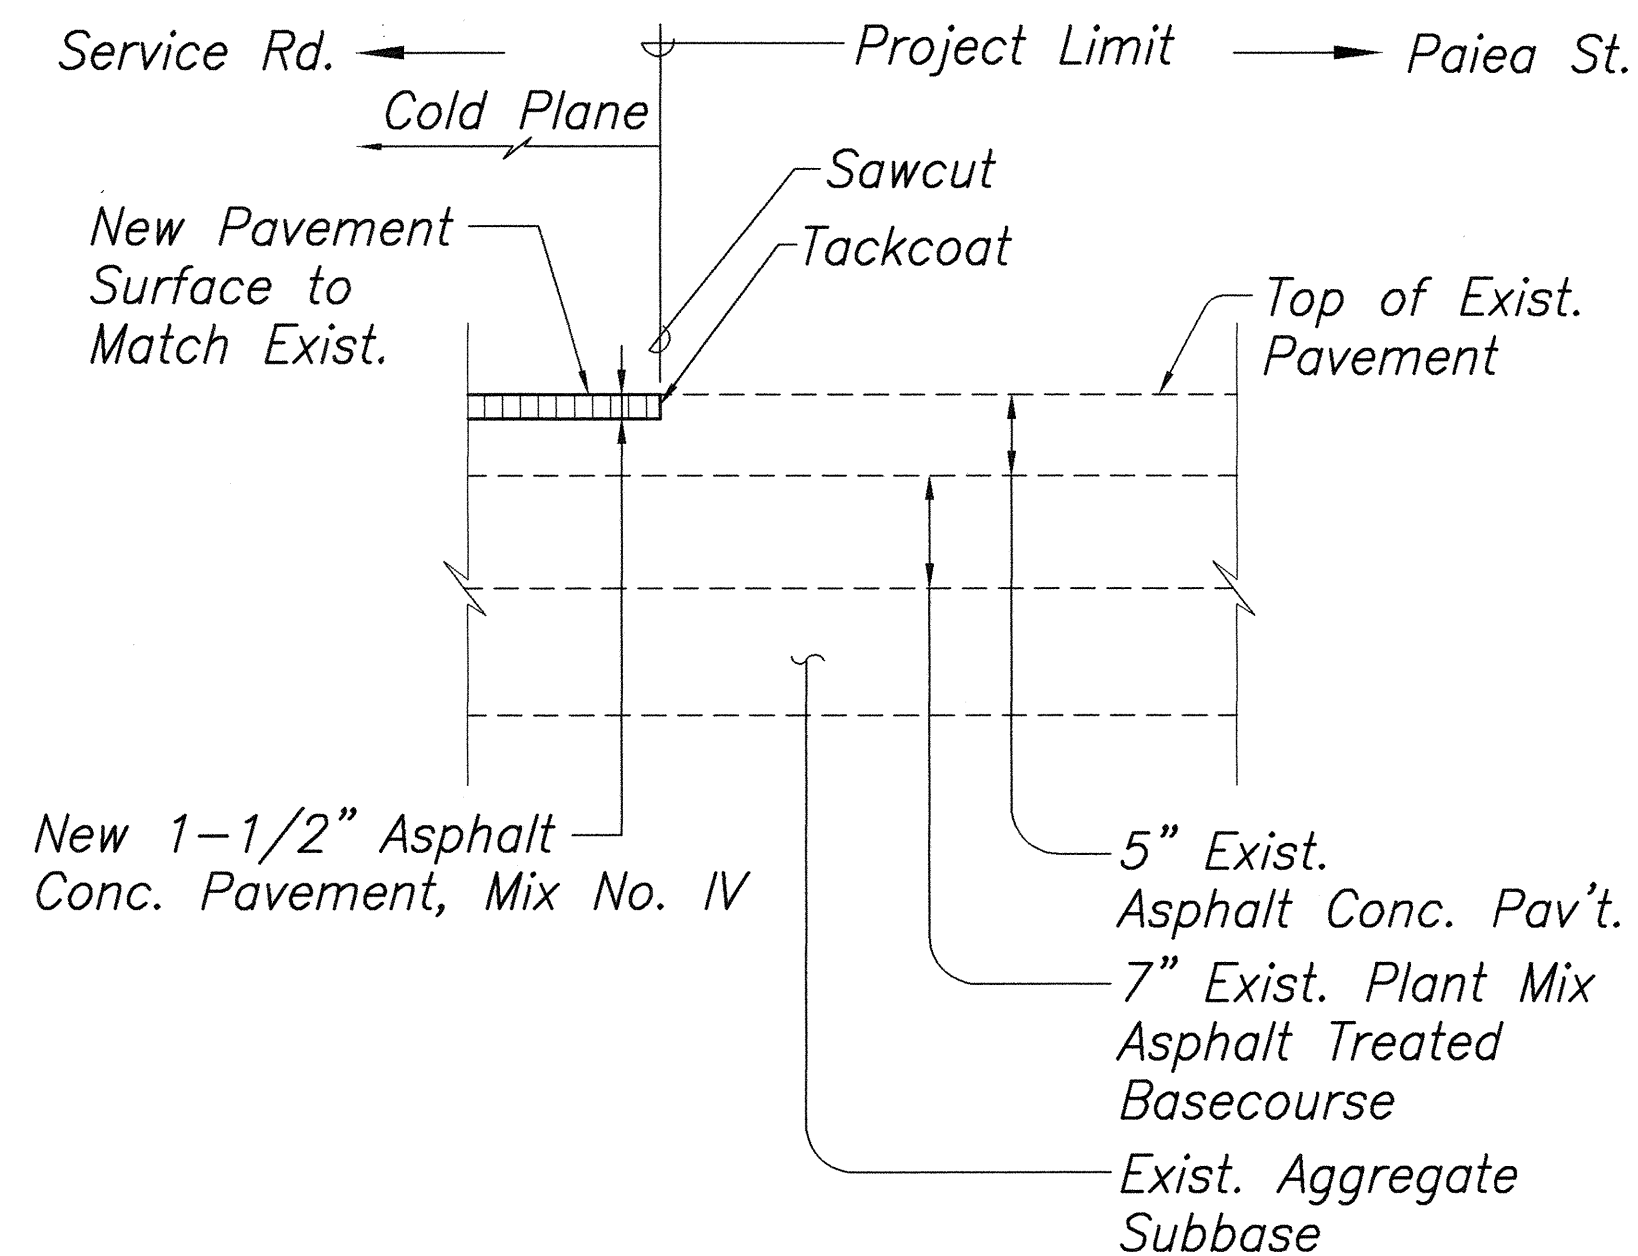


PAIEA ST. A.C. TRANSITION

SCALE: 1" = 1'-0"

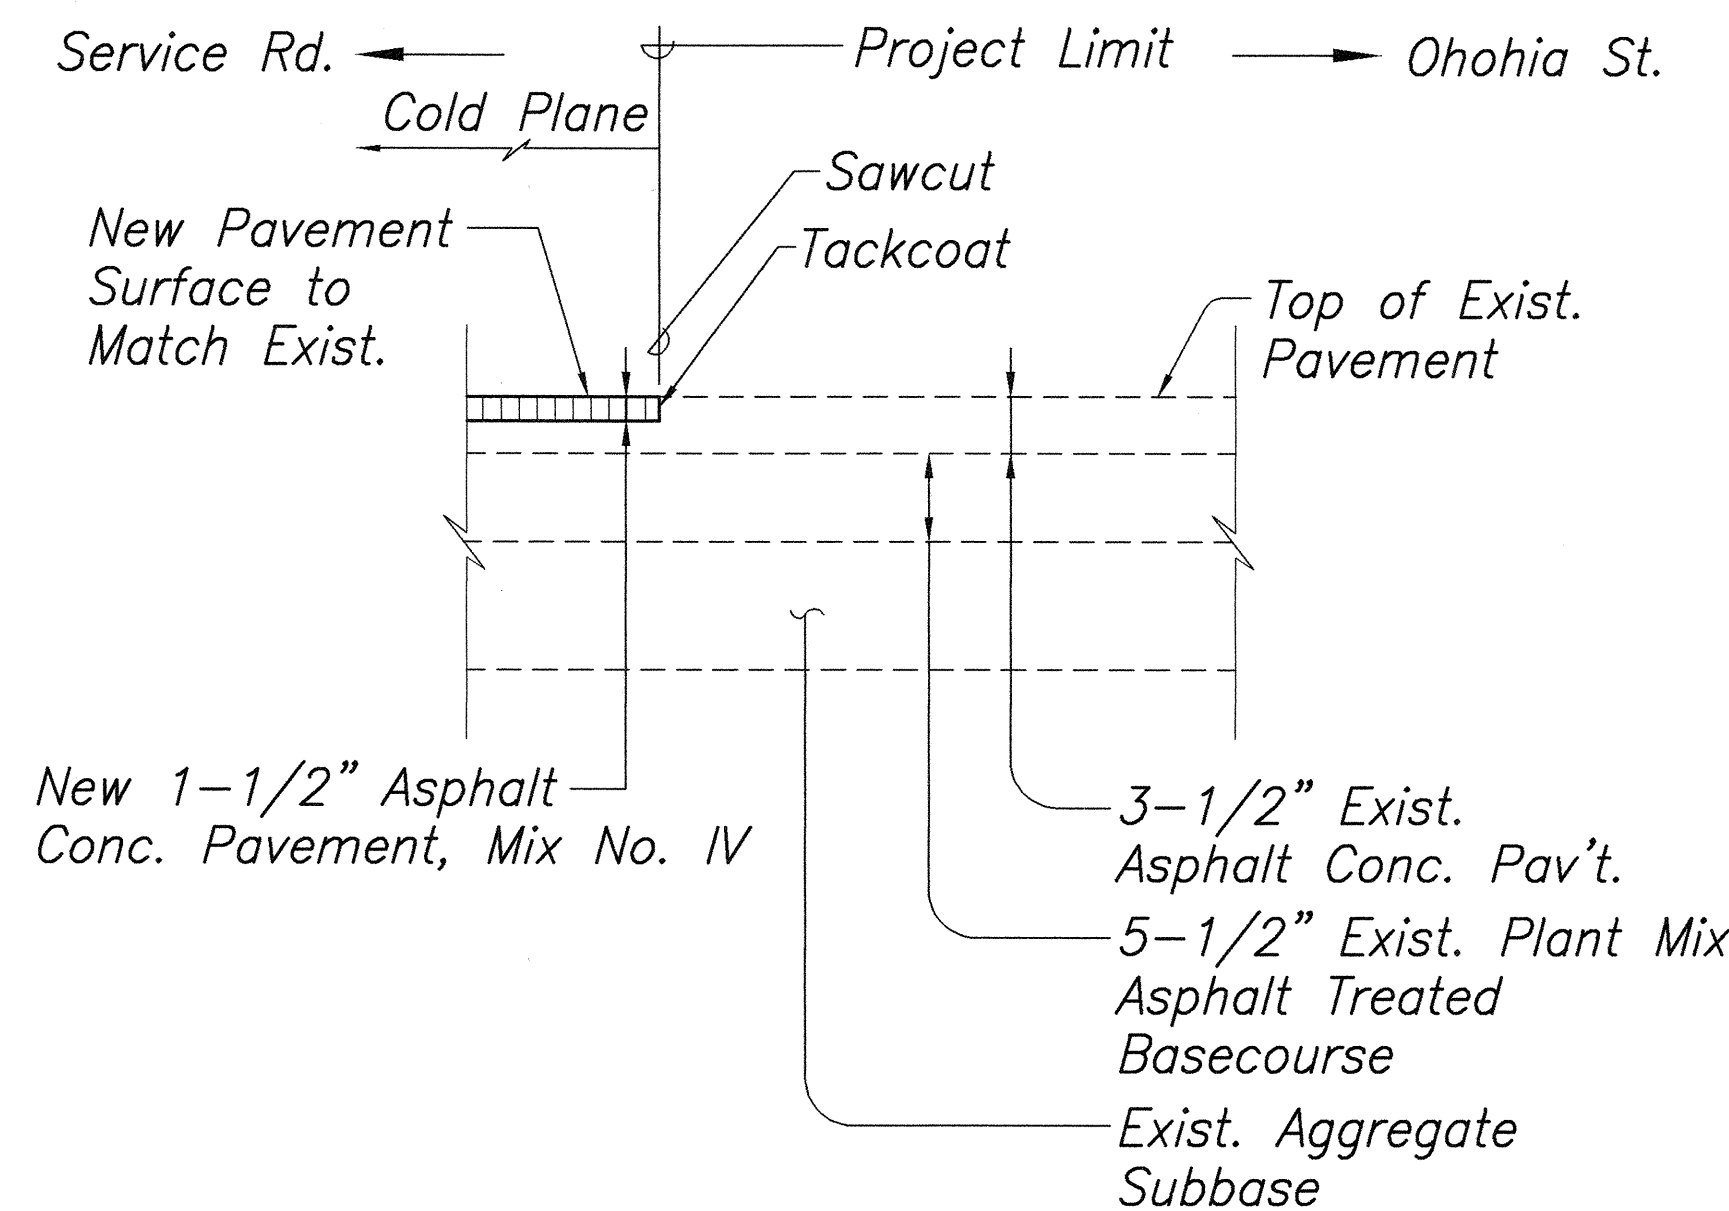


OHOHIA ST. A.C. TRANSITION

SCALE: 1" = 1'-0"

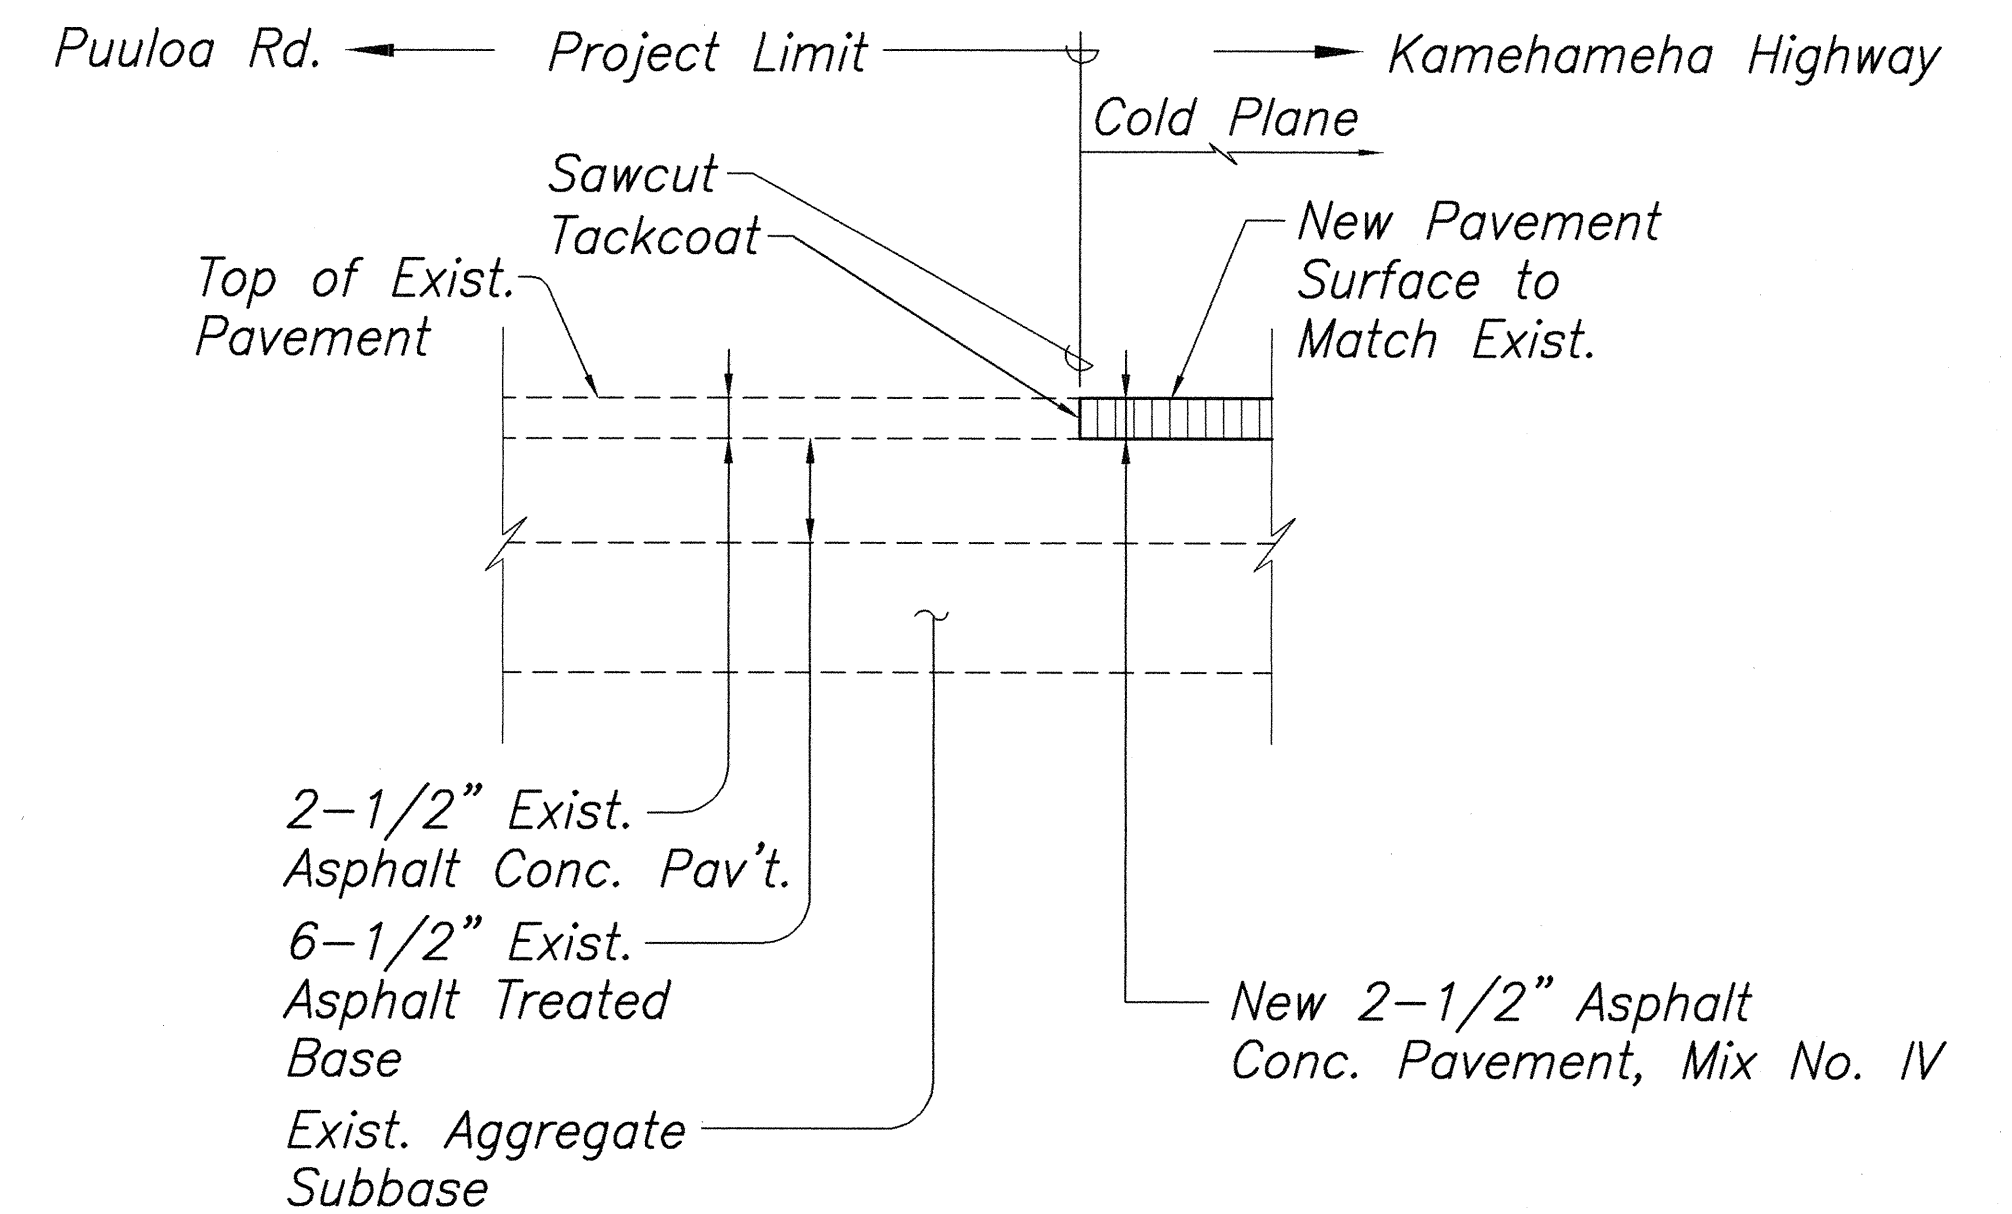

PUULOA RD. A.C. TRANSITION


SCALE: 1" = 1'-0"

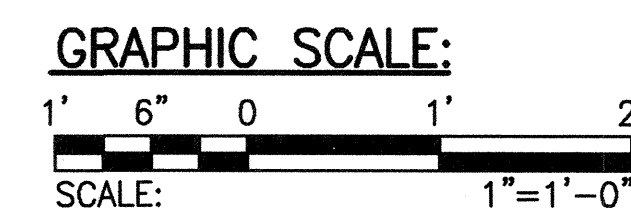

Lance S. Oyama


STATE OF HAWAII DEPARTMENT OF TRANSPORTATION HIGHWAYS DIVISION	
PAVEMENT TRANSITIONS NIMITZ HIGHWAY RESURFACING RODGERS BOULEVARD TO AHUA STREET FED. AID PROJECT NO. STP-092-1(24)	
Scale: As Noted	Date: Aug. 2, 1999
SHEET NO. C-6 OF 57 SHEETS	

FED. ROAD DIST. NO.	STATE	FED. AID PROJ. NO.	FISCAL YEAR	SHEET NO.	TOTAL SHEETS
HAWAII	HAW.	STP-092-1(24)	2000	8	57

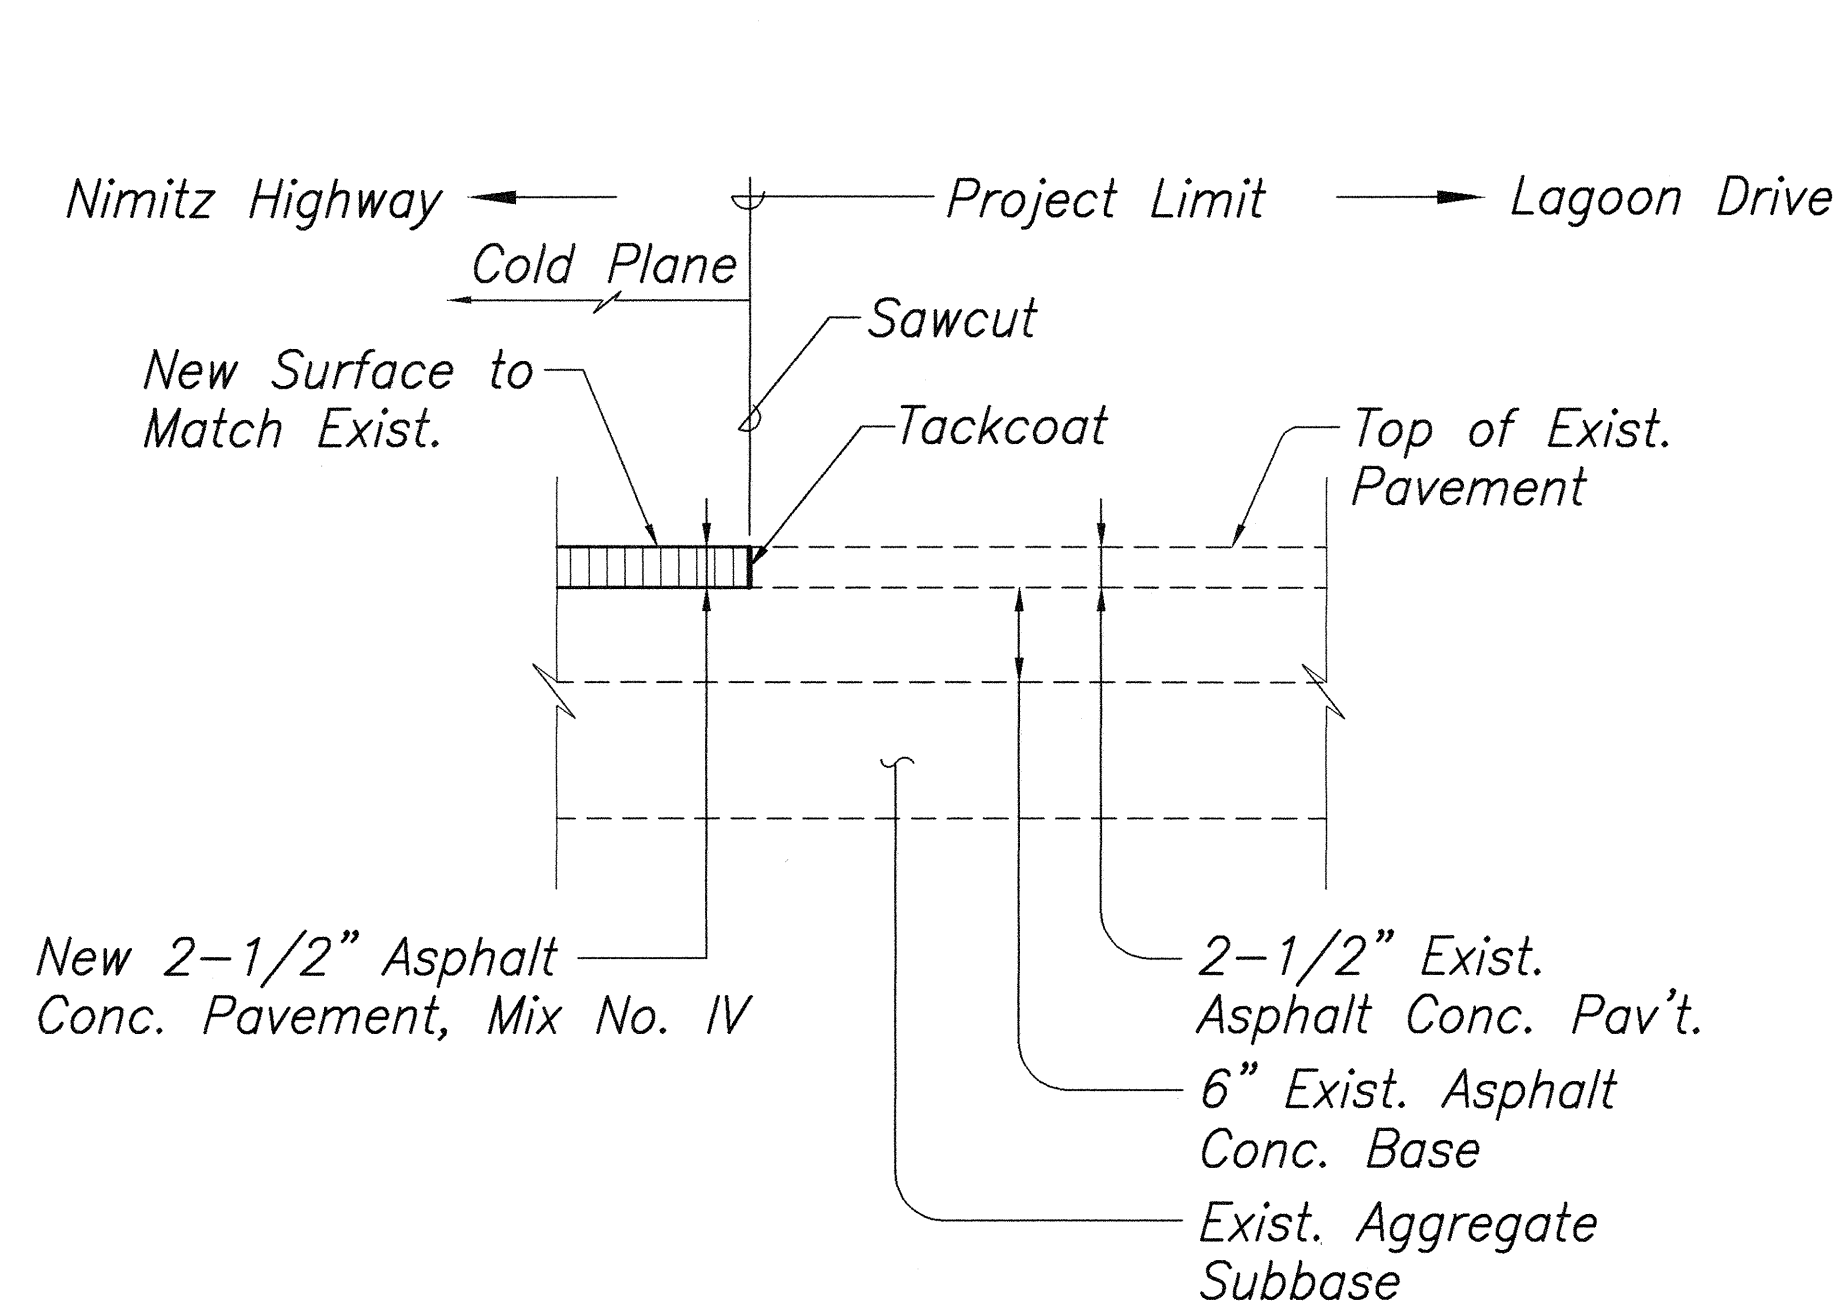

LAGOON DR. A.C. TRANSITION


SCALE: 1" = 1'-0"

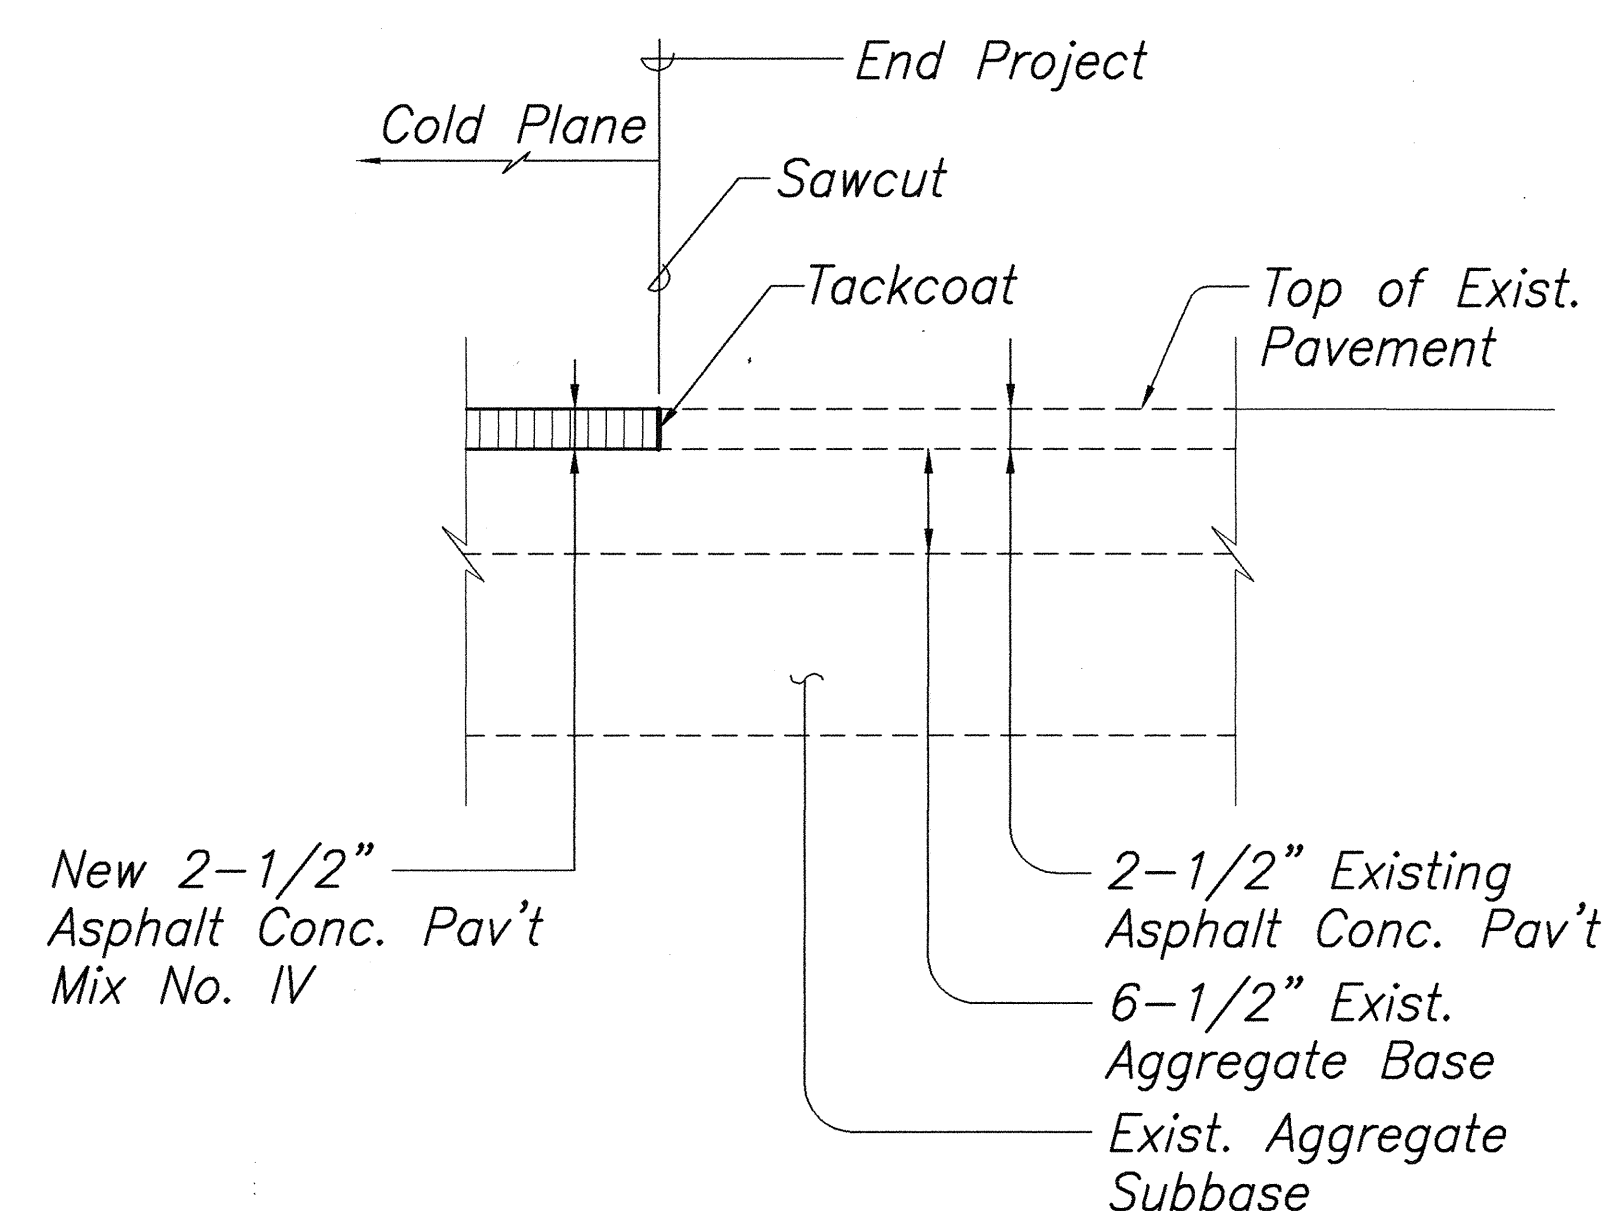

END PROJECT A.C. TRANSITION


SCALE: 1" = 1'-0"

END PROJECT @ NIMITZ HIGHWAY STA. 223+50
END PROJECT @ KAMEHAMEHA HIGHWAY STA. 221+60

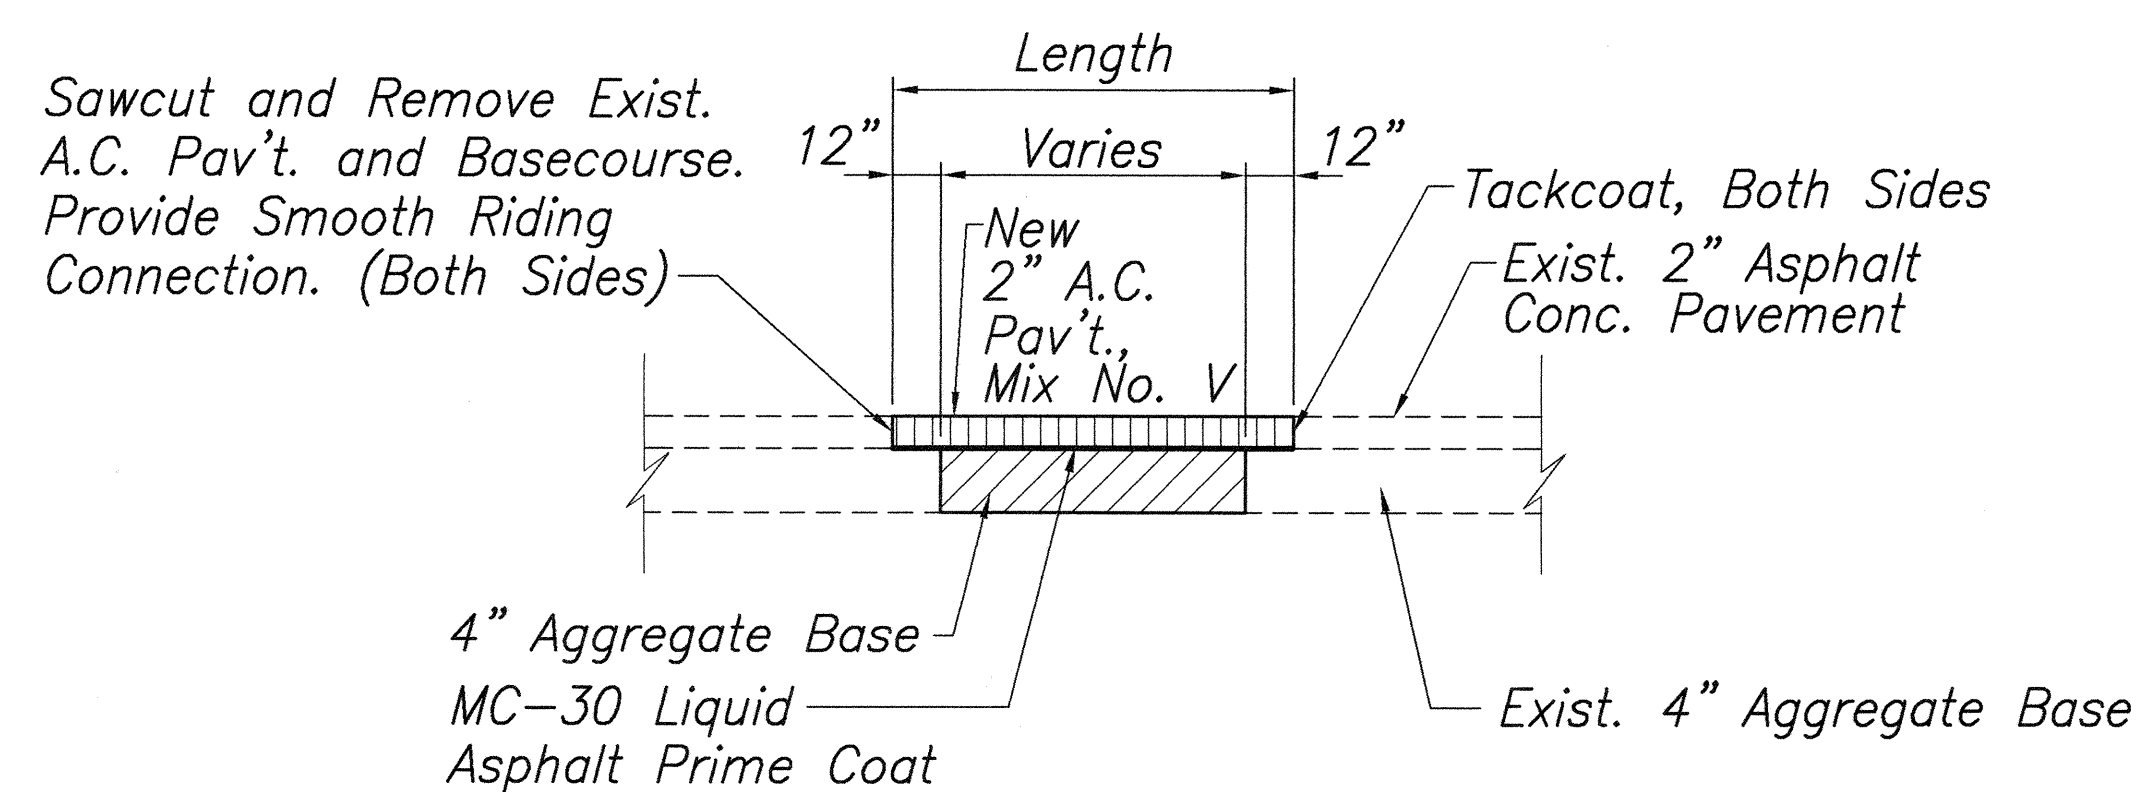


BIKEWAY RECONSTRUCTION

NOT TO SCALE

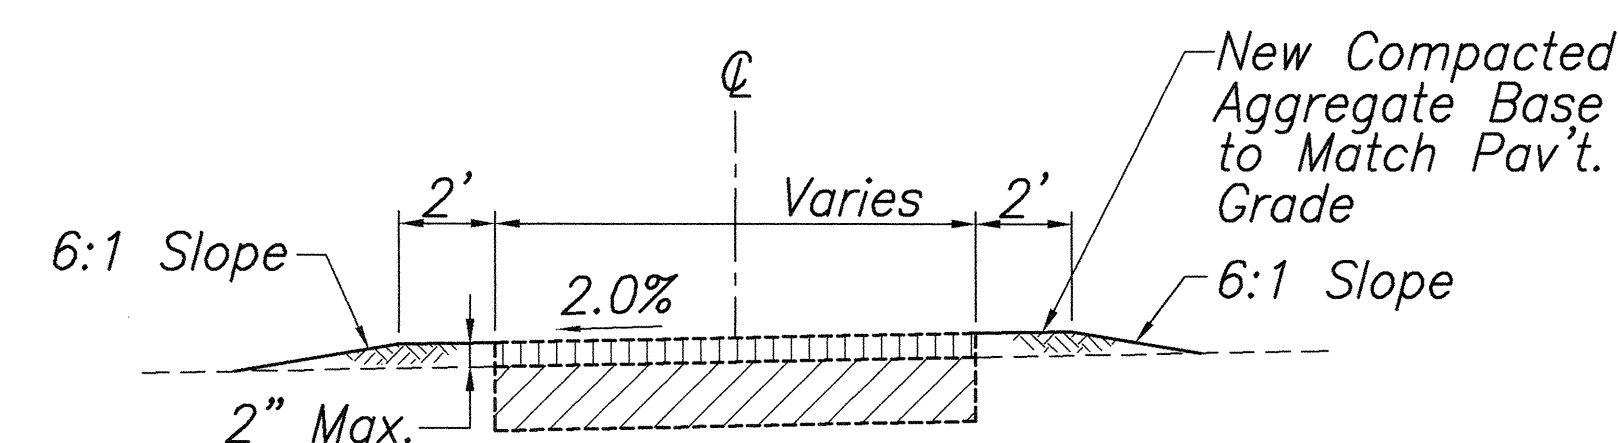


BIKEWAY GRADED SHOULDER

NOT TO SCALE

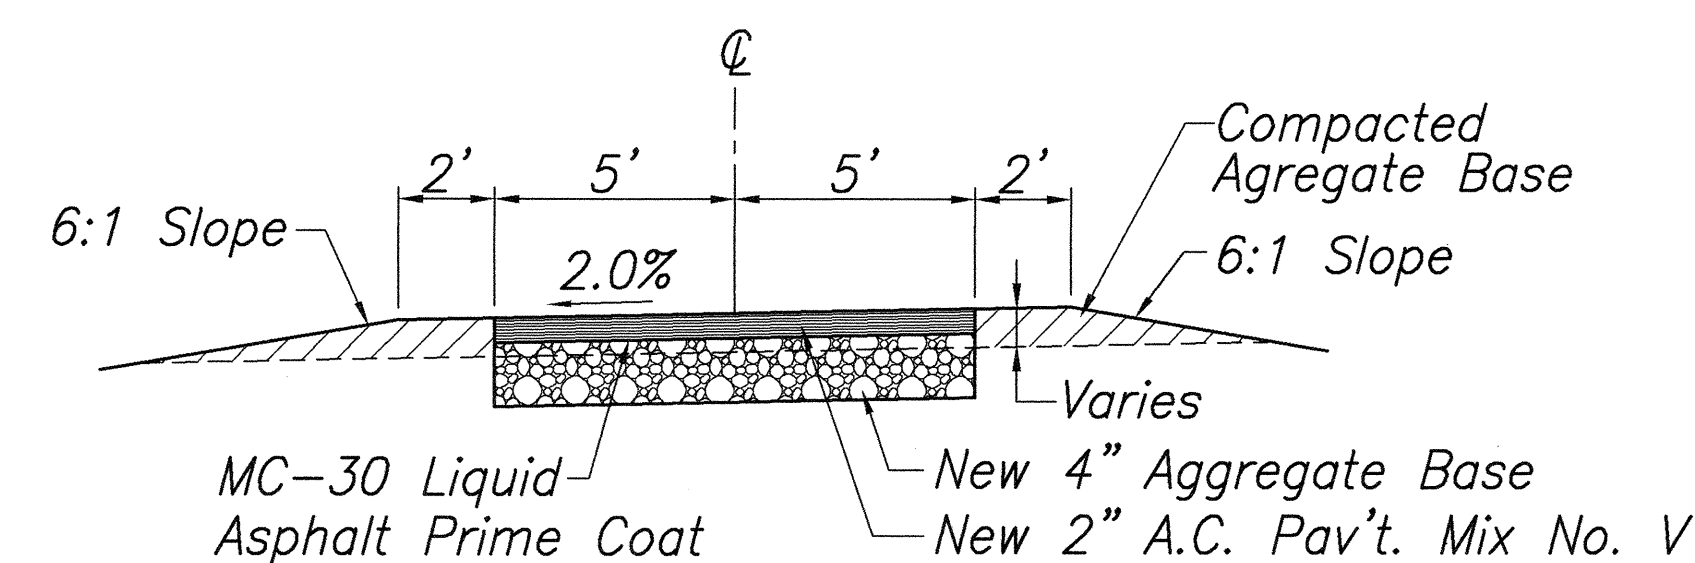



BIKEWAY RECONSTRUCTION @ KAMEHAMEHA HWY. STA. 221+35 TO @ KAKOI ST. STA. 11+20

NOT TO SCALE

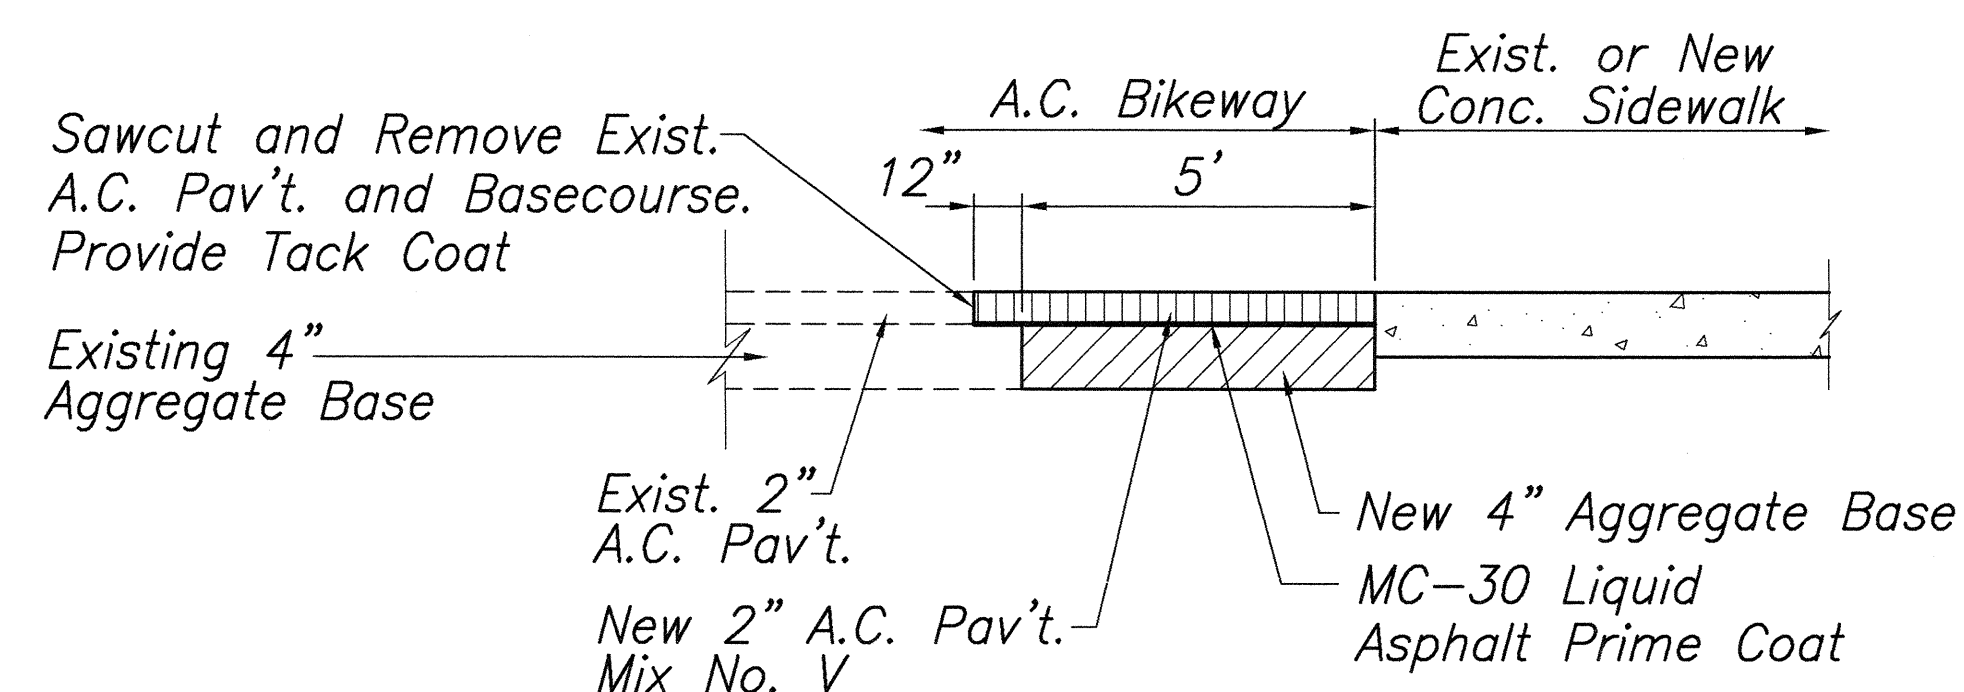

BIKEWAY CONNECTION

NOT TO SCALE

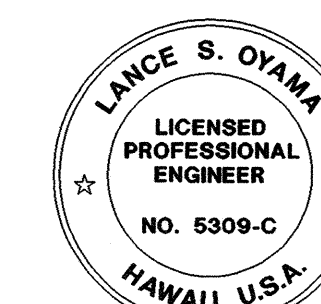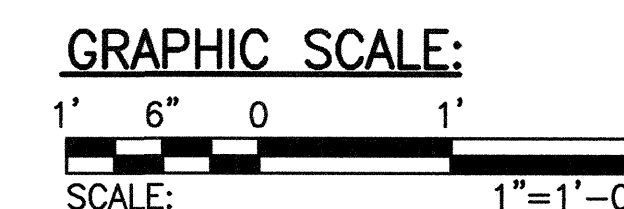

Lance S. Oyama

STATE OF HAWAII DEPARTMENT OF TRANSPORTATION HIGHWAYS DIVISION	
PAVEMENT TRANSITIONS AND BIKEWAY DETAILS	
NIMITZ HIGHWAY RESURFACING RODGERS BOULEVARD TO AHUA STREET FED. AID PROJECT NO. STP-092-1(24)	
Scale: As Noted	Date: Aug. 2, 1999
SHEET No. C-7 OF 57 SHEETS	