




INDEX TO DRAWING	
SHEET NO.	DESCRIPTION
1 TO 225	FEDERAL-AID PROJECT NO. NH-092-1(25)
226 TO 268	BOARD OF WATER SUPPLY JOB NO. 01-87A

Sheet Nos. (1) 46S-1, (2) 50S-1 to 50S-3, (3) 52S-1, (4) 53S-1, (5) 61S-1, (6) 65S-1, (7) 76S-1 to 76S-2, (8) 77S-1 to 77S-3, (9) 132S-1, (10) 138S-1, (11) C.O. 139S-1, (12) C.O. 147S-1, (13) 172S-1, (14) 185S-1, (15) C.O. 236S-1 TO C.O. 236S-4, (16) C.O. 237S-1, ADD 237S-1, C.O. 237S-2, C.O. 237S-4, (17) ADD 238S-1, C.O. 238S-1, (18) C.O. 239S-1, C.O. 239S-5 TO C.O. 239S-6, (19) C.O. 240S-1 TO C.O. 240S-2, (20) C.O. 241S-1, C.O. 241S-7 TO C.O. 241S-8, (21) C.O. 242S-1, C.O. 242S-8 TO C.O. 242S-9, (22) C.O. 243S-1, C.O. 243S-9 TO C.O. 243S-10, (23) C.O. 244S-1, (24) C.O. 245S-1, (25) C.O. 247S-1, C.O. 247S-12, (26) C.O. 248S-1, C.O. 248S-13, (27) C.O. 249S-1 TO C.O. 249S-2, (28) C.O. 250S-1, (29) C.O. 253S-1, (30) C.O. 254S-1, (31) C.O. 256S-1, (32) ADD 258S-1, (33) 266S-1 are Supplementary Sheets to this Project. Total Sheet Count After "As-Built" Posting 323 Sheets.

STATE OF HAWAII
DEPARTMENT OF TRANSPORTATION
HIGHWAYS DIVISION
"AS-BUILT" HONOLULU, HAWAII
PLANS FOR
NIMITZ HIGHWAY REHABILITATION
SUMNER STREET TO QUEEN STREET
FEDERAL AID PROJECT NO. NH-092-1(25)
AND
NIMITZ HIGHWAY
WATER SYSTEM IMPROVEMENTS, PART 1
BOARD OF WATER SUPPLY PROJECT NO. 01-87A
CITY AND COUNTY OF HONOLULU
DISTRICT OF HONOLULU
ISLAND OF OAHU

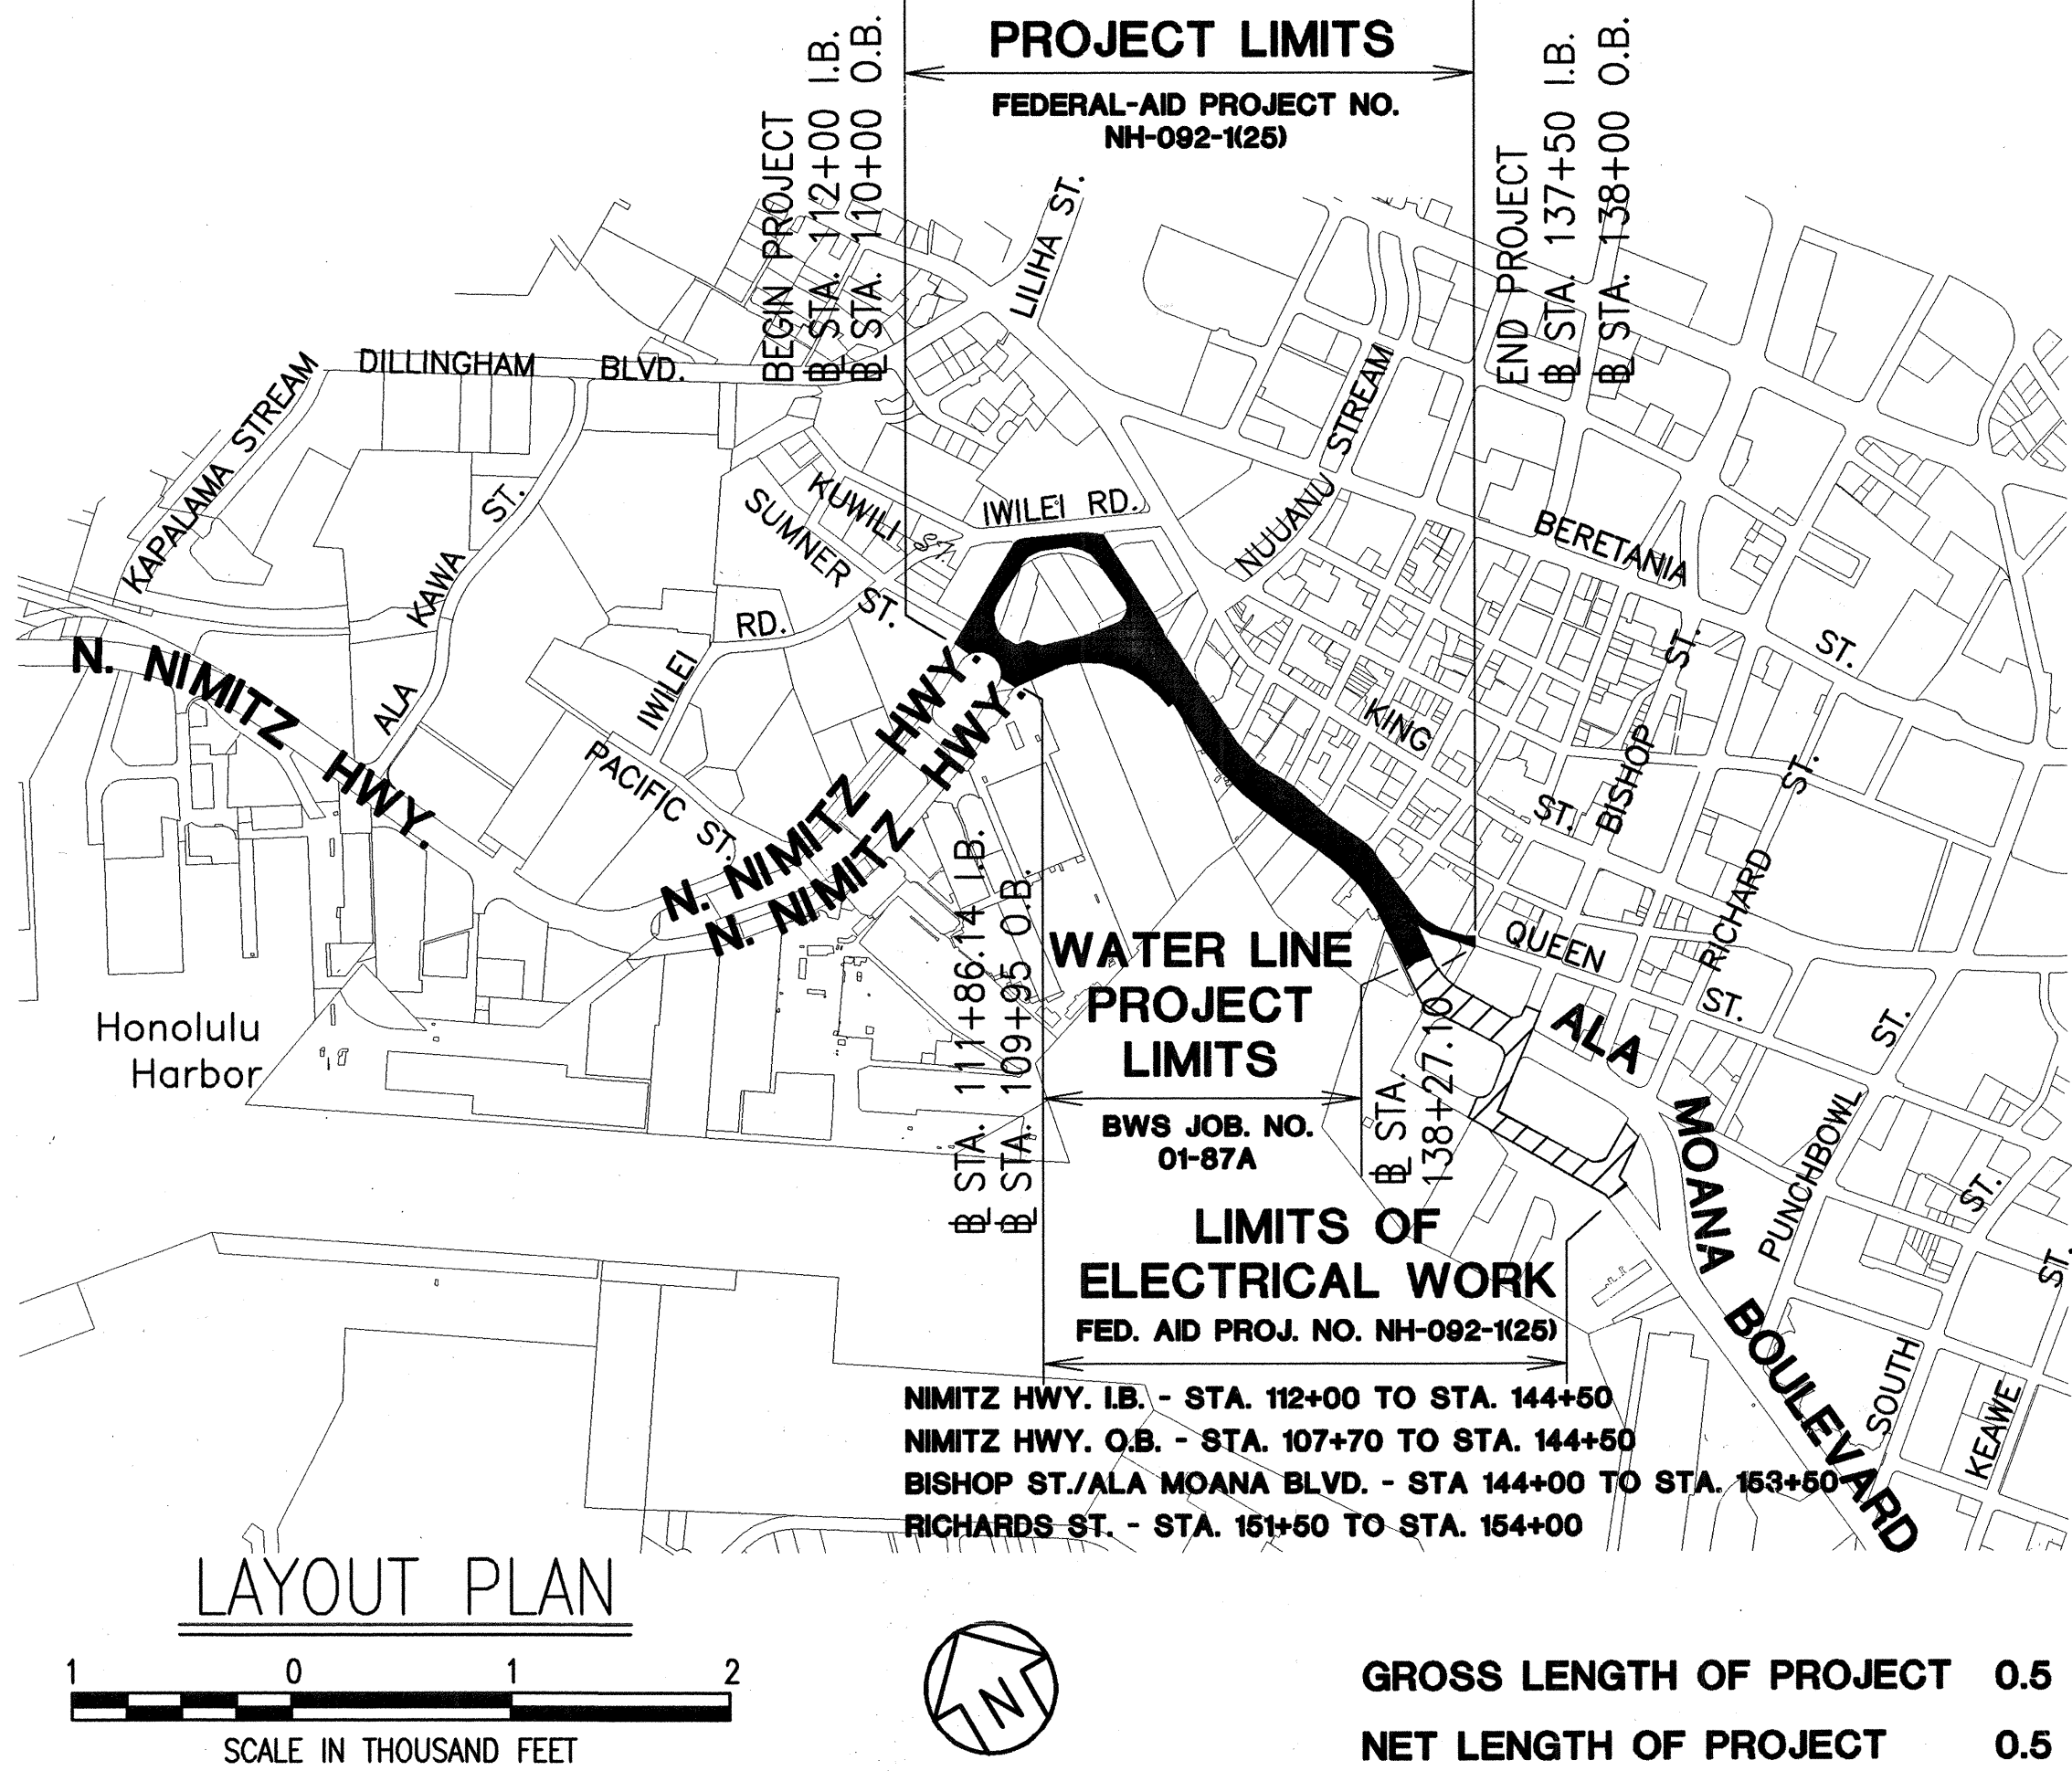

FED. ROAD DIST. NO.	STATE	FED. AID PROJ. NO.	FISCAL YEAR	SHEET NO.	TOTAL SHEETS
HAWAII	HAW.	NH-092-1(25)	2002	1	246

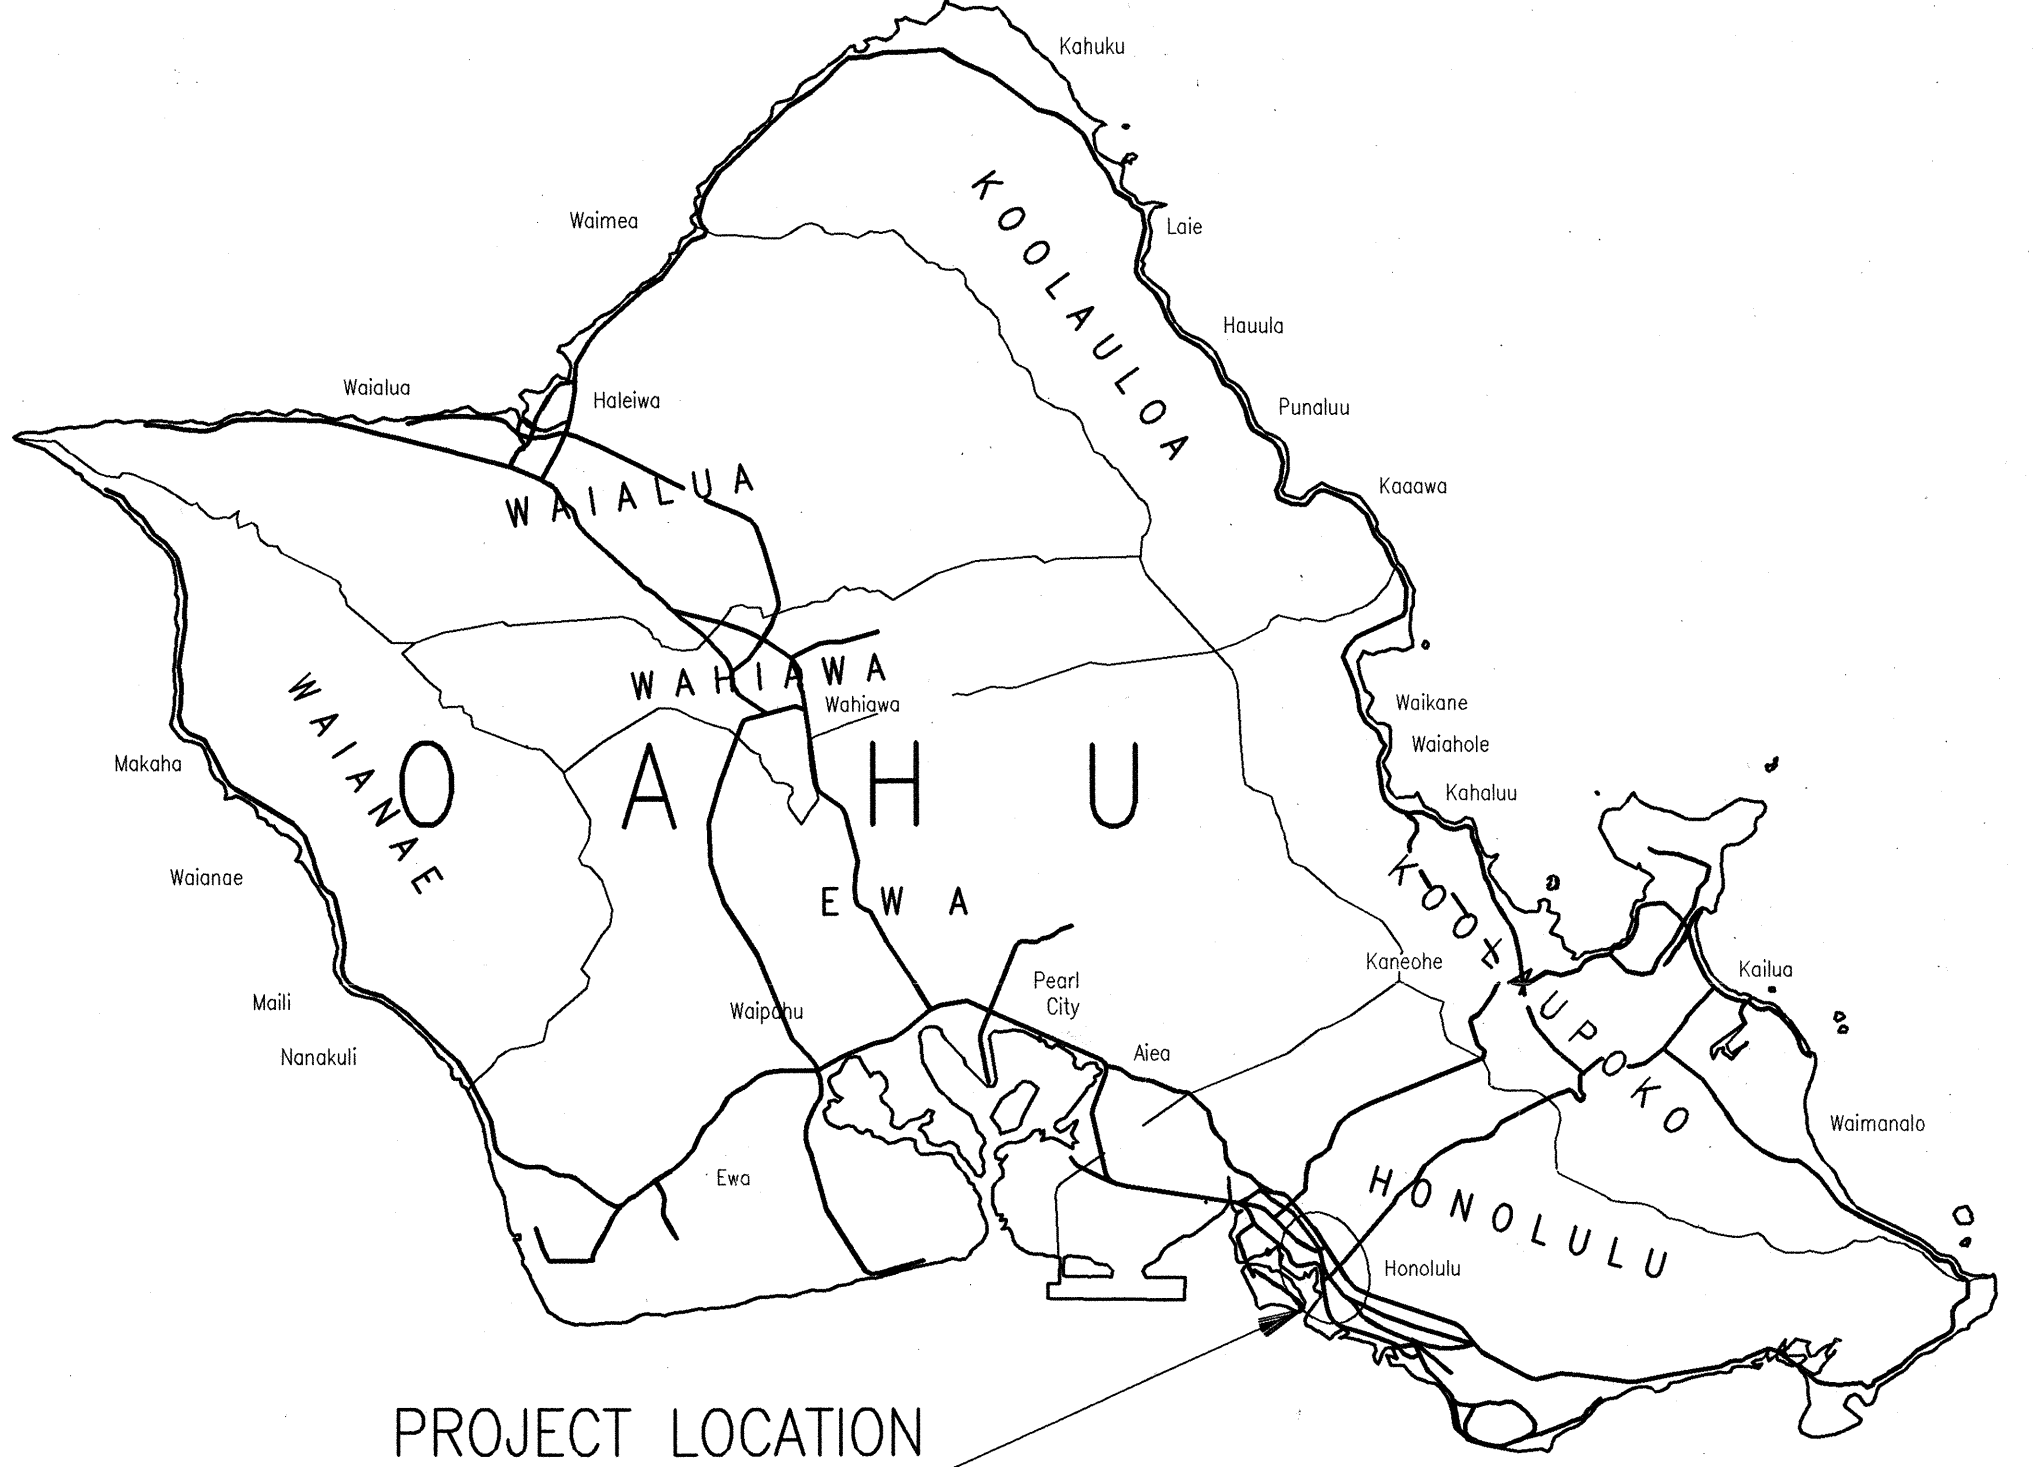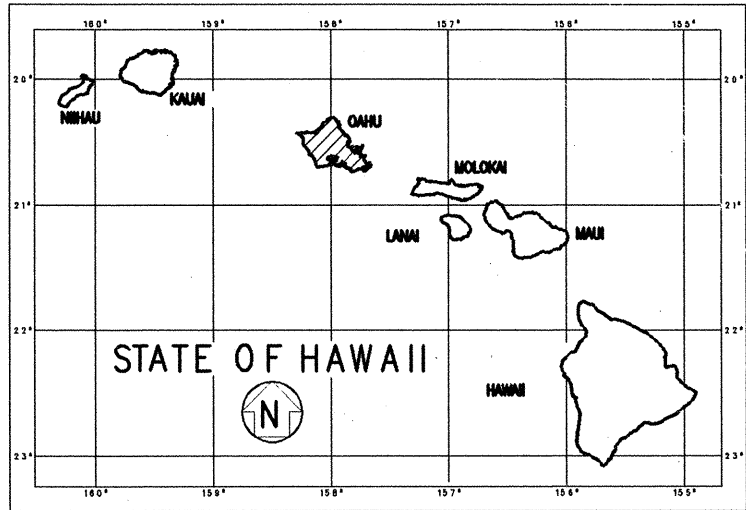

CHANGES MADE DURING CONSTRUCTION HAVE BEEN INCORPORATED ON THESE PLANS EXCEPT CHANGES IN THE ORIGINAL THEORETICAL QUANTITIES. FOR ACTUAL QUANTITIES, REFER TO PROJECT LEDGER AND/OR COMPUTATION BOOK.

RESIDENT ENGINEER DATE

ORIGINAL PLAN	DATE
DESIGNED BY	
CHECKED BY	
NOTED BY	
DESIGNED BY	
CHECKED BY	
NOTED BY	

R.M. TOWILL CORP. DESIGNED BY P. S. & E. BY Sean Hiraoka
692-7581 PHONE DEC. 2001 DATE

GROSS LENGTH OF PROJECT 0.5 MILES
NET LENGTH OF PROJECT 0.5 MILES