	INDEX TO DRAWINGS
SHEET NO.	DESCRIPTION
1	TITLE SHEET
2	STANDARD PLANS SUMMARY
3	GENERAL NOTES
4	TYPICAL SECTIONS
5 – 11	ROADWAY PLANS
12 – 13	WATER POLLUTION & EROSION
	CONTROL NOTES
14	ROADWAY FEATURES
15	TRAFFIC CONTROL NOTES & LEGEND
16	PAVEMENT MARKINGS, LEGEND,
	DETAILS & NOTES
17	LOOP DETECTORS
18 – 24	PAVEMENT MARKING & STRIPING
	PLANS

Sheet No. O.C.O. 55-1 through C.O. 55-3 and O.C.O.115-1 through C.O.115-5 are supplementary sheets to this project. Total sheet count after "As-Built" posting 32 sheets.

STATE OF HAWAII

DEPARTMENT OF TRANSPORTATION


HIGHWAYS DIVISION HONOLULU, HAWAII

PLANS FOR

NIMITZ HIGHWAY PAVEMENT PREVENTIVE MAINTENANCE


KEEHI INTERCHANGE TO WAIAKAMILO ROAD PROJECT NO. 92A-03-03M

> DISTRICT OF HONOLULU ISLAND OF OAHU

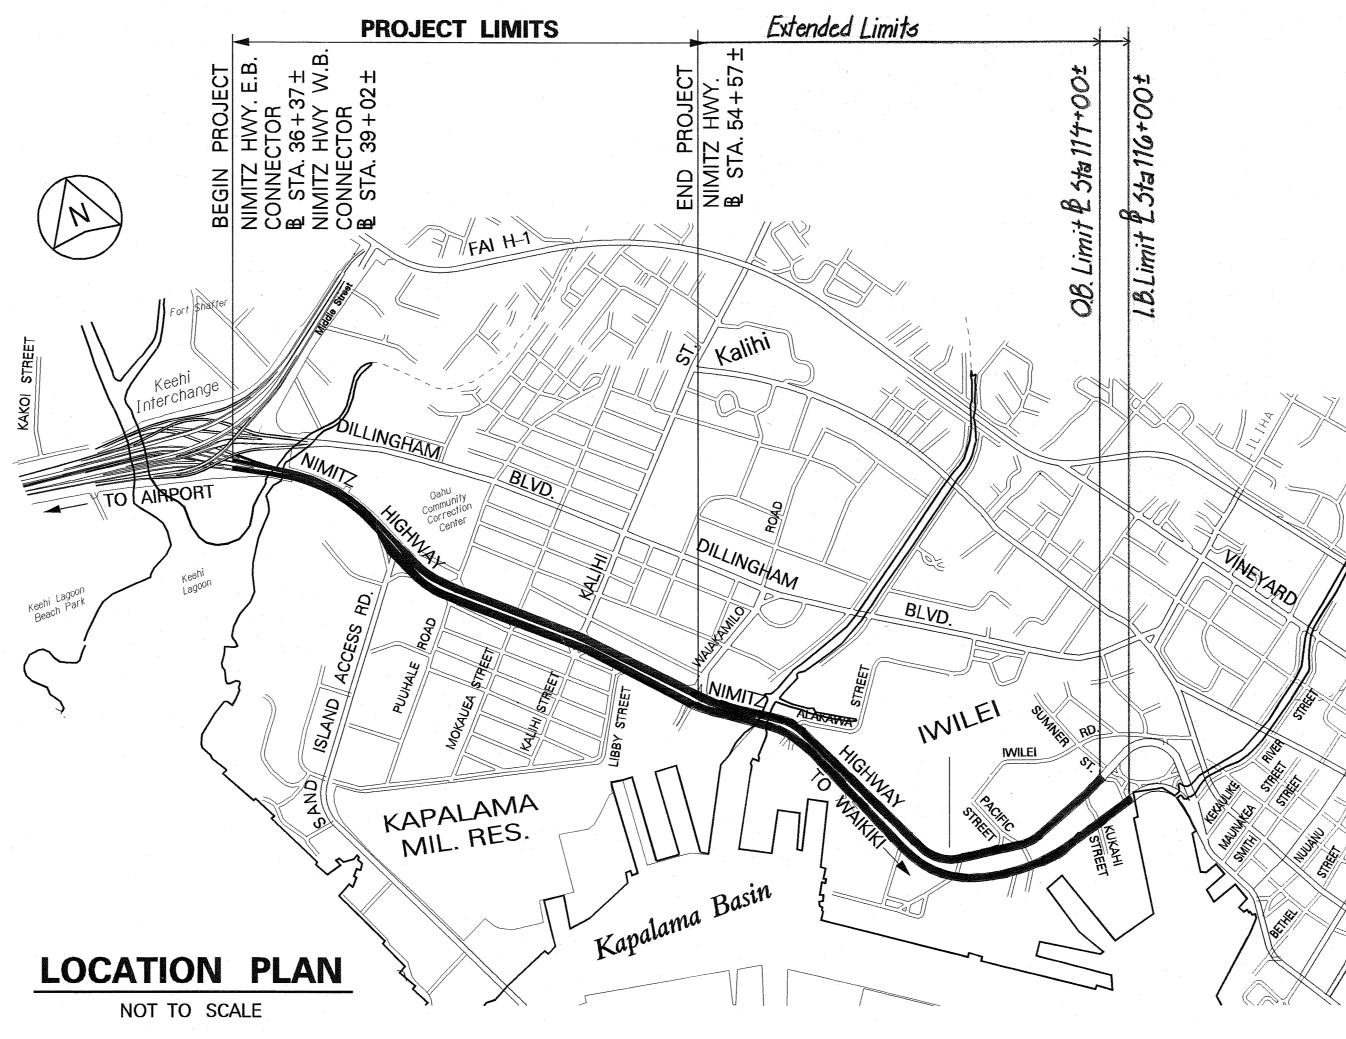

92A-03-03M 2004 STATE OF HAWAII

FED. ROAD DIST. NO.

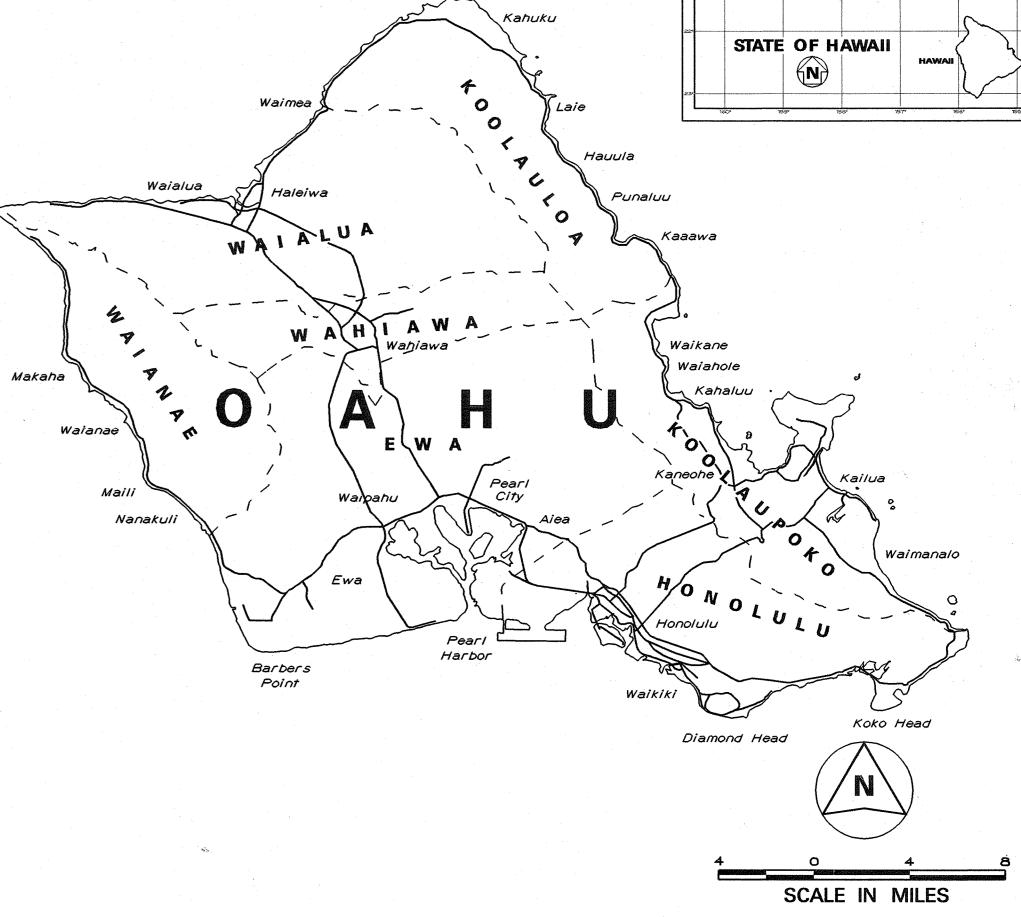

MILE POST 3.57 TO MILE POST 4.68

FISCAL SHEET YEAR NO.

PROJ. NO.

TOTAL SHEETS

Estimated Disturbed Area = 563,500 sq. ft.

DEPARTMENT OF TRANSPORTATION STATE OF HAWAII APPROVED:

5.20.04 LOUIR. OF TRANSPORTATION

DATE