






| FED. ROAD DIST. NO. | STATE | PROJ. NO.   | FISCAL YEAR | SHEET NO. | TOTAL SHEETS |
|---------------------|-------|-------------|-------------|-----------|--------------|
| HAWAII              | HAW.  | 92AB-01-06M | 2006        | C.O.15S-1 | 74           |

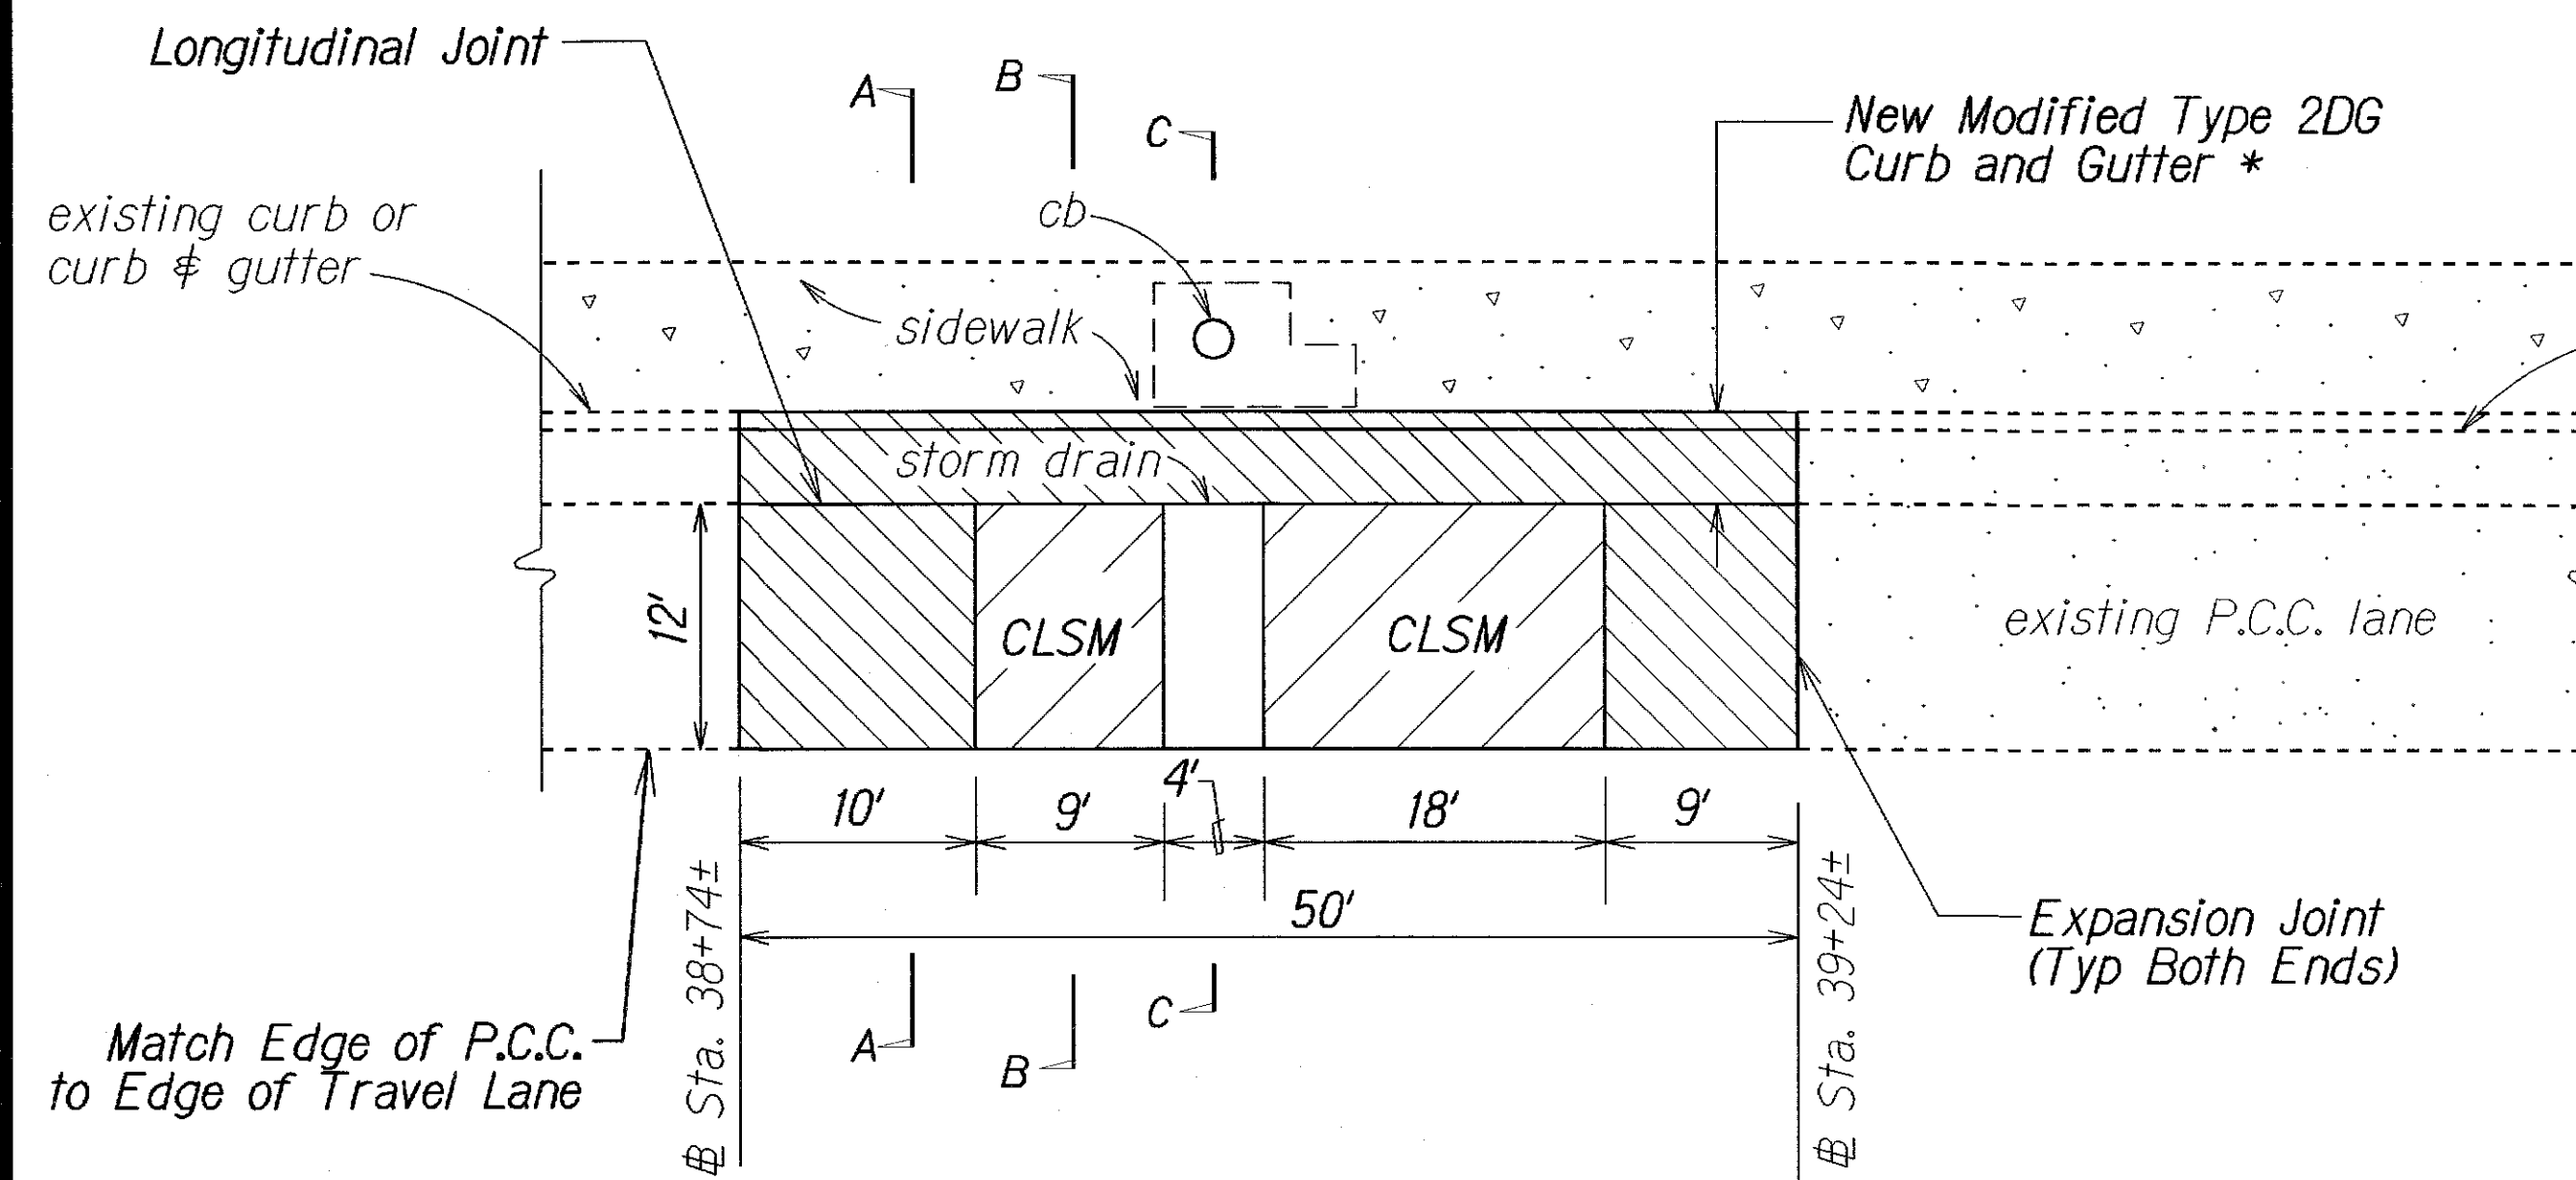


**LAYOUT PLAN FOR P.C.C. LANE RESTORATION**  
**± STA. 38+74±, Lt. TO ± STA. 39+24±, Lt.**  
 Not to Scale  
 Note : For P.C.C. Pavement Restoration, See Details Below.

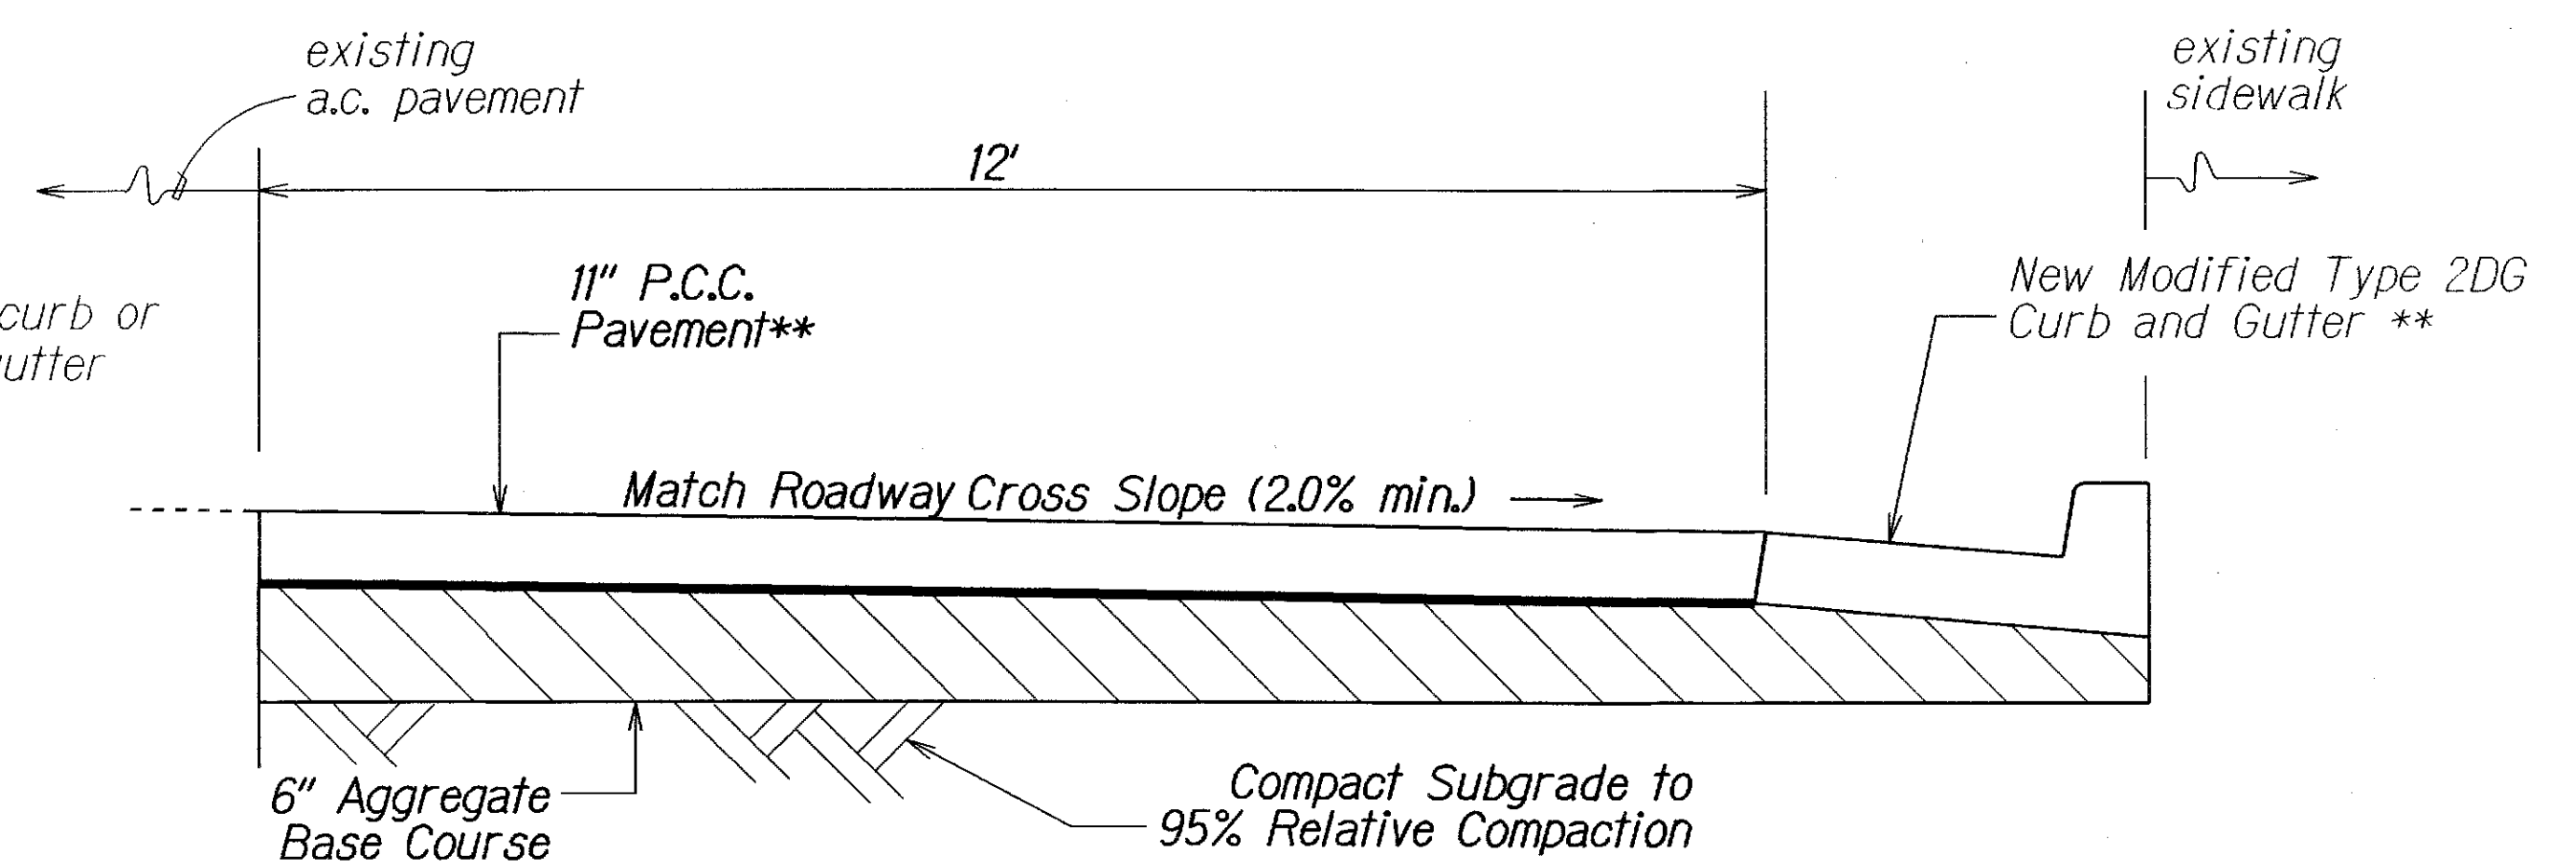

**SECTION A-A**  
**P.C.C. LANE RESTORATION SECTION**  
 Not to Scale

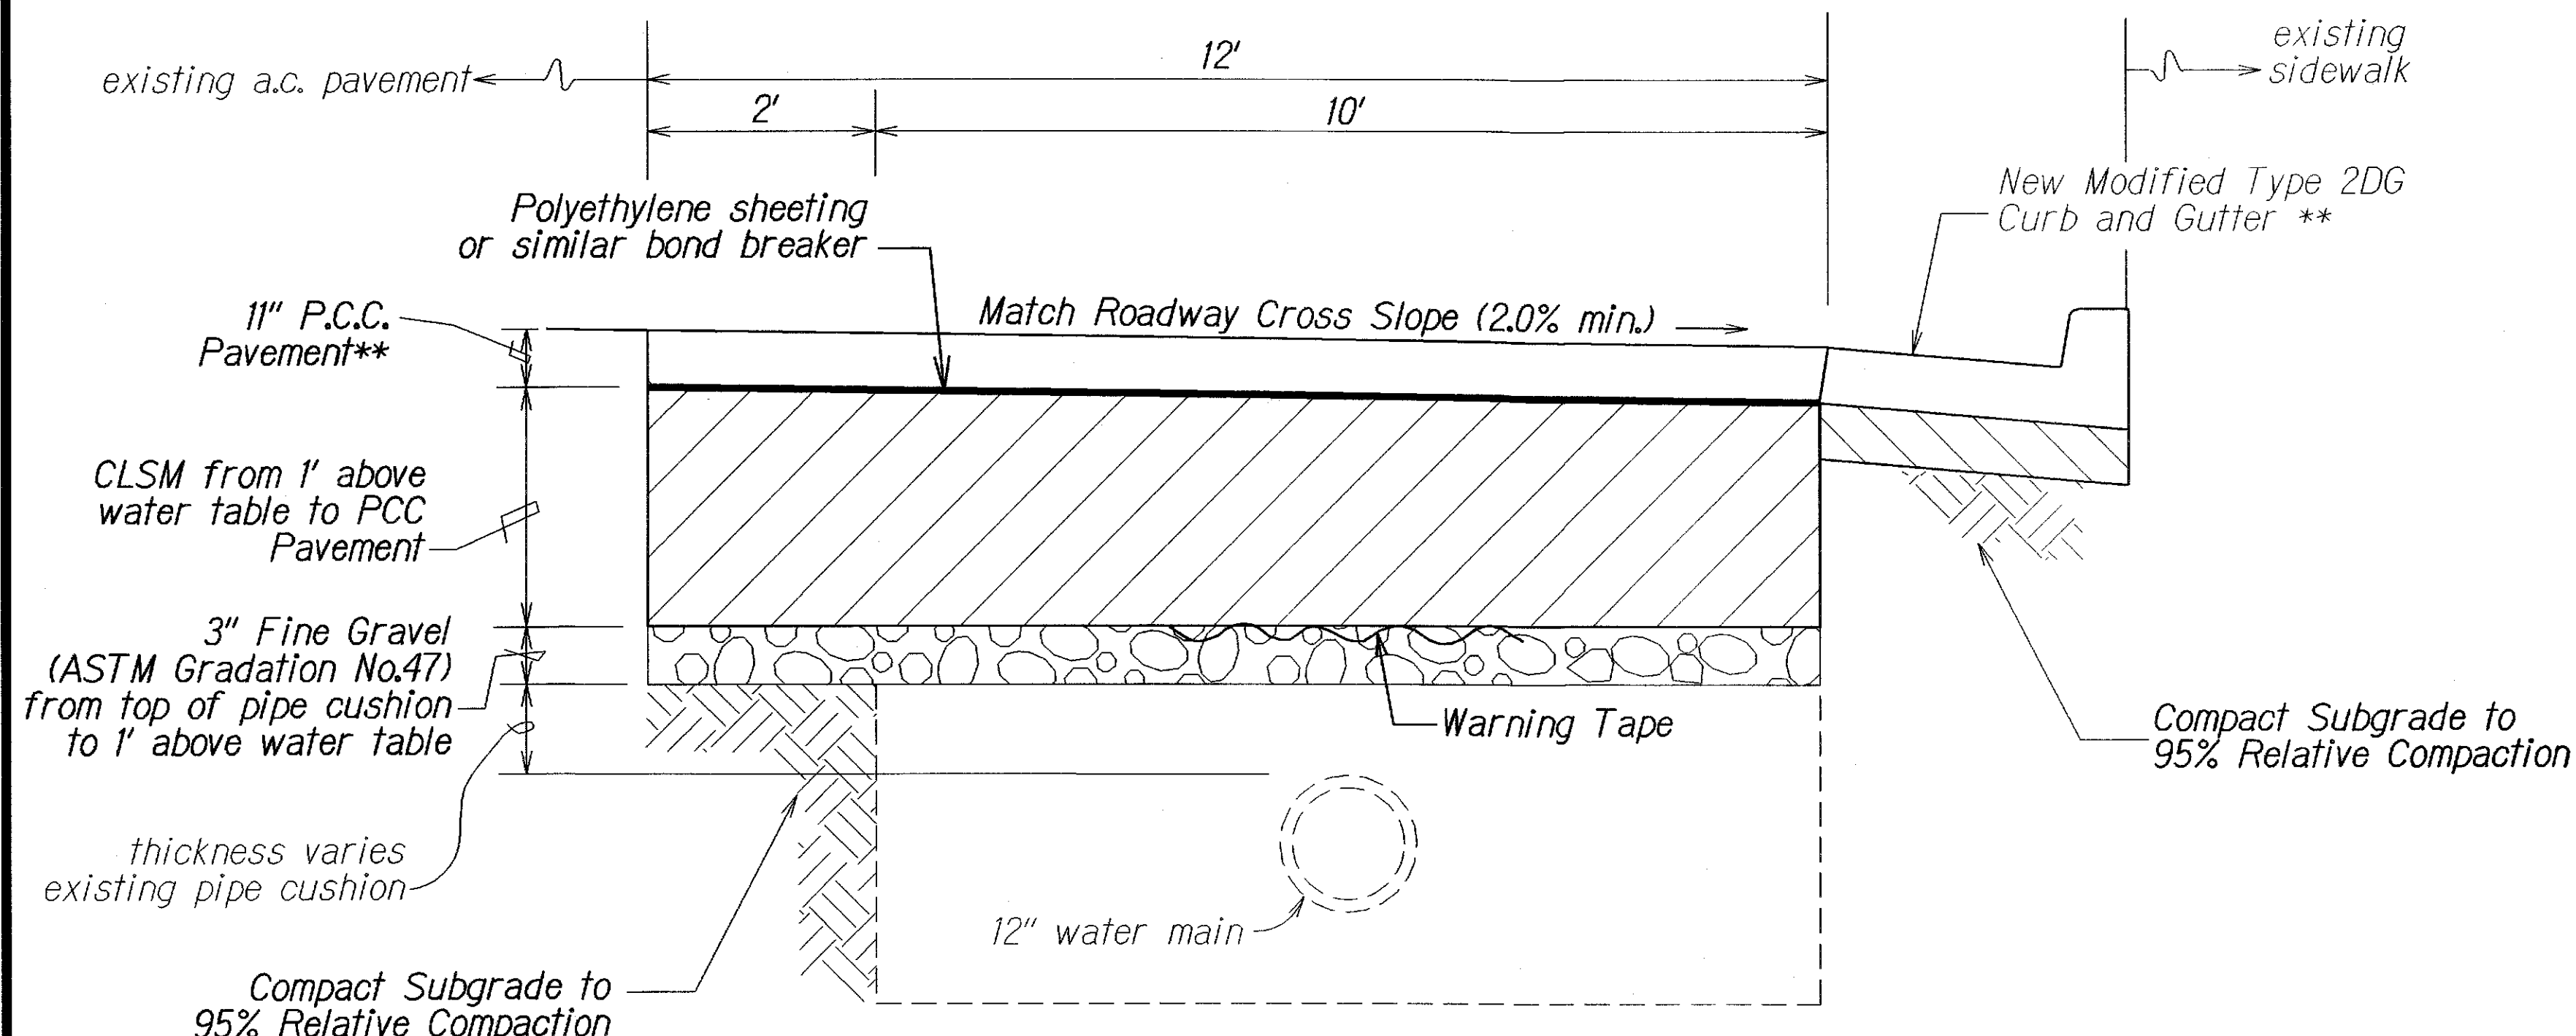

**SECTION B-B**  
**P.C.C. LANE RESTORATION WITH CLSM SECTION**  
 Not to Scale

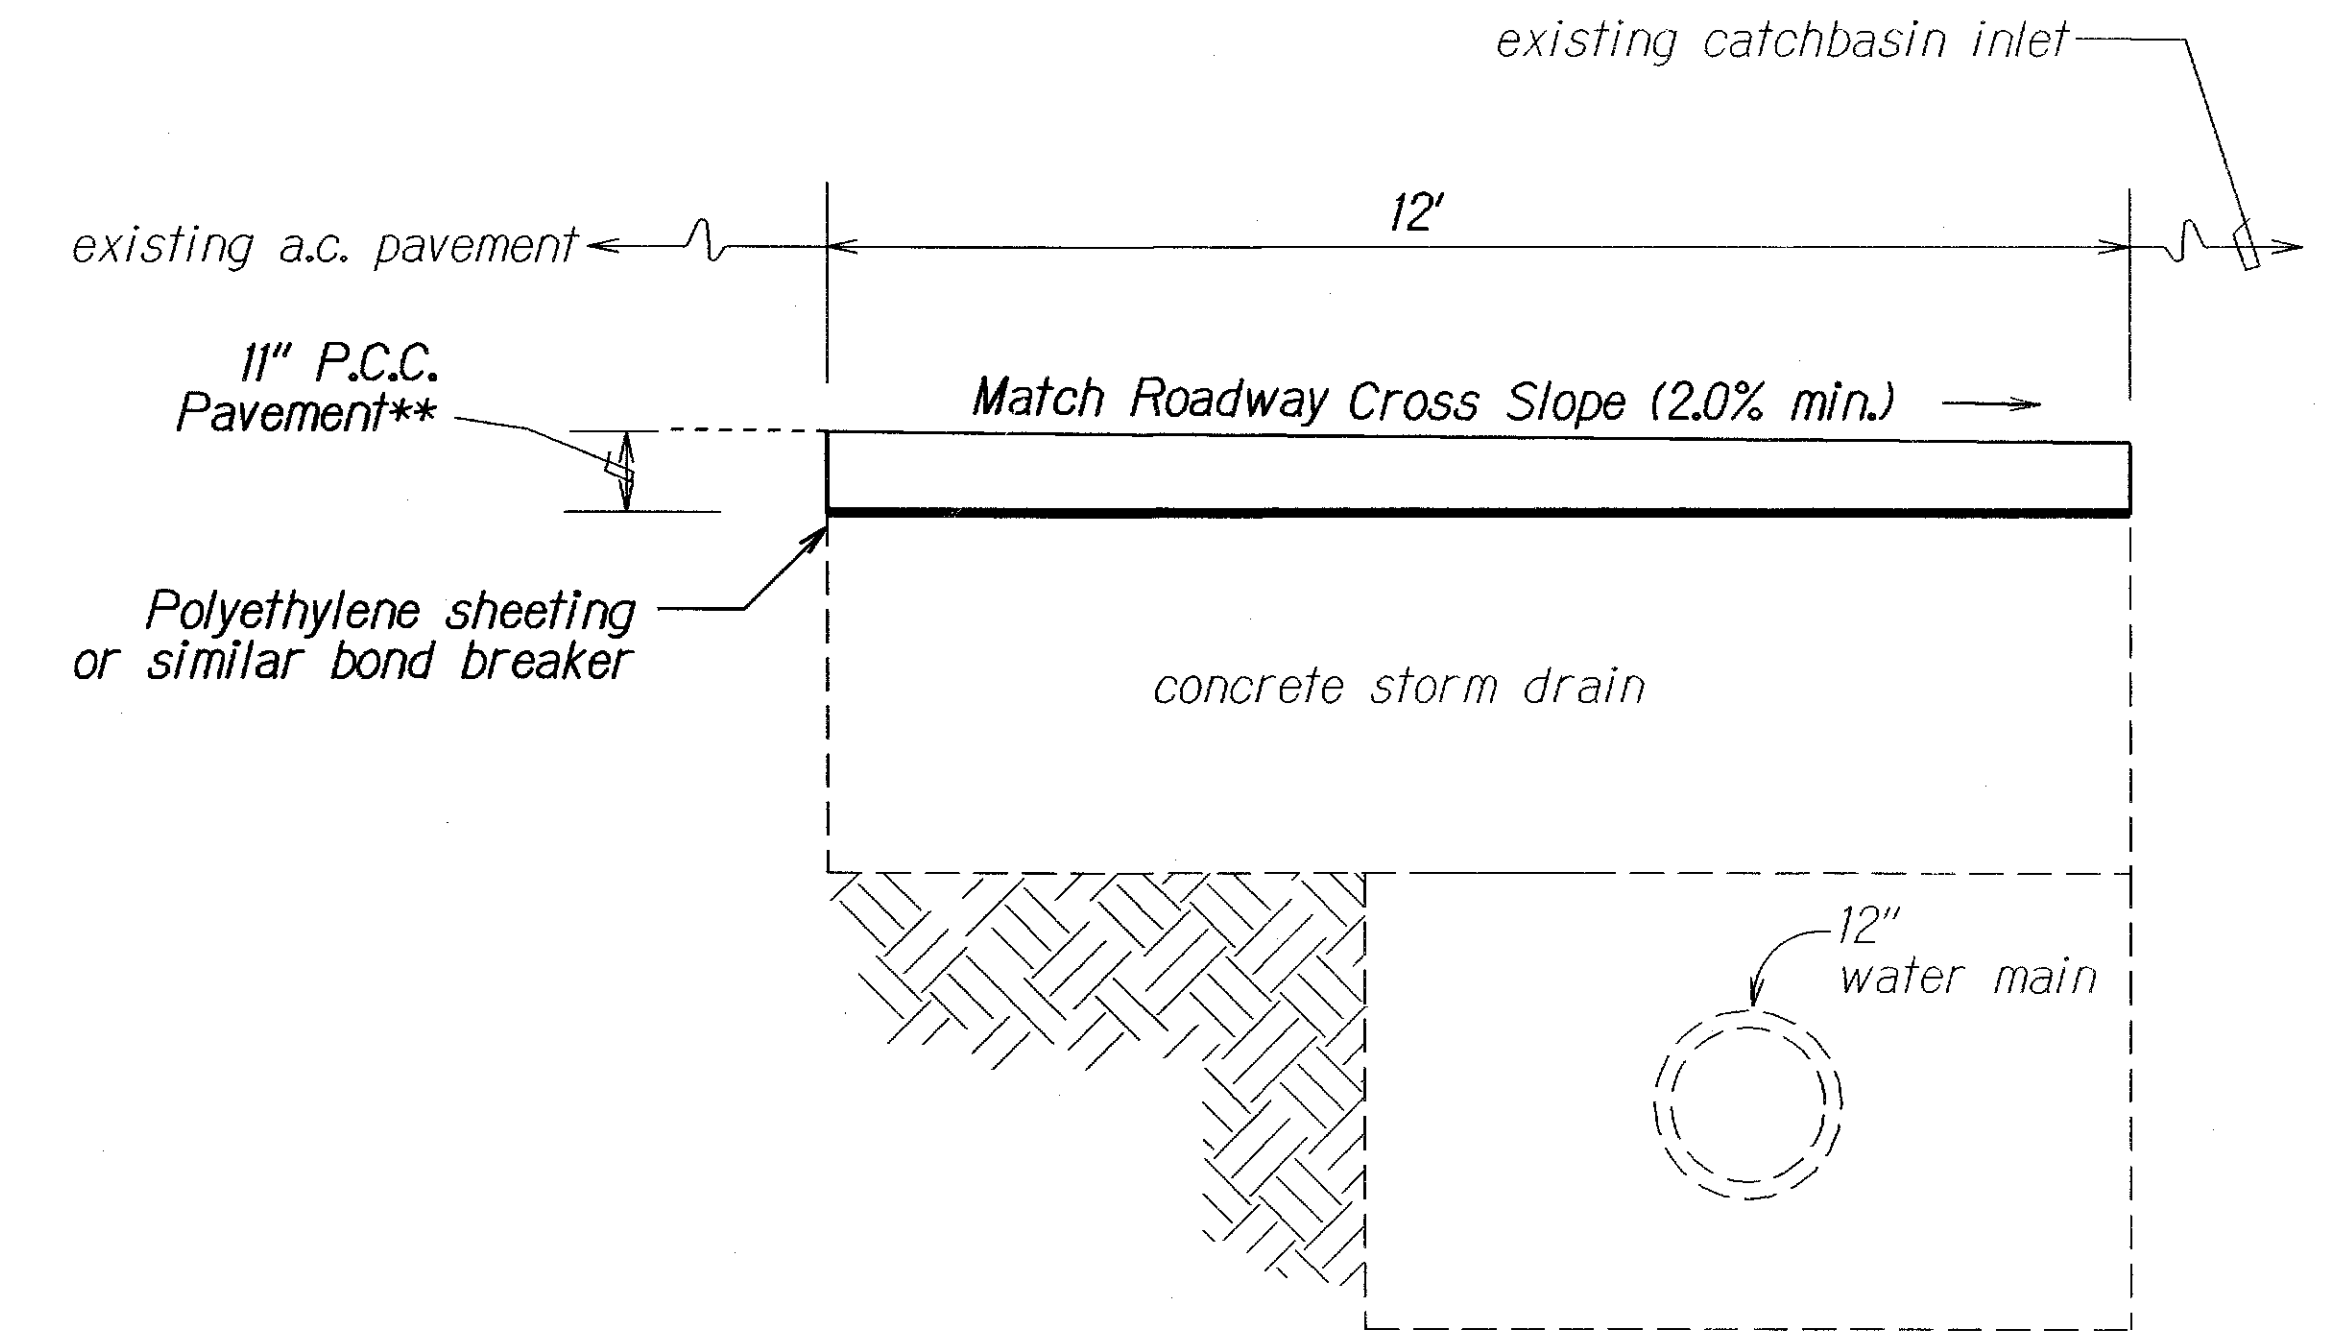

**SECTION C-C**  
**P.C.C. LANE RESTORATION OVER STORM DRAIN SECTION**  
 Not to Scale

|                   |      |
|-------------------|------|
| SURVEY PLOTTED BY | DATE |
| DRAWN BY          |      |
| DESIGNED BY       |      |
| QUANTITIES BY     |      |
| CHECKED BY        |      |

NOTE : \* For Modified Type 2DG Curb and Gutter details, see P.C.C. Bus Pad Pavement Details, Sheet 15  
 \*\* For reinforcement details, see P.C.C. Bus Pad Pavement Details, Sheet 15

| 12/26/06 | This sheet added to contract plans |
|----------|------------------------------------|
| DATE     | REVISION                           |

STATE OF HAWAII  
 DEPARTMENT OF TRANSPORTATION  
 HIGHWAYS DIVISION

**LANE RESTORATION DETAIL**

**NIMITZ HIGHWAY AND  
 ALA MOANA BOULEVARD RESURFACING  
 Fort Street to Piikoi Street**

Project No. 92AB-01-06M  
 Scale: Not to Scale Date: October 2006

SHEET No. 1 OF 1 SHEETS