




FED. ROAD DIST. NO.	STATE	PROJ. NO.	FISCAL YEAR	SHEET NO.	TOTAL SHEETS
HAWAII	HAW.	92AB-01-06M	2006	11	74

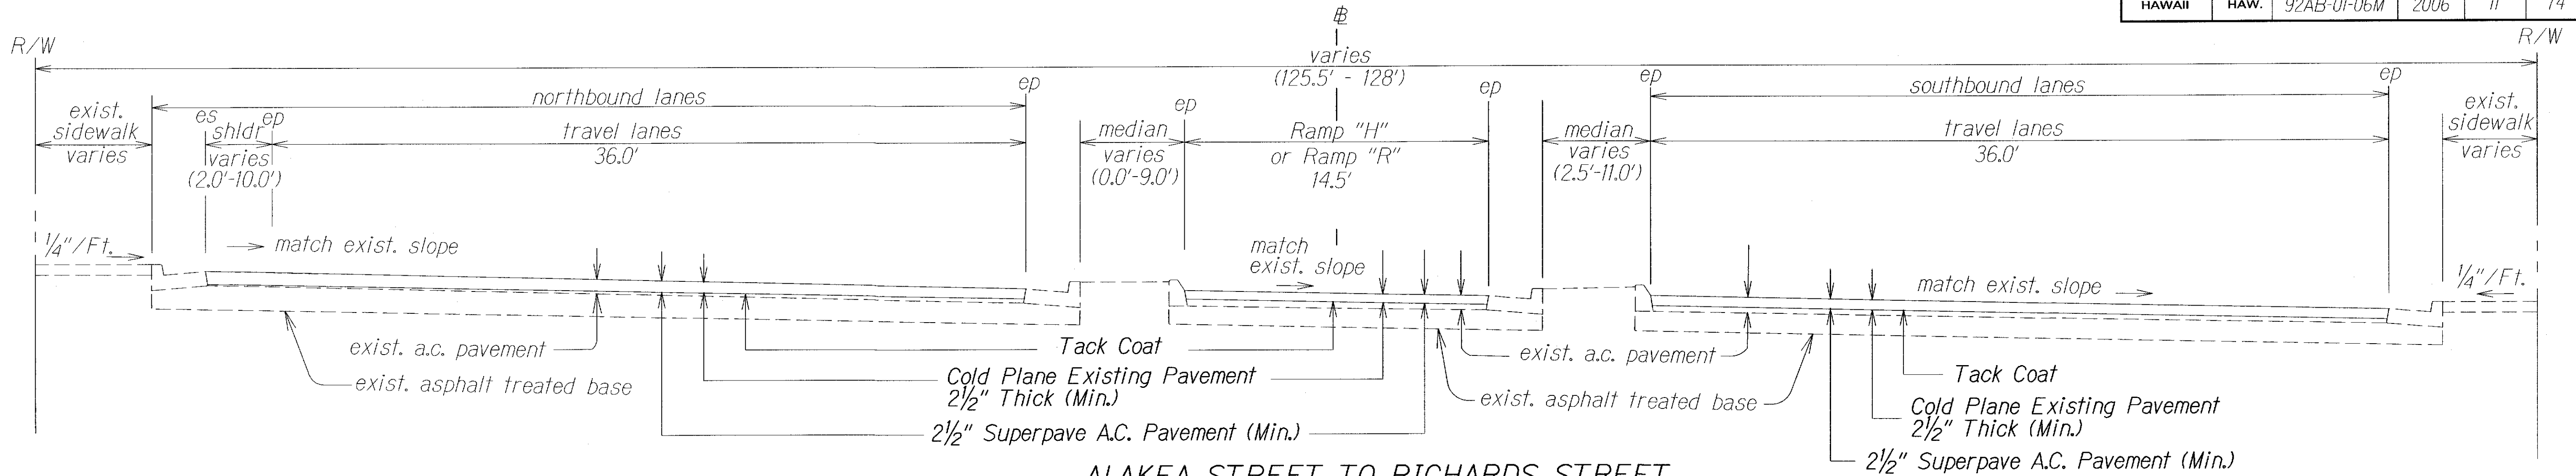

ALAKEA STREET TO RICHARDS STREET
P.C. # STA. 148+79.32 TO P.T. # STA. 153+58.27
Not to Scale

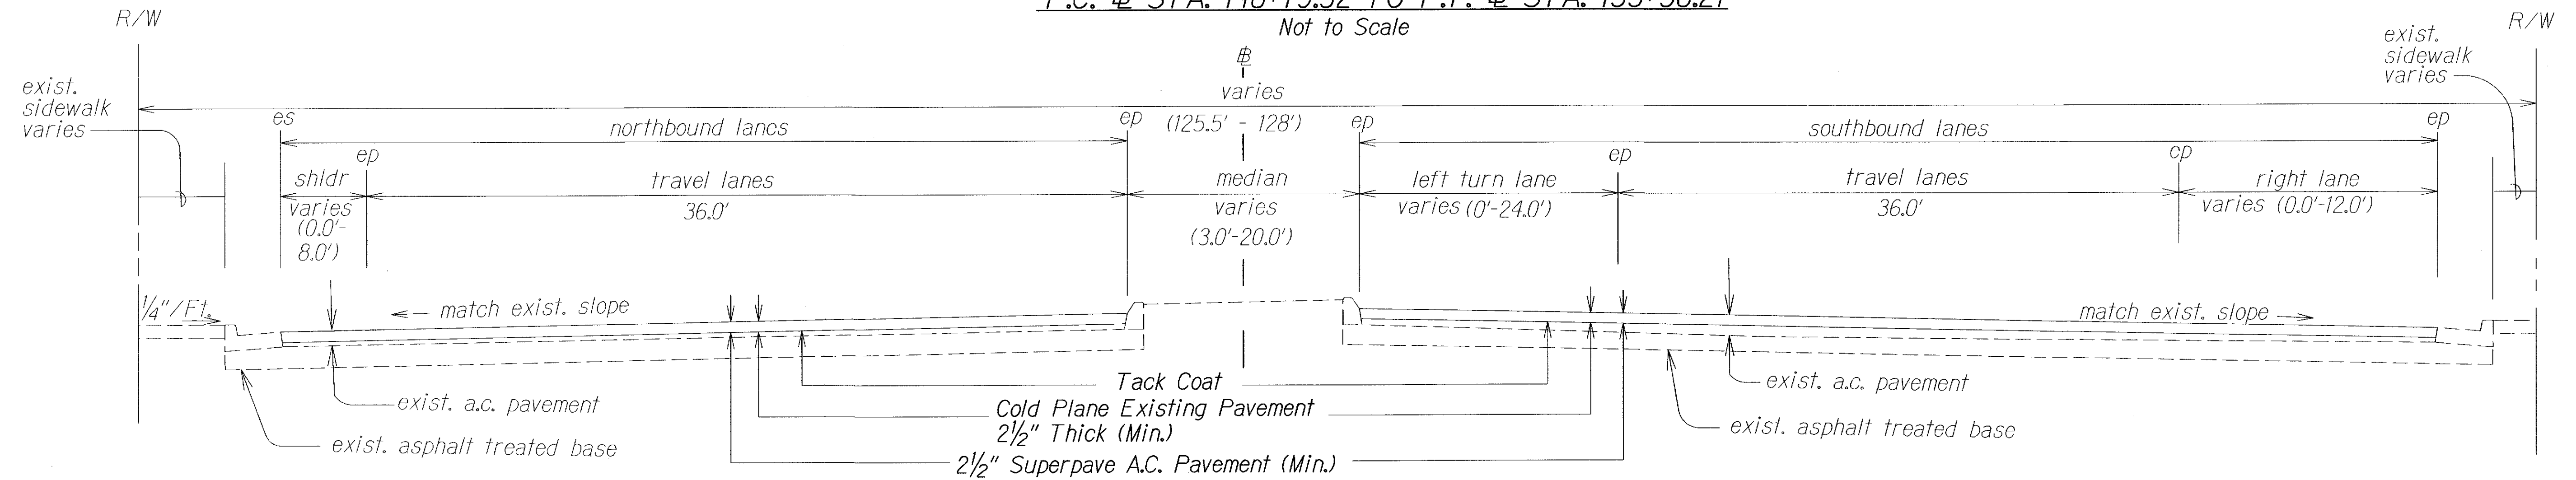


FORT STREET TO ALAKEA STREET
IB # STA. 137+50/OB # STA. 138+00 TO P.C. # STA. 148+79.32
Not to Scale

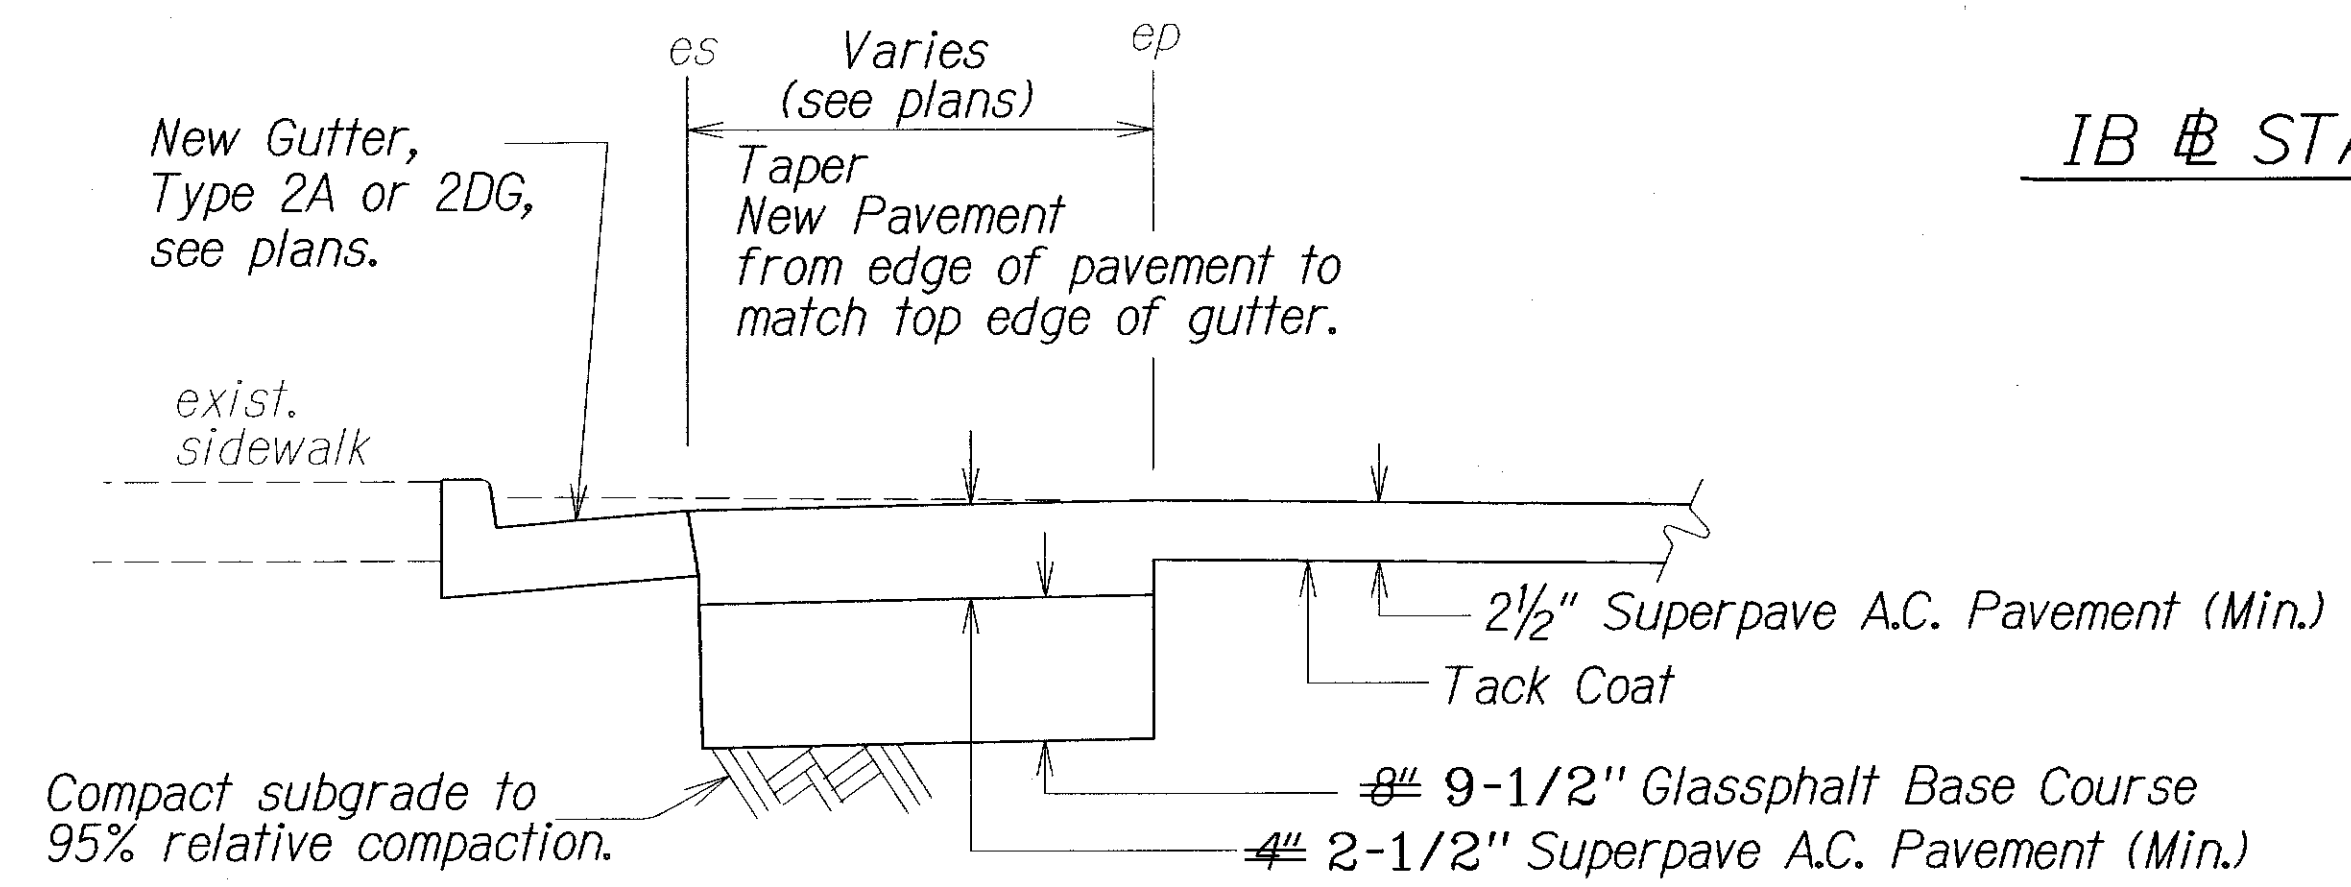

PARTIAL TYPICAL SECTION FOR A.C. OVER GUTTER
(For Reconstruction Areas Where Existing A.C. is Higher Than Gutter)
Not to Scale

NOTE:

1. Removal of existing a.c. pavement over gutter shall be considered incidental to various contract items.
2. Location of Gutter Overlayed With A.C. Pavement Shall Be Verified in the Field by the Contractor. Use partial typical for # Sta 17+01± Lt to # Sta 17+08± Lt, # Sta 17+91± Lt to # Sta 19+57± Lt, # Sta 21+09± Lt to # Sta 21+46± Lt, # Sta 34+40± Rt to # Sta 40+45± Rt. This Work Shall Considered Incidental to Various Contract Items.
3. See Roadway Plans for Location of Replaced Cracked Curb and Gutter.

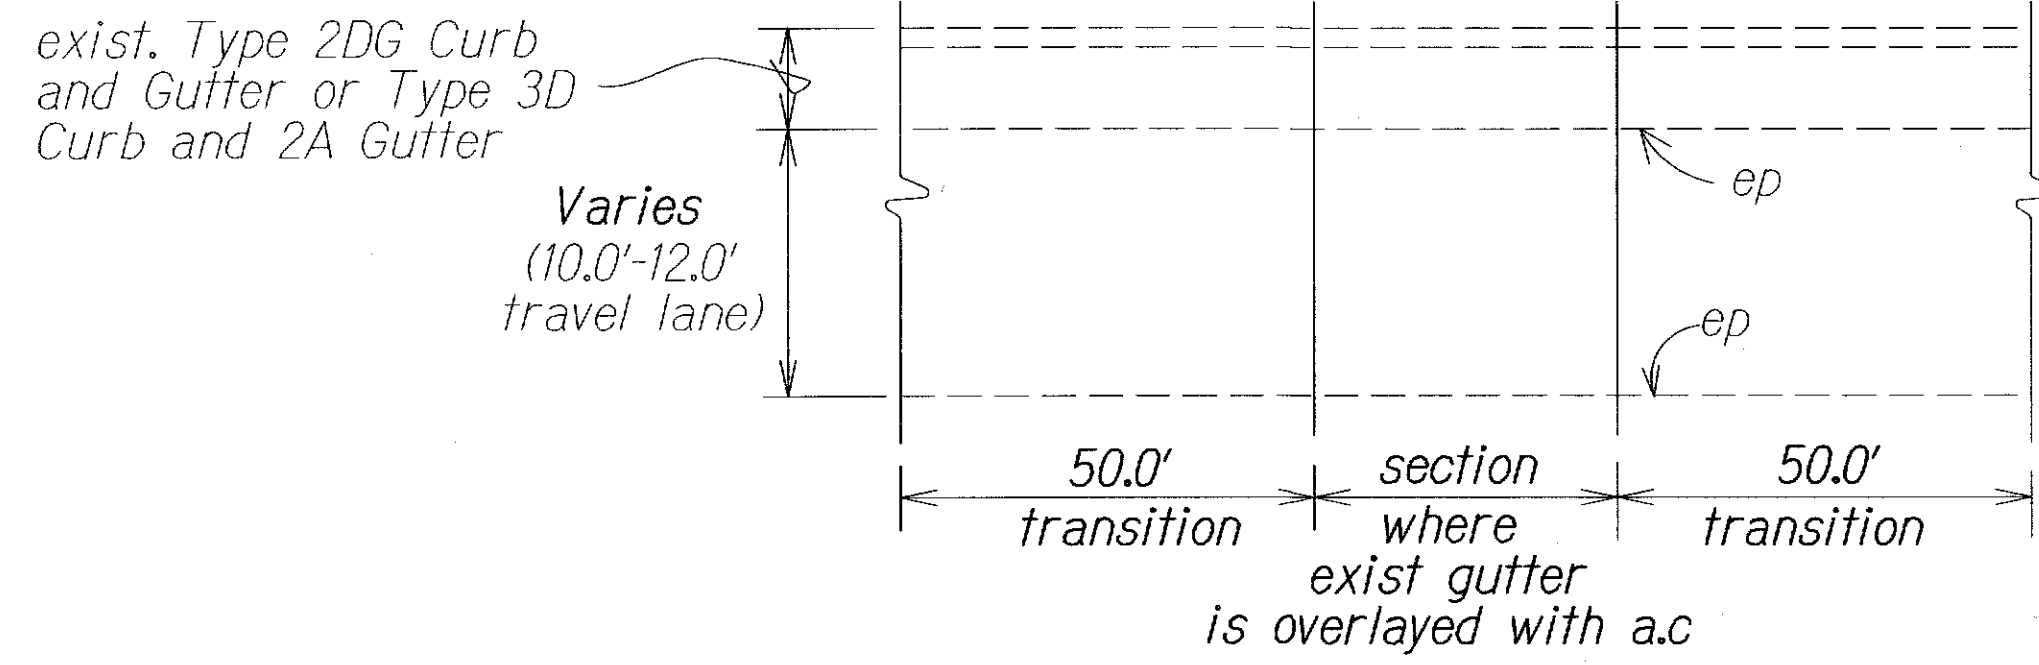

(For detail, see Partial Typical Section for A.C. Over Gutter)

LONGITUDINAL TRANSITION

(For Reconstruction Areas With Existing A.C. is Higher Than Gutter)

Not to Scale

LEGEND FOR AS-BUILT POSTINGS	
	Squiggly line for as-built deletion
	Double line for as-built deletion
	Text for as-built posting

STATE OF HAWAII
DEPARTMENT OF TRANSPORTATION
HIGHWAYS DIVISION


TYPICAL SECTION
NIMITZ HIGHWAY AND
ALA MOANA BOULEVARD RESURFACING
Fort Street to Piikoi Street
Project No. 92AB-01-06M

Scale: Not to Scale Date: April 2006


SHEET No. 1 OF 4 SHEETS

"AS-BUILT"

FED. ROAD DIST. NO.	STATE	PROJ. NO.	FISCAL YEAR	SHEET NO.	TOTAL SHEETS
HAWAII	HAW.	92AB-01-06M	2006	12	74

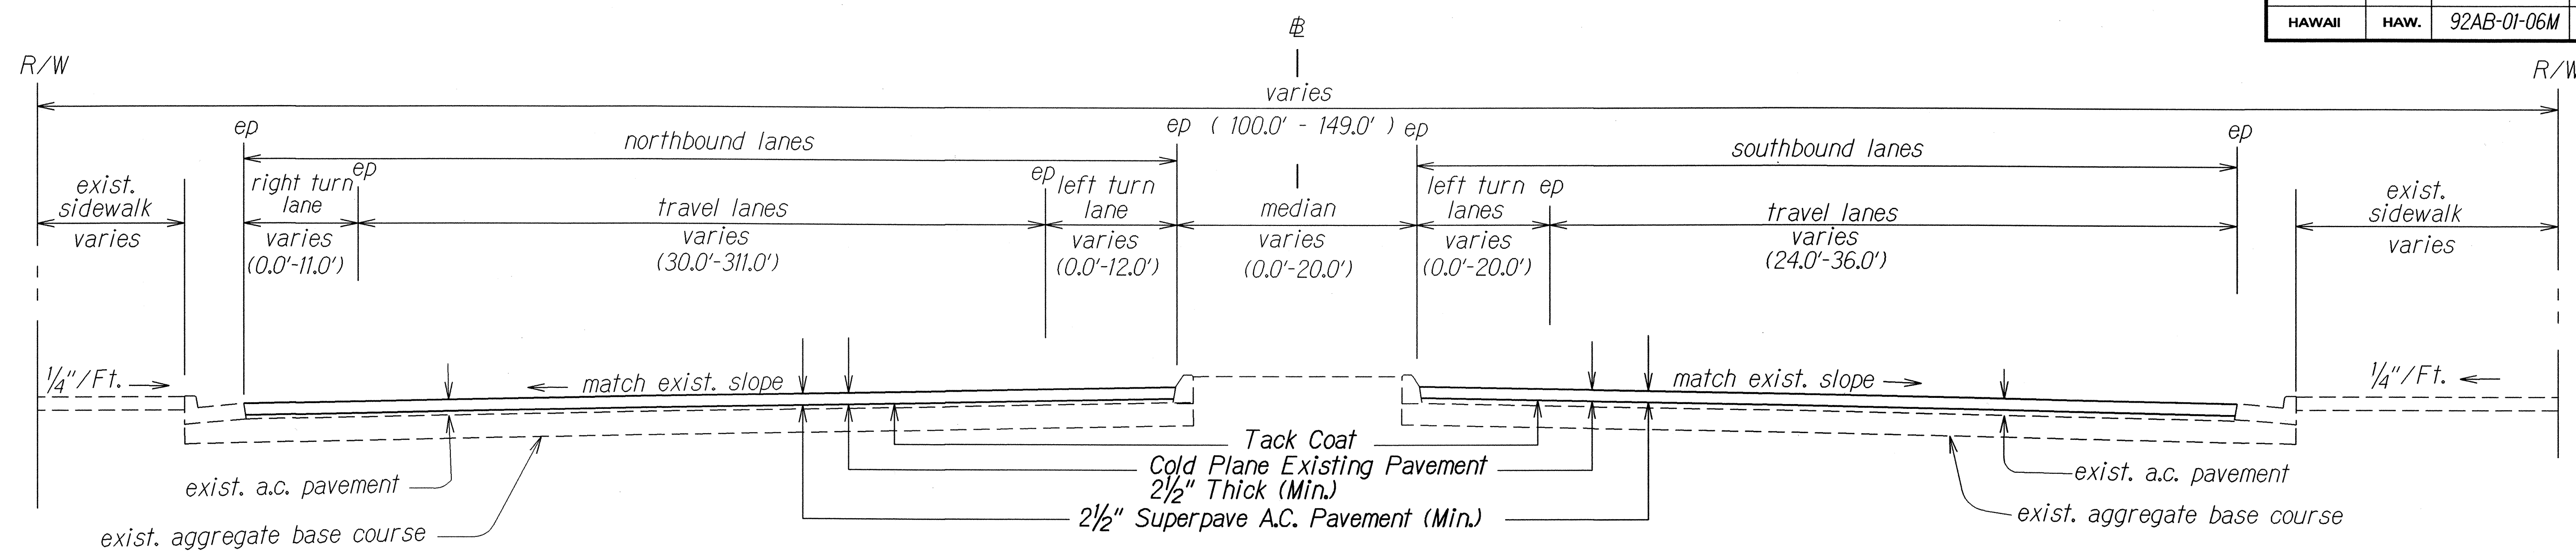


TANGENT SECTION
Not to Scale

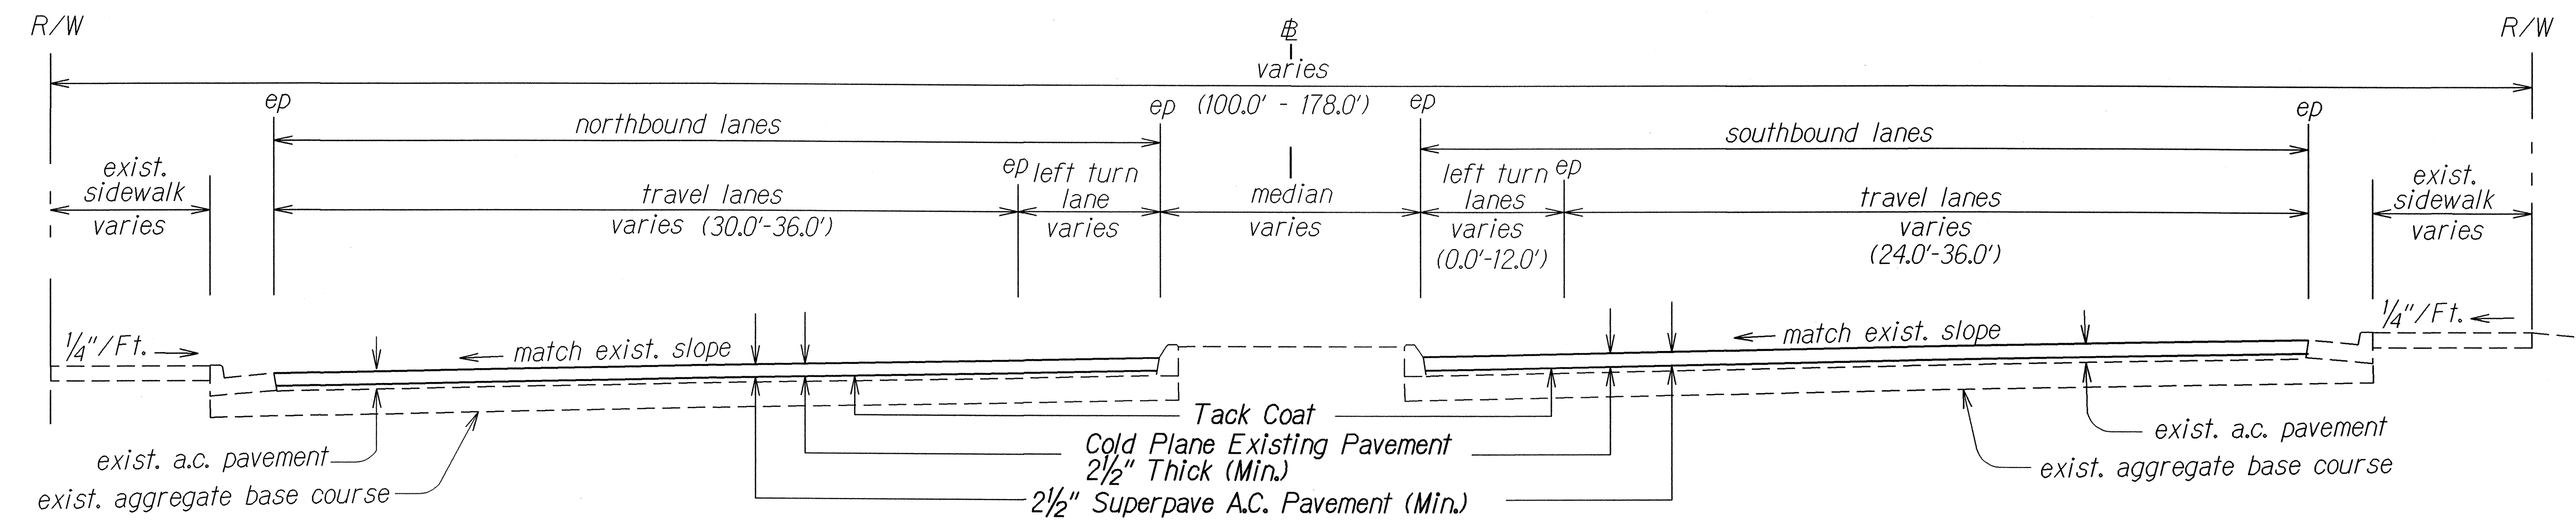


SUPERELEVATED SECTION
Not to Scale

NOTE:
For I.B. $\pm$ O.B. Sta. 162+50 $\pm$ to I.B. $\pm$ O.B. Sta. 25+20 $\pm$ - Cold Plane 5" and Pave with 5" of Superpave A.C. Pavement.

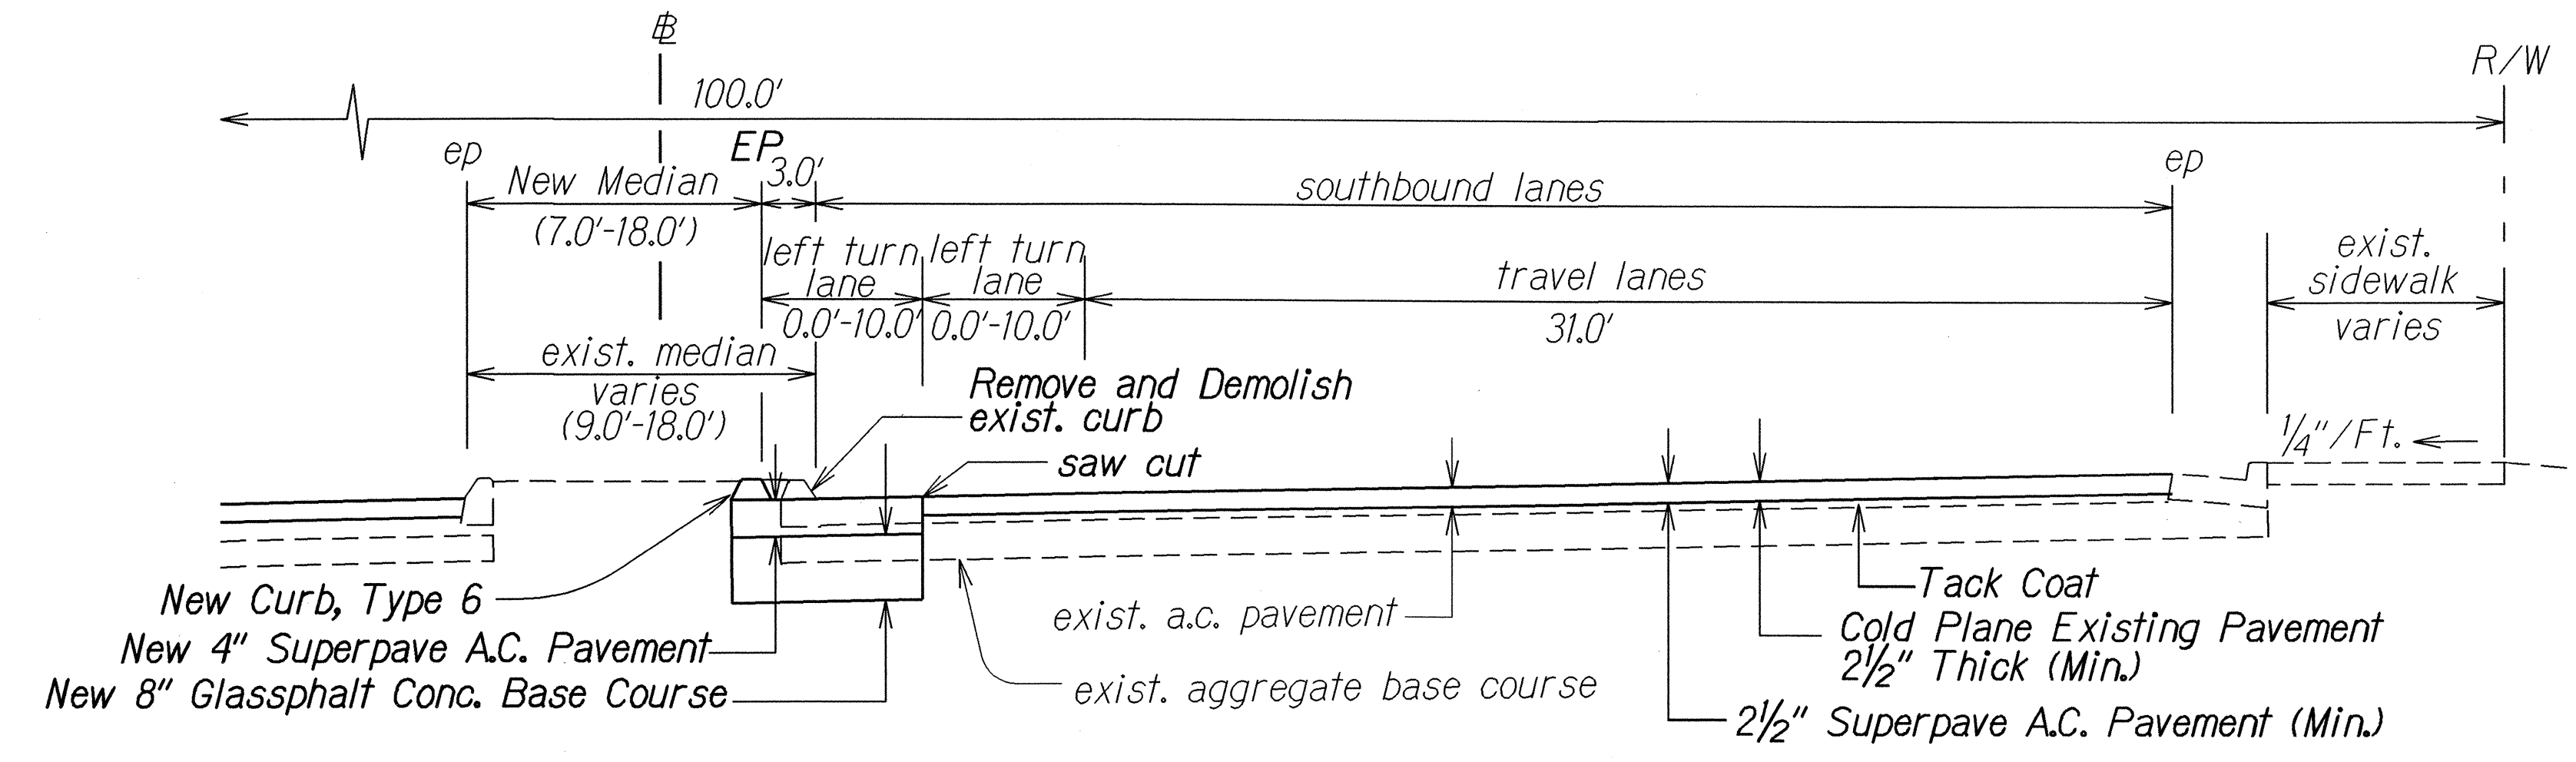

PARTIAL TYPICAL SECTION
Sta. 32+37.07 - Sta. 37+13.37
Not to Scale

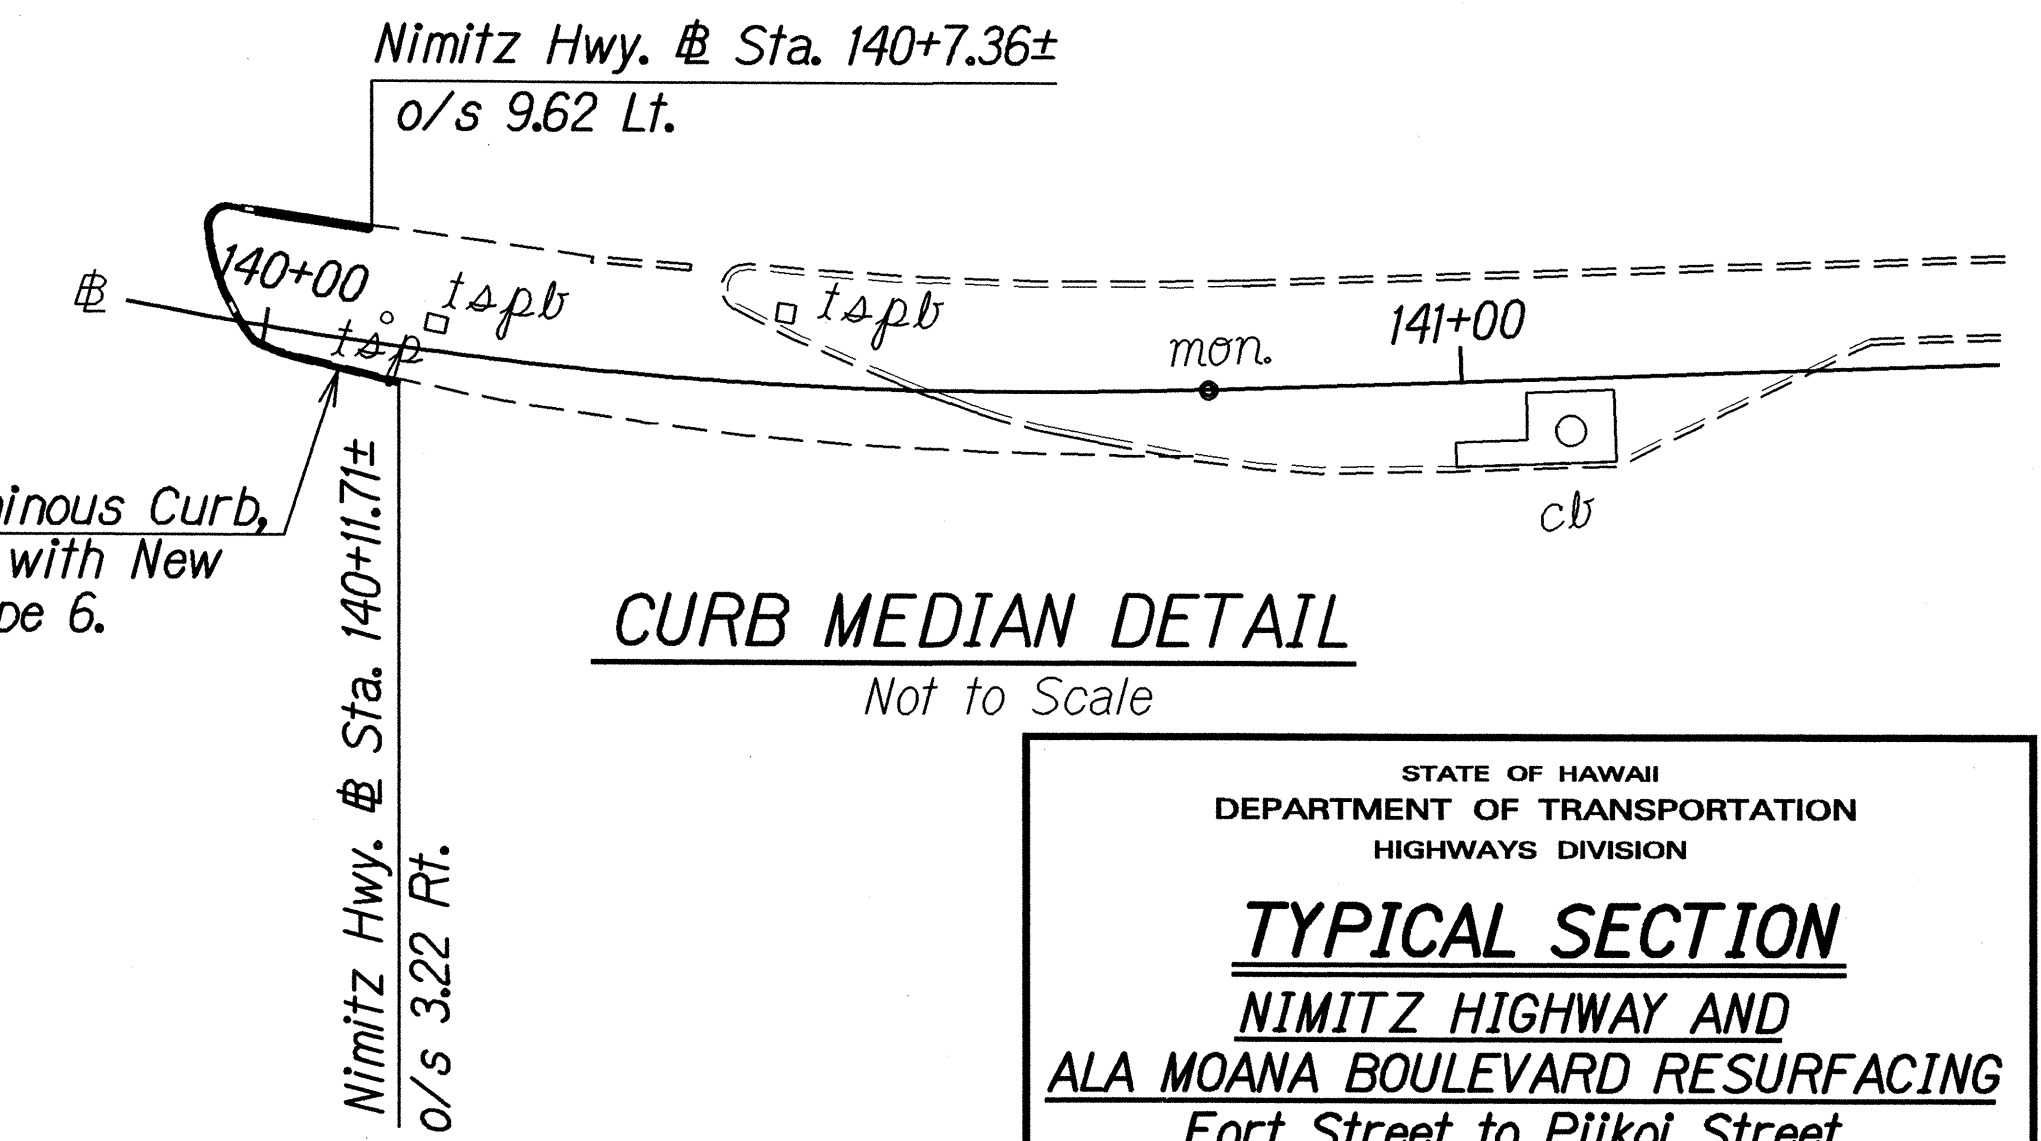

CURB MEDIAN DETAIL
Not to Scale

STATE OF HAWAII

DEPARTMENT OF TRANSPORTATION

HIGHWAYS DIVISION

TYPICAL SECTION

NIMITZ HIGHWAY AND

ALA MOANA BOULEVARD RESURFACING

Fort Street to Piikoi Street

Project No. 92AB-01-06M


Scale: Not to Scale

Date: April 2006


SHEET No. 2 OF 4 SHEETS

ORIGINAL PLAN	SURVEY PLOTTED BY	DATE
NOTE BOOK	DRAWN BY	
006.en.Sampd	DESIGNED BY	
Samd02.dgn	CHECKED BY	


FED. ROAD DIST. NO.	STATE	PROJ. NO.	FISCAL YEAR	SHEET NO.	TOTAL SHEETS
HAWAII	HAW.	92AB-01-06M	2006	13R	74

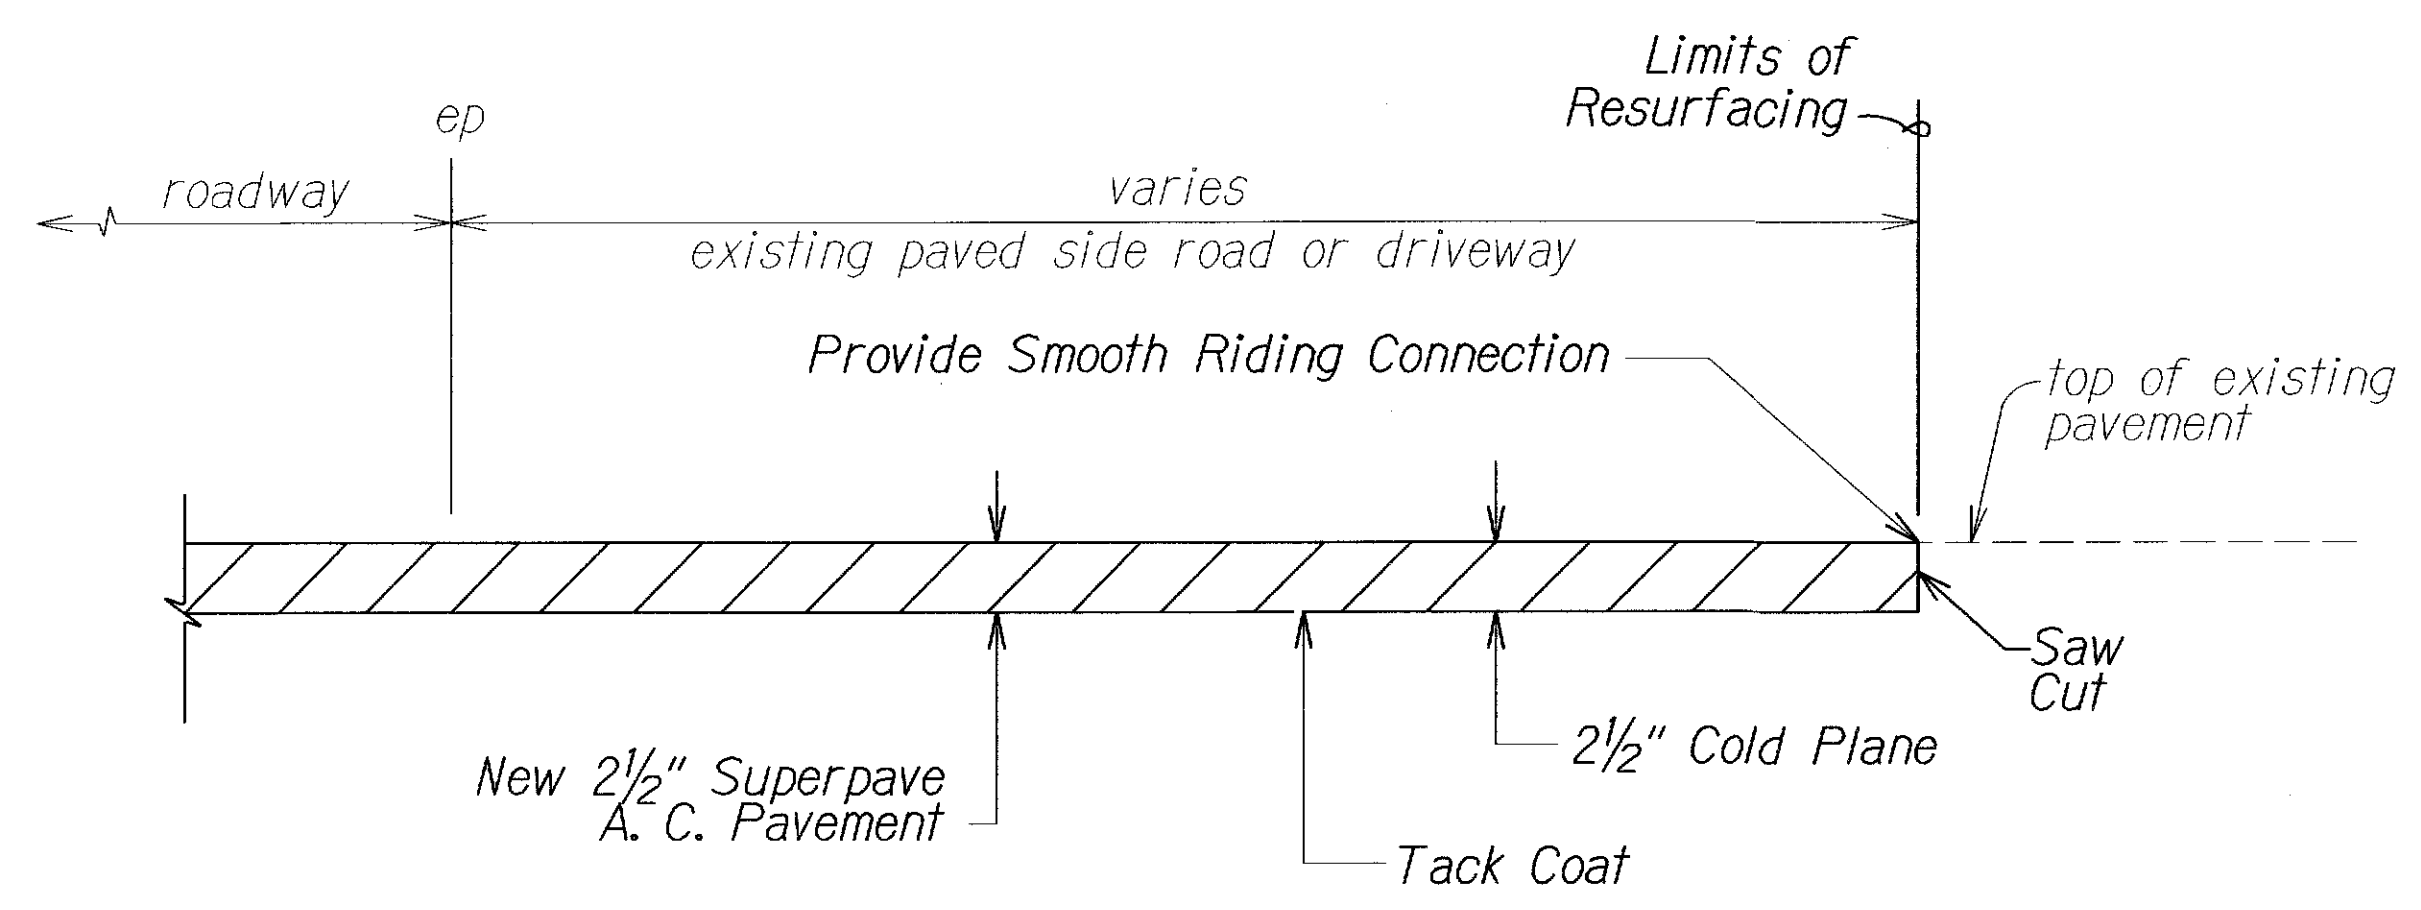


A.C. RESURFACING AT PAVED SIDE ROAD
OR PAVED DRIVEWAY DETAIL
Not to Scale

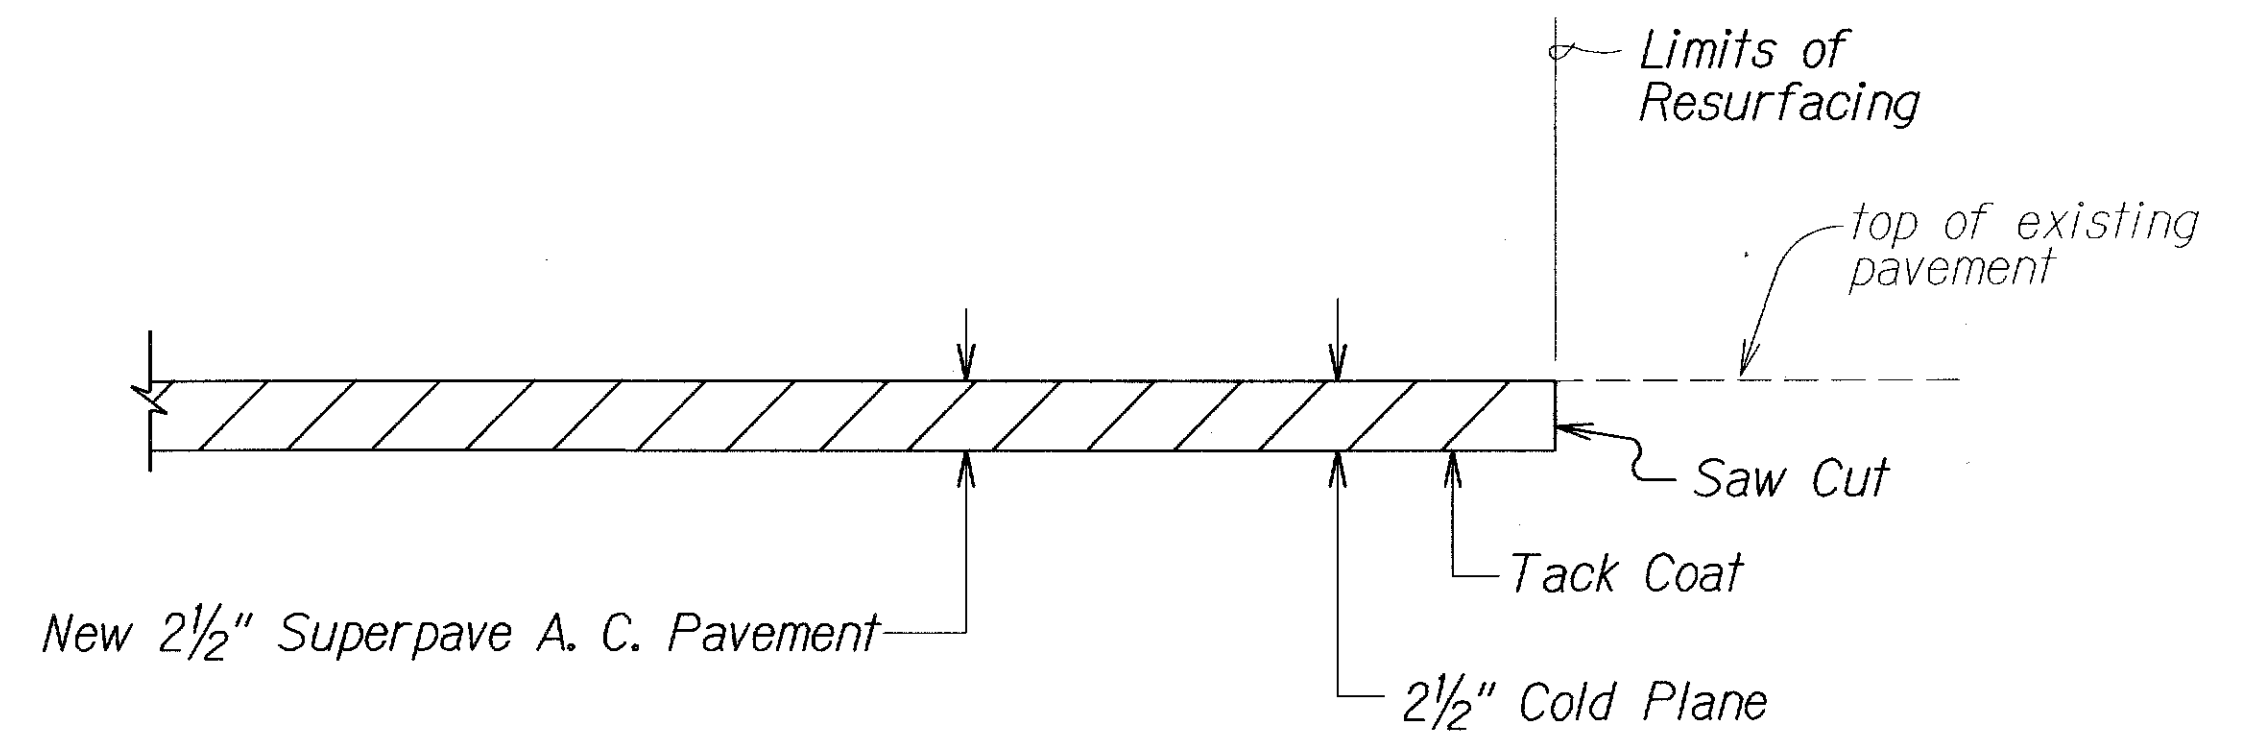


TRANSITION TO EXISTING A.C. PAVEMENT
BEGIN AND END PROJECT
Not to Scale

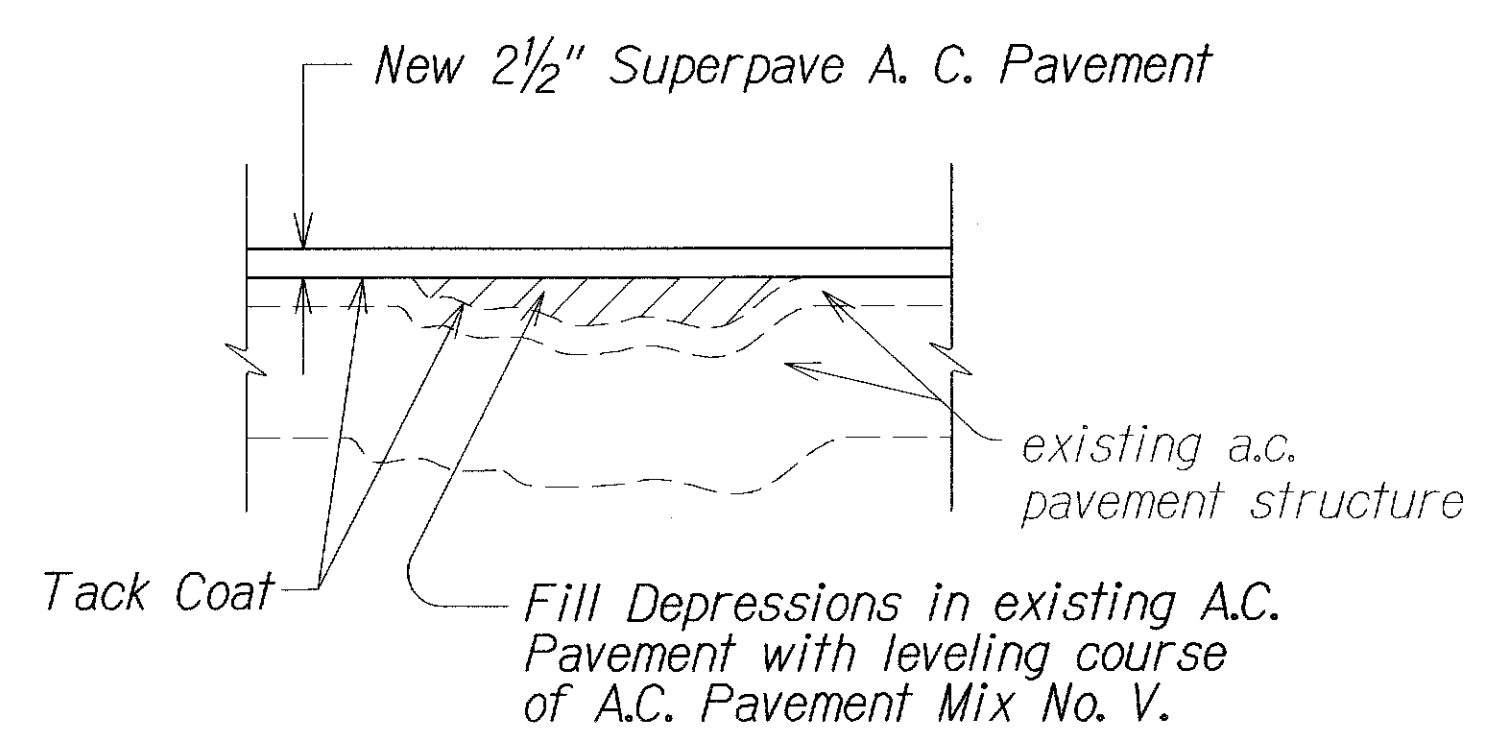

LEVELING COURSE DETAIL
Not To Scale

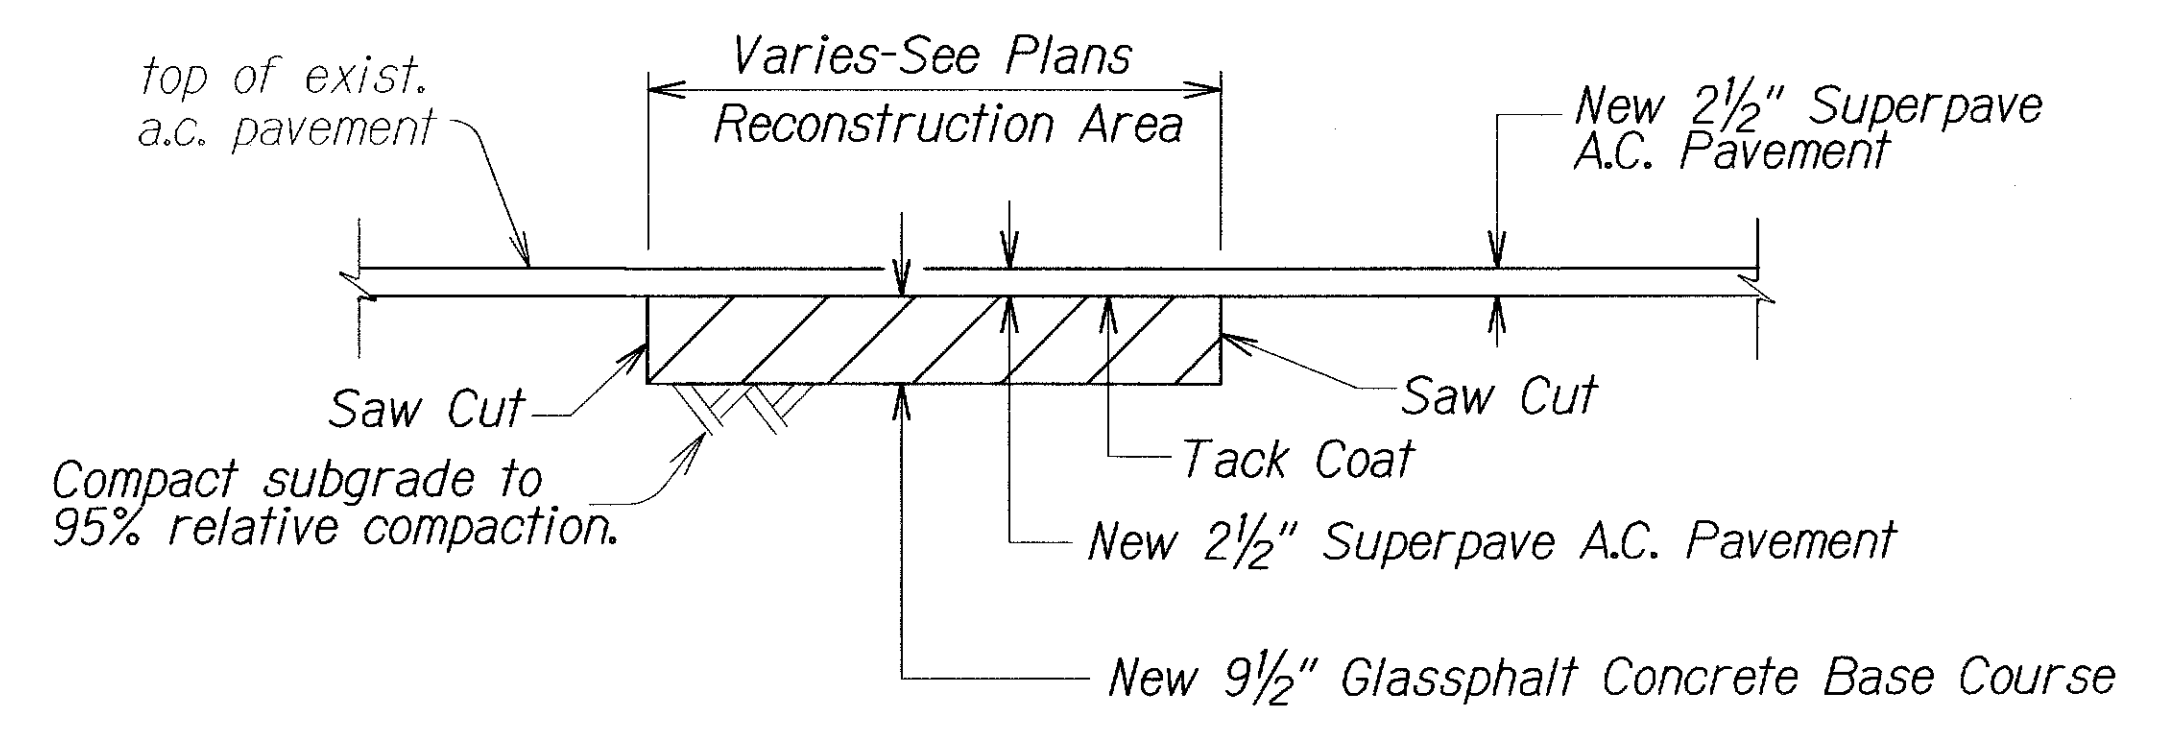

A.C. PAVEMENT RECONSTRUCTION DETAIL
Not to Scale

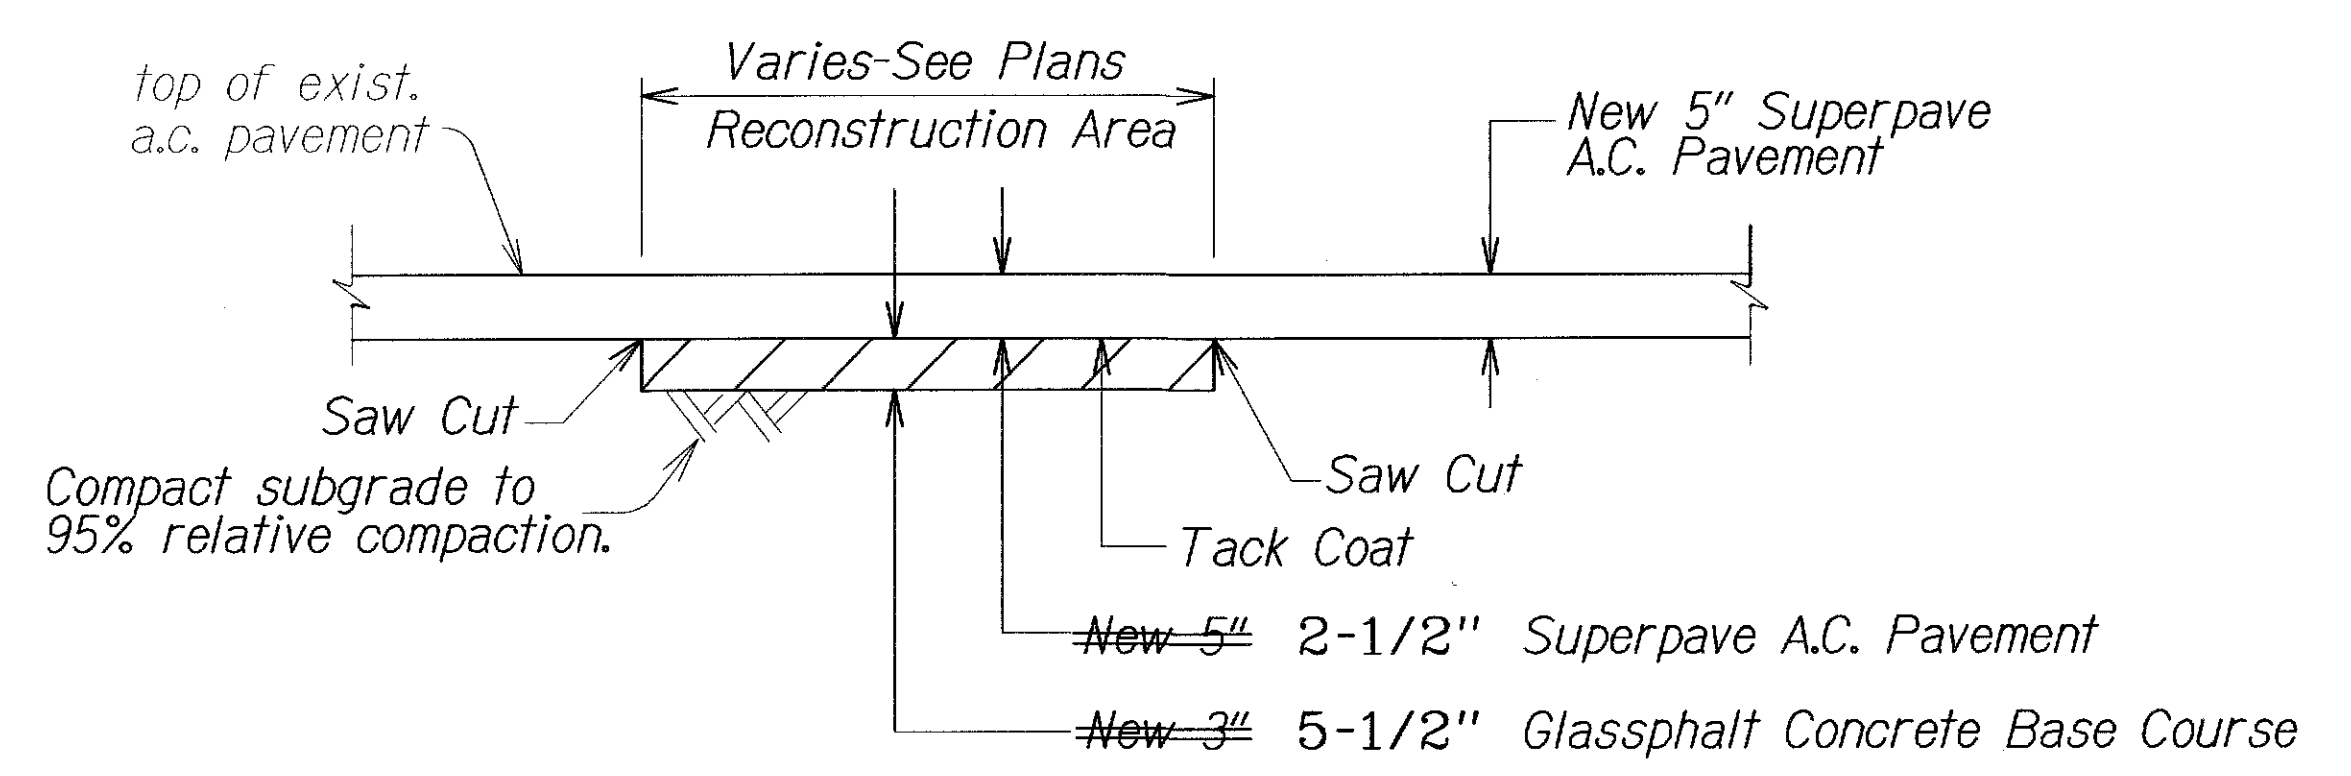


A.C. PAVEMENT RECONSTRUCTION DETAIL
FOR RECONSTRUCTION AREAS BETWEEN IB & OB @STA. 162+50± and IB & OB @STA. 25+20±
Not to Scale

LEGEND FOR AS-BUILT POSTINGS	
AAA	Squiggly line for as-built deletion
100.00	Double line for as-built deletion
Roadway	Text for as-built posting


5/30/06	Revised Details.
DATE	REVISION
STATE OF HAWAII DEPARTMENT OF TRANSPORTATION HIGHWAYS DIVISION	
TYPICAL DETAILS	
NIMITZ HIGHWAY AND ALA MOANA BOULEVARD RESURFACING Fort Street to Piikoi Street Project No. 92AB-01-06M	
Scale: Not to Scale	Date: April 2006
SHEET No. 3 OF 4 SHEETS	

SURVEY PLOTTED BY	DATE
DRAWN BY	
TRACED BY	
CHECKED BY	
QUANTITIES BY	
CHECKED BY	
ORIGINAL PLAN	
NOTE BOOK	
gdb:jmd:rev	
gdb:jmd:rev	


FED. ROAD DIST. NO.	STATE	PROJ. NO.	FISCAL YEAR	SHEET NO.	TOTAL SHEETS
HAWAII	HAW.	92AB-01-06M	2006	ADD. 14	74

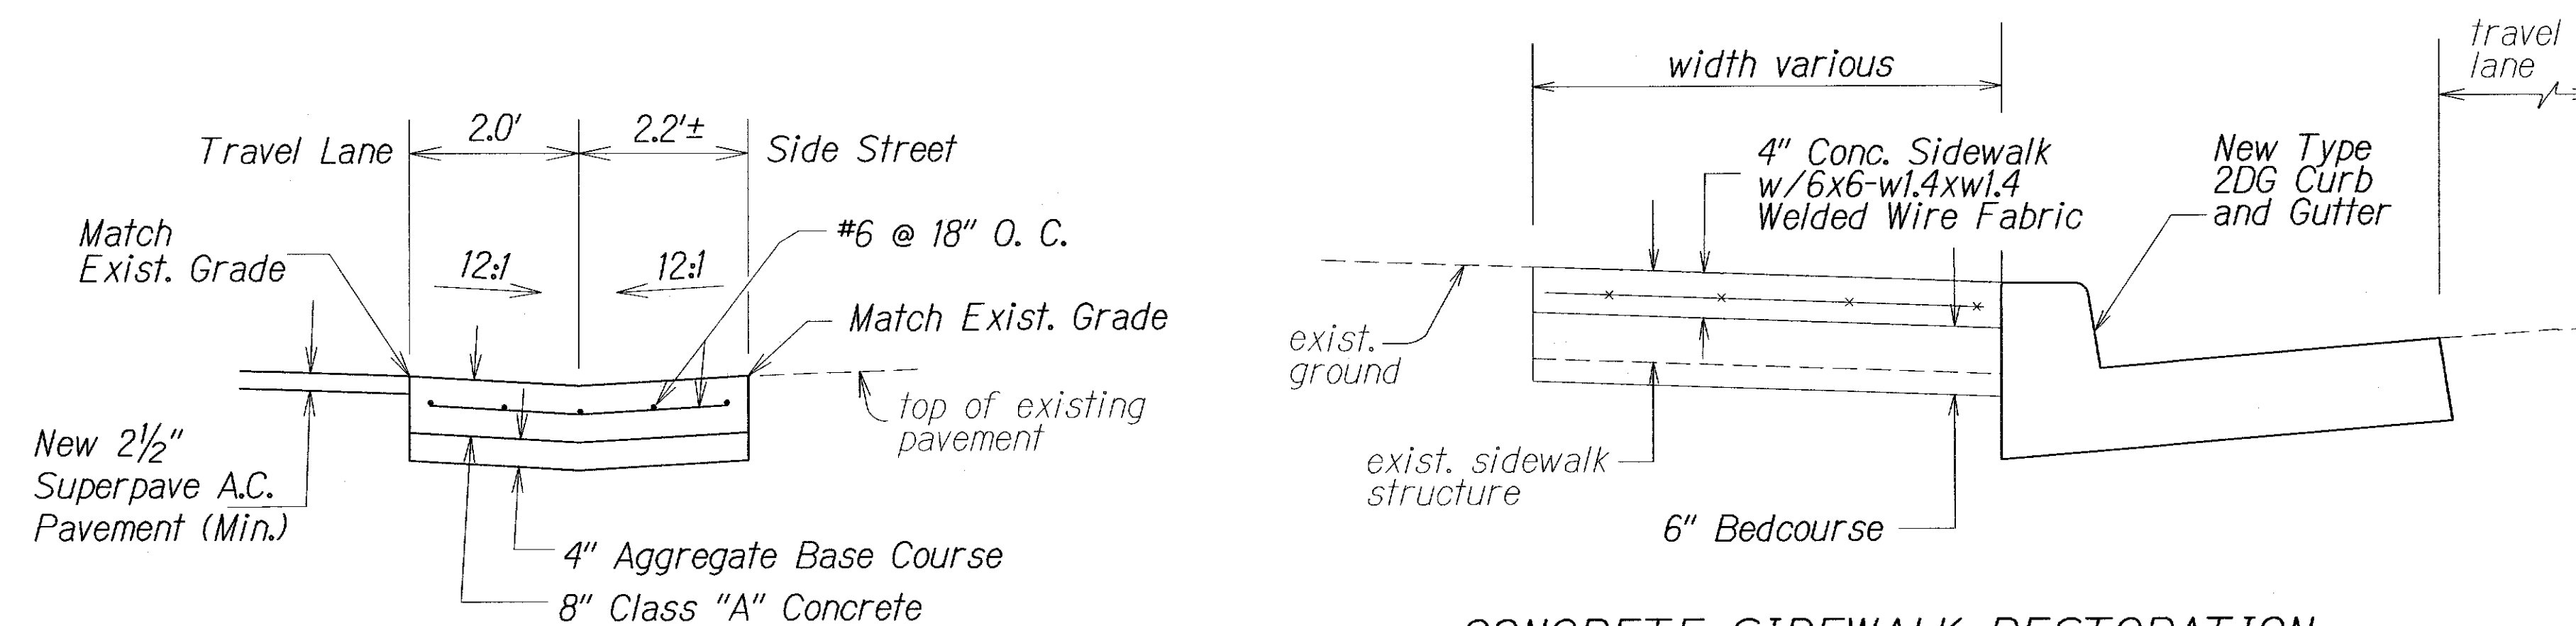


TYPICAL DETAIL
THRU GUTTER
Not to Scale

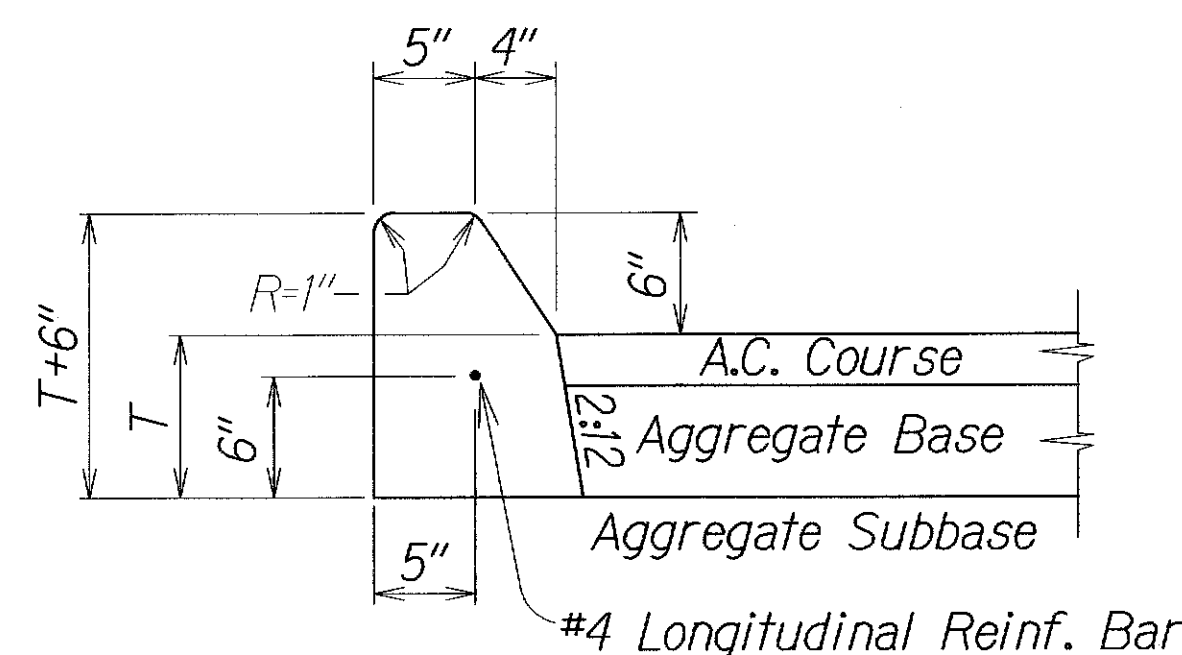


CURB, TYPE 2A
Not to Scale

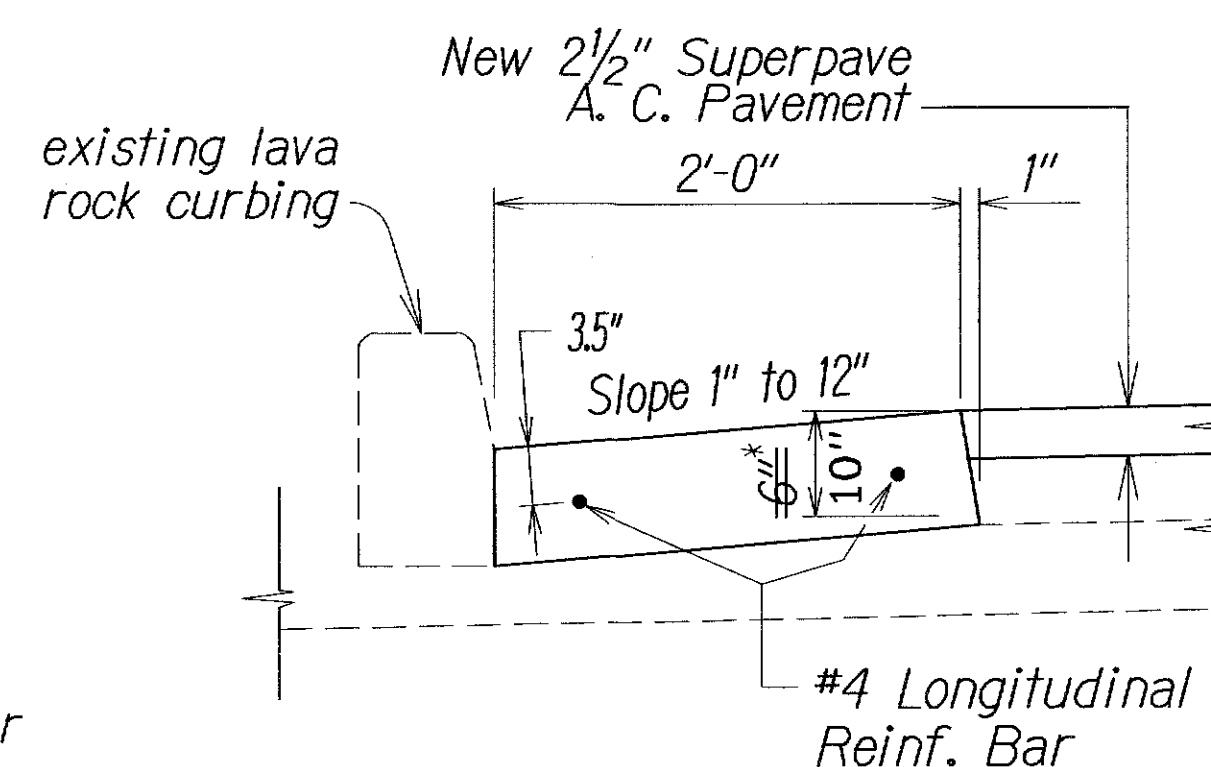


GUTTER, TYPE 2A
Not to Scale

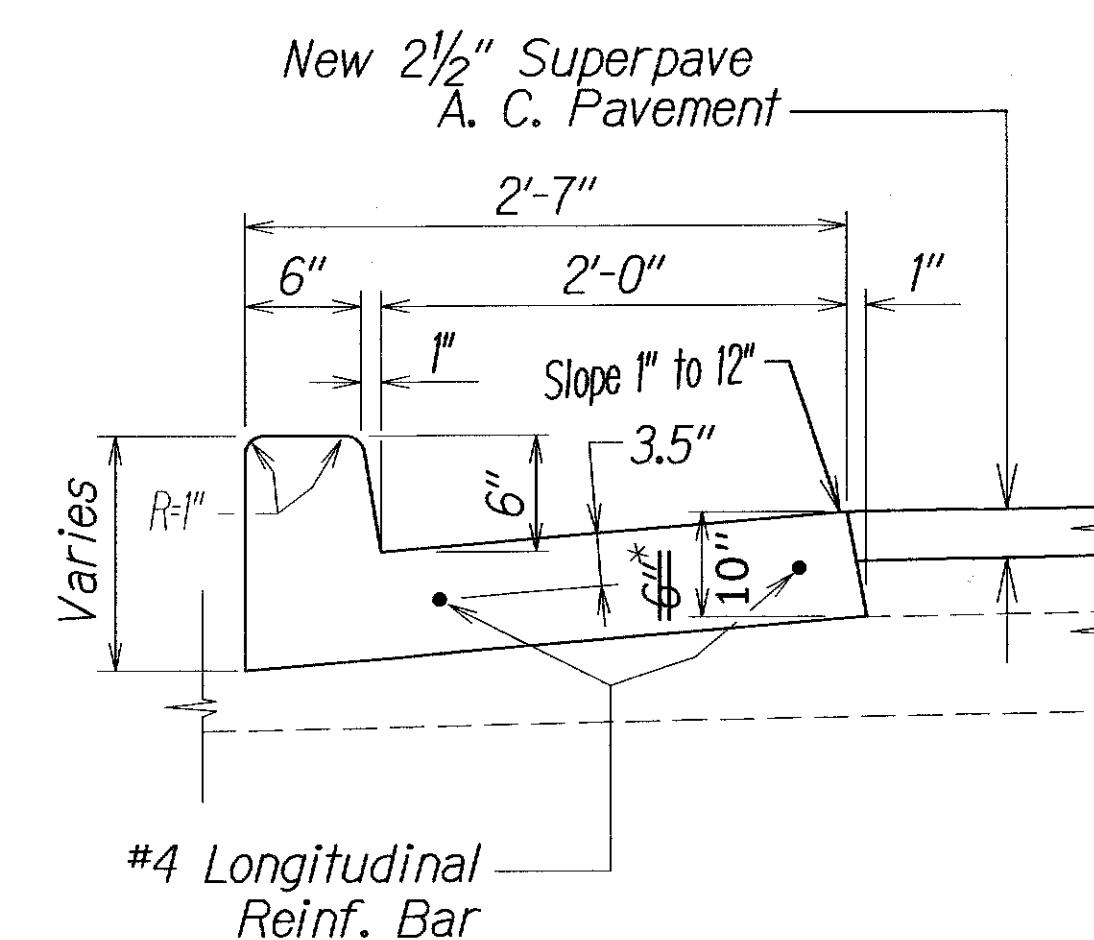


CURB & GUTTER, TYPE 2DG
Not to Scale

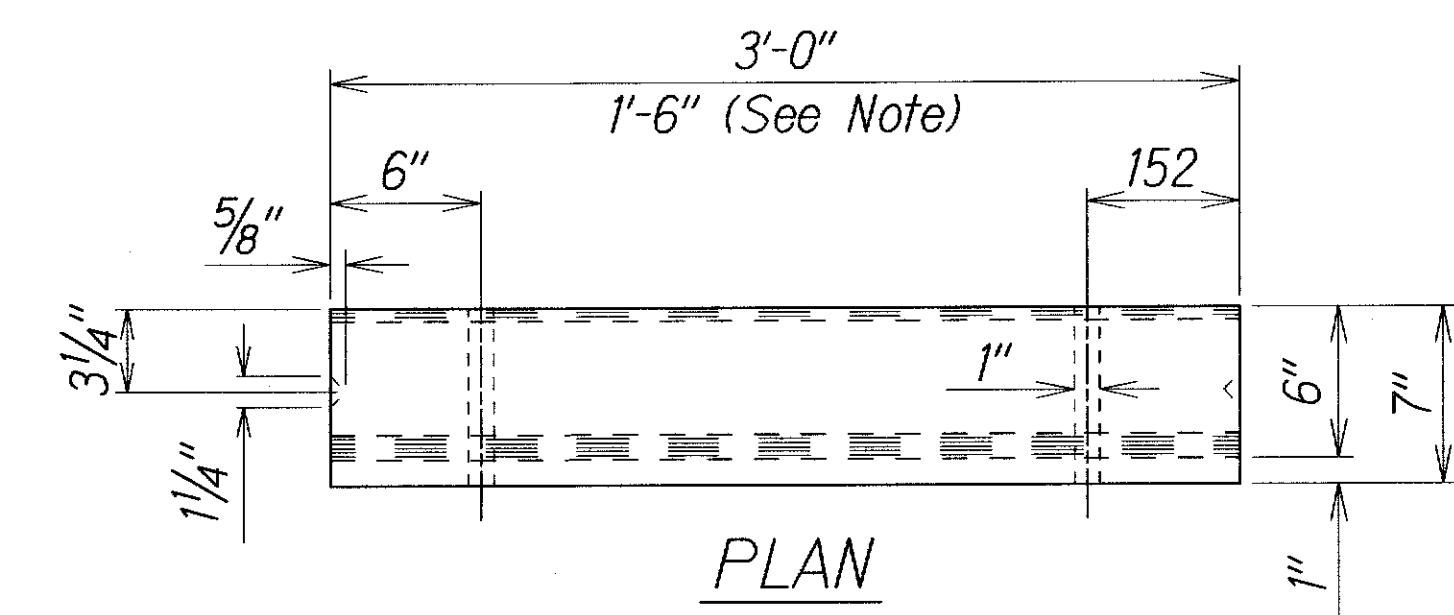

PLAN

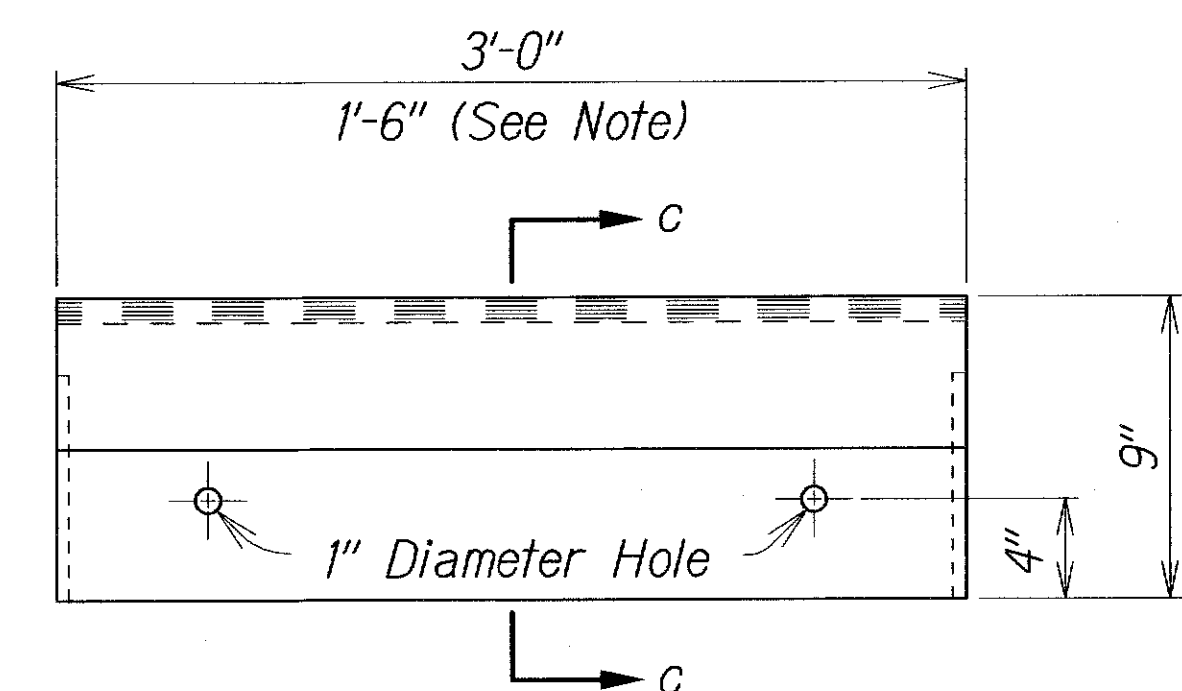


ELEVATION

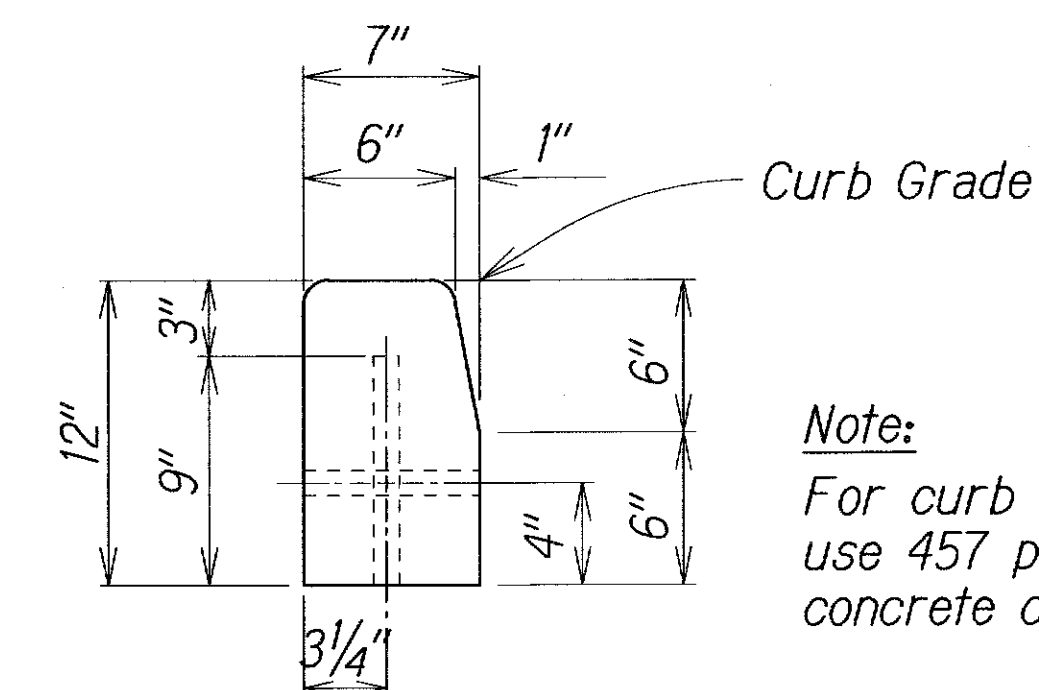

Note:
For curb returns
use 457 pre-cast
concrete curbs.

SECTION C-C
CURB, TYPE 3D
PRE-CAST CONC. CURB
Not to Scale

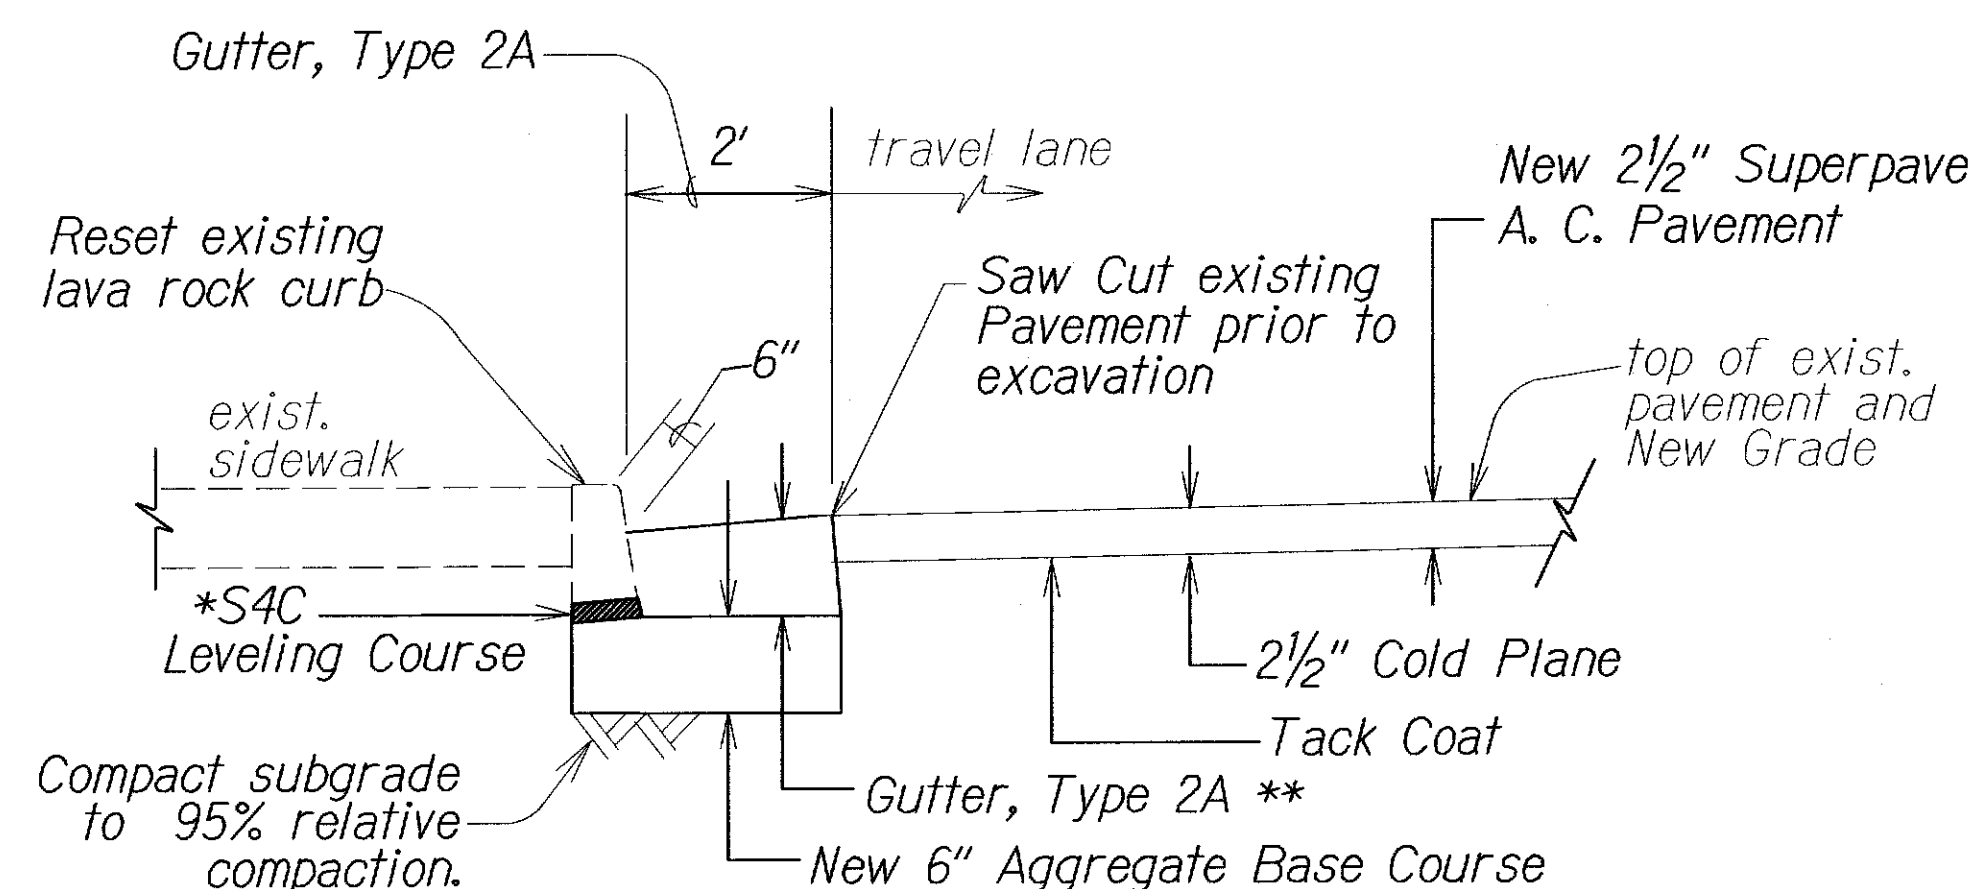


RESETTING EXISTING LAVA ROCK CURBING 

Not to Scale

* The thickness of S4C shall be determined by the Contractor. Resetting of existing lava rock curb shall be considered incidental to various contract items.

*** At PCC Bus Pad Pavement Section, use 11" Modified Type 2A Gutter
See Plan Sht. No. 15.*

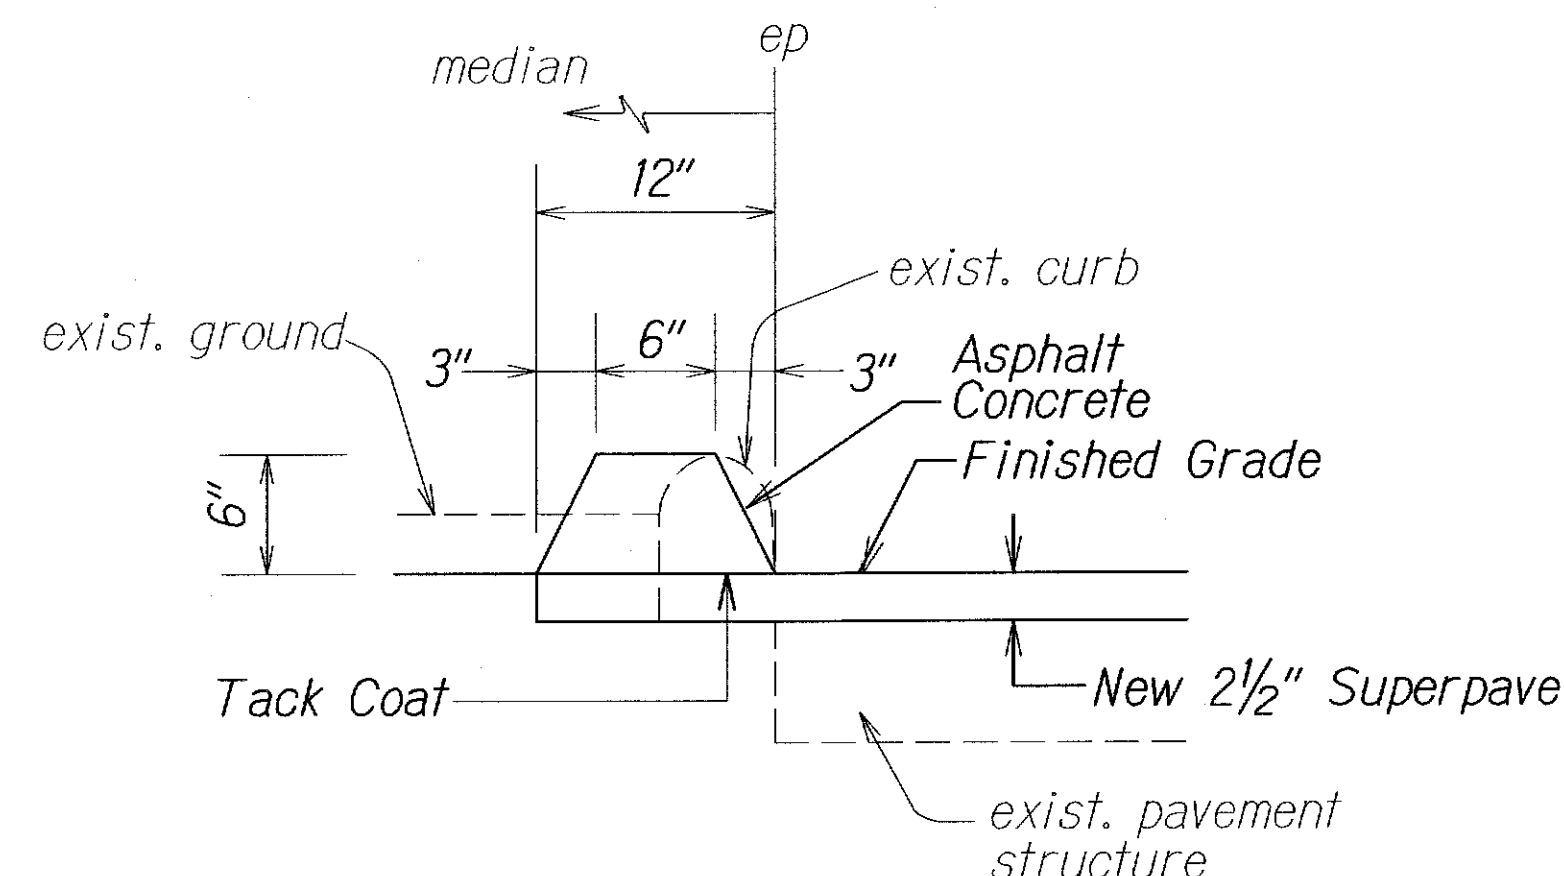

PARTIAL TYPICAL SECTION, CURB, TYPE 6 

Not to Scale

Note:

1. *Cast-In-Place P.C.C. Gutters shall be longitudinal broom finished.*
2. *The top of all types of concrete curbs, including driveway curbs shall be longitudinally broom finished.*

ORIGINAL PLAN	SURVEY PLOTTED BY _____ DATE _____
NOTE BOOK	DRAWN BY _____
add. per 5-min	TRACED BY _____
22	DESIGNED BY _____
22	QUANTITIES BY _____
22	CHECKED BY _____

5/25/06	Revised Details.
DATE	REVISION
STATE OF HAWAII DEPARTMENT OF TRANSPORTATION HIGHWAYS DIVISION <u>TYPICAL DETAILS</u> <u>NIMITZ HIGHWAY AND</u> <u>ALA MOANA BOULEVARD RESURFACING</u> <u>Fort Street to Piikoi Street</u> <u>Project No. 92AB-01-06M</u> Scale: Not to Scale Date: April 2006 SHEET No. 4 OF 4 SHEETS	

LEGEND FOR
AS-BUILT POSTINGS

	Squiggly line for as-built deletion
	Double line for as-built deletion
Roadway	Text for as-built posting

STATE OF HAWAII
DEPARTMENT OF TRANSPORTATION
HIGHWAYS DIVISION

TYPICAL DETAILS
NIMITZ HIGHWAY AND
ALA MOANA BOULEVARD RESURFACING
Fort Street to Piikoi Street
Project No. 92AB-01-06M

Scale: Not to Scale Date: April 2006

SHEET No. 4 OF 4 SHEETS

"AS-BUILT"

ADD. 14