



Limit of Pavement	<u>Farrington Highway</u>	Curb,	Farrington Highway
-------------------	---------------------------	-------	--------------------

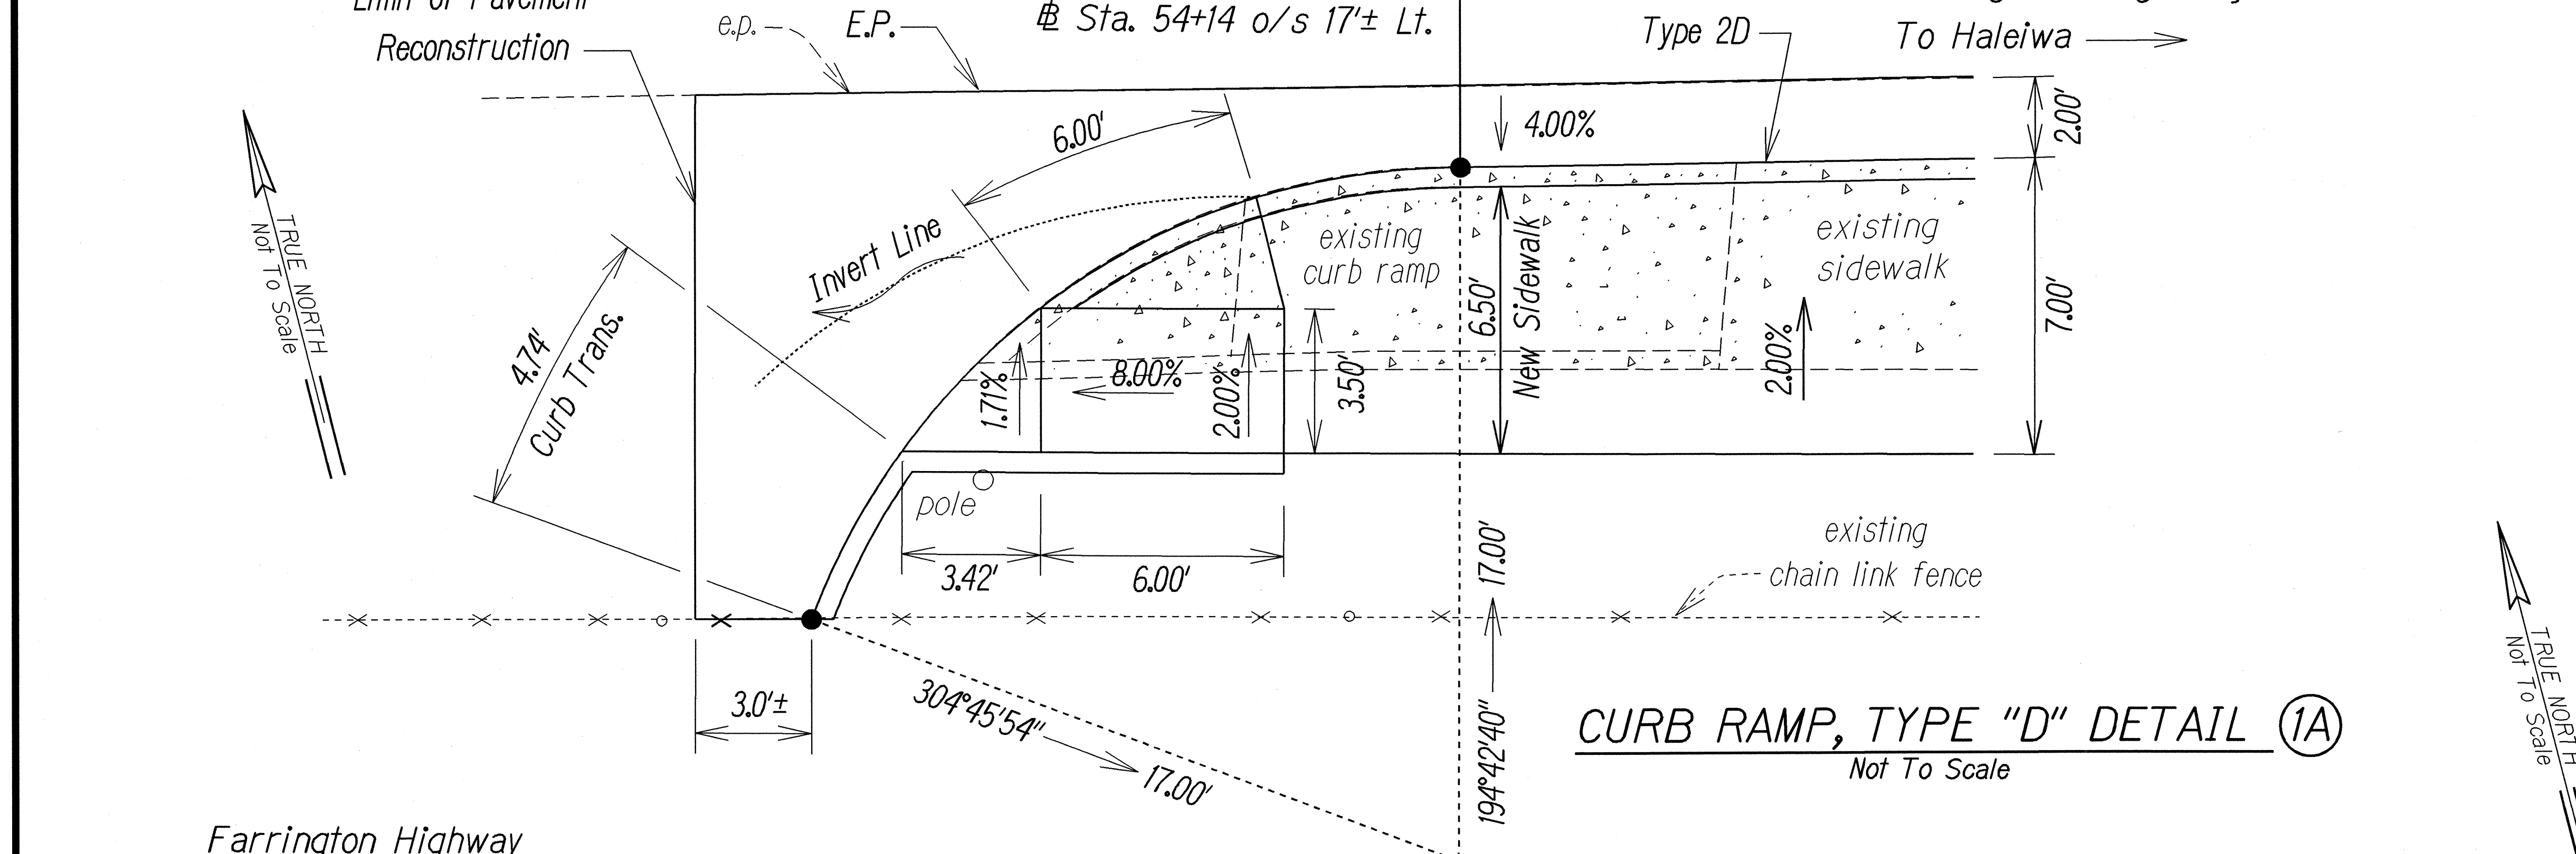

CURB RAMP, TYPE "D" DETAIL (1A)
Not To Scale

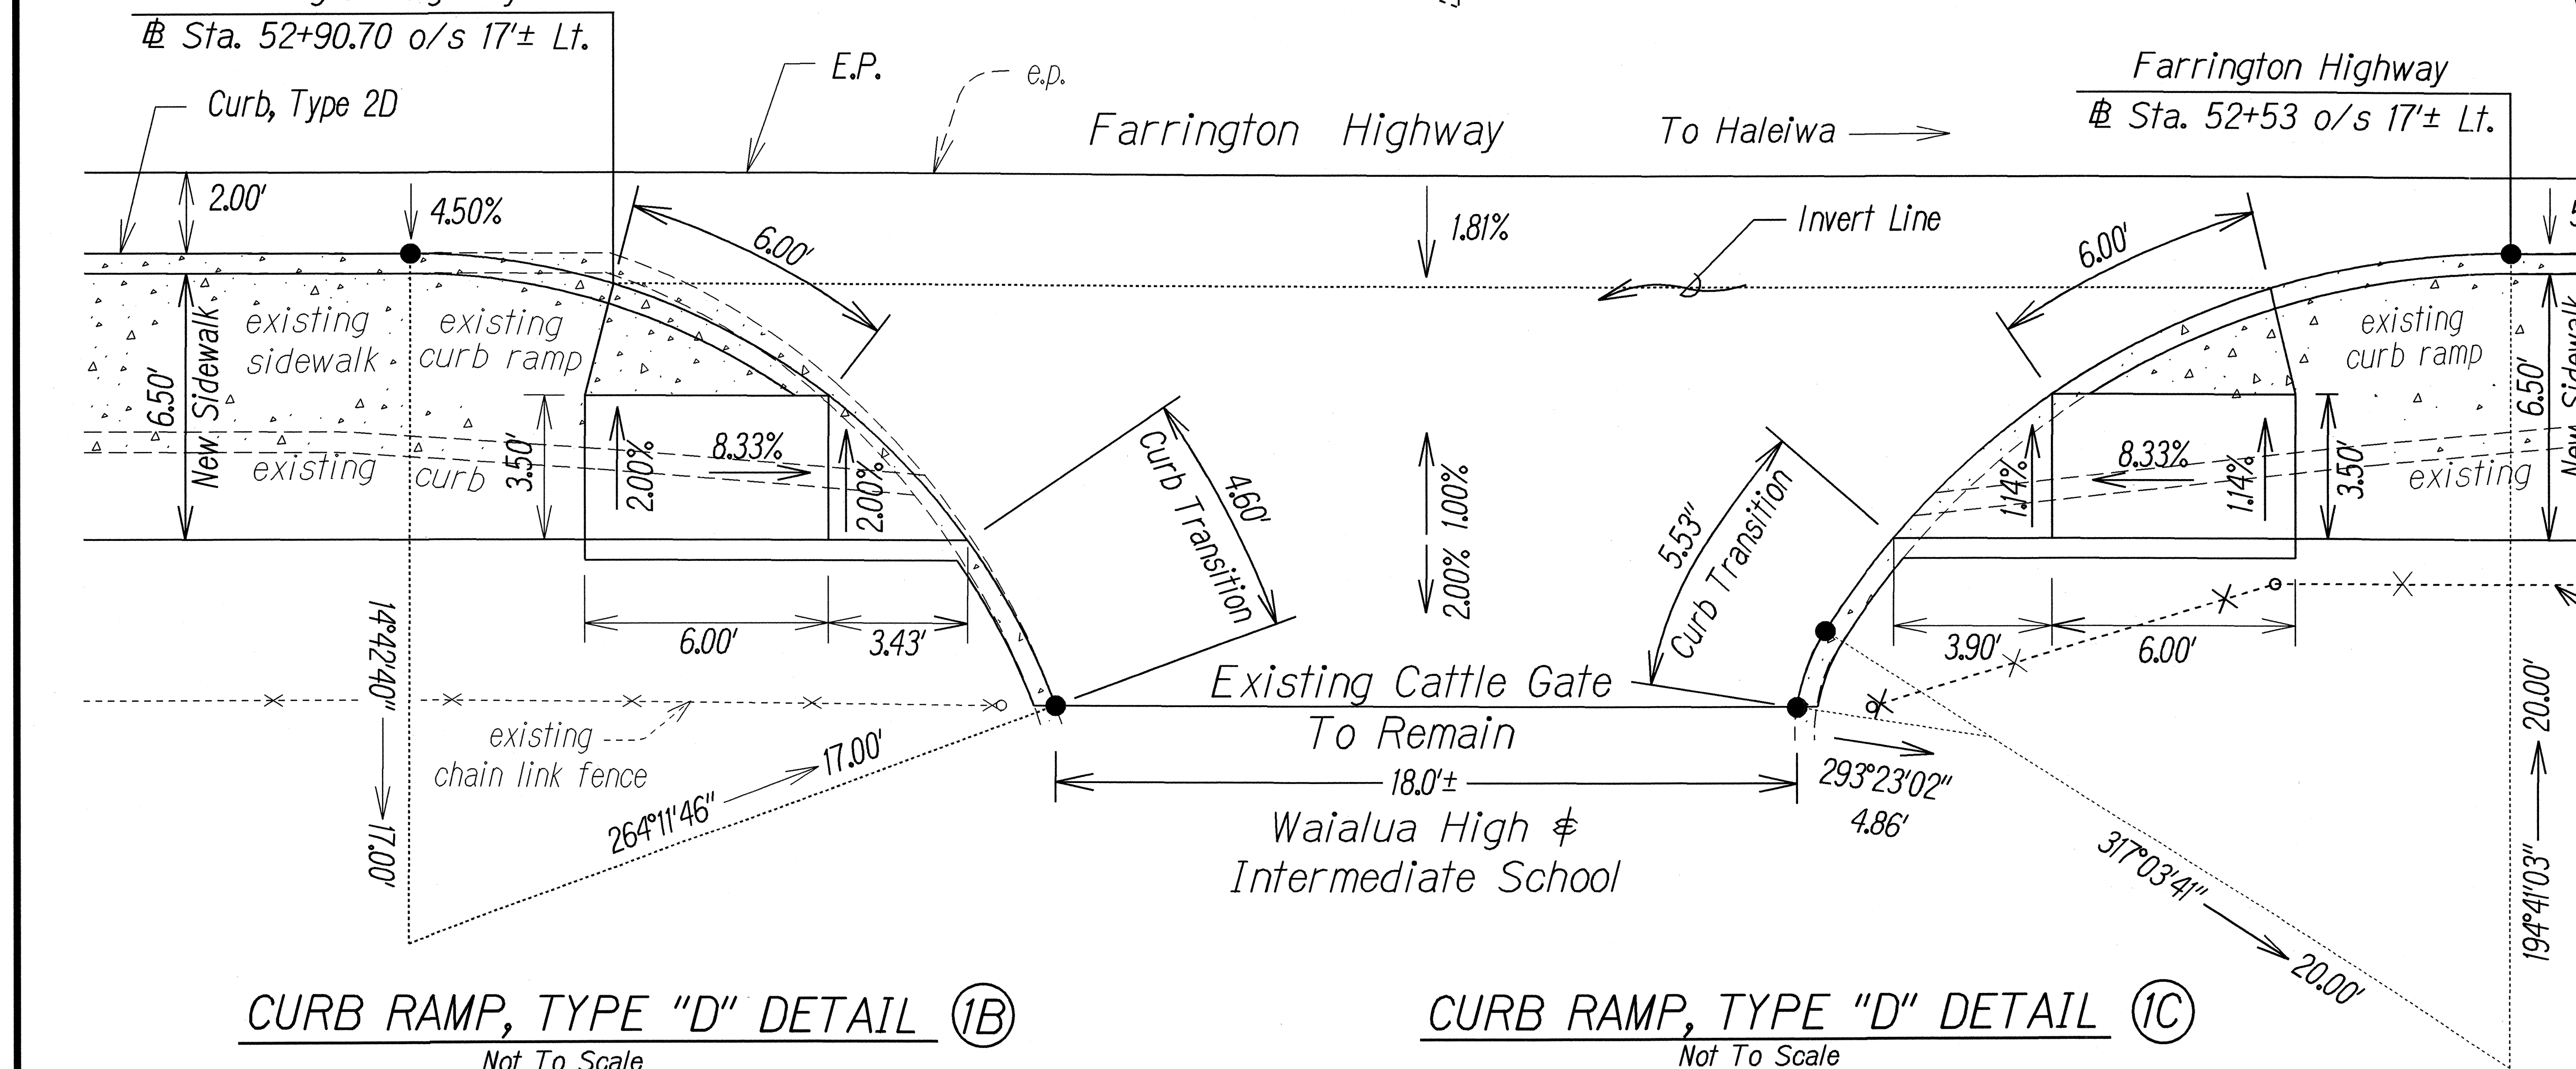

CURB RAMP, TYPE "D" DETAIL (1B)
Not To Scale

CURB RAMP, TYPE "D" DETAIL (1C)
Not To Scale

ORIGINAL PLAN	SURVEY PLOTTED BY _____ DATE <u>12/11/01</u>
NOTE BOOK	DRAWN BY <u>JOS. P. ROY</u>
and 140/150-44/67	TRACED BY _____
and 140/150-44/67	DESIGNED BY <u>RTU</u>
and 140/150-44/67	QUANTITIES BY _____
and 140/150-44/67	CHECKED BY _____

STATE OF HAWAII
DEPARTMENT OF TRANSPORTATION
HIGHWAYS DIVISION

DETAILS

PEDESTRIAN FACILITIES and ADA COMPLIANCE



Various Locations On Oahu

Federal Aid Project No. CMAQ-0300(83)

Not To Scale *Date: Feb., 2001*

SHEET No. **1** OF **9** SHEETS

FED. ROAD DIST. NO.	STATE	PROJ. NO.	FISCAL YEAR	SHEET NO.	TOTAL SHEETS
HAWAII	HAW.	CMAQ-0300(83)	2002	30	42

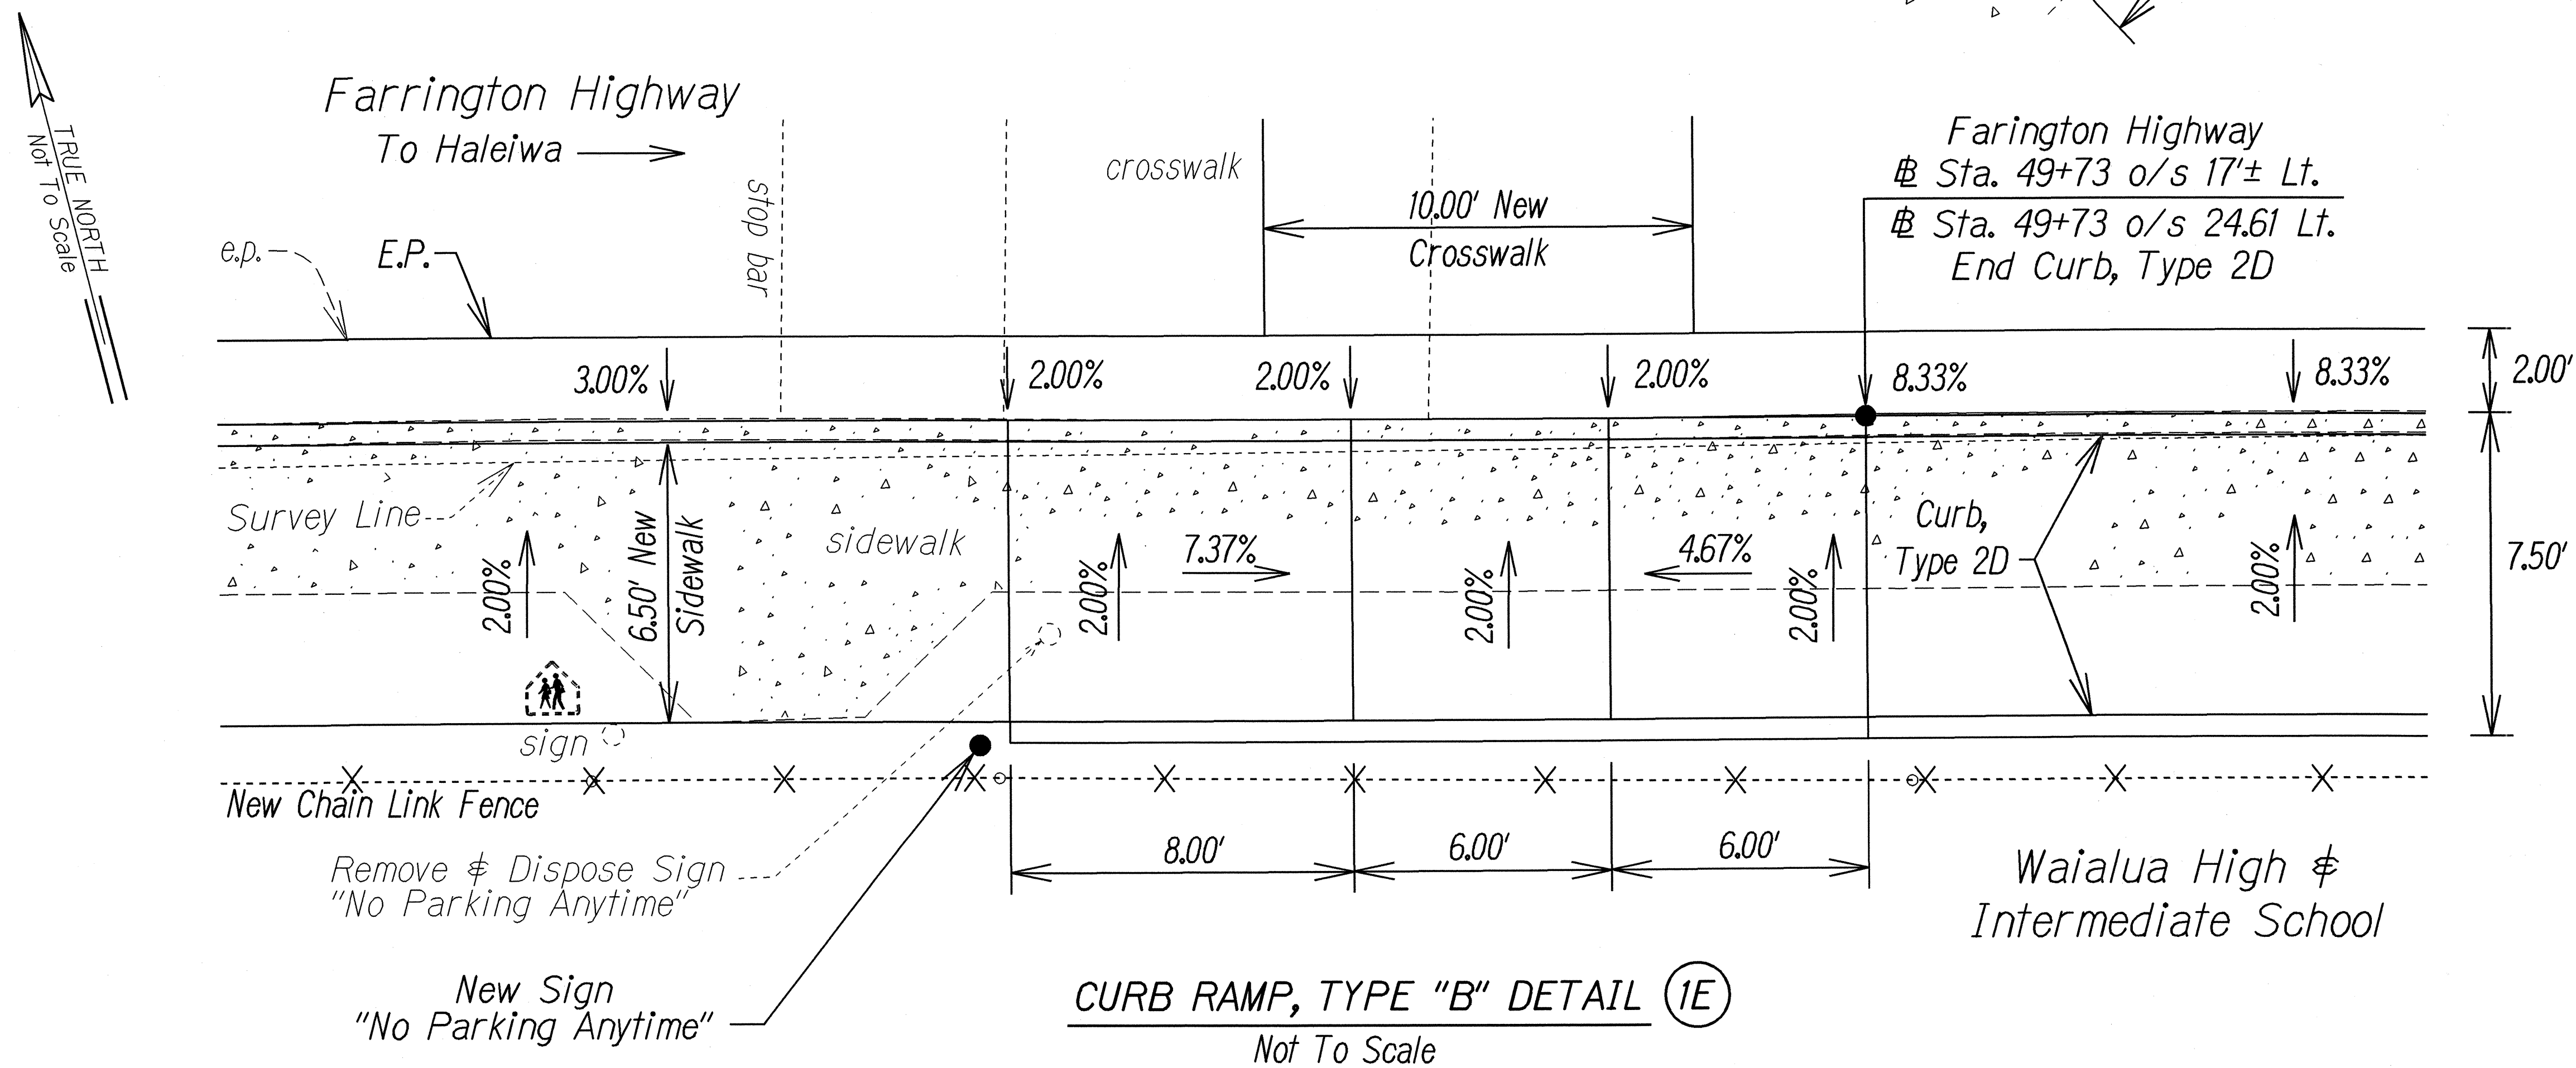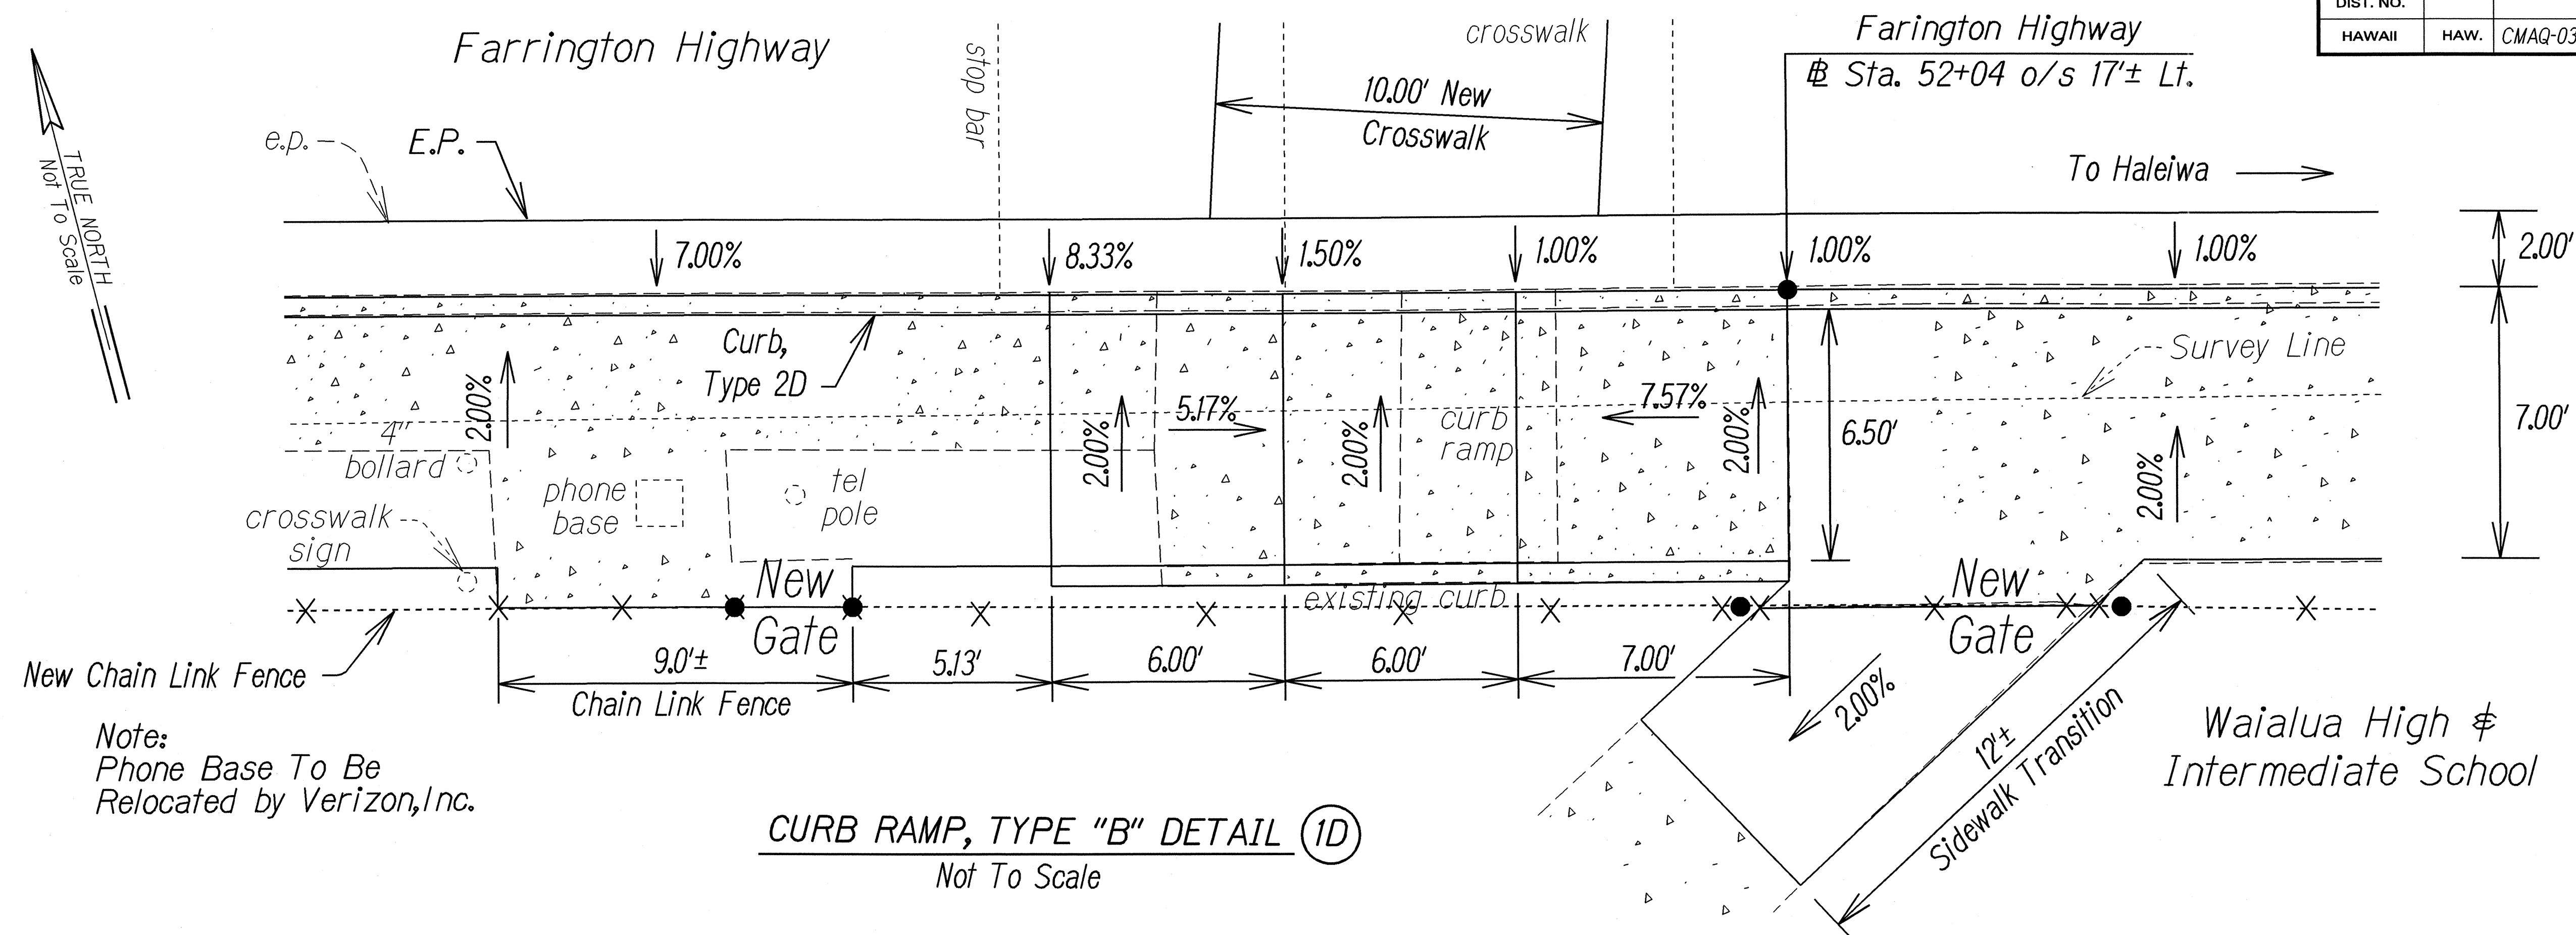

ORIGINAL PLAN	SURVEY PLOTTED BY _____ DATE <u>12/11/01</u>
	DRAWN BY <u>gms gms</u>
	TRACED BY _____
	DESIGNED BY <u>RTU</u>
	QUANTITIES BY _____
	CHECKED BY _____

STATE OF HAWAII
DEPARTMENT OF TRANSPORTATION
HIGHWAYS DIVISION

DETAILS

PEDESTRIAN FACILITIES and ADA COMPLIANCE


Various Locations On Oahu

Federal Aid Project No. CMAQ-0300(83)

Not To Scale *Date: Feb., 2001*

SHEET No. **2** OF **9** SHEETS

FED. ROAD DIST. NO.	STATE	PROJ. NO.	FISCAL YEAR	SHEET NO.	TOTAL SHEETS
HAWAII	HAW.	CMAQ-0300(83)	2002	31	42

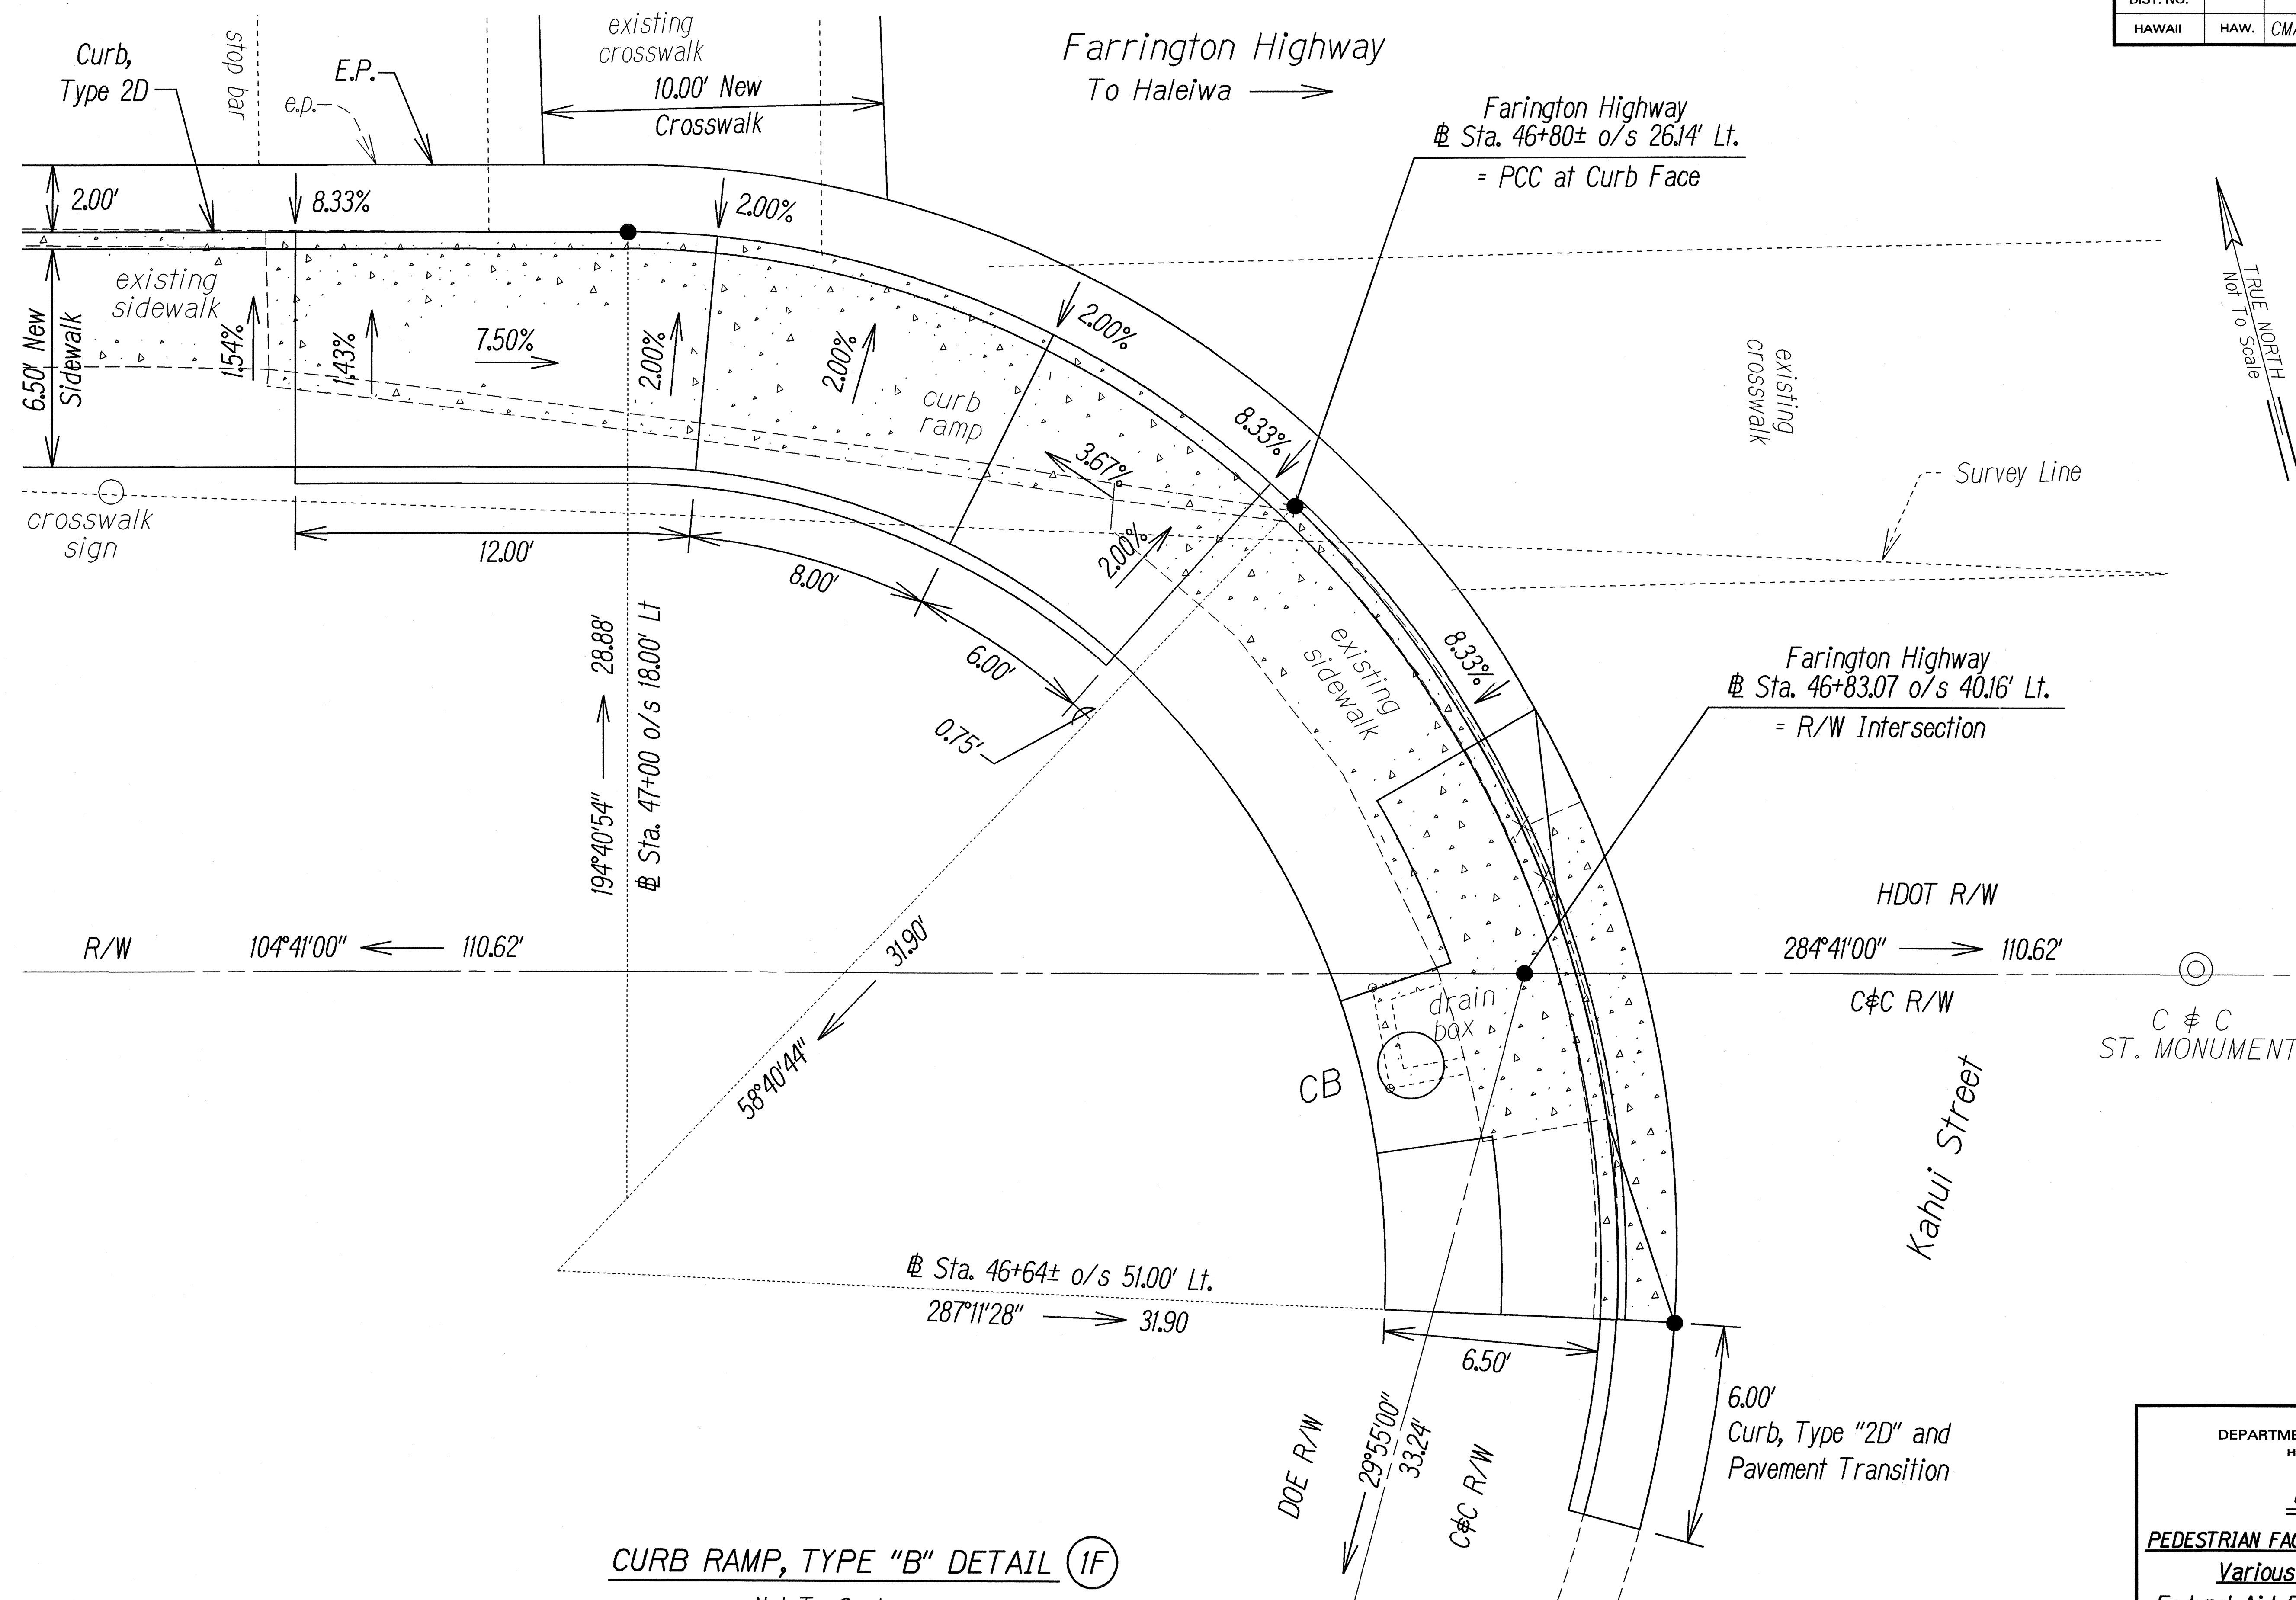

CURB RAMP, TYPE "B" DETAIL (1F)
Not To Scale

DESIGNED BY	DATE
TRACED BY	12/1/01
NOTED BY	12/1/01
QUANTITIES BY	
CHECKED BY	

STATE OF HAWAII
DEPARTMENT OF TRANSPORTATION
HIGHWAYS DIVISION


DETAILS

PEDESTRIAN FACILITIES and ADA COMPLIANCE
Various Locations On Oahu
Federal Aid Project No. CMAQ-0300(83)


Not To Scale Date: Feb., 2001

SHEET No. 3 OF 9 SHEETS

FED. ROAD DIST. NO.	STATE	FED. AID PROJ. NO.	FISCAL YEAR	SHEET NO.	TOTAL SHEETS
HAWAII	HAW.	CMAQ-0300(83)	2001	ADD.34	42

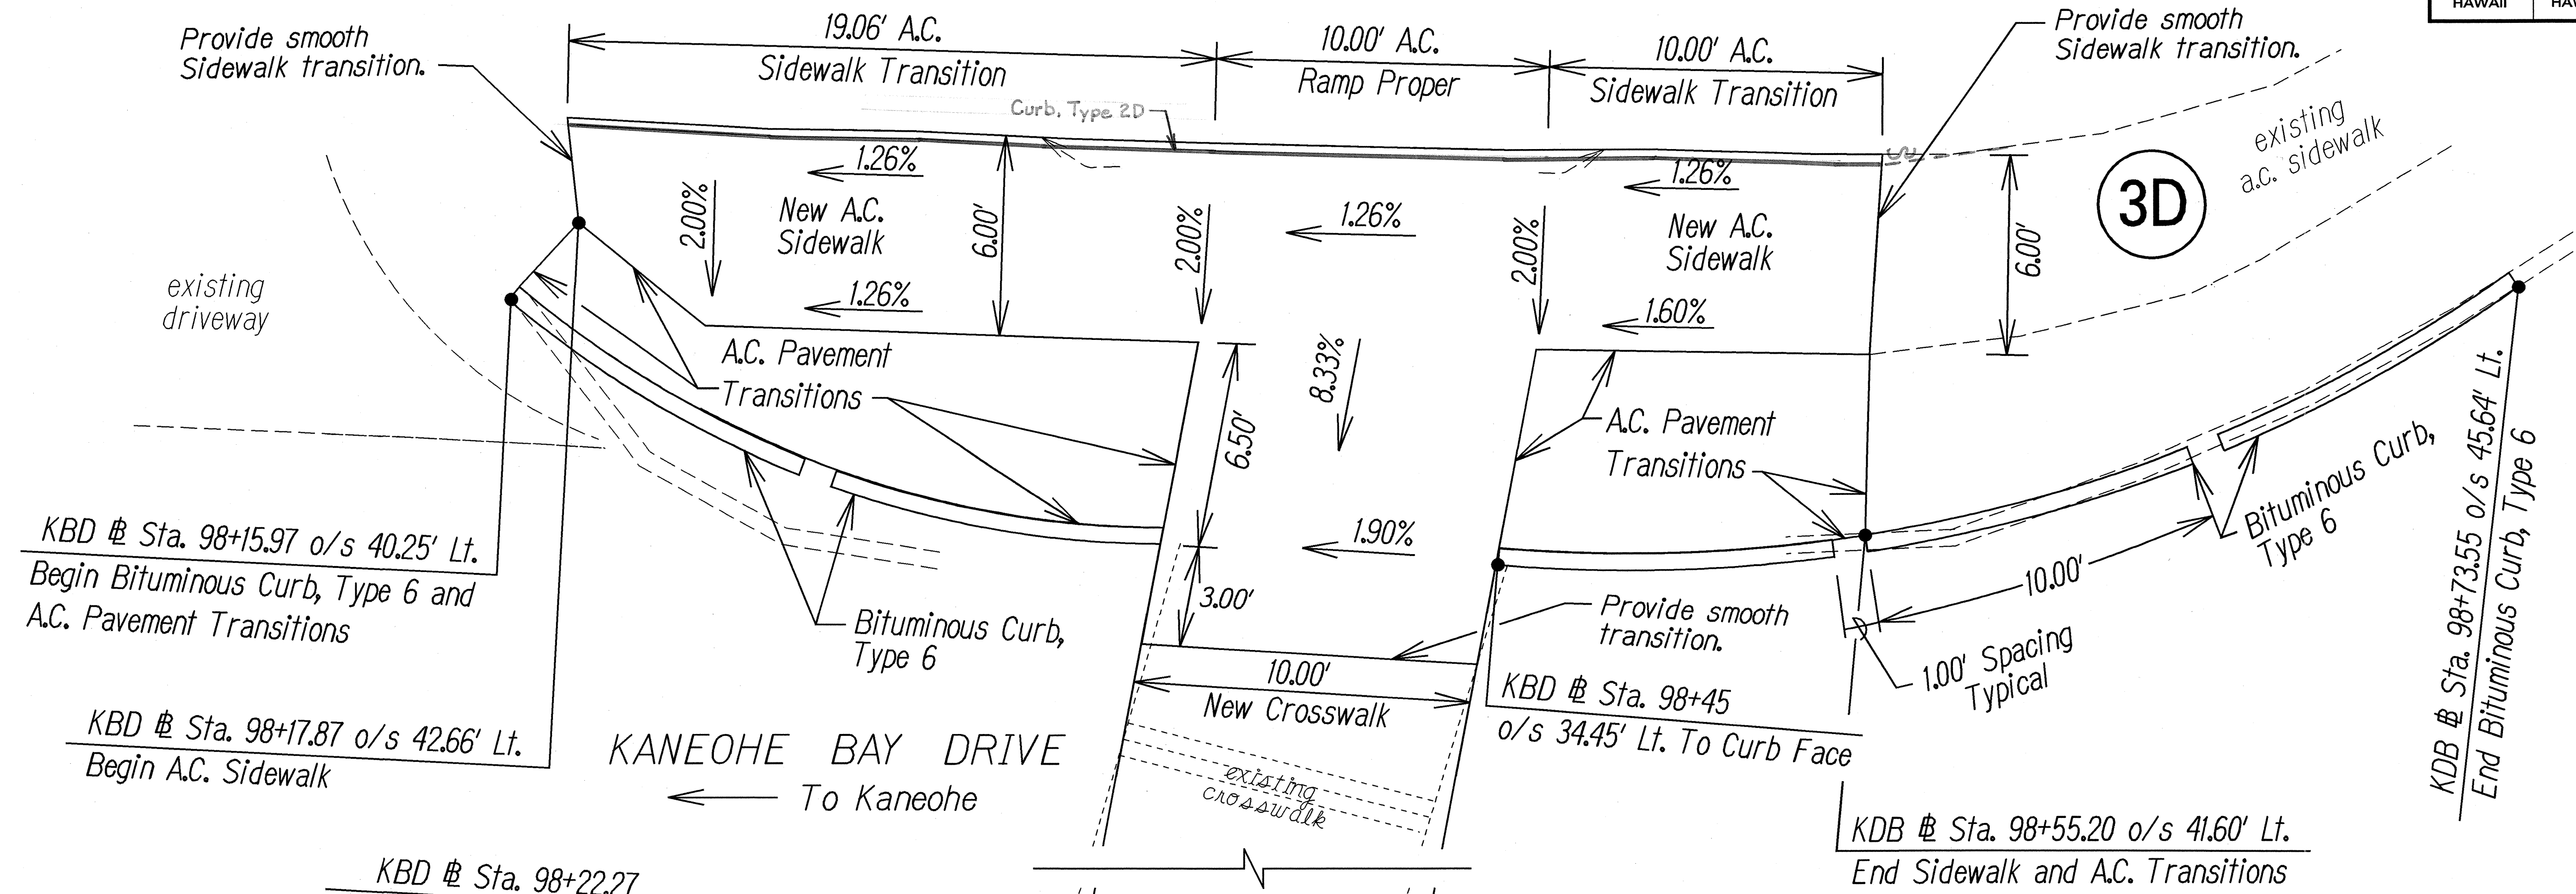

A.C. SIDEWALK, DETAIL 3D
Not to Scale

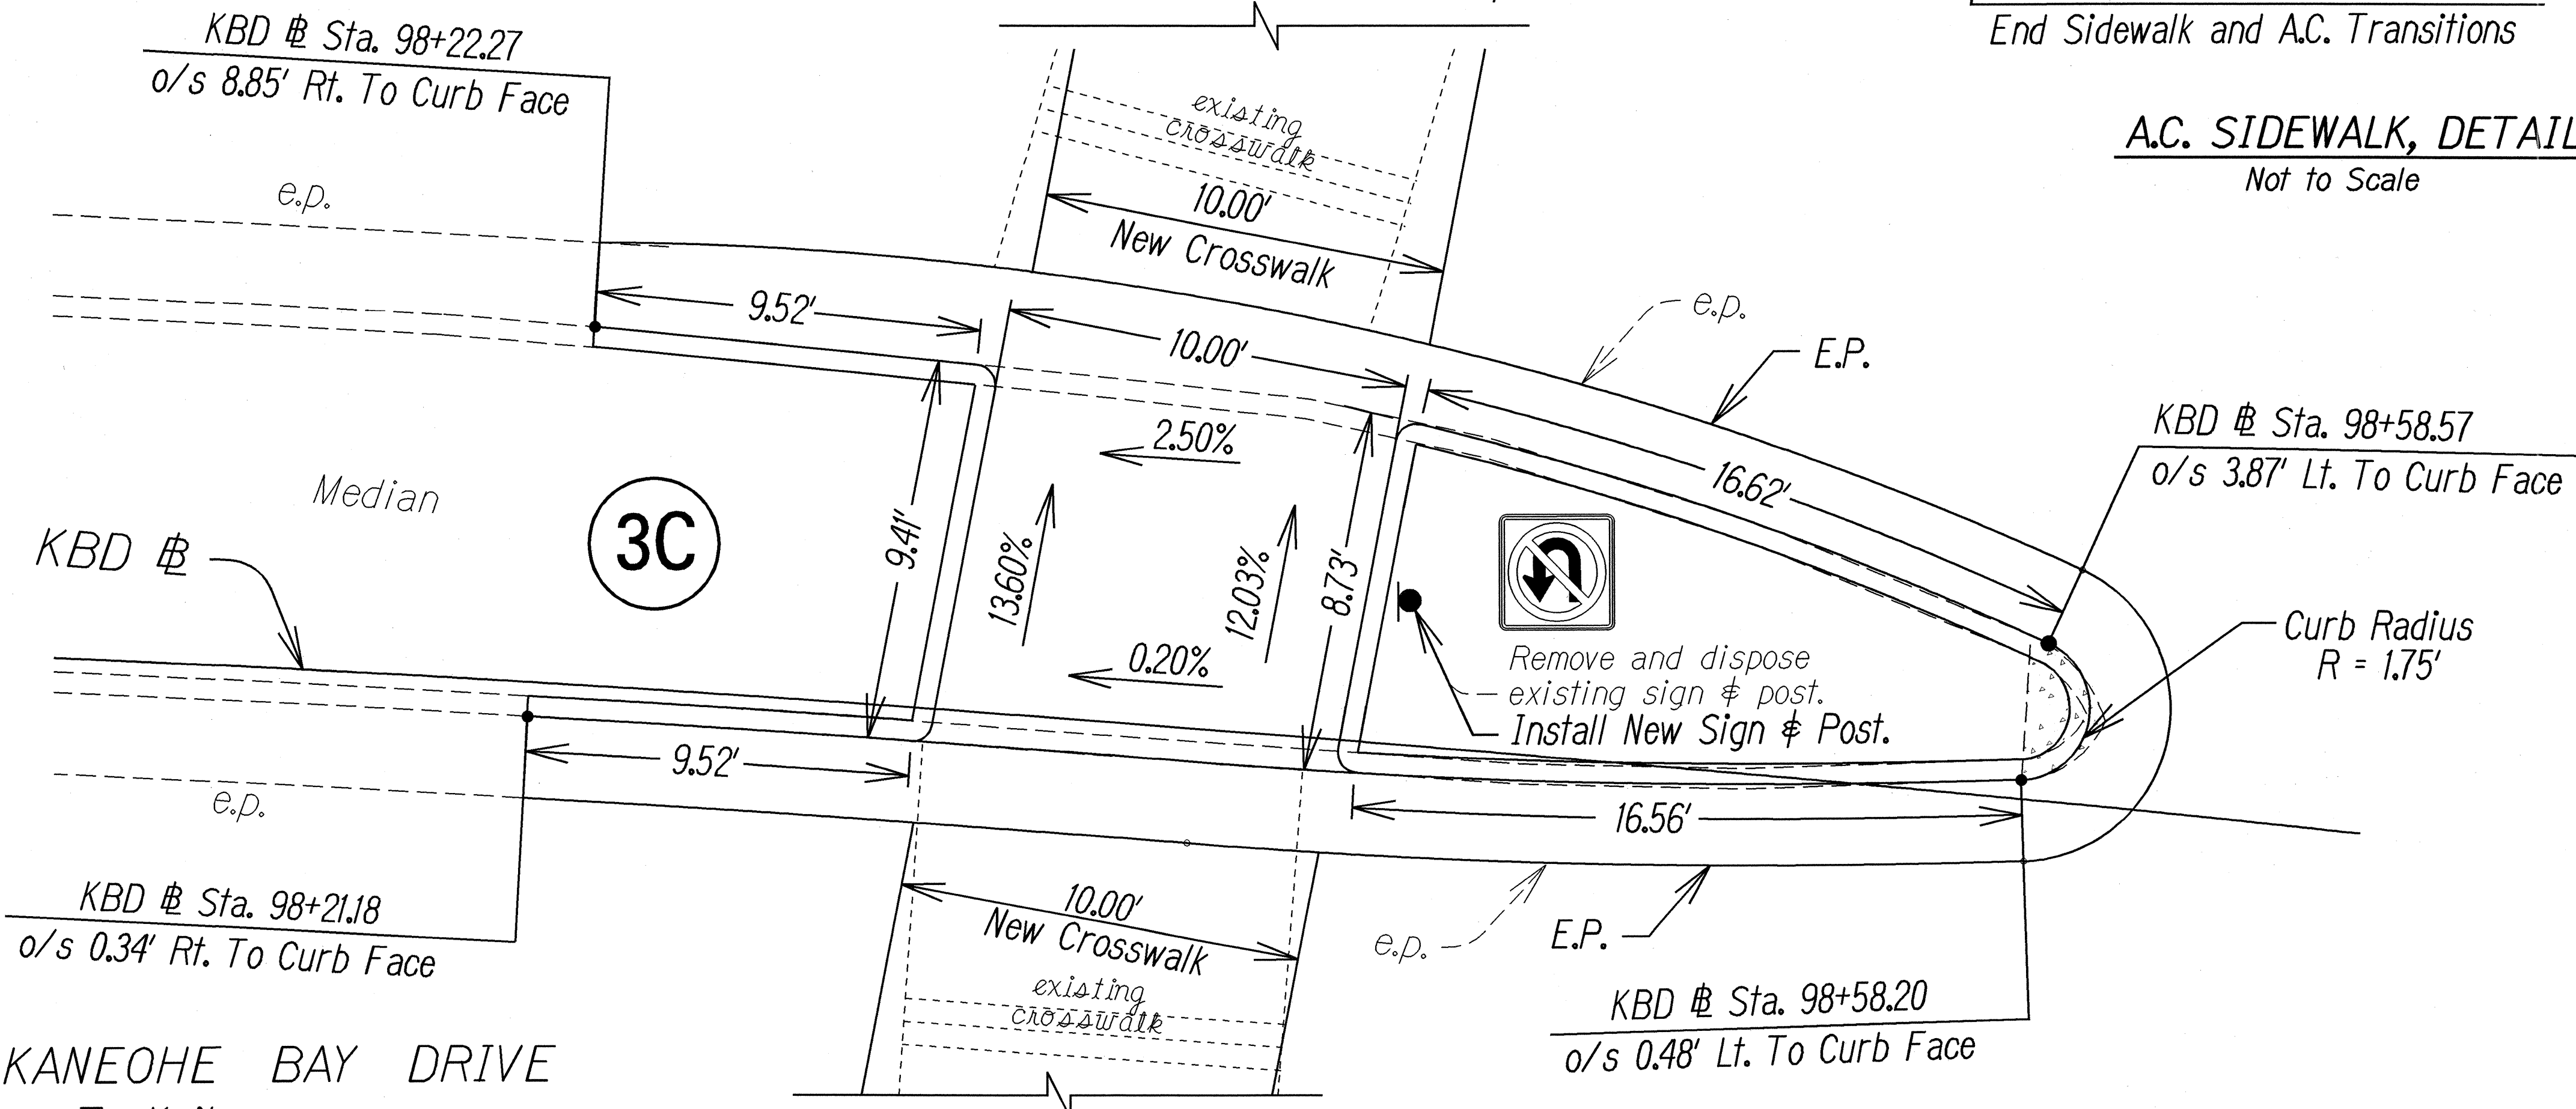

CURB RAMP, TYPE "C" DETAIL 3C
Not to Scale


ORIGINAL PLAN	DATE
DESIGNED BY	07/02/02
TRACED BY	
NOTE BOOK	
QUANTITIES BY	
CHECKED BY	

1/8/02	Revised and added sign call-out for Detail 3C. Revised and added dimensions, call-outs and title for Detail 3D.
DATE	REVISION
STATE OF HAWAII DEPARTMENT OF TRANSPORTATION HIGHWAYS DIVISION DETAILS PEDESTRIAN FACILITIES and ADA COMPLIANCE Various Locations On Oahu Federal Aid Project No. CMAQ-0300(83) Scale: None Date: Feb., 2001 SHEET No. 6 OF 9 SHEETS	


"AS-BUILT"

ADD.34


FED. ROAD DIST. NO.	STATE	FED. AID PROJ. NO.	FISCAL YEAR	SHEET NO.	TOTAL SHEETS
HAWAII	HAW.	CMAQ-0300(83)	2002	ADD.35	42

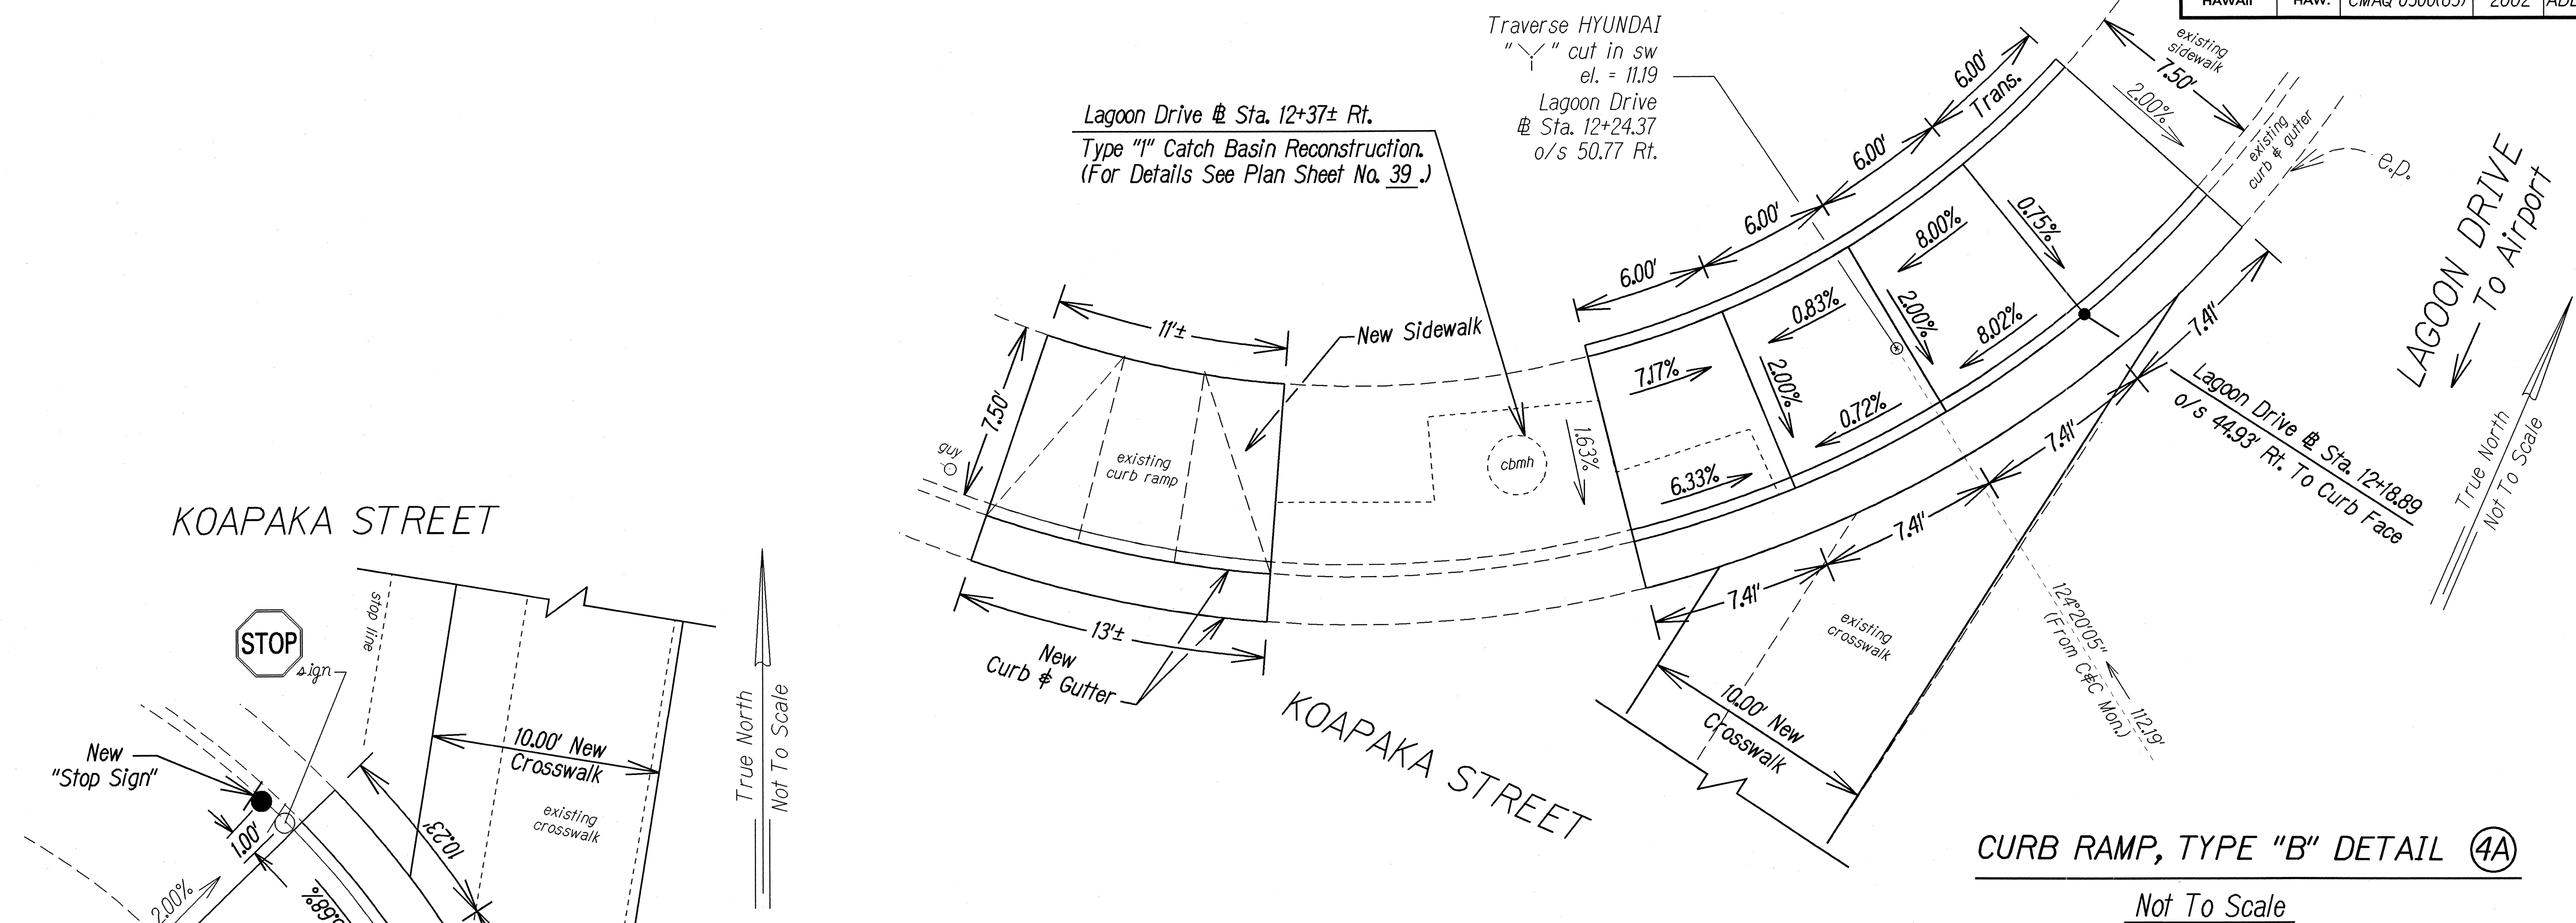

CURB RAMP, TYPE "B" DETAIL 4A
Not To Scale

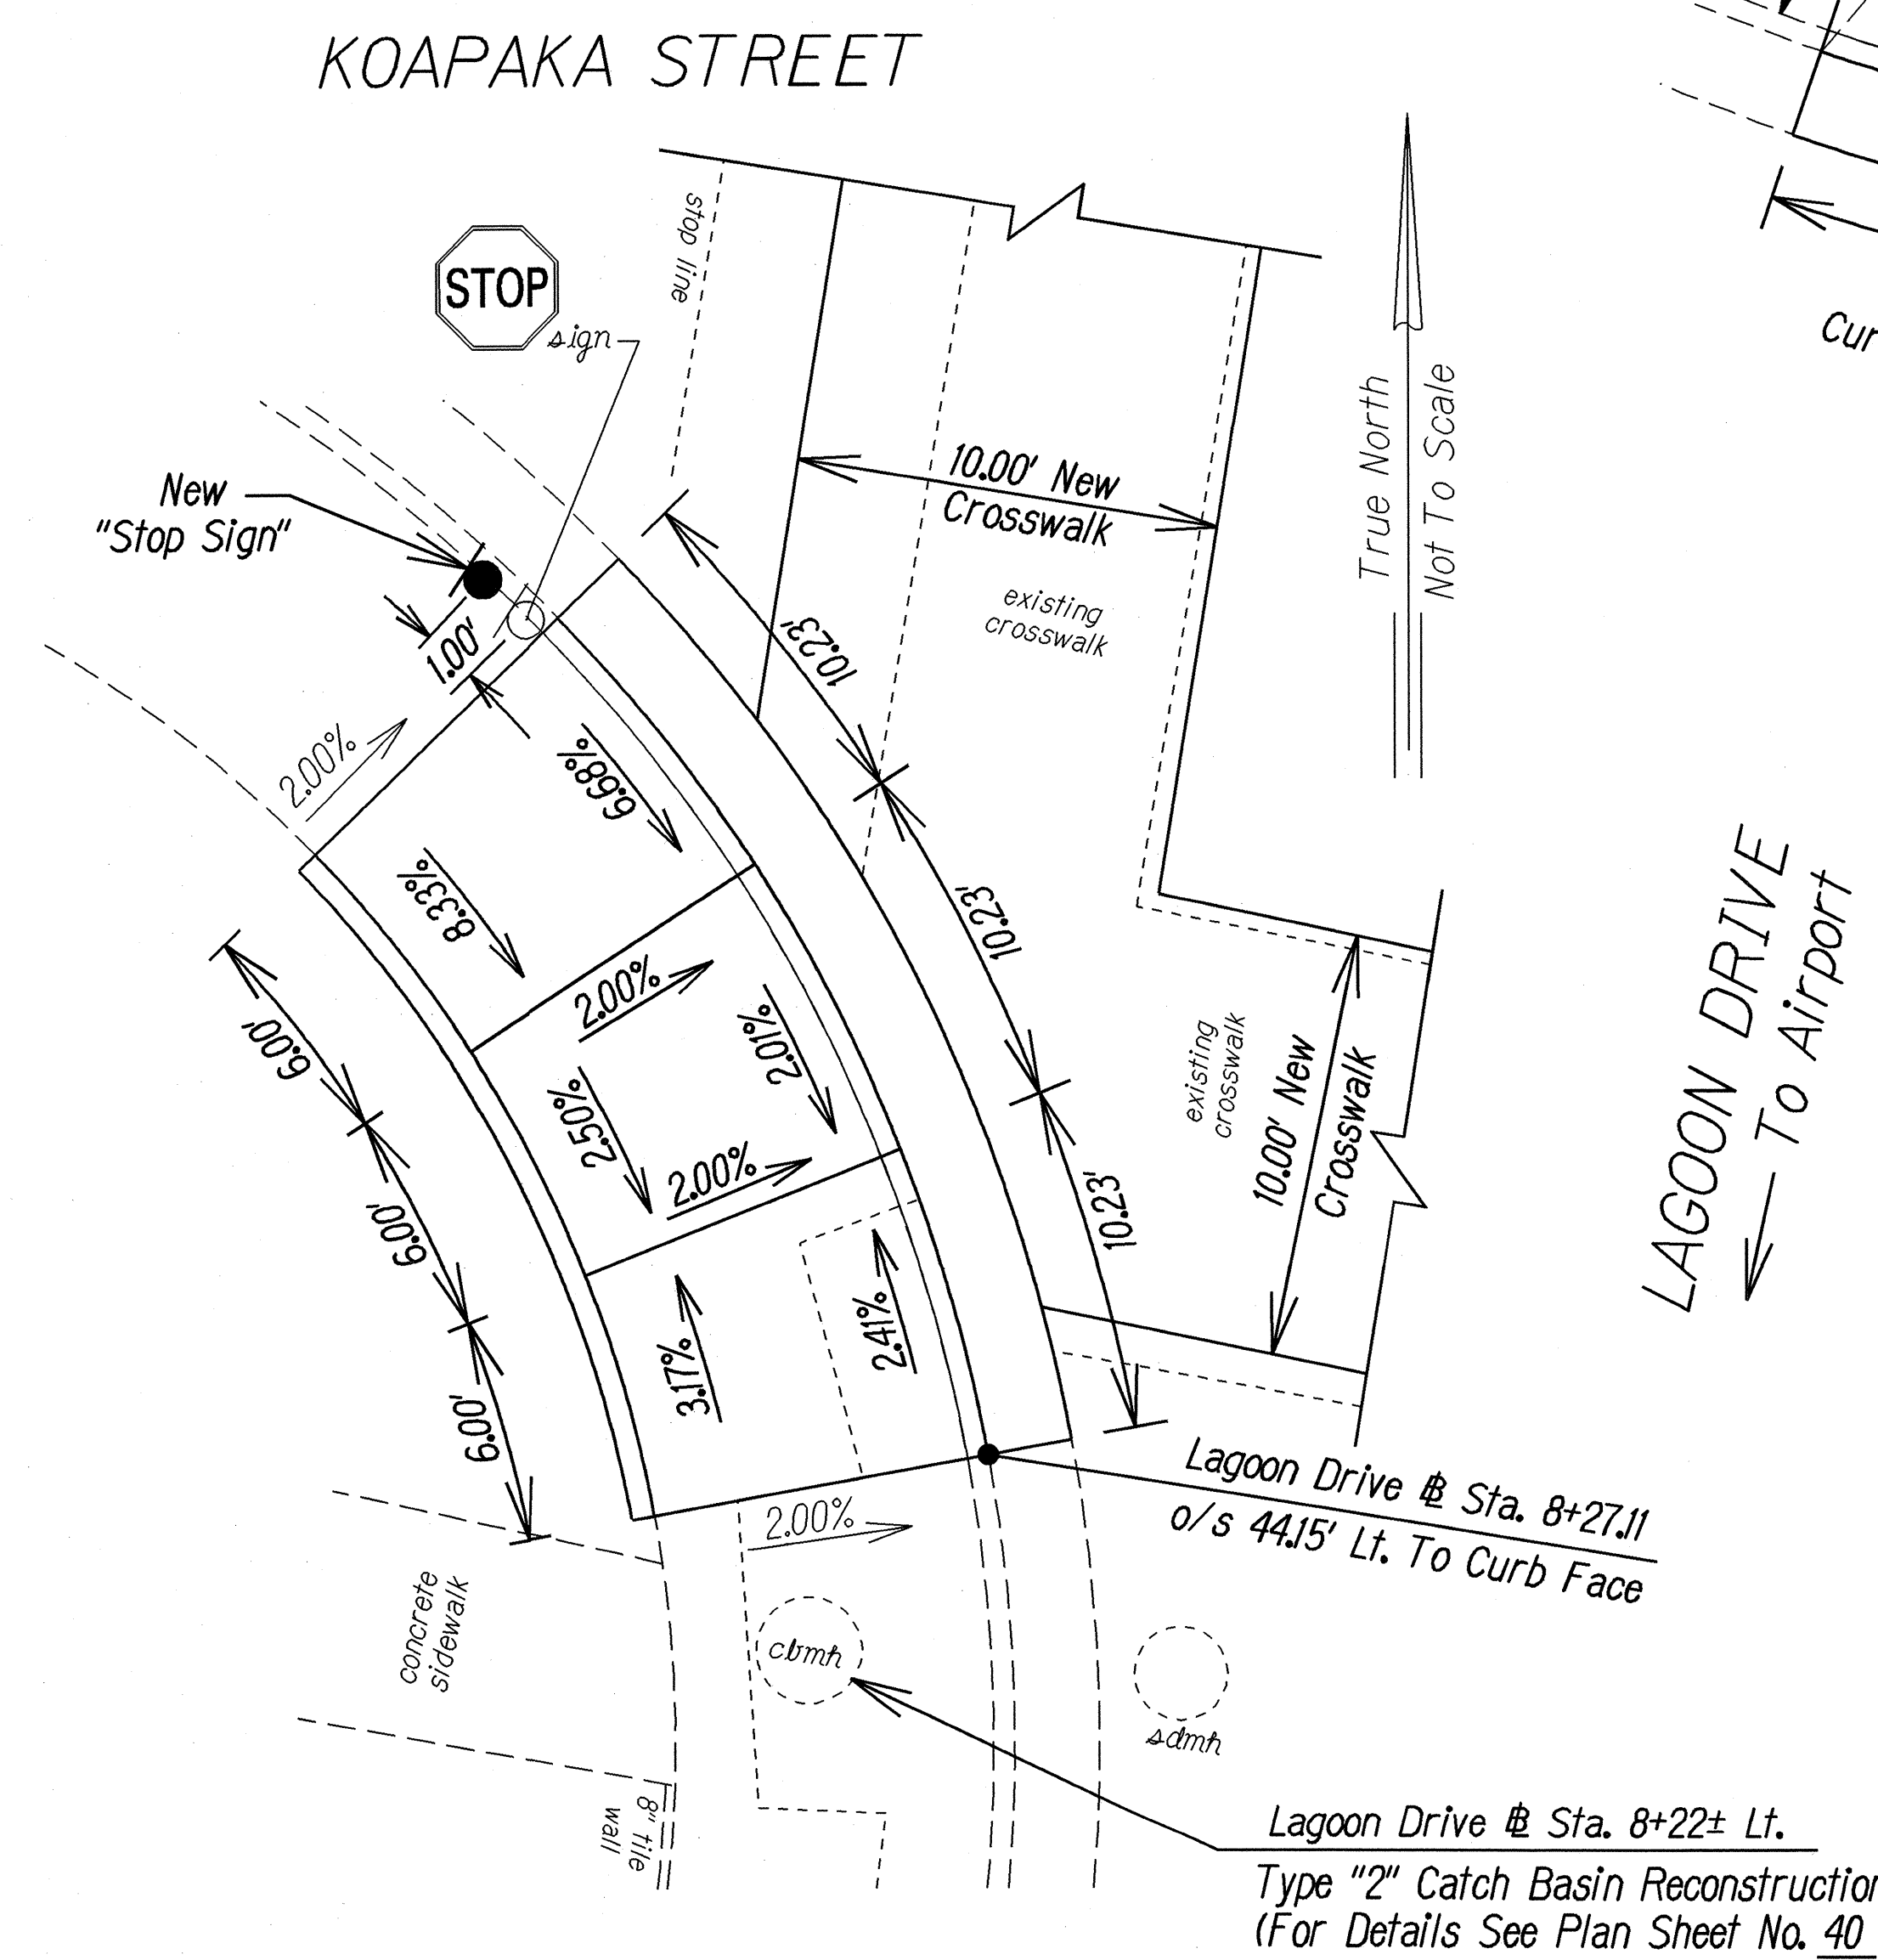

CURB RAMP, TYPE "B" DETAIL 4B
Not To Scale

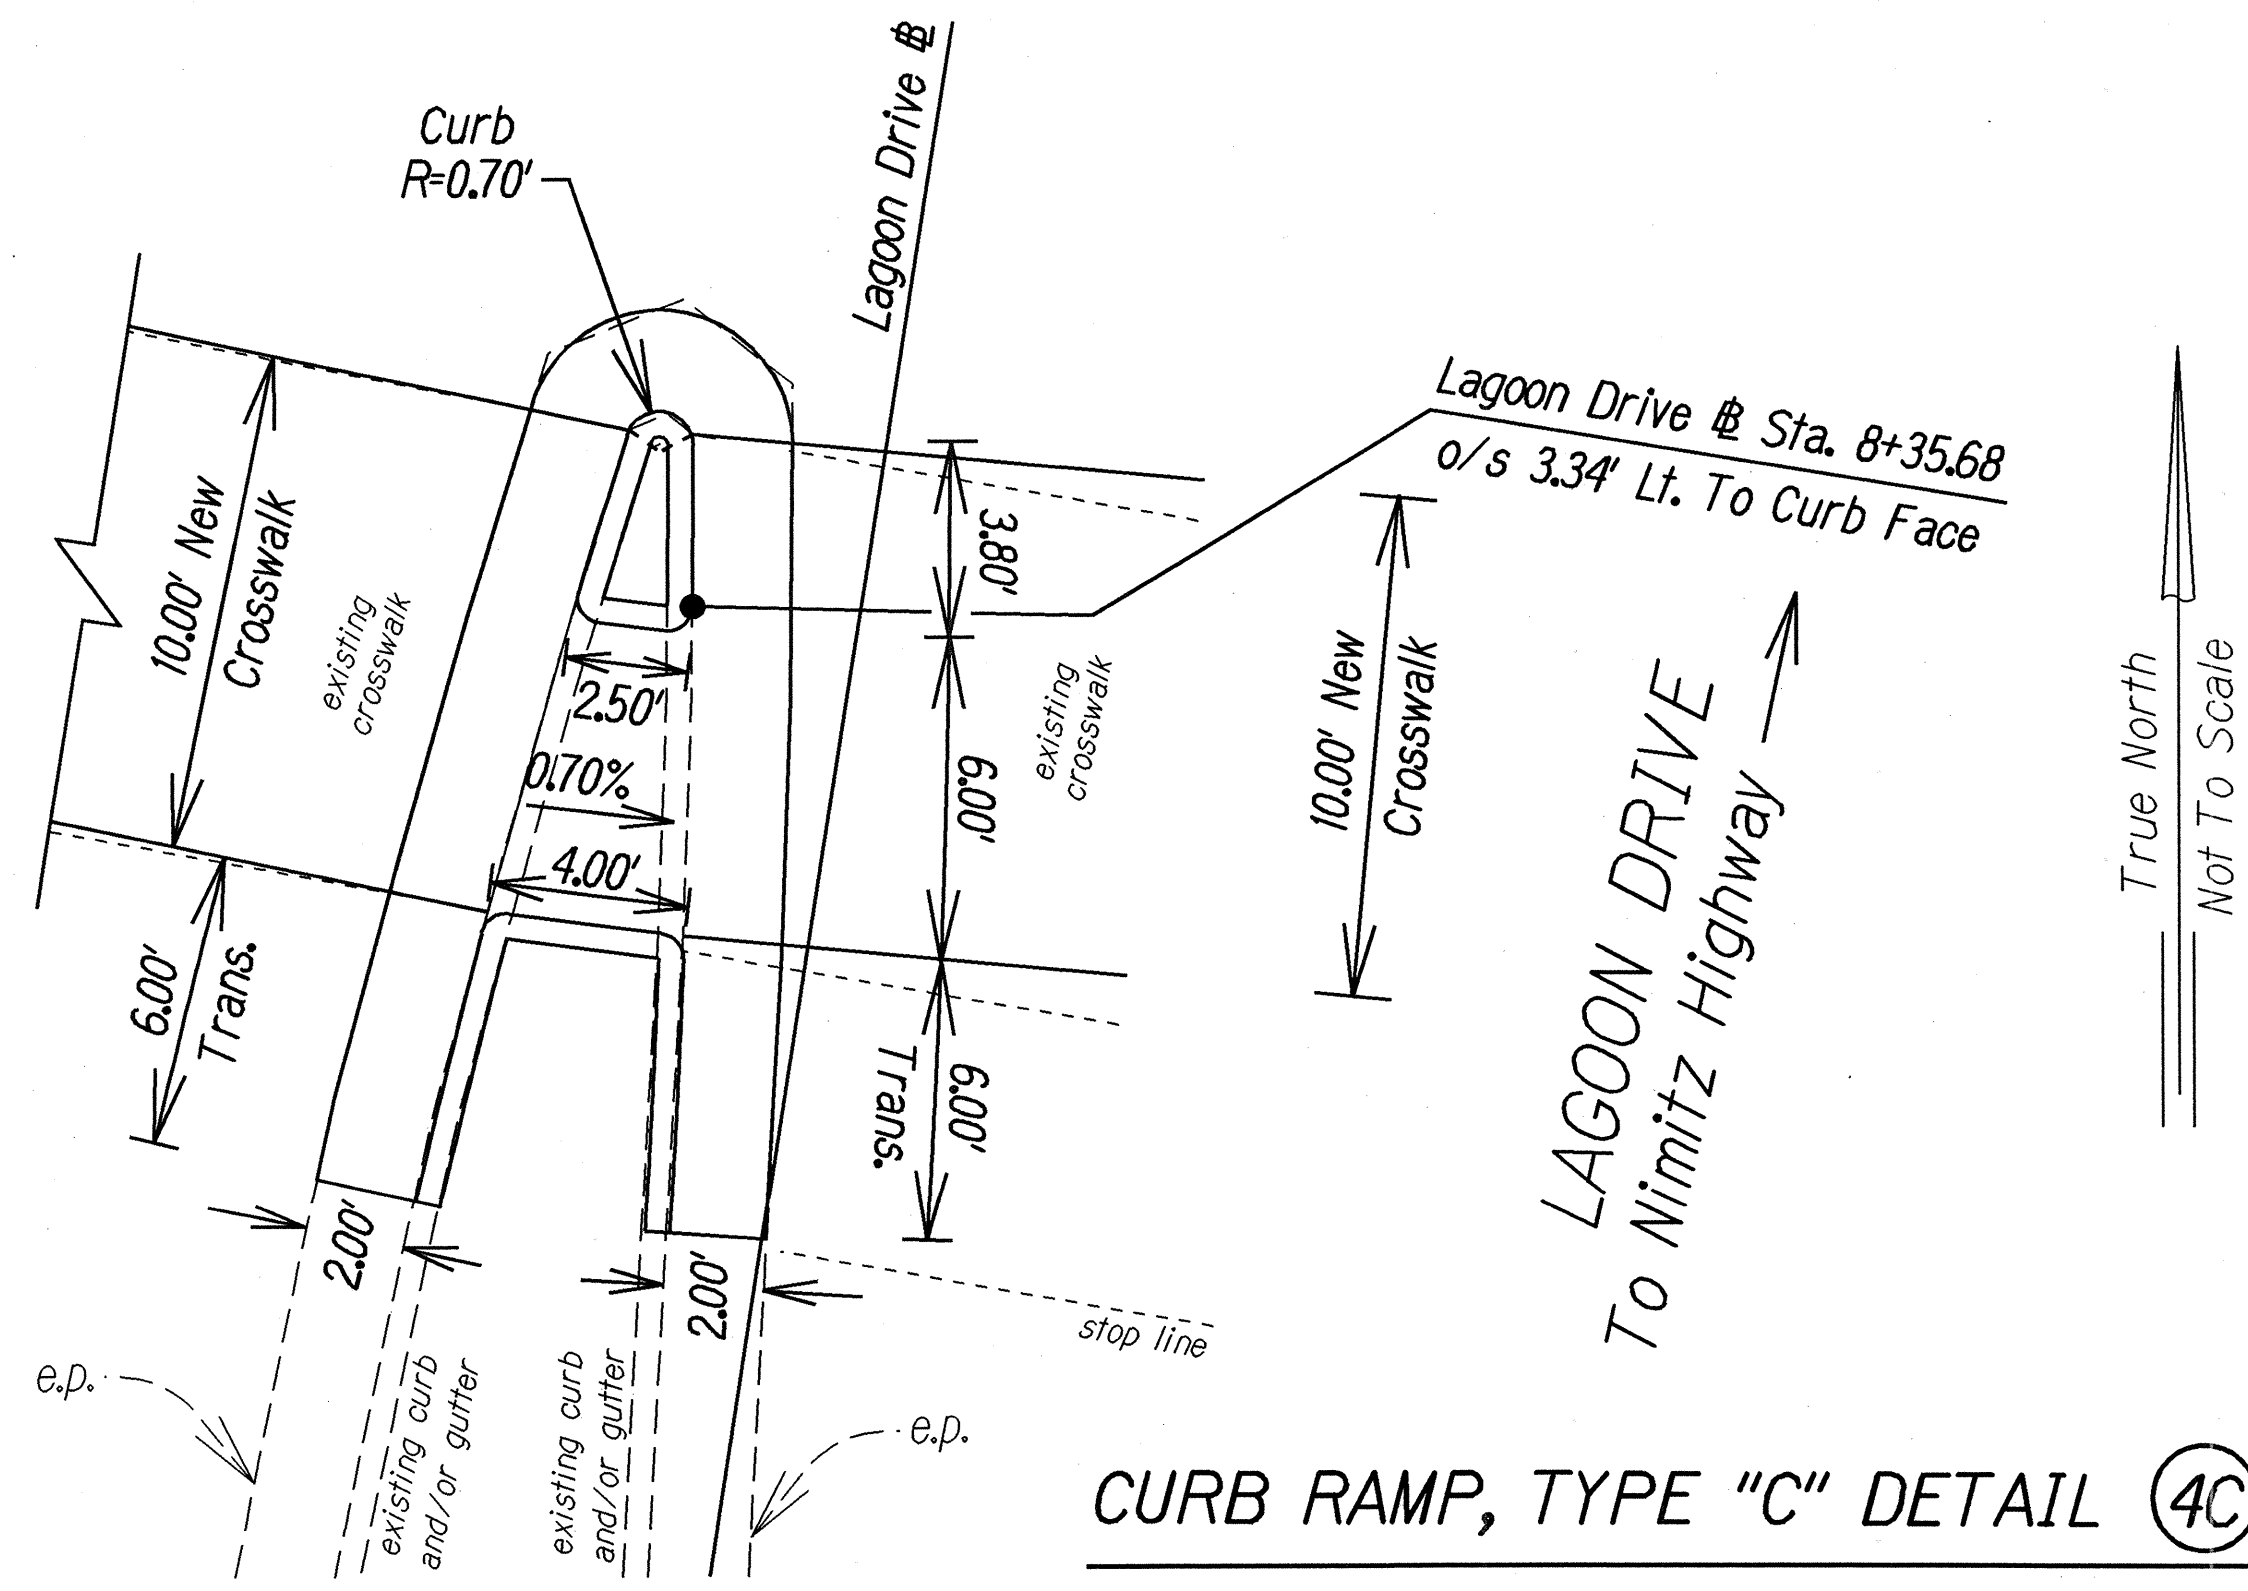


CURB RAMP, TYPE "C" DETAIL 4C
Not To Scale

ORIGINAL PLAN	DATE	01/11/02
DESIGNED BY	TRACED BY	01/11/02
NOTED BY	DESIGNED BY	
QUANTITIES BY	CHECKED BY	

1/11/02	Revised location of New Standard Curb from within the sidewalk limit to the outside of the sidewalk limit.
DATE	REVISION
STATE OF HAWAII DEPARTMENT OF TRANSPORTATION HIGHWAYS DIVISION DETAILS PEDESTRIAN FACILITIES and ADA COMPLIANCE Various Locations On Oahu Federal Aid Project No. CMAQ-0300(83) Not To Scale Date: Feb., 2001	
SHEET No. 7 OF 9 SHEETS	

FED. ROAD DIST. NO.	STATE	FED. AID PROJ. NO.	FISCAL YEAR	SHEET NO.	TOTAL SHEETS
HAWAII	HAW.	CMAQ-0300(83)	2002	ADD.36	42

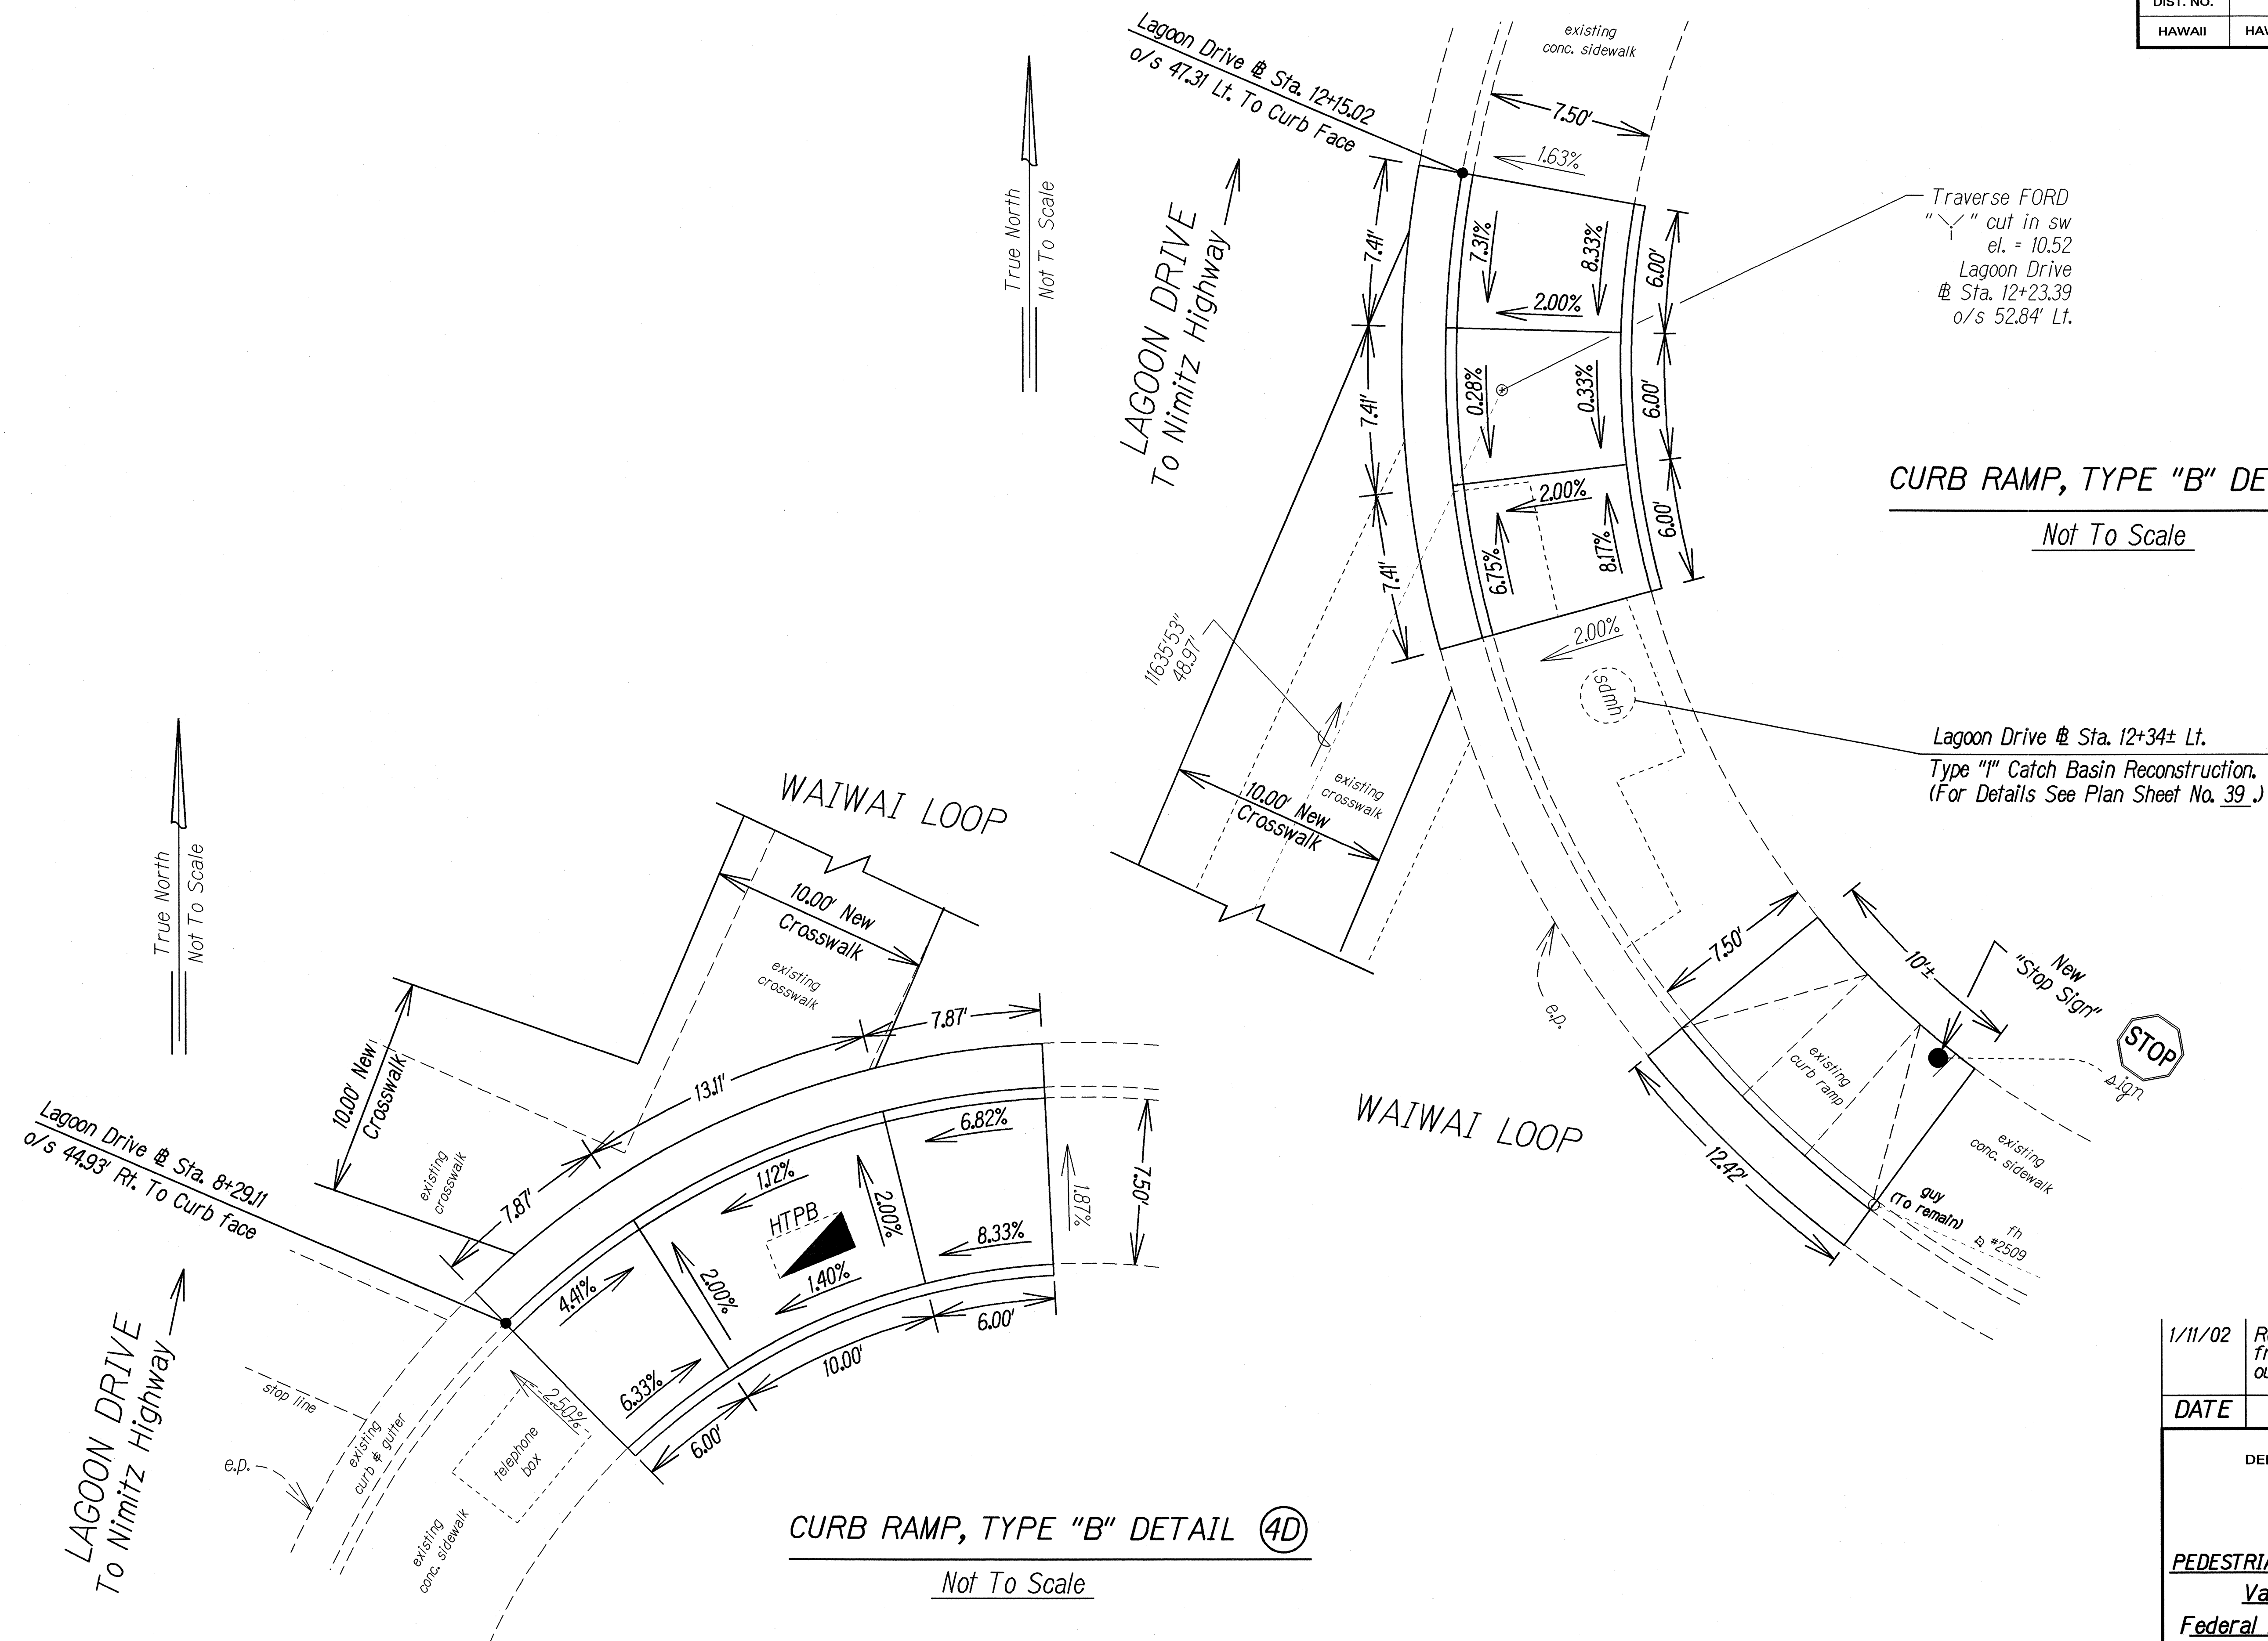

1/11/02	Revised location of New Standard Curb from within the sidewalk limit to the outside of the sidewalk limit.
---------	--

<i>DATE</i>	<i>REVISION</i>
-------------	-----------------

STATE OF HAWAII
DEPARTMENT OF TRANSPORTATION
HIGHWAYS DIVISION

DETAILS

PEDESTRIAN FACILITIES and ADA COMPLIANCE


Various Locations On Oahu

Federal Aid Project No. CMAQ-0300(83)

Not To Scale Date: Feb., 2001

SHEET No. 8 OF 9 SHEETS

FED. ROAD DIST. NO.	STATE	FED. AID PROJ. NO.	FISCAL YEAR	SHEET NO.	TOTAL SHEETS
HAWAII	HAW.	CMAQ-0300(83)	2002	ADD.37	42

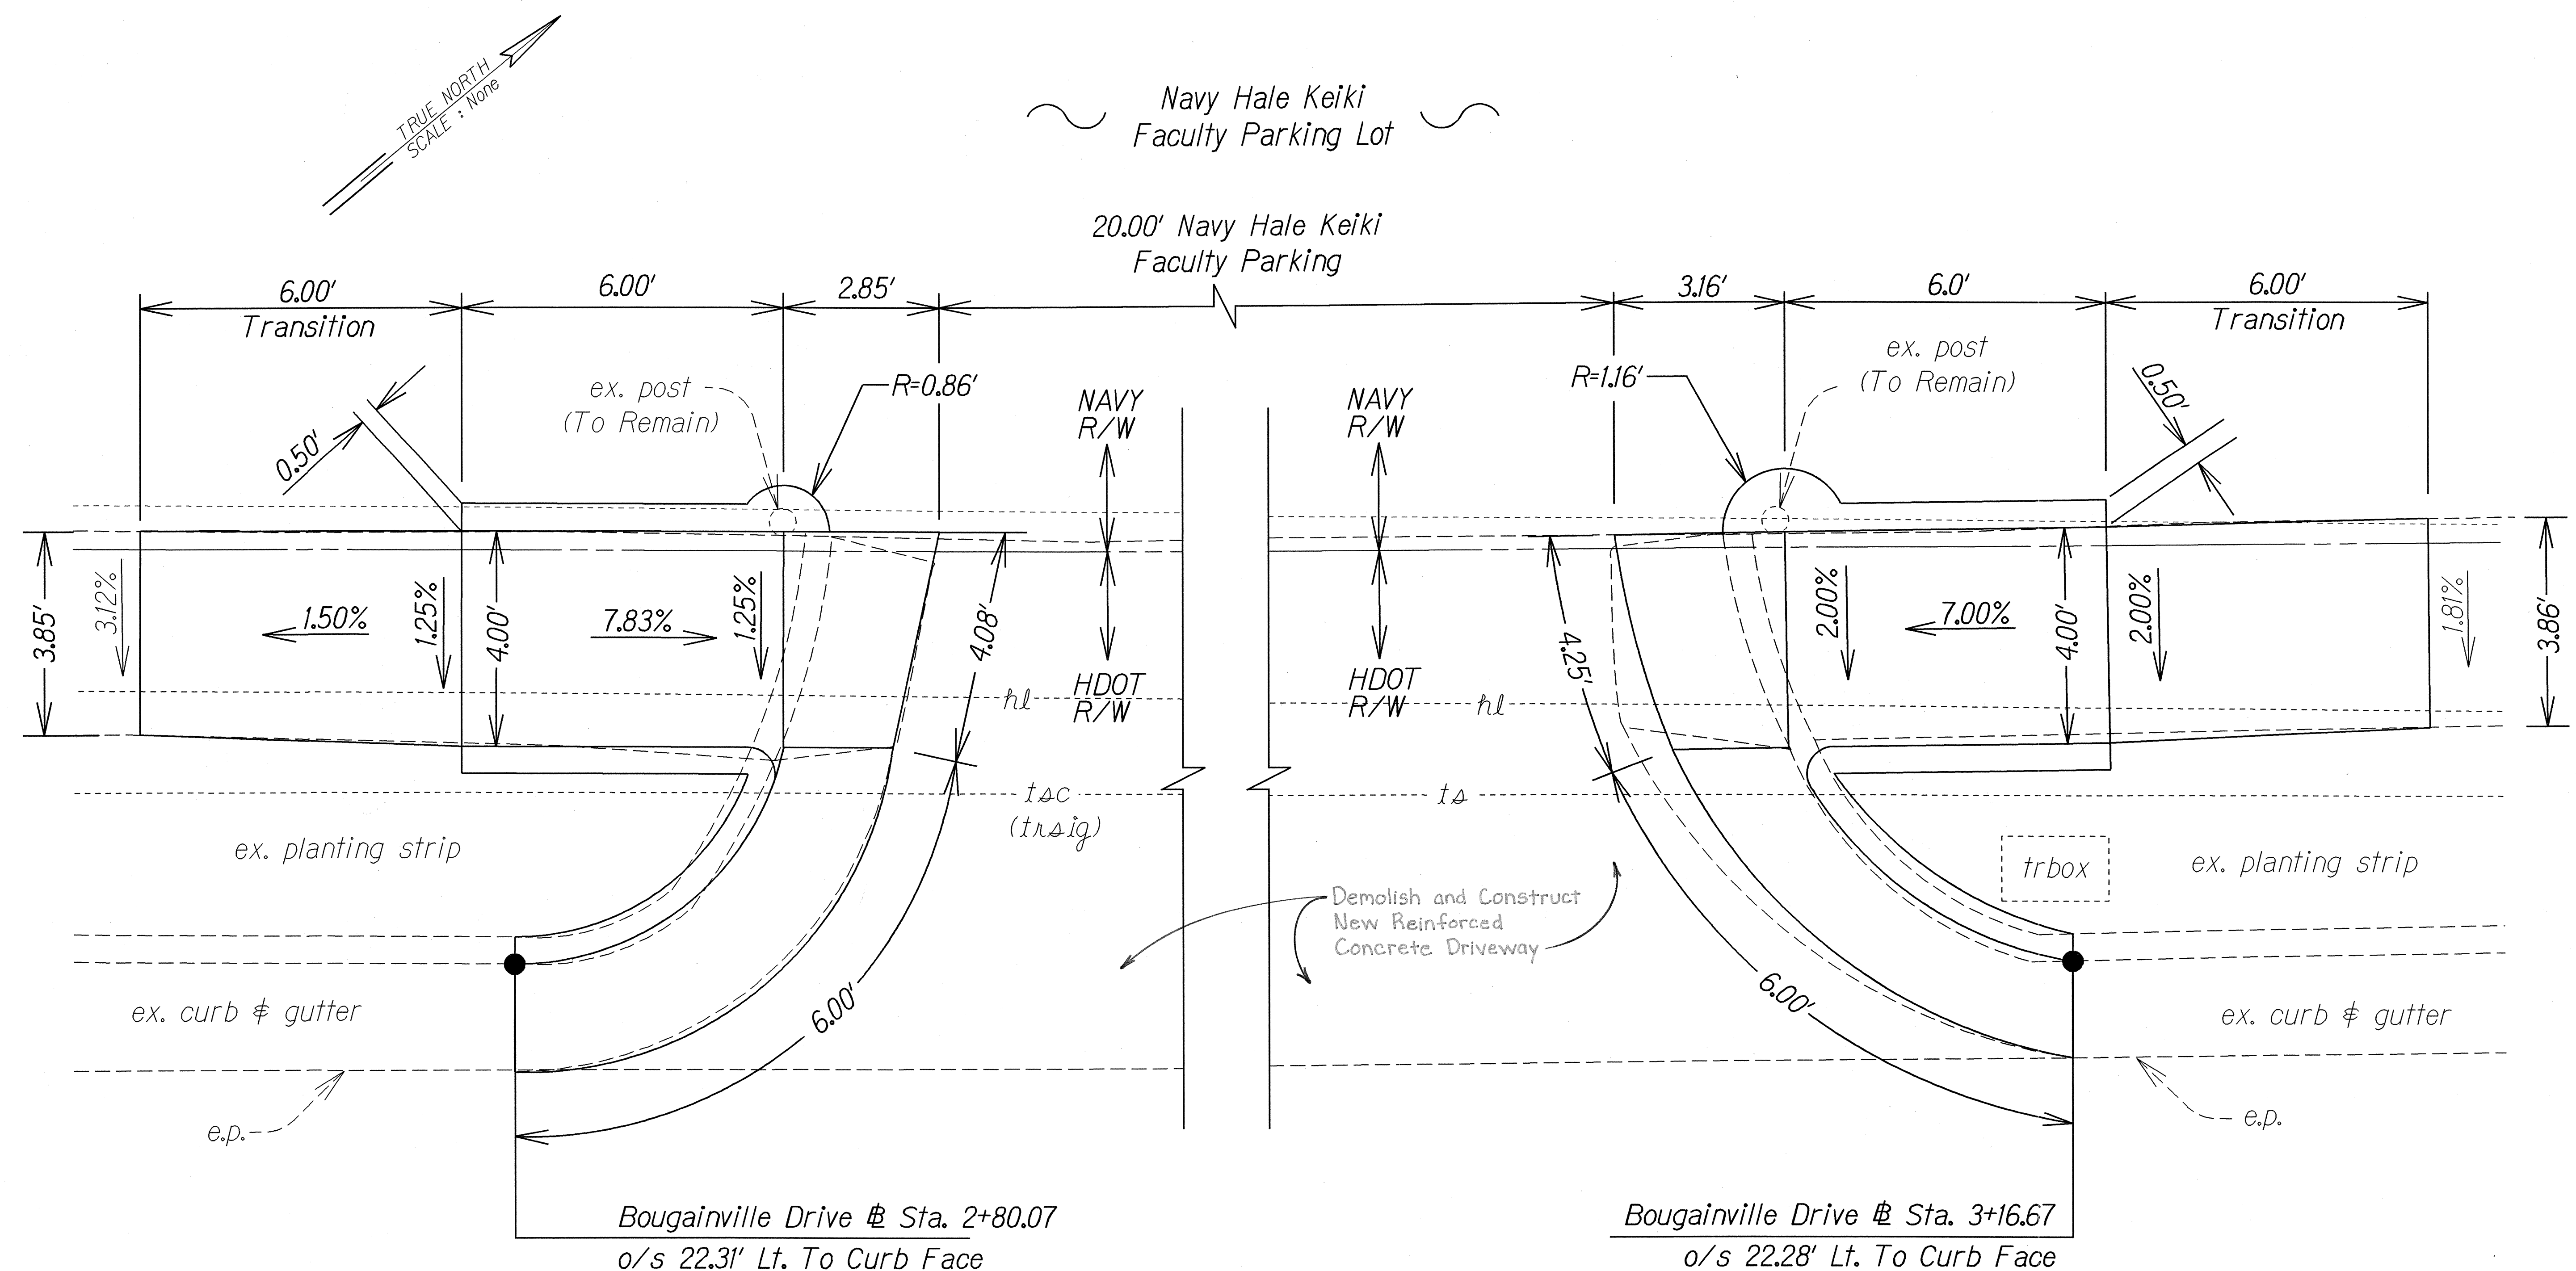

BOUGAINVILLE DRIVE
← To (Radford Drive) Honolulu

CURB RAMP, TYPE "D" MODIFIED DETAIL (5A)
Not to Scale

CURB RAMP, TYPE "D" MODIFIED DETAIL (5B)
Not to Scale

1/8/02	Added Curb Ramp dimensions, labels and call-out, and revised Radius around the existing post to remain.
DATE	REVISION
STATE OF HAWAII DEPARTMENT OF TRANSPORTATION HIGHWAYS DIVISION DETAILS PEDESTRIAN FACILITIES and ADA COMPLIANCE Various Locations on Oahu Federal Aid Project No. CMAQ-0300(83) Not to Scale Date: Dec., 2001	
SHEET No. 9 OF 9 SHEETS	

"AS-BUILT"

ADD.37