	INDEX TO DRAWINGS
SHEET NO.	DESCRIPTION
1	TITLE SHEET
2	STANDARD PLAN SUMMARY
3	GENERAL NOTES
4 – 5	TYPICAL SECTIONS
6 – 7	WATER POLLUTION & EROSION CONTROL NOTES
8 – 11	CURB RAMP NOTES AND DETAILS
12 – 28	LAYOUT PLAN AND PLAN SHEETS
29 – 37	DETAIL PLANS
38 – 42	DRAINAGE PLANS
,	
^	
	·

STATE OF HAWAII

DEPARTMENT OF TRANSPORTATION


HIGHWAYS DIVISION HONOLULU, HAWAII

PLANS FOR

PEDESTRIAN FACILITIES AND ADA COMPLIANCE


VARIOUS LOCATIONS ON OAHU
FEDERAL AID PROJECT NO. CMAQ-0300(83)

DISTRICTS OF WAIALUA, HONOLULU AND KOOLAUPOKO ISLAND OF OAHU

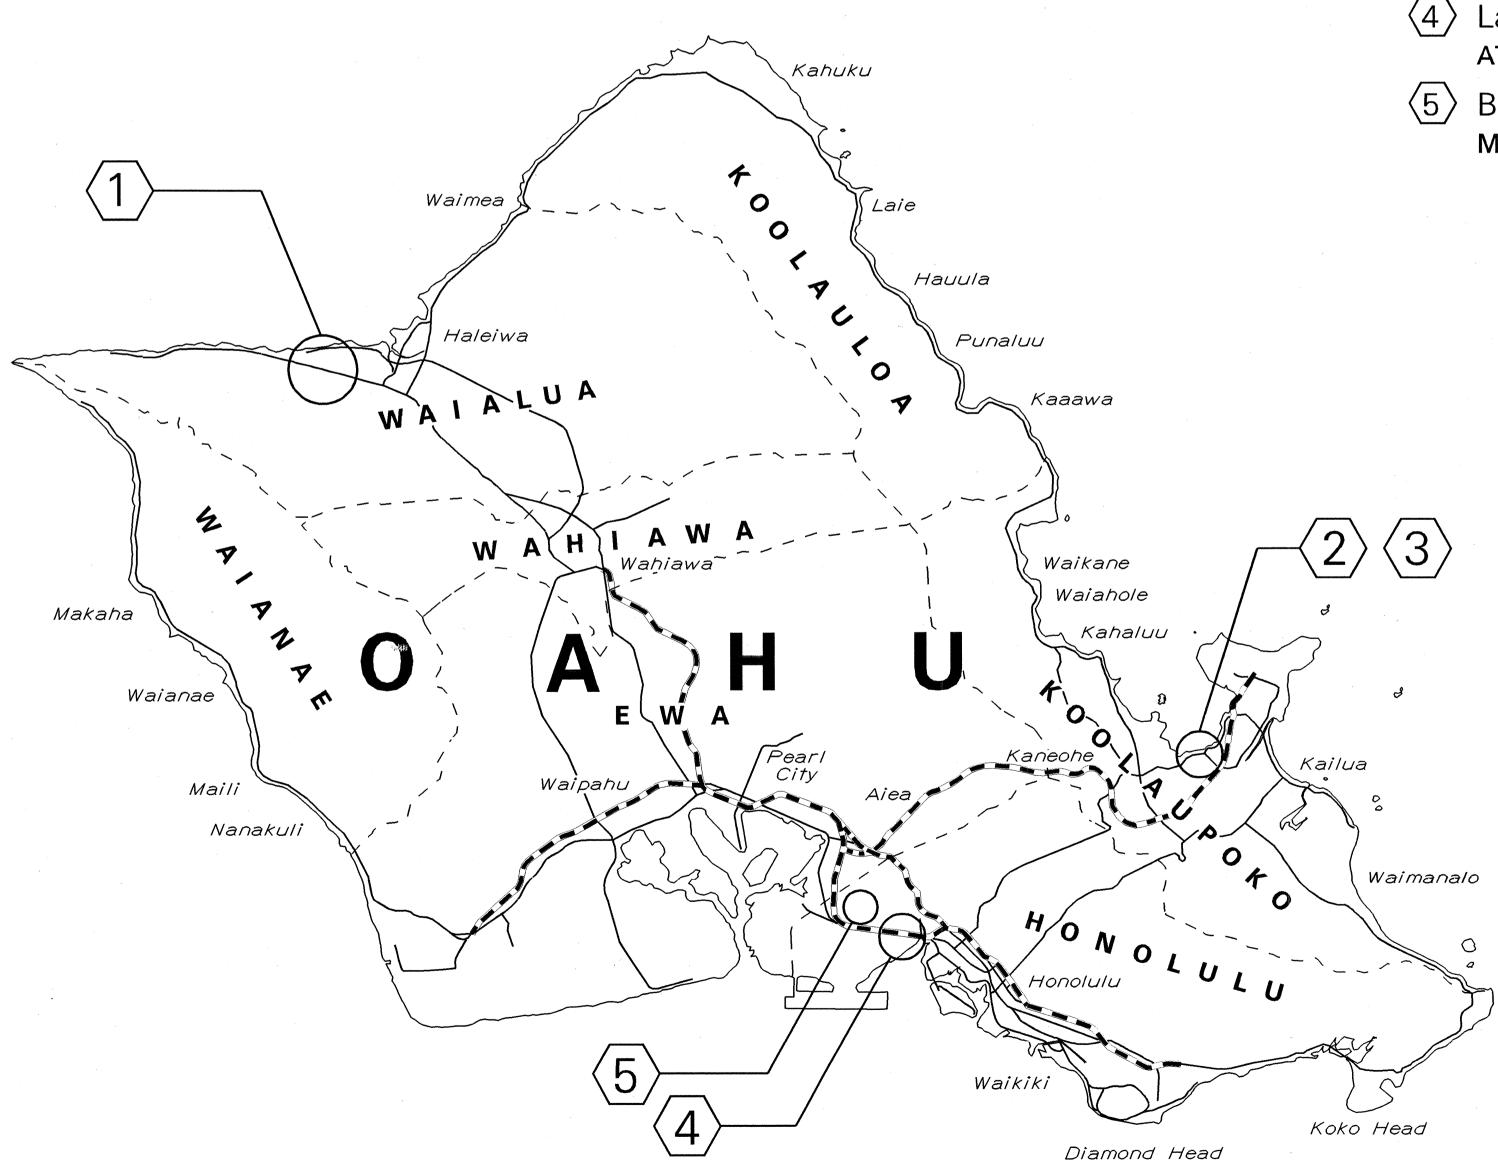

FED. ROAD DIST. NO. STATE FED. AID PROJ. NO. FISCAL SHEET TOTAL SHEETS


HAWAII HAW. CMAQ-0300(83) 2002 1 42

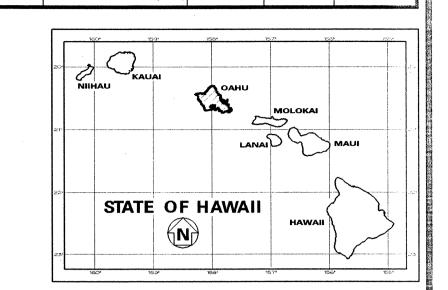

PROJECT SITES

- Farrington Highway Fronting Waialua High School MILE POST 5.75 TO MILE POST 5.90
- (2) Kaneohe Bay Drive At Bay View Market Driveway and MILE POST 1.89 TO MILE POST 1.92
- (3) Kaneohe Bay Drive At Mikiola Drive MILE POST 1.89 TO MILE POST 1.92
- 4 Lagoon Drive At Koapaka Street And Waiwai Loop AT NIMITZ HIGHWAY MILE POST 3.29
- (5) Bougainville Drive At Navy Hale Keiki Driveway

 MILE POST 0.26

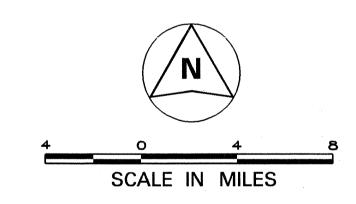

---- FEDERAL AID INTERSTATE PROJECTS PREVIOUSLY CONSTRUCTED OR UNDER CONSTRUCTION

CHANGES MADE DURING CONSTRUCTION HAVE BEEN INCORPORATED ON THESE PLANS EXCEPT CHANGES IN THE ORIGINAL THEORETICAL QUANTITIES. FOR ACTUAL QUANTITIES, REFER TO PROJECT LEDGER AND/OR COMPUTATION SOOK.

HESIDENT ENGINEER

CHANGES MADE DURING CONSTRUCTION HAVE BEEN GOVERNMENT OF THE PROJECT LEDGER

AND/OR COMPUTATION SOOK.

RESIDENT ENGINEER

DEPARTMENT OF TRANSPORTATION
STATE OF HAWAII

APPROVED:

For Mile 127-01

FOR DIR. OF TRANSPORTATION DATE

1