

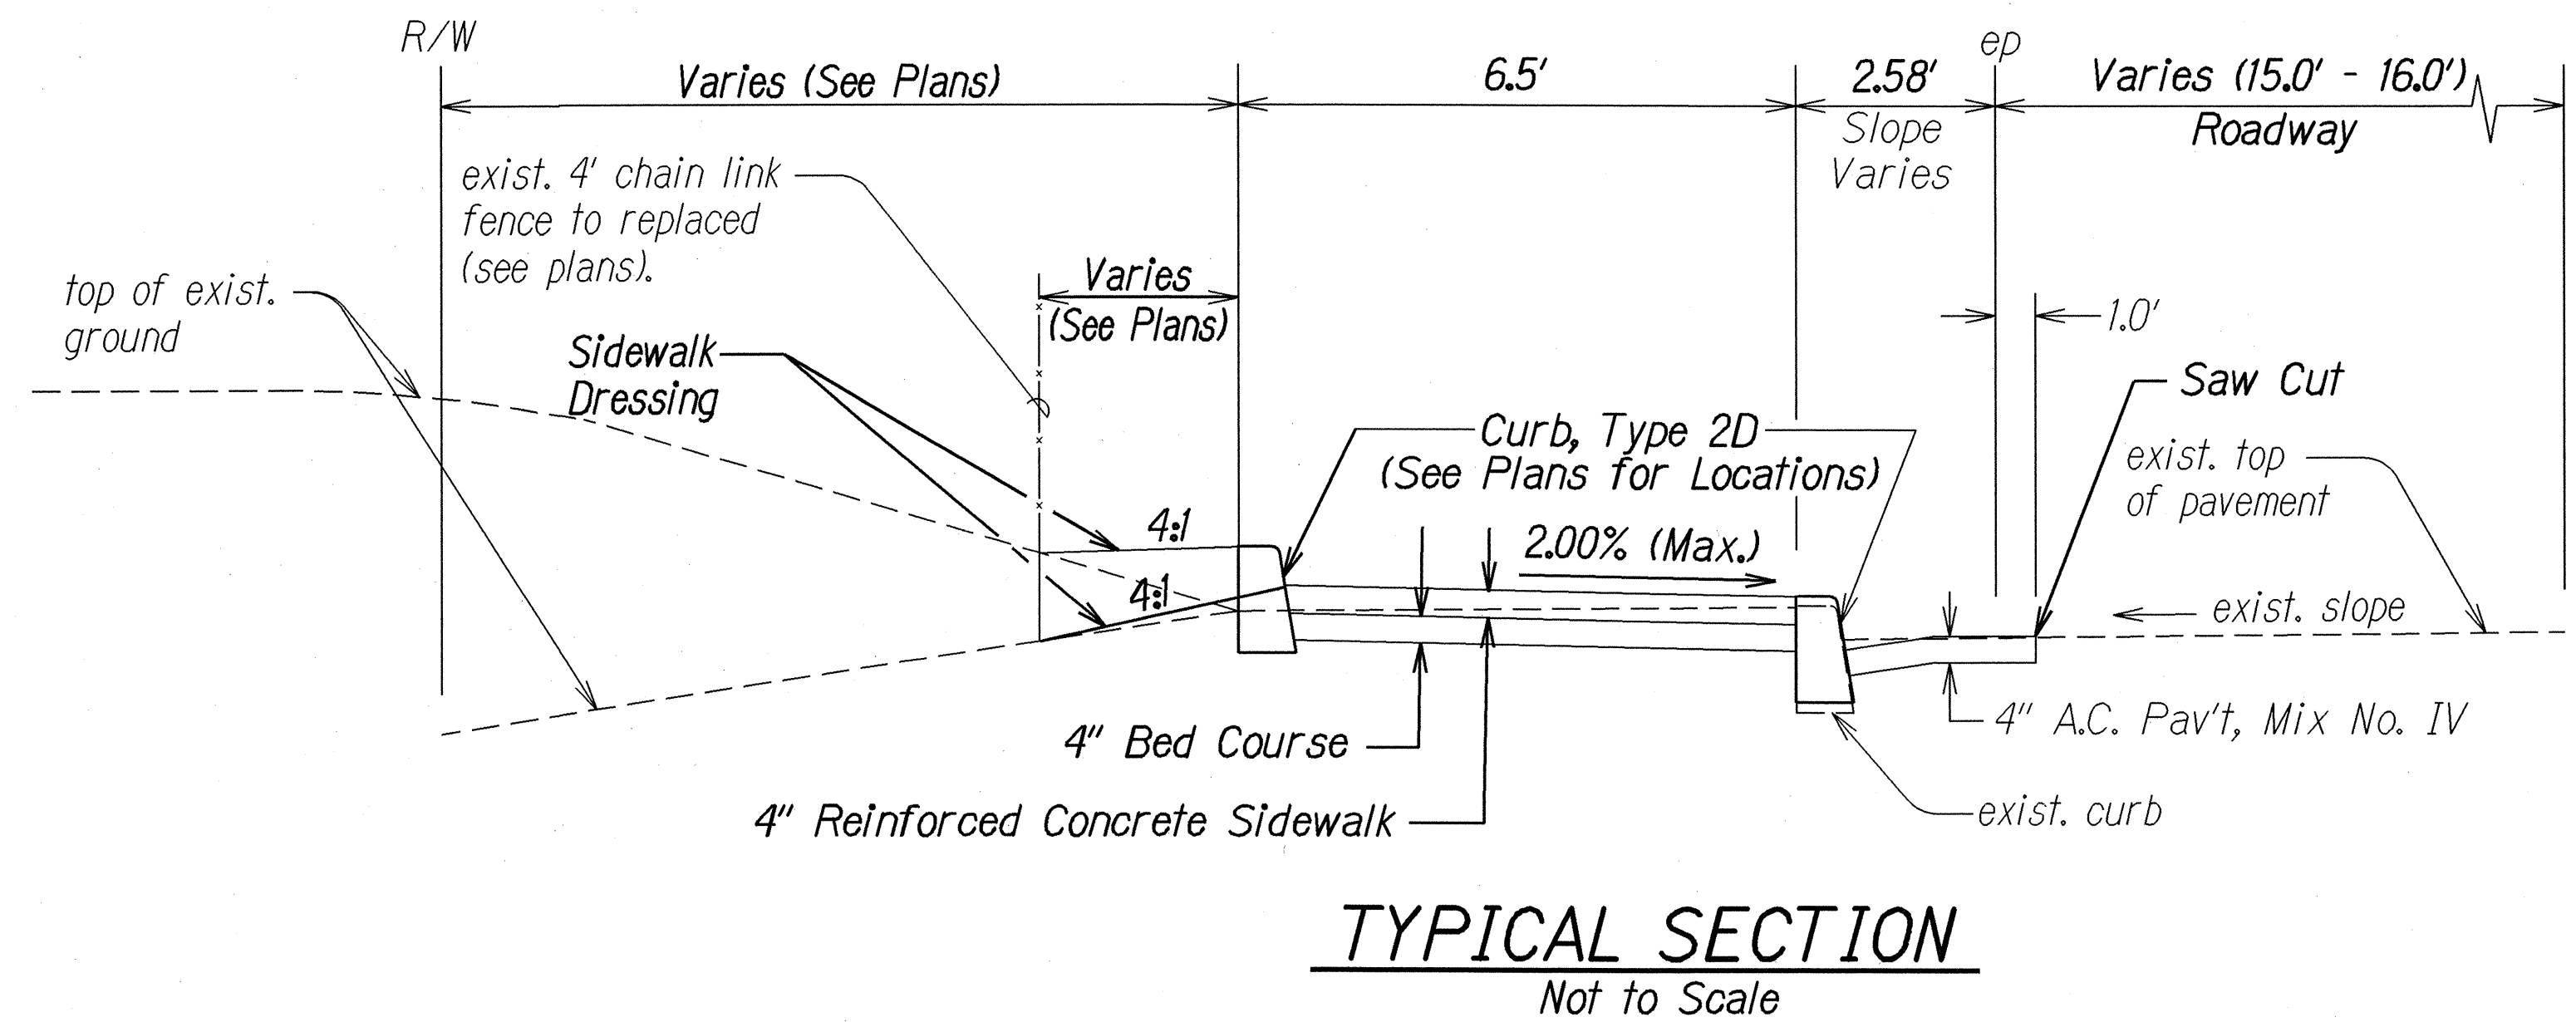



FED. ROAD DIST. NO.	STATE	FED. AID PROJ. NO.	FISCAL YEAR	SHEET NO.	TOTAL SHEETS
HAWAII	HAW.	CMAQ-0300(83)	2002	4	42

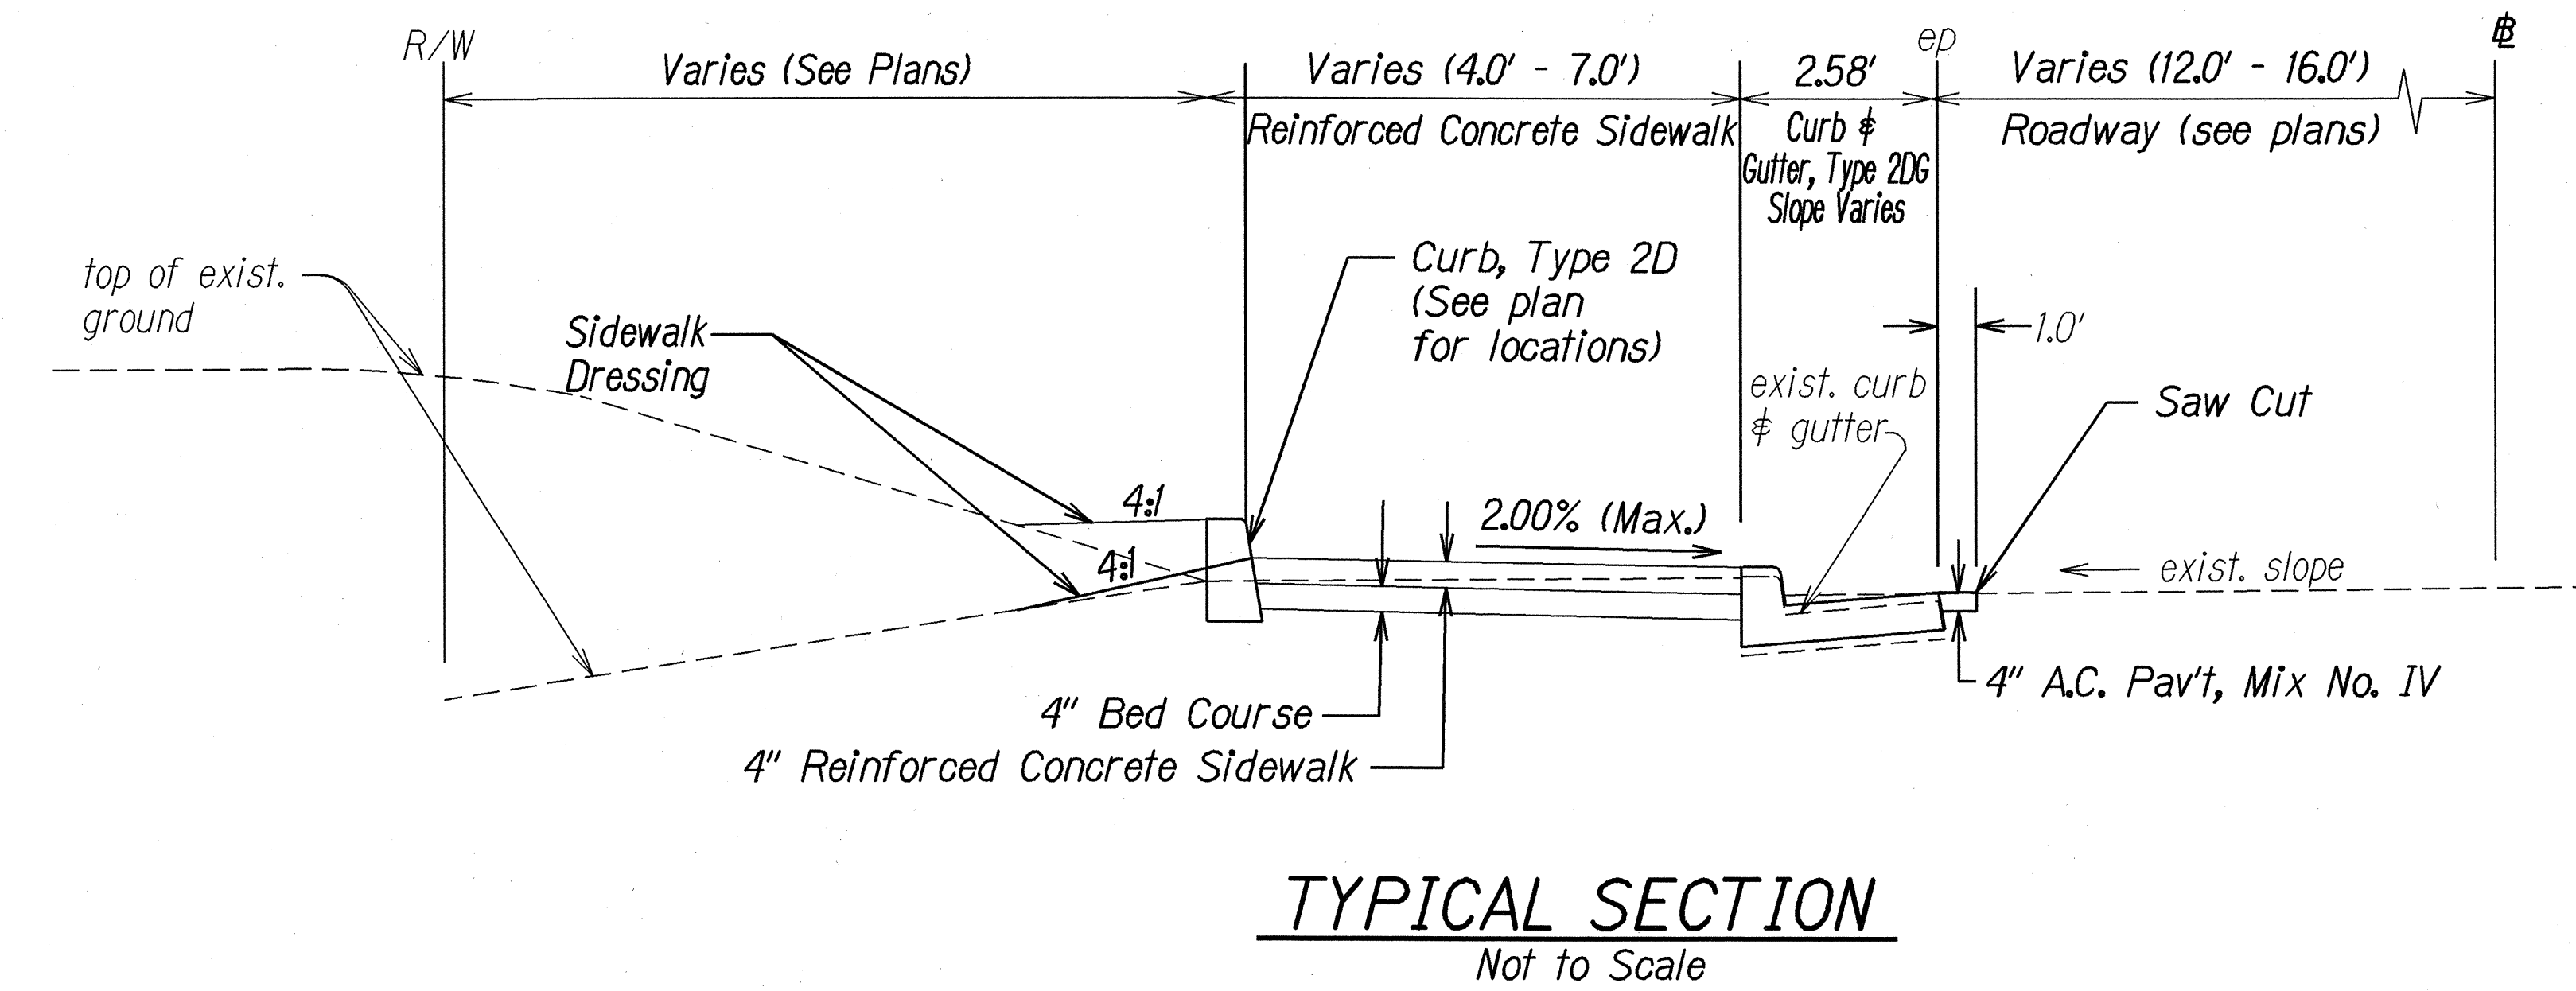

TYPICAL SECTION
Not to Scale
FARRINGTON HIGHWAY
FRONTING WAIALUA HIGH SCHOOL

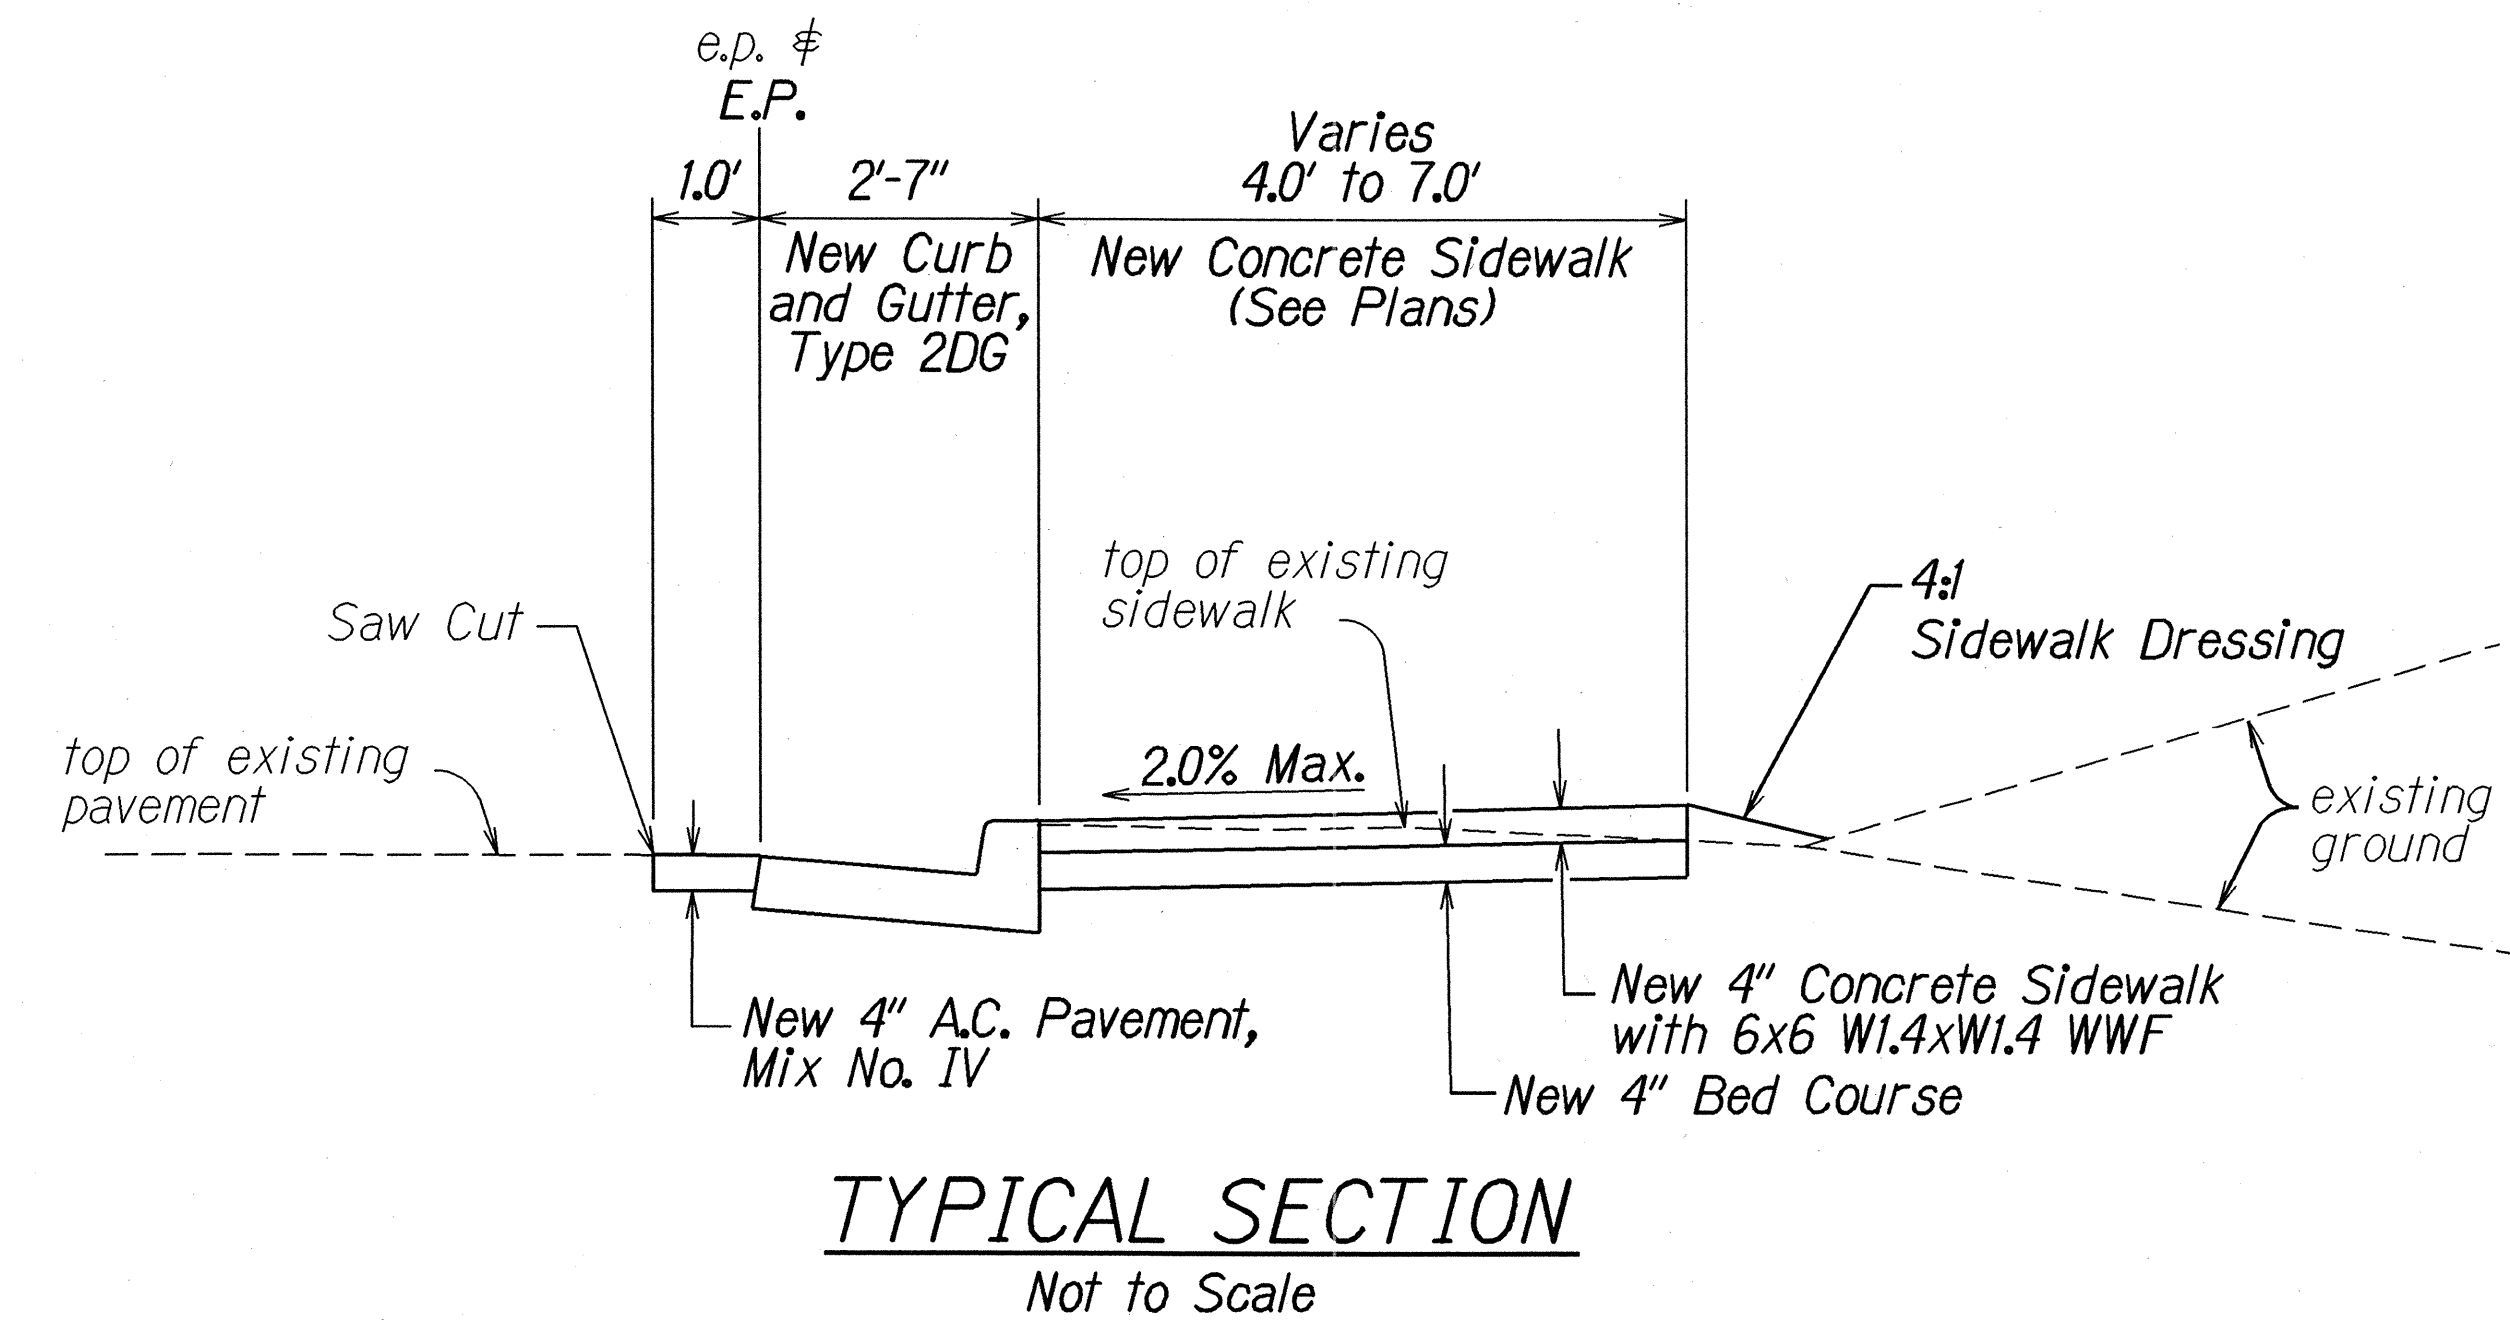

TYPICAL SECTION
Not to Scale
FARRINGTON HIGHWAY
FRONTING WAIALUA HIGH SCHOOL

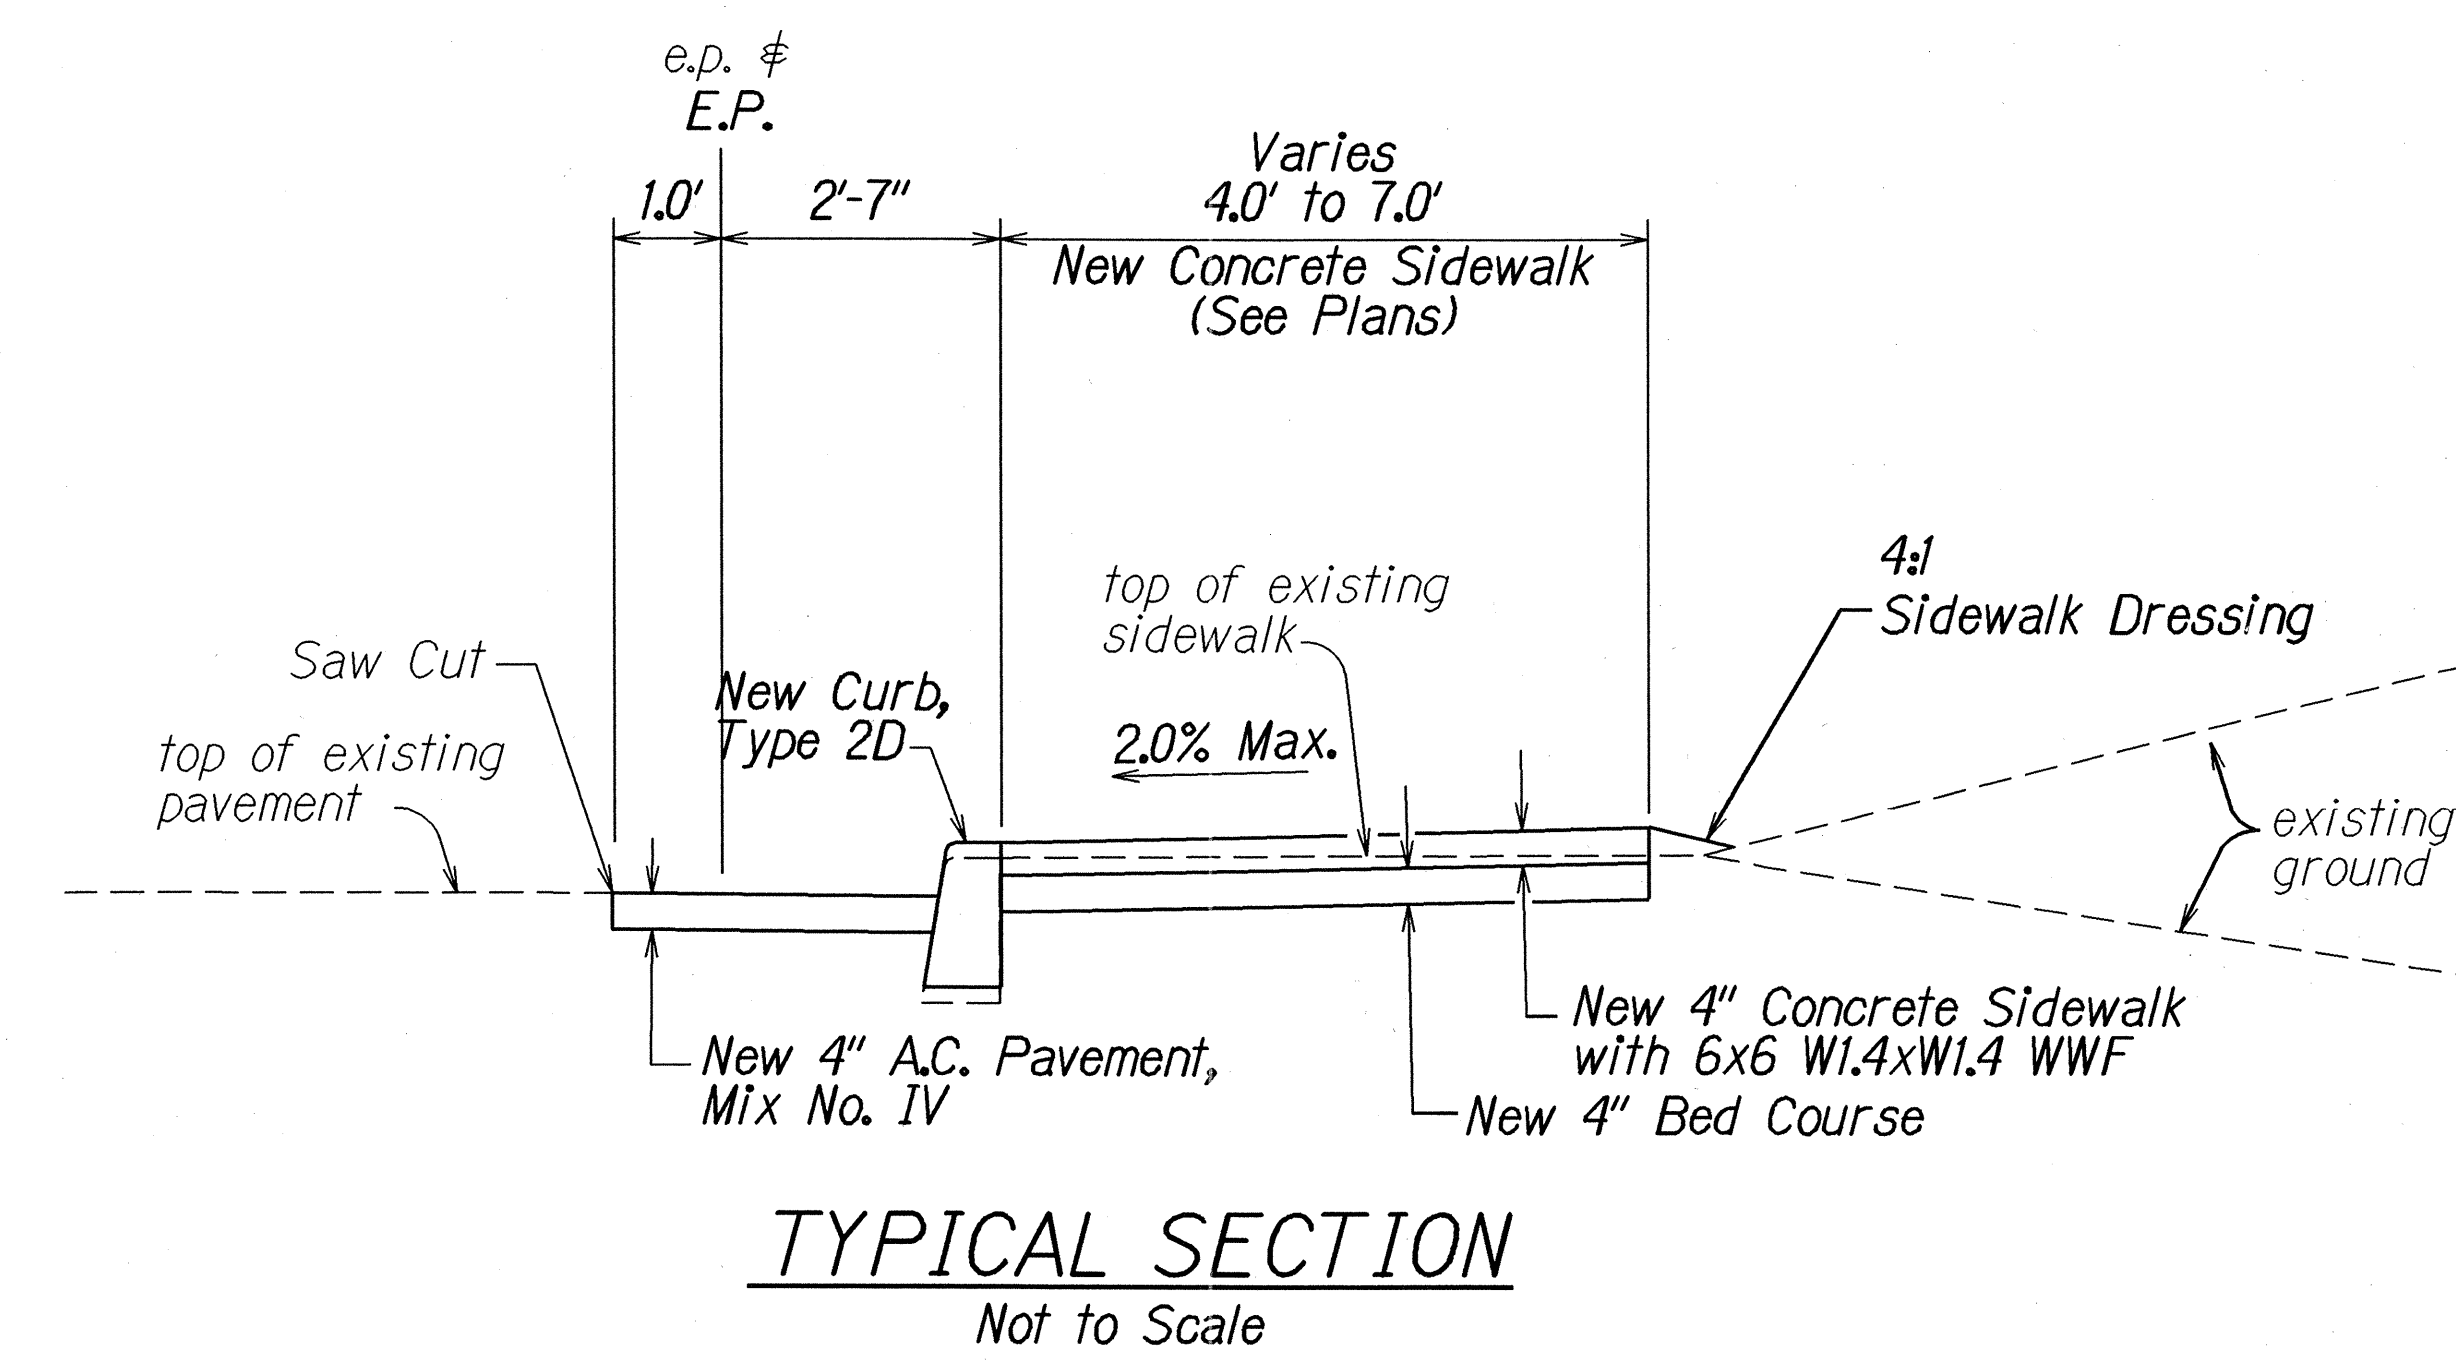

- NOTE:
1. Replace existing 4.0' chainlink fence with post and/or chain gate with top rail from the finish grade. See plans.
 2. Where concrete sidewalk exists beyond the new sidewalk and outside of the Right-of-Way, saw cut the existing sidewalk and transition with new reinforced concrete sidewalk with a 2.00% maximum slope.

SURVEY PLOTTED BY	DATE
DRAWN BY	12-05-01
TRACED BY	12-05-01
NOTED BY	
CHECKED BY	
ORIGINAL	
PLAN	
NOTE BOOK	
QUANTITIES BY	
CHECKED BY	

STATE OF HAWAII
DEPARTMENT OF TRANSPORTATION
HIGHWAYS DIVISION

TYPICAL SECTIONS

Pedestrian Facilities and ADA Compliance
Various Locations On Oahu
Federal Aid Project No. CMAQ-0300(83)
Scale: None Date: Feb., 2001

SHEET No. 1 OF 2 SHEETS

