




NOT IN CONTRACT - { Street lights shall be installed in accordance with City & County Ordinance No. 1117, Class "B."
Special Fill as shown in plans shall be used for all pipelines constructed on fill areas.

NOTE: Connect JENER MAIN at
SMH #5, @ Sta. 2+86.45.
Connect DRAIN LINE at
HEADWALL, @ Sta. 3+20.00
Construct Slab Drop Driveway to parcel 3, and
Lots 4, 5, 6, 23, 24, & 25. Final locations of Driveway
shall be determined in the field by the Engineer.

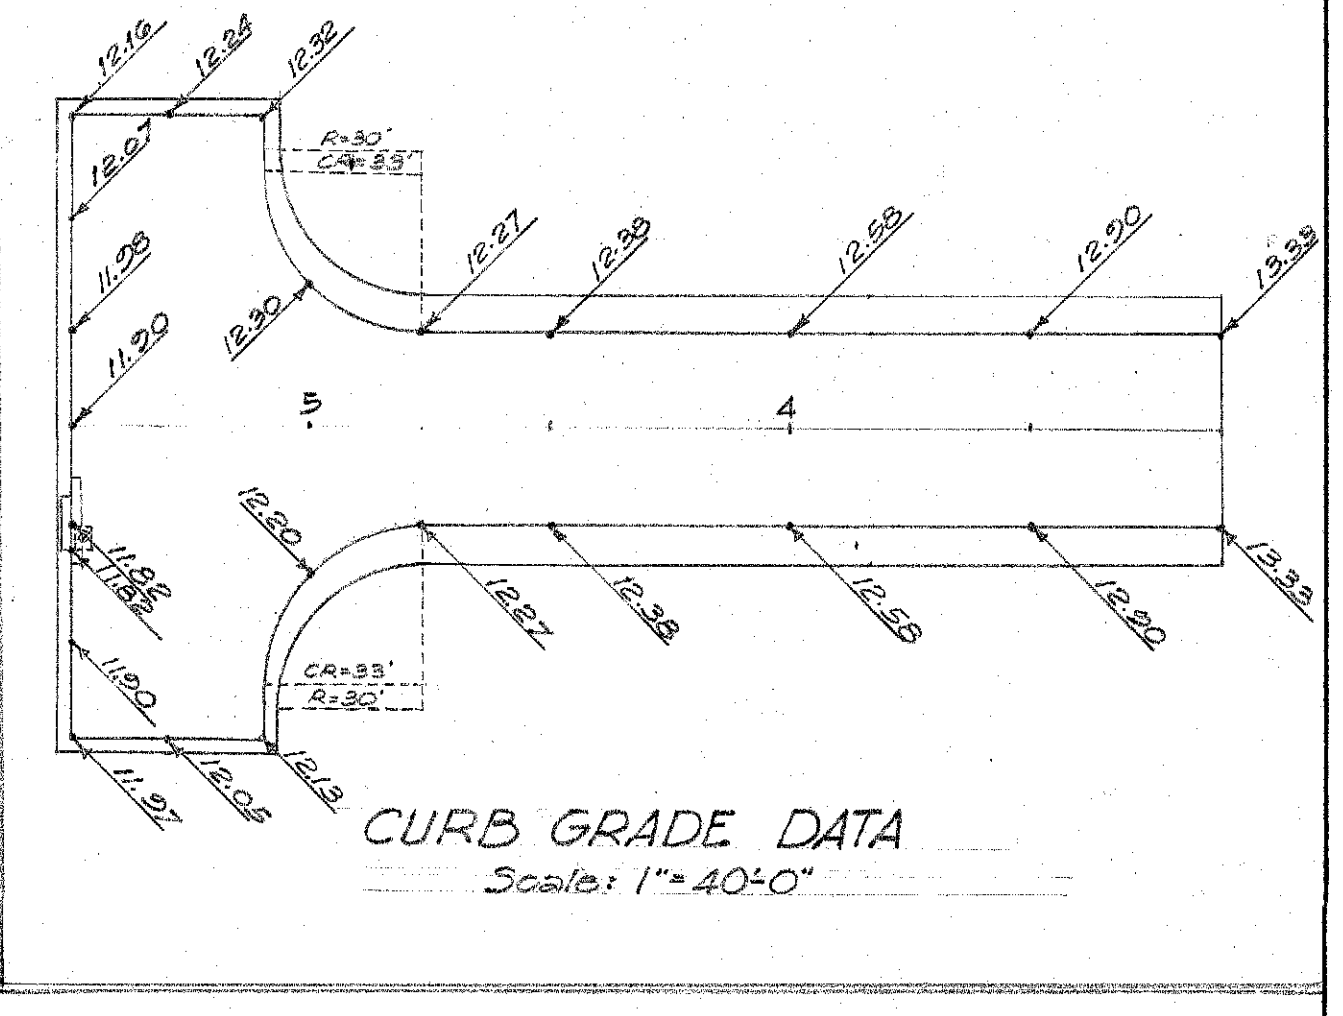