


FINAL SURVEY
NO. _____
DATE _____
BY _____
SURVEYED
PLANNED
NOTED
AREAS CHECKED

ORIGINAL SURVEY
NO. _____
DATE _____
BY _____
SURVEYED
PLANNED
NOTED
AREAS CHECKED

Rev. Apr. 1945 (Grades)

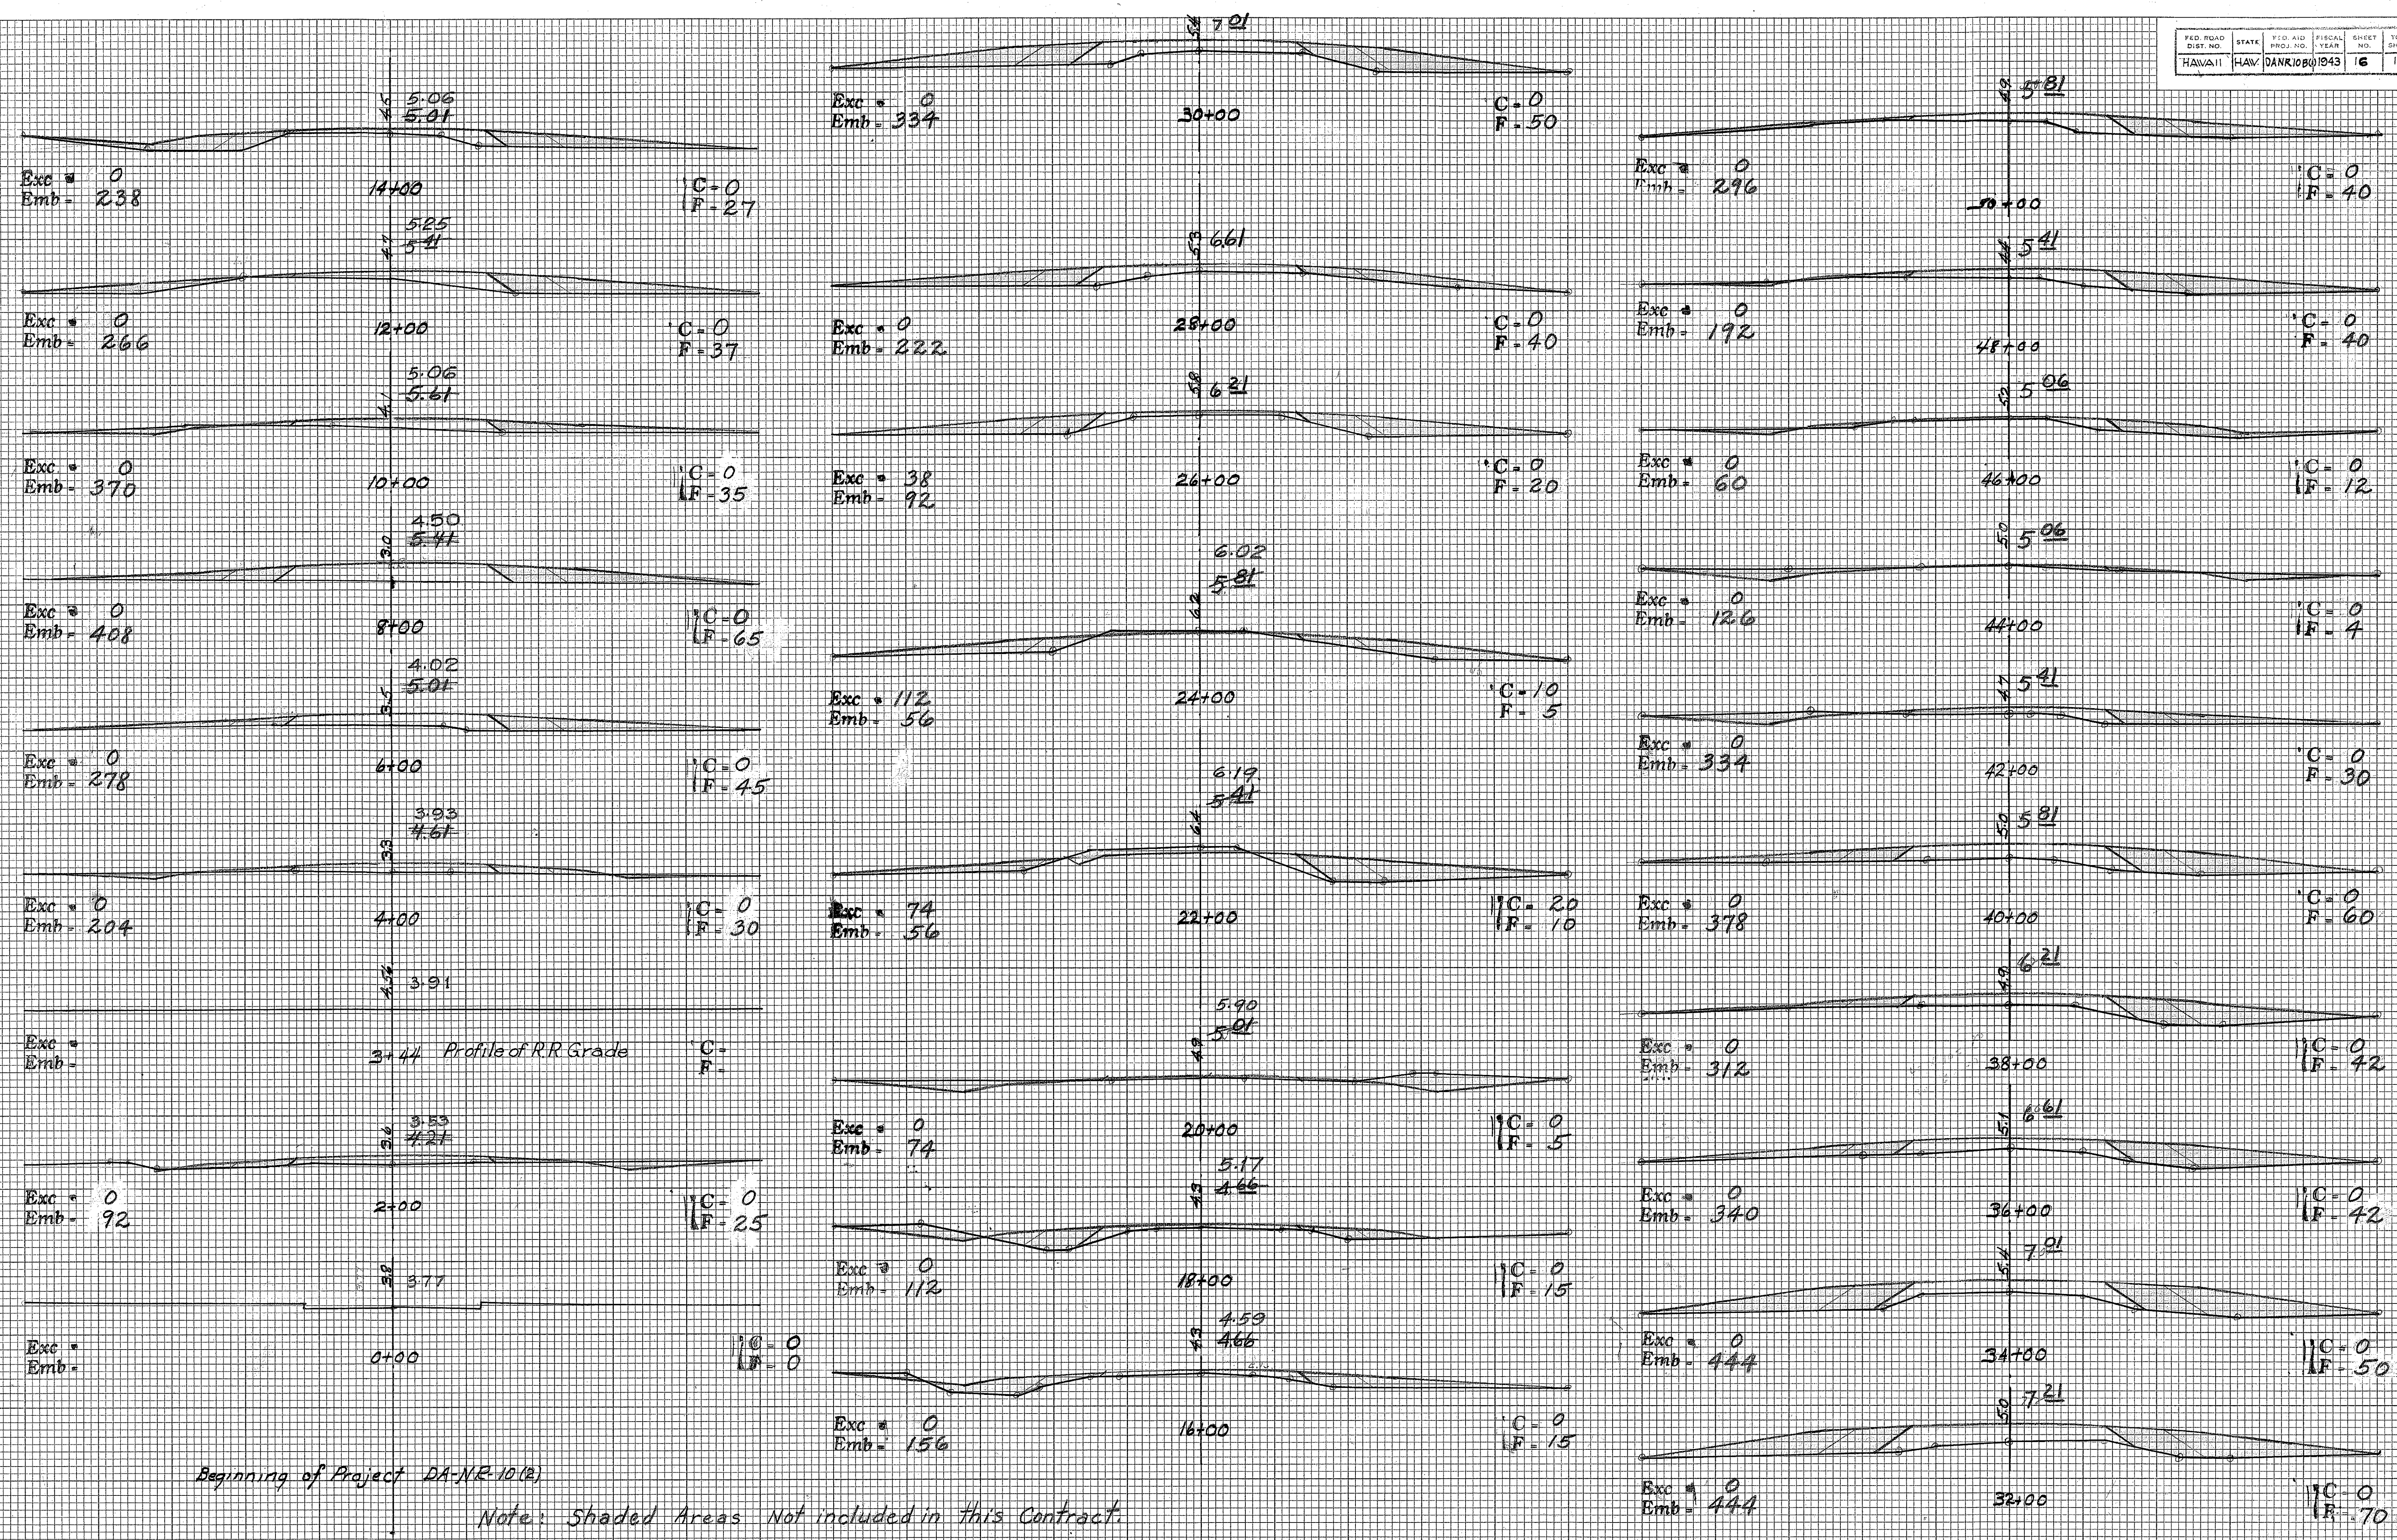


Beginning of Project DA-NR-10(2)

Note: Shaded Areas Not included in this Contract.

FINAL SURVEY	DATE	BY
	SIGNED	
NOTE BOOK	NO.	AREAS CHECKED
	SIGNED	

ORIGINAL SURVEY	DATE	BY
	SIGNED	
NOTE BOOK	NO.	AREAS CHECKED
	SIGNED	

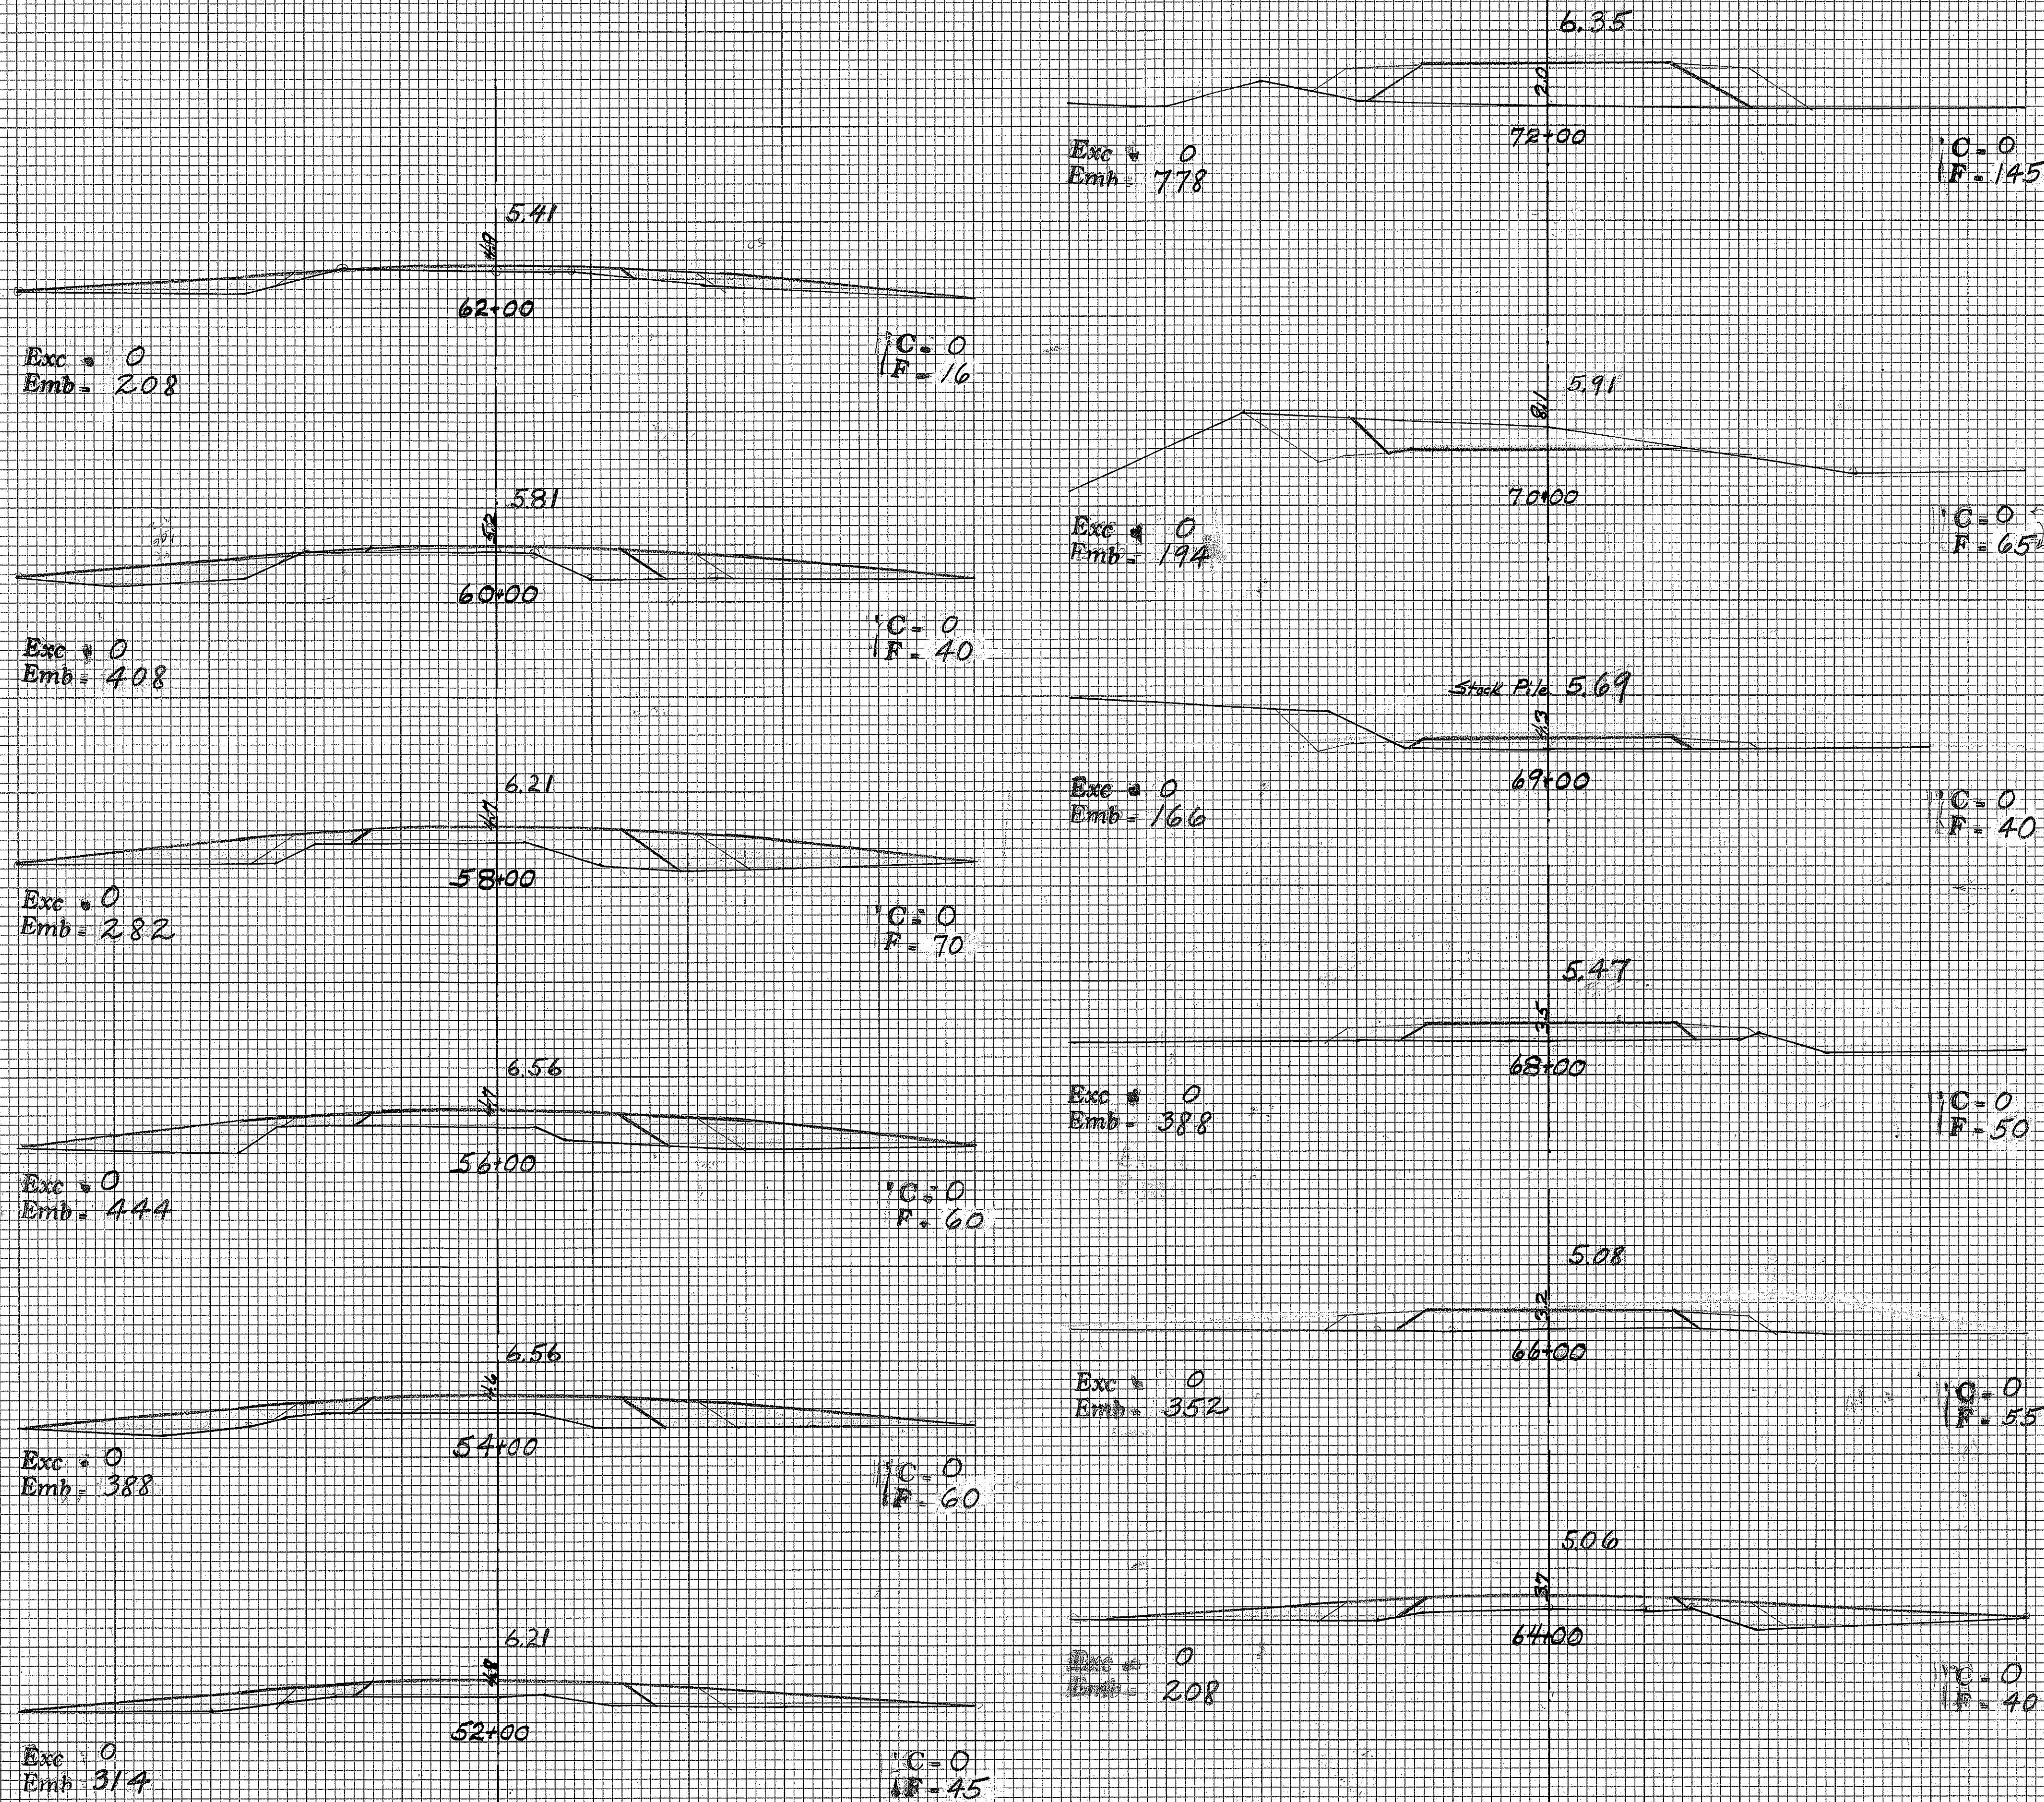

Note: Shaded Areas not included in this Contract.