

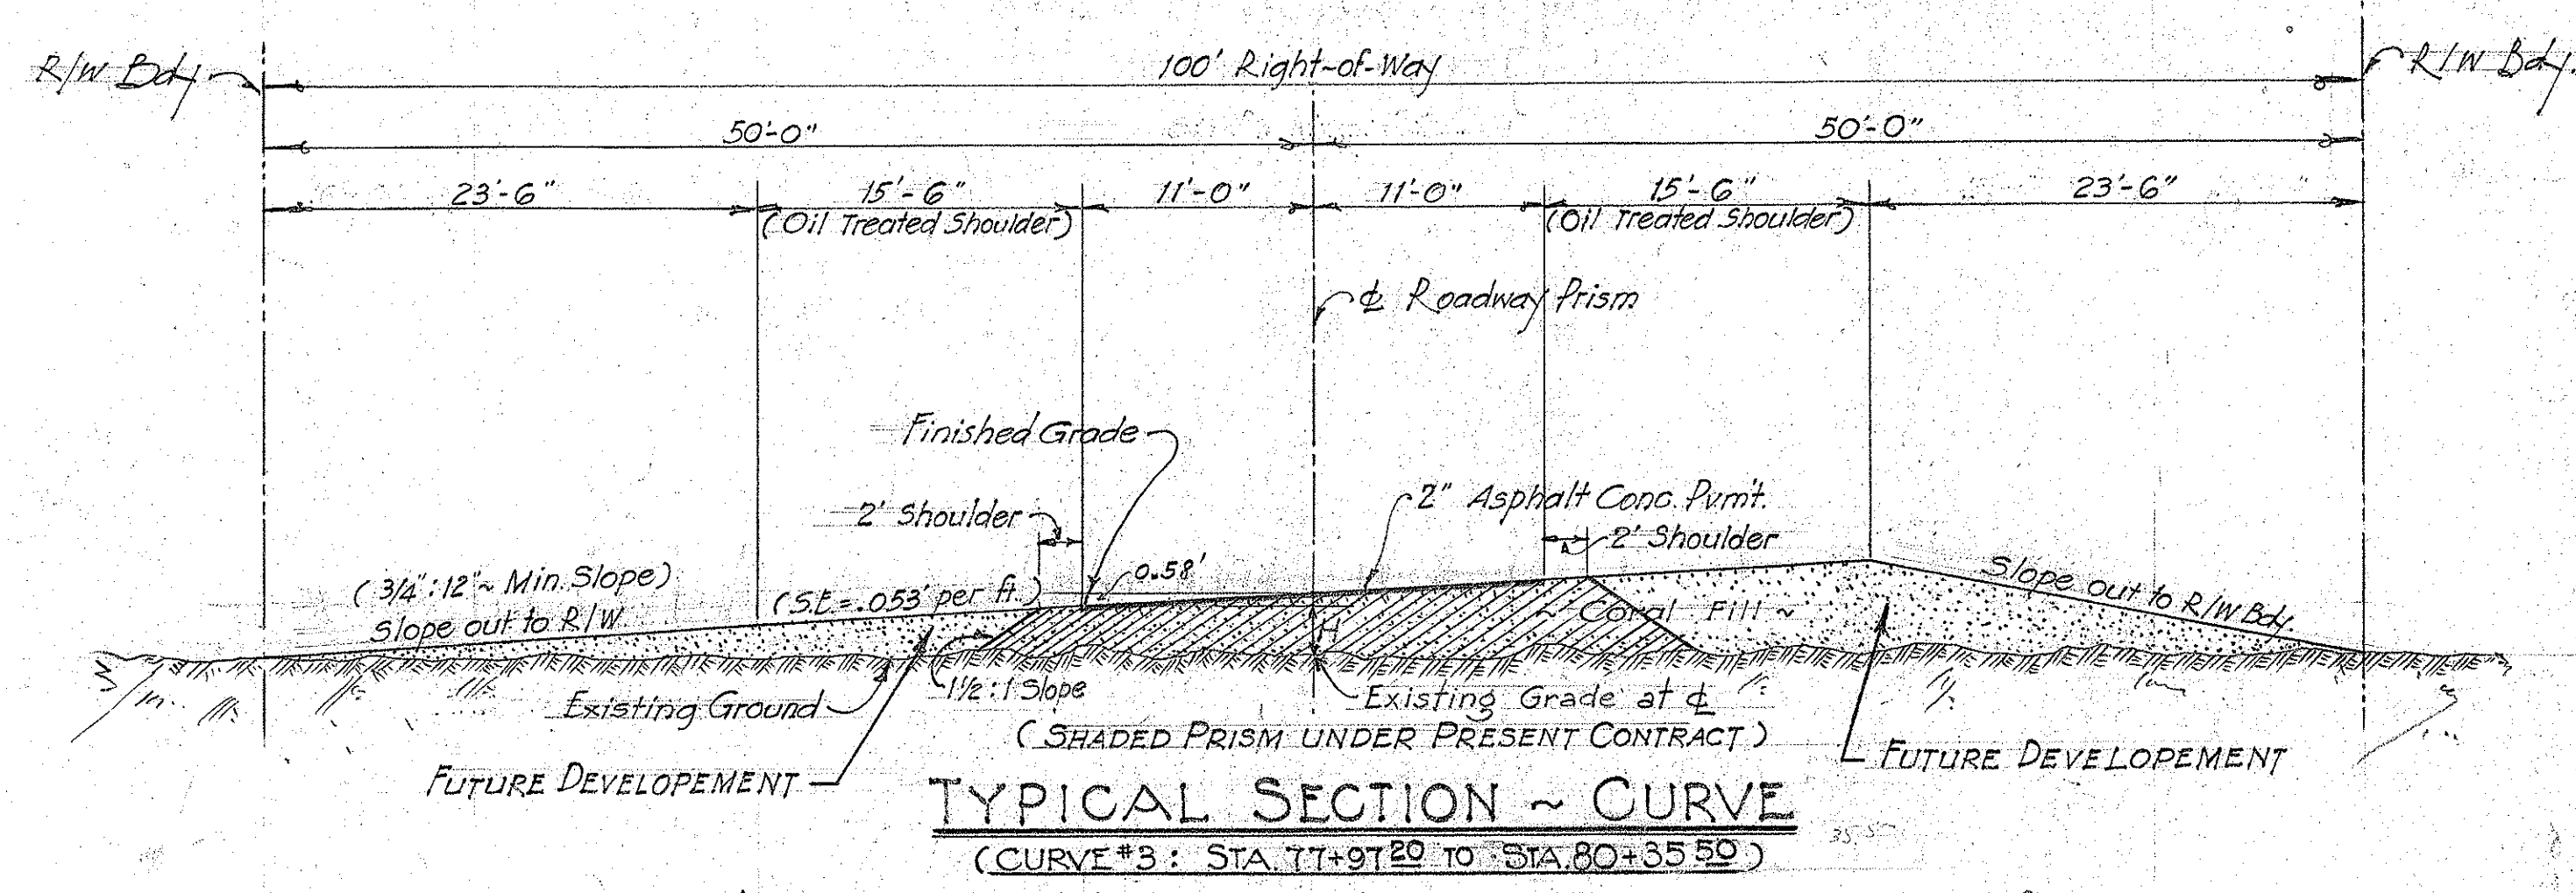
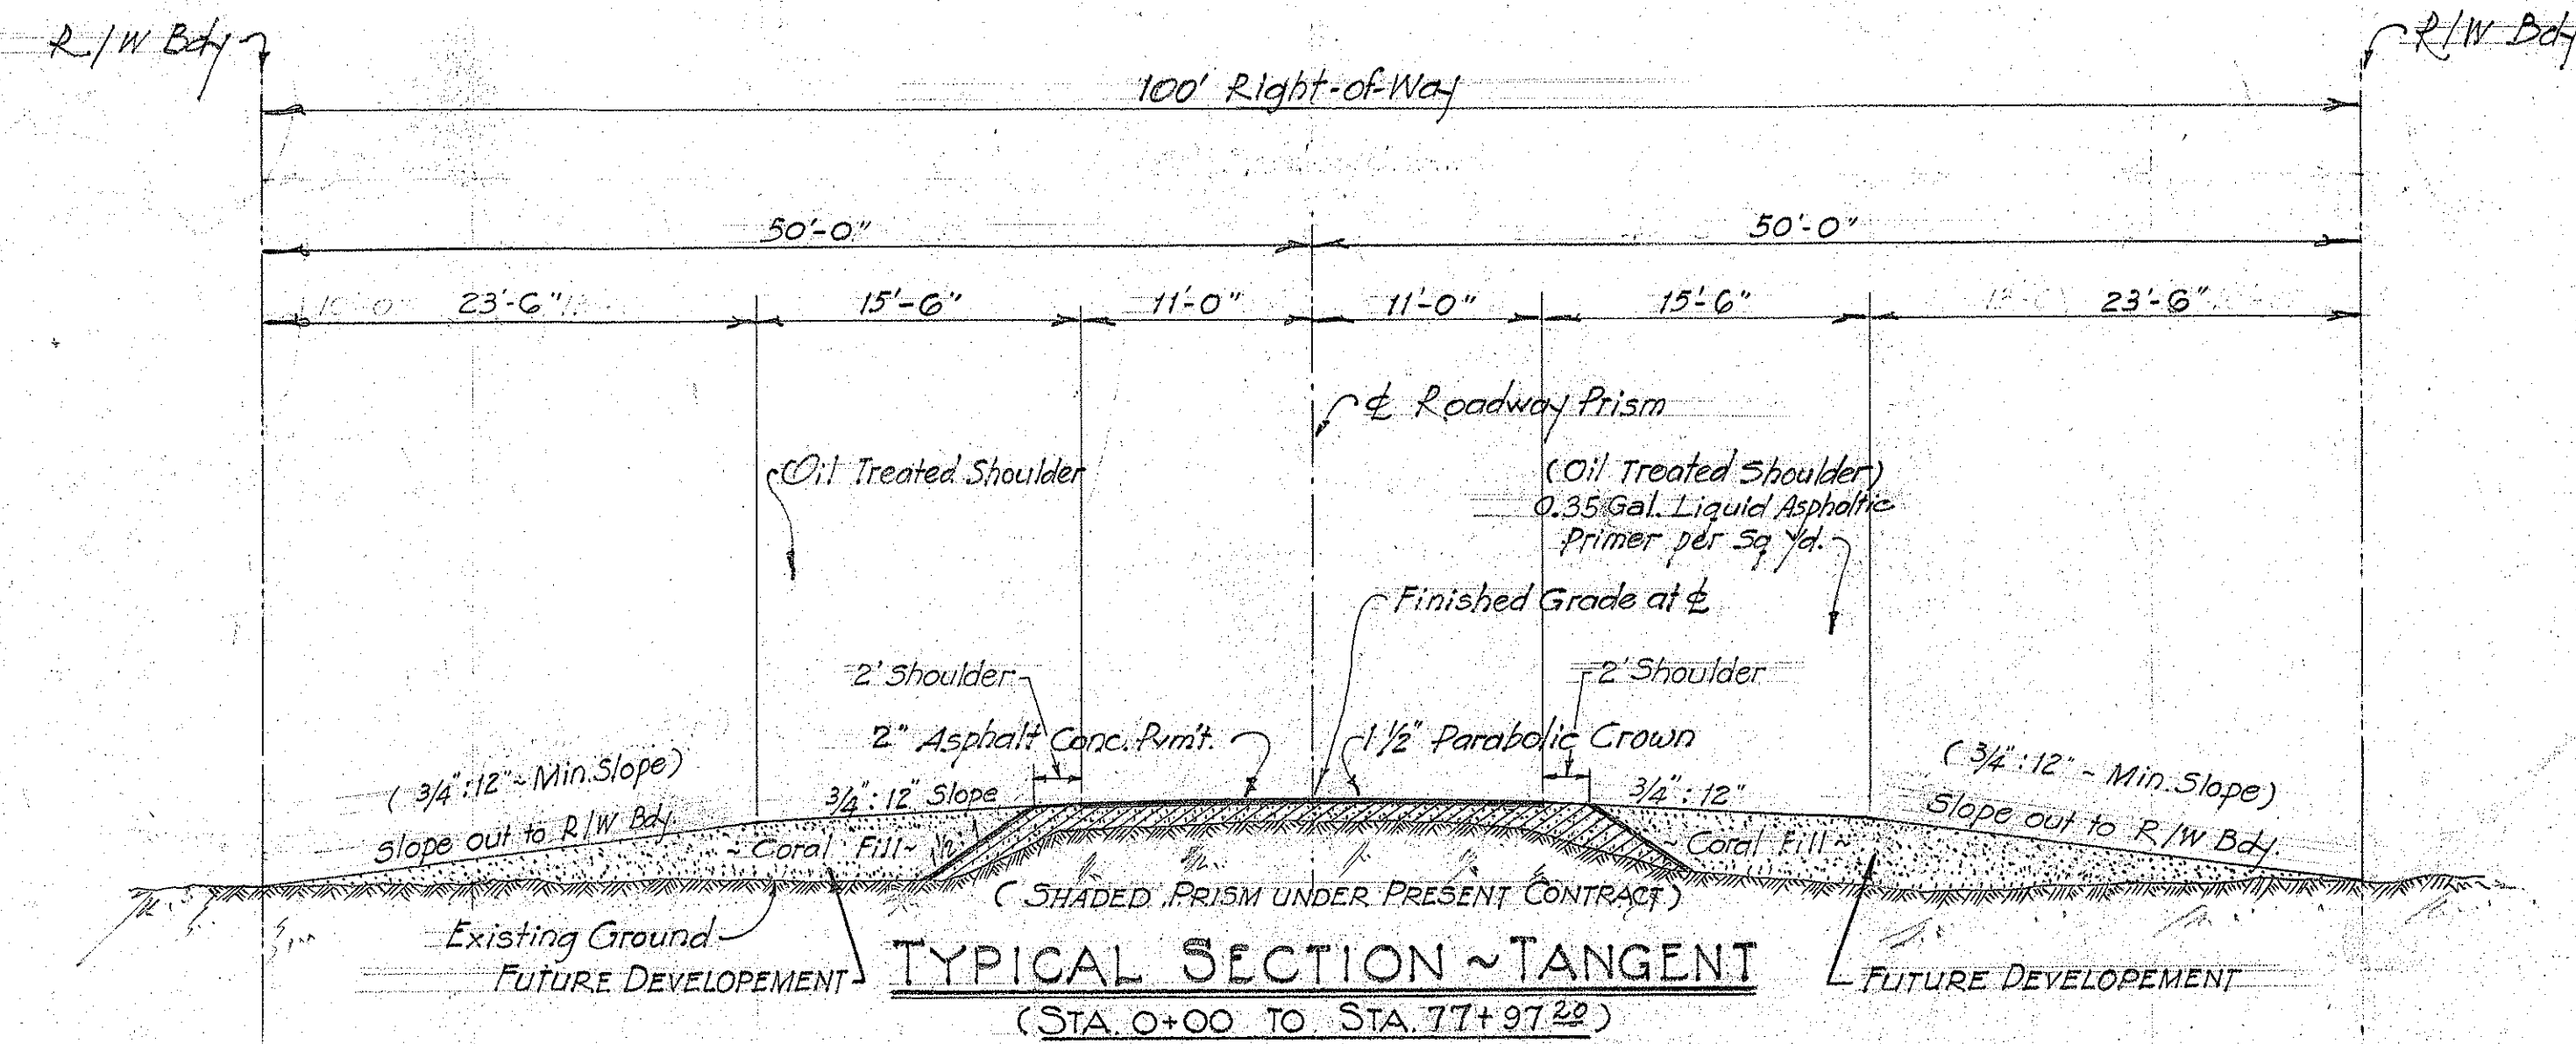
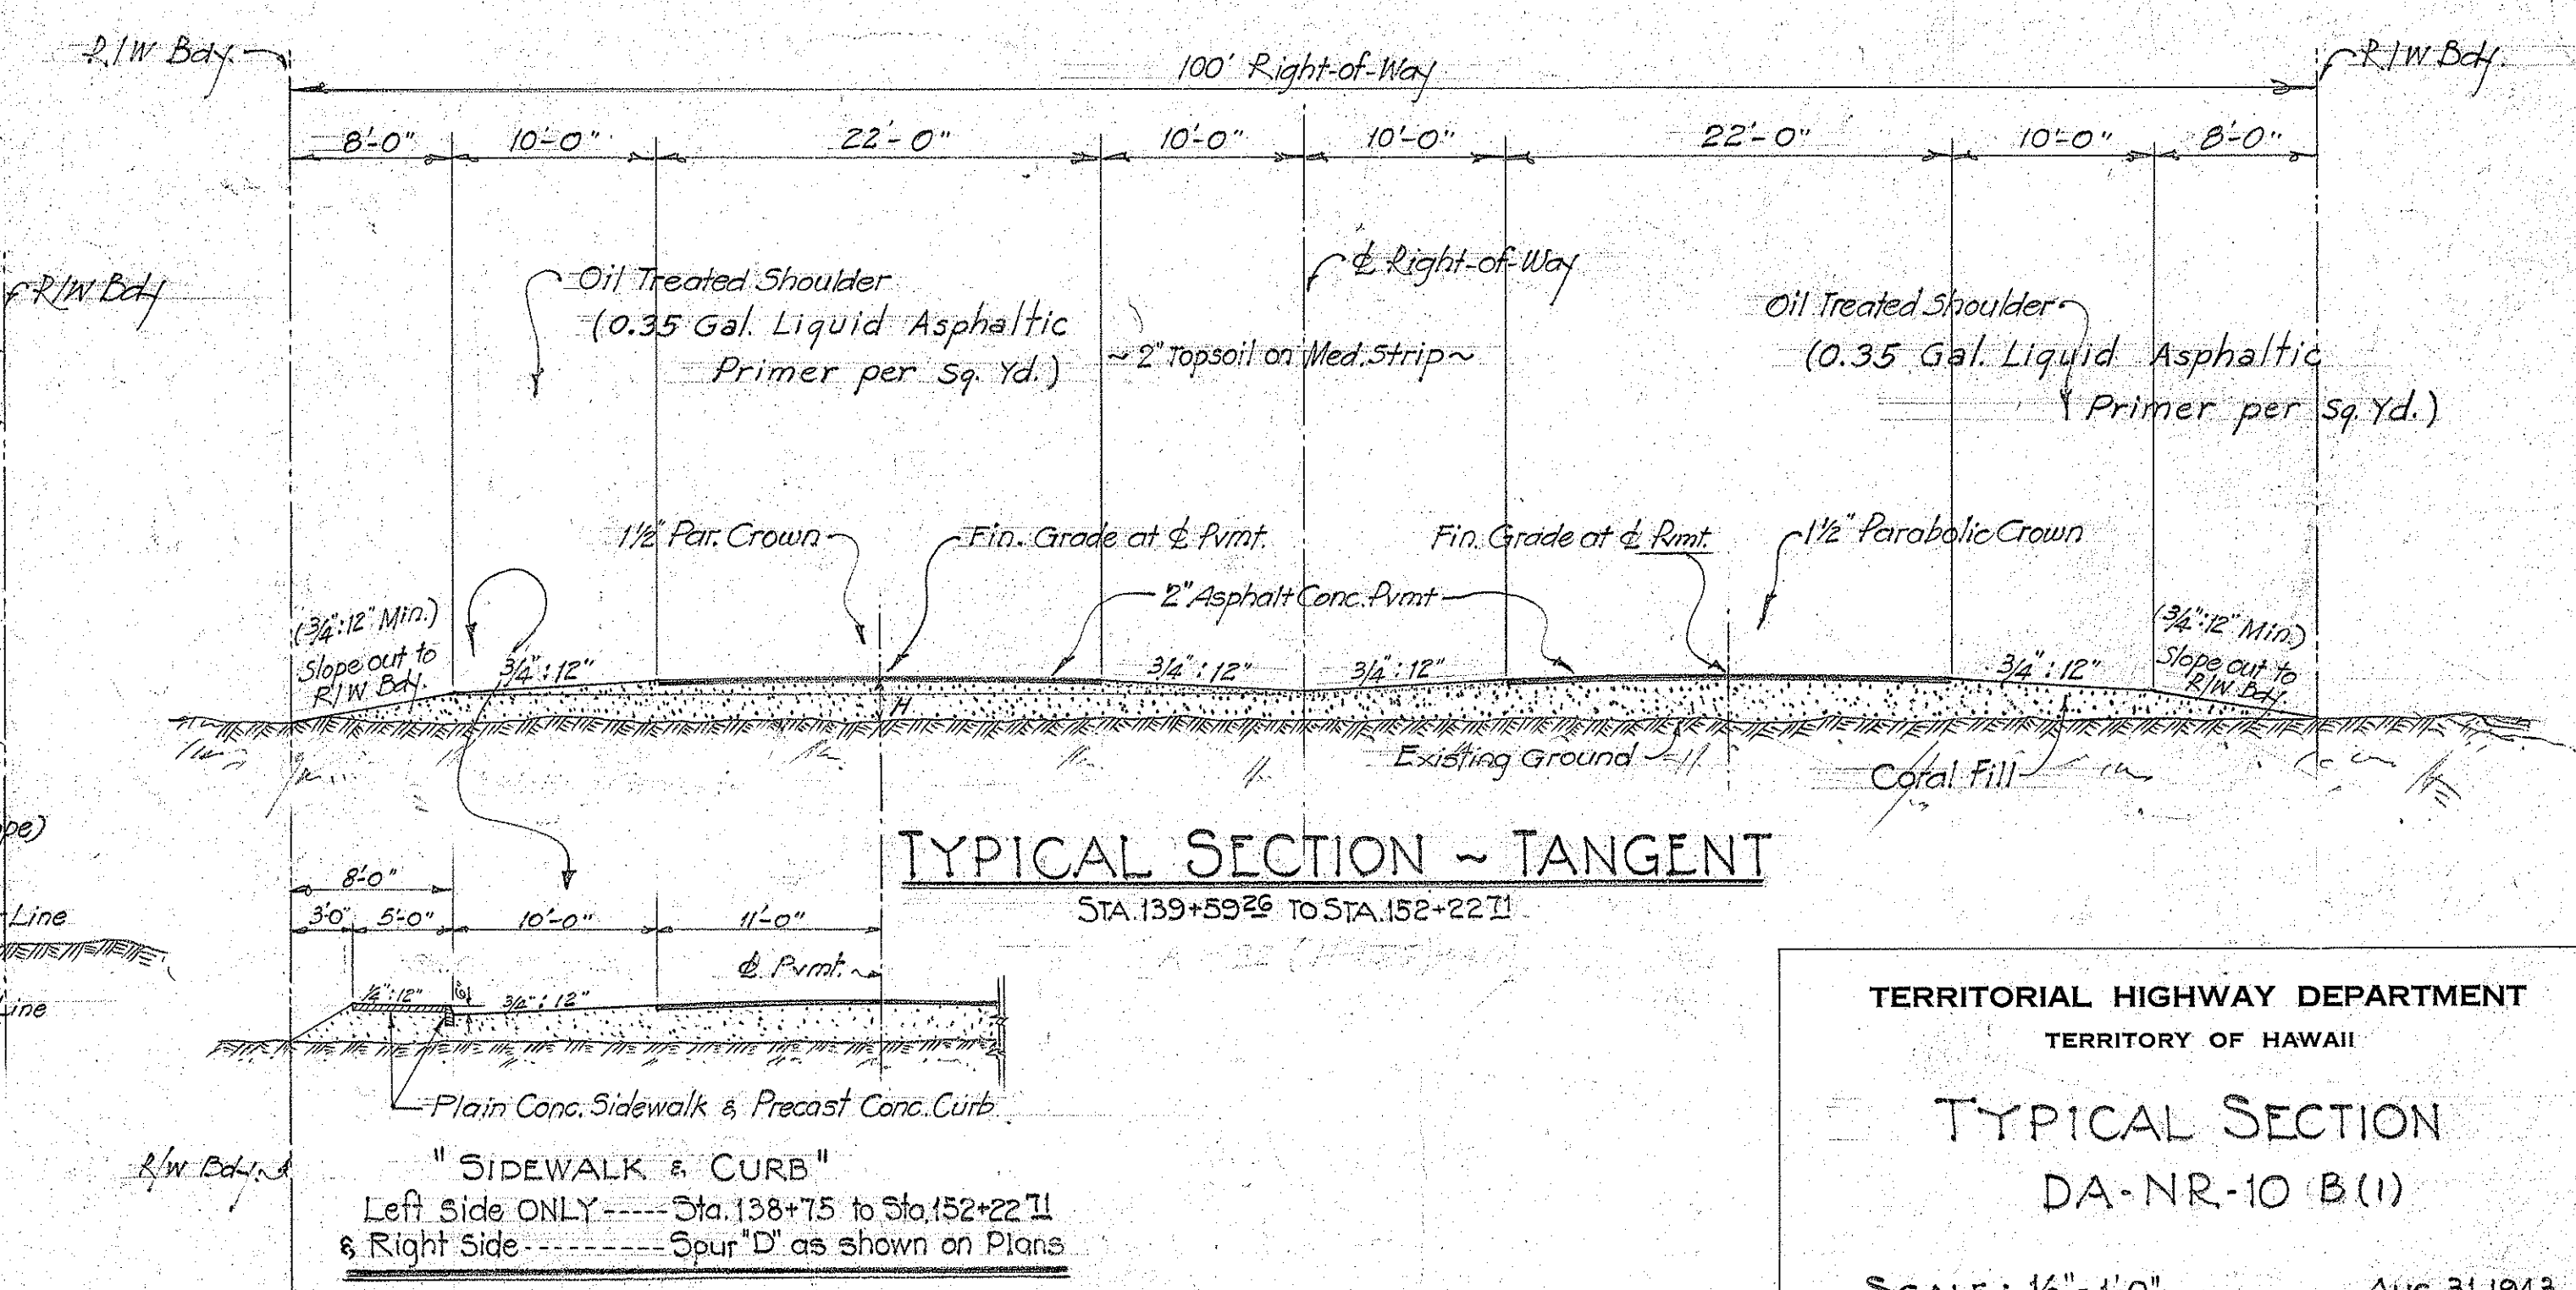
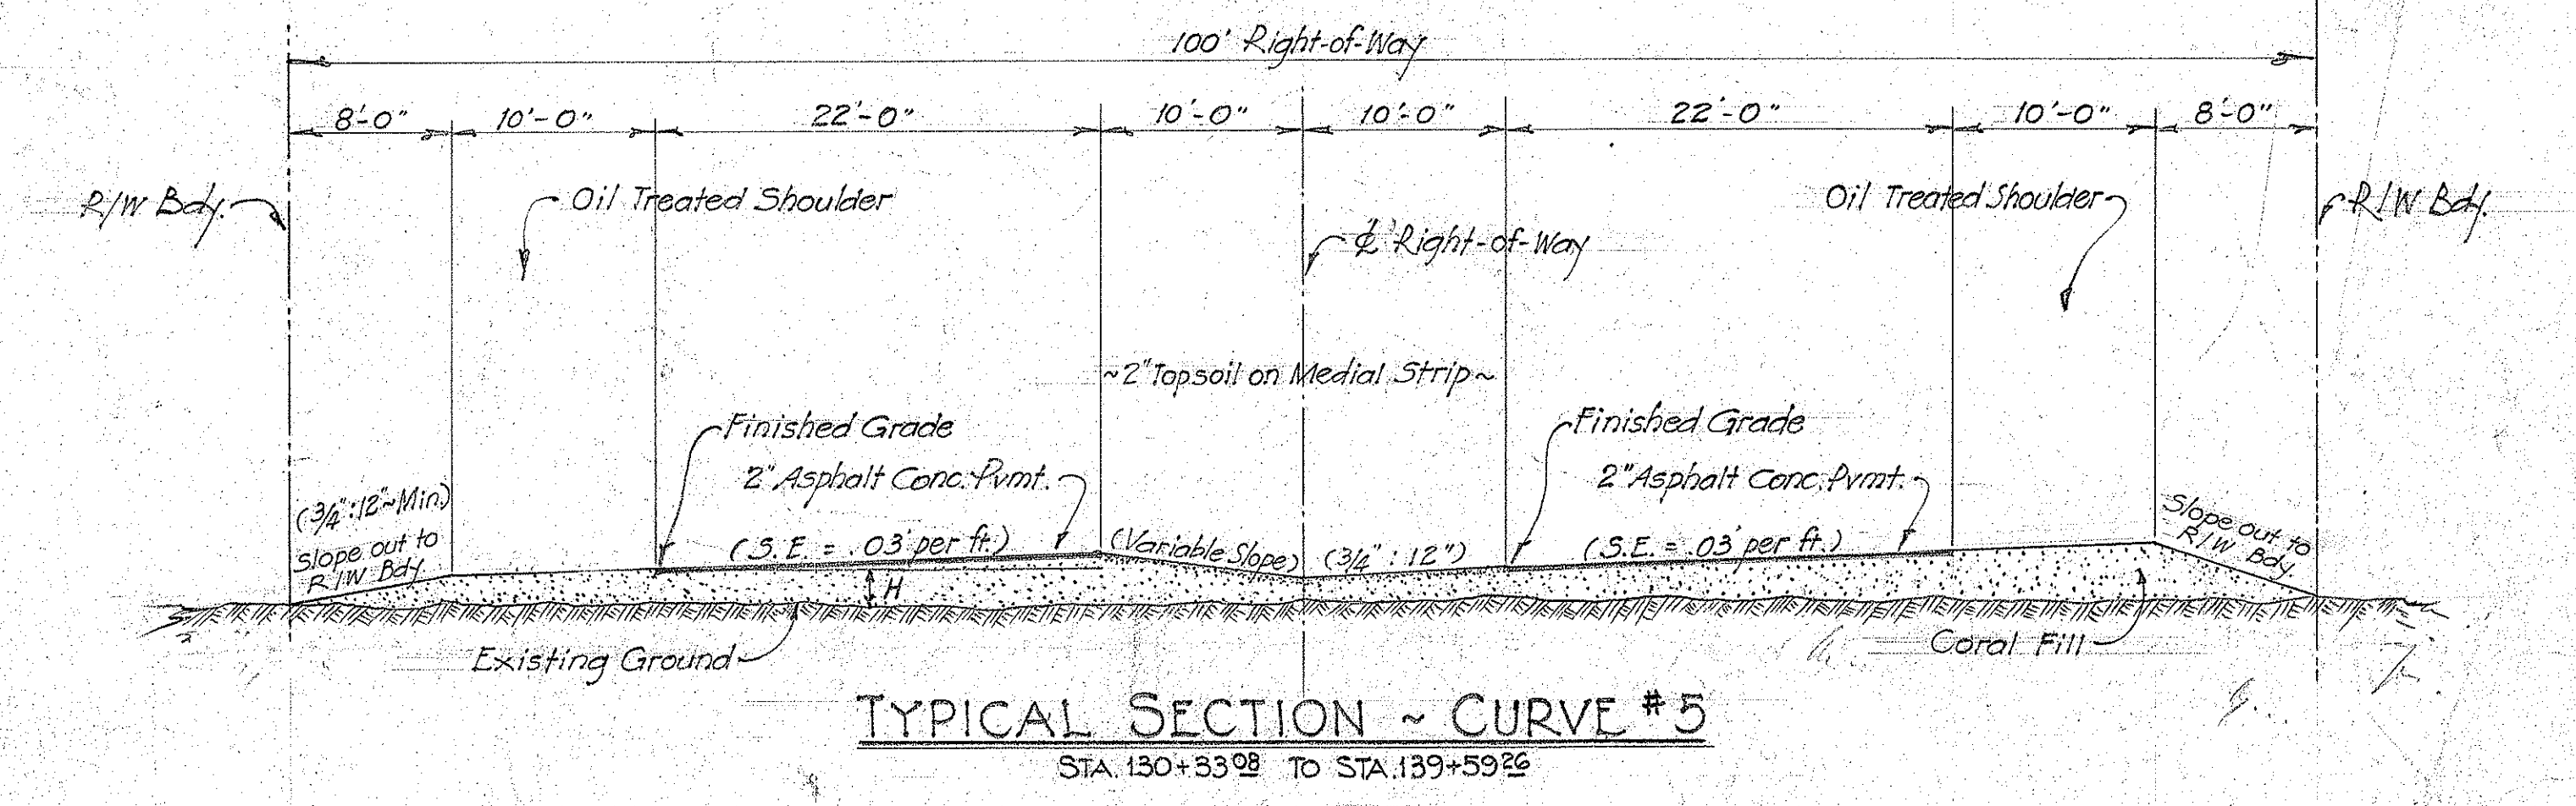


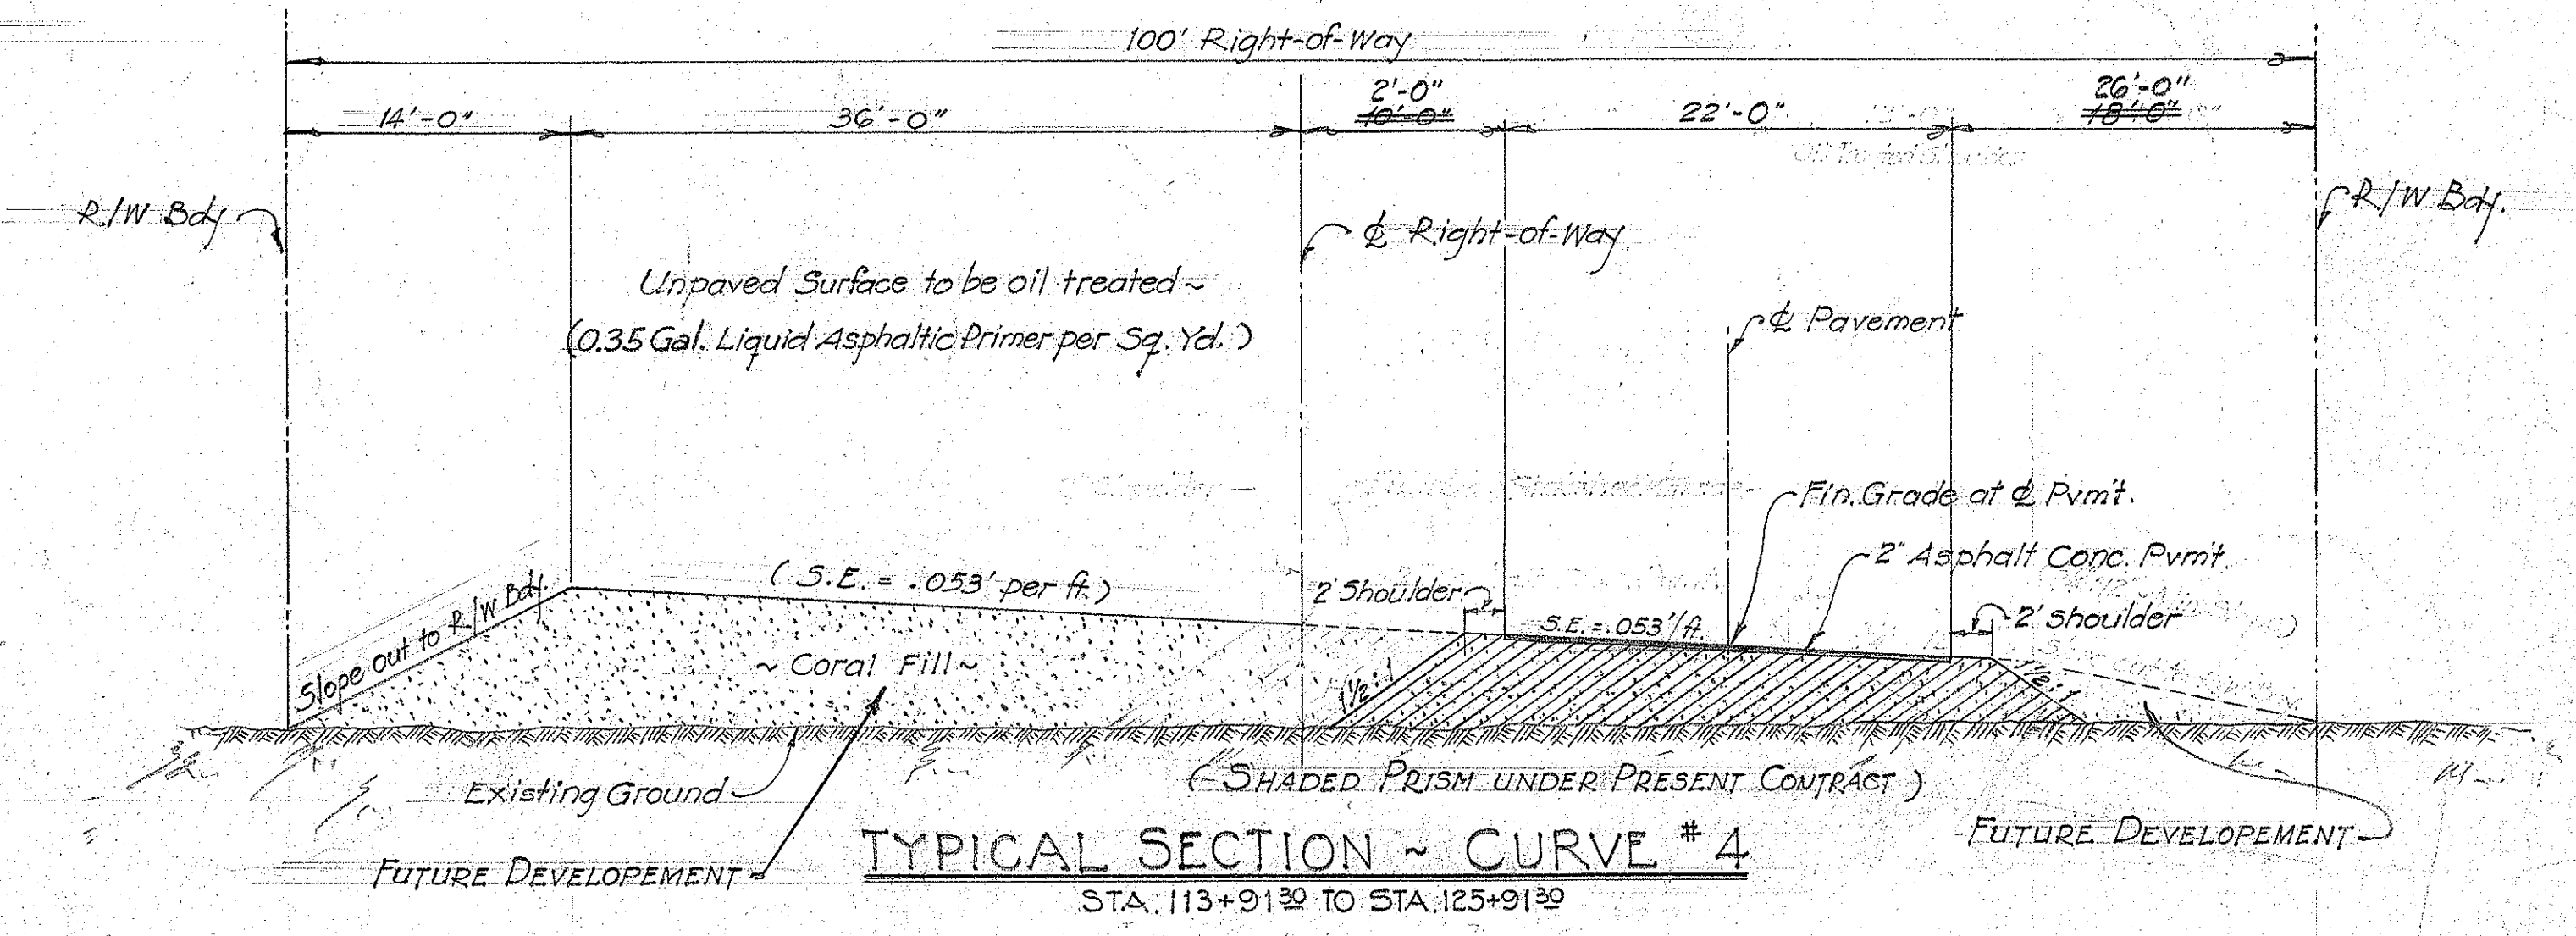

Note: Pavement shifts to the Right from 0.0 ft. at P.C. (Sta. 77+97.20) to 21.0 ft. at P.T. (Sta. 80+35.50) ~ of Medial Strip widens from 0.0 ft. to 10.0 ft.

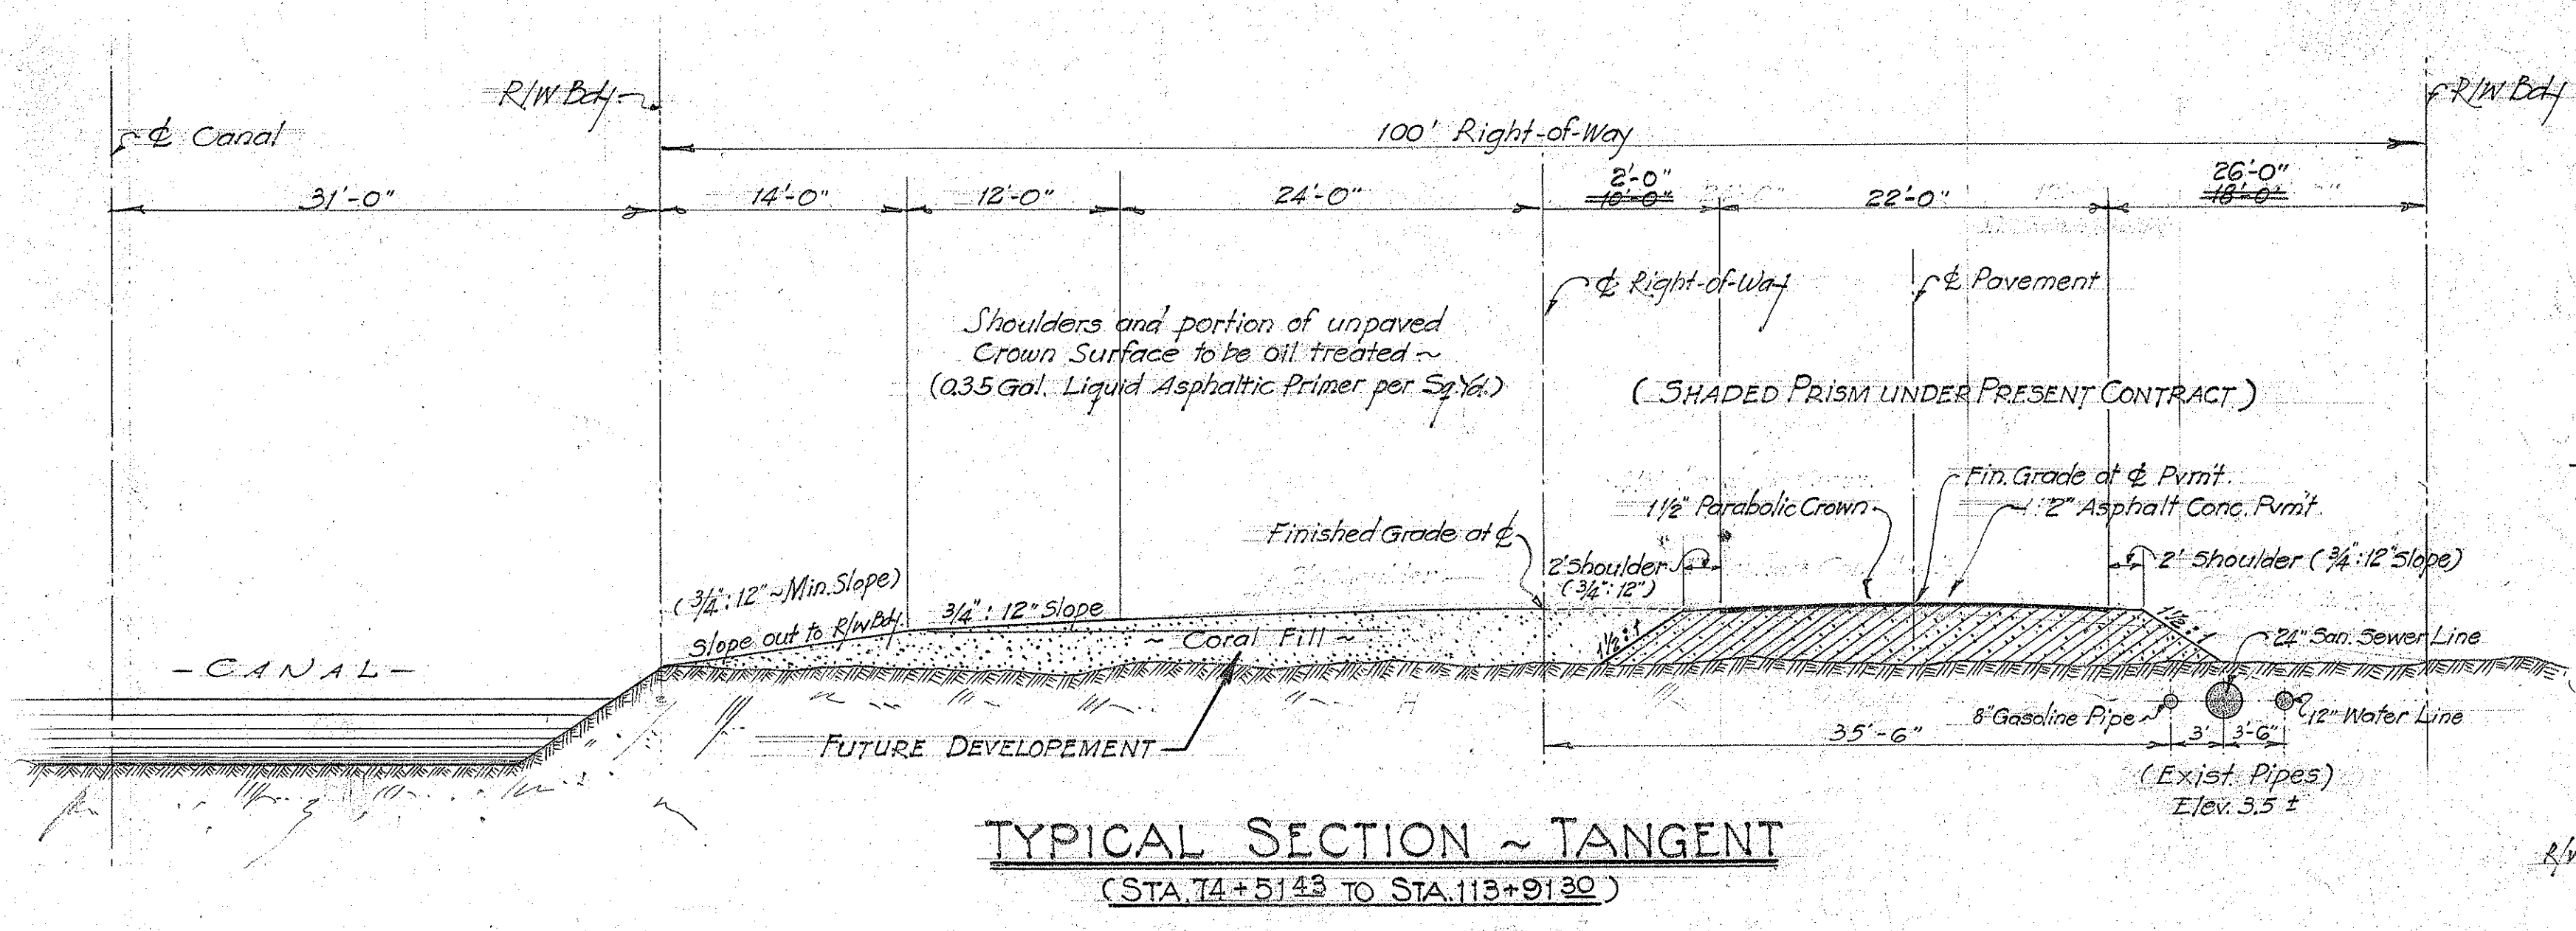

TERRITORIAL HIGHWAY DEPARTMENT
TERRITORY OF HAWAII

TYPICAL SECTION
DA-NR-10 B(1)

SCALE: 1/8" = 1'-0" Aug. 31, 1943

SHEET No. OF SHEETS

Rev. Change Med. Strip from 20' to 4' Sta. 74+51.43 to Sta. 125+91.30 June 7, 1944

Rev. Revised Typical Sections: (Sta. 0 to Sta. 77+97.22) (Sta. 77+97.20 to Sta. 80+35.50) (Sta. 80+35.50 to Sta. 113+91.30) (Sta. 113+91.30 to Sta. 125+91.30) (Sta. 125+91.30 to Sta. 139+59.00) (Sta. 139+59.00 to Sta. 152+22.11)

ORIGINAL PLAN	DESIGNED BY	DATE
NOTE BOOK	D. L. P.	Aug. 1943
CHECKED BY	R. E. R.	Aug. 1943
	QUANTITIES CHECKED BY	
	CHECKED BY	