

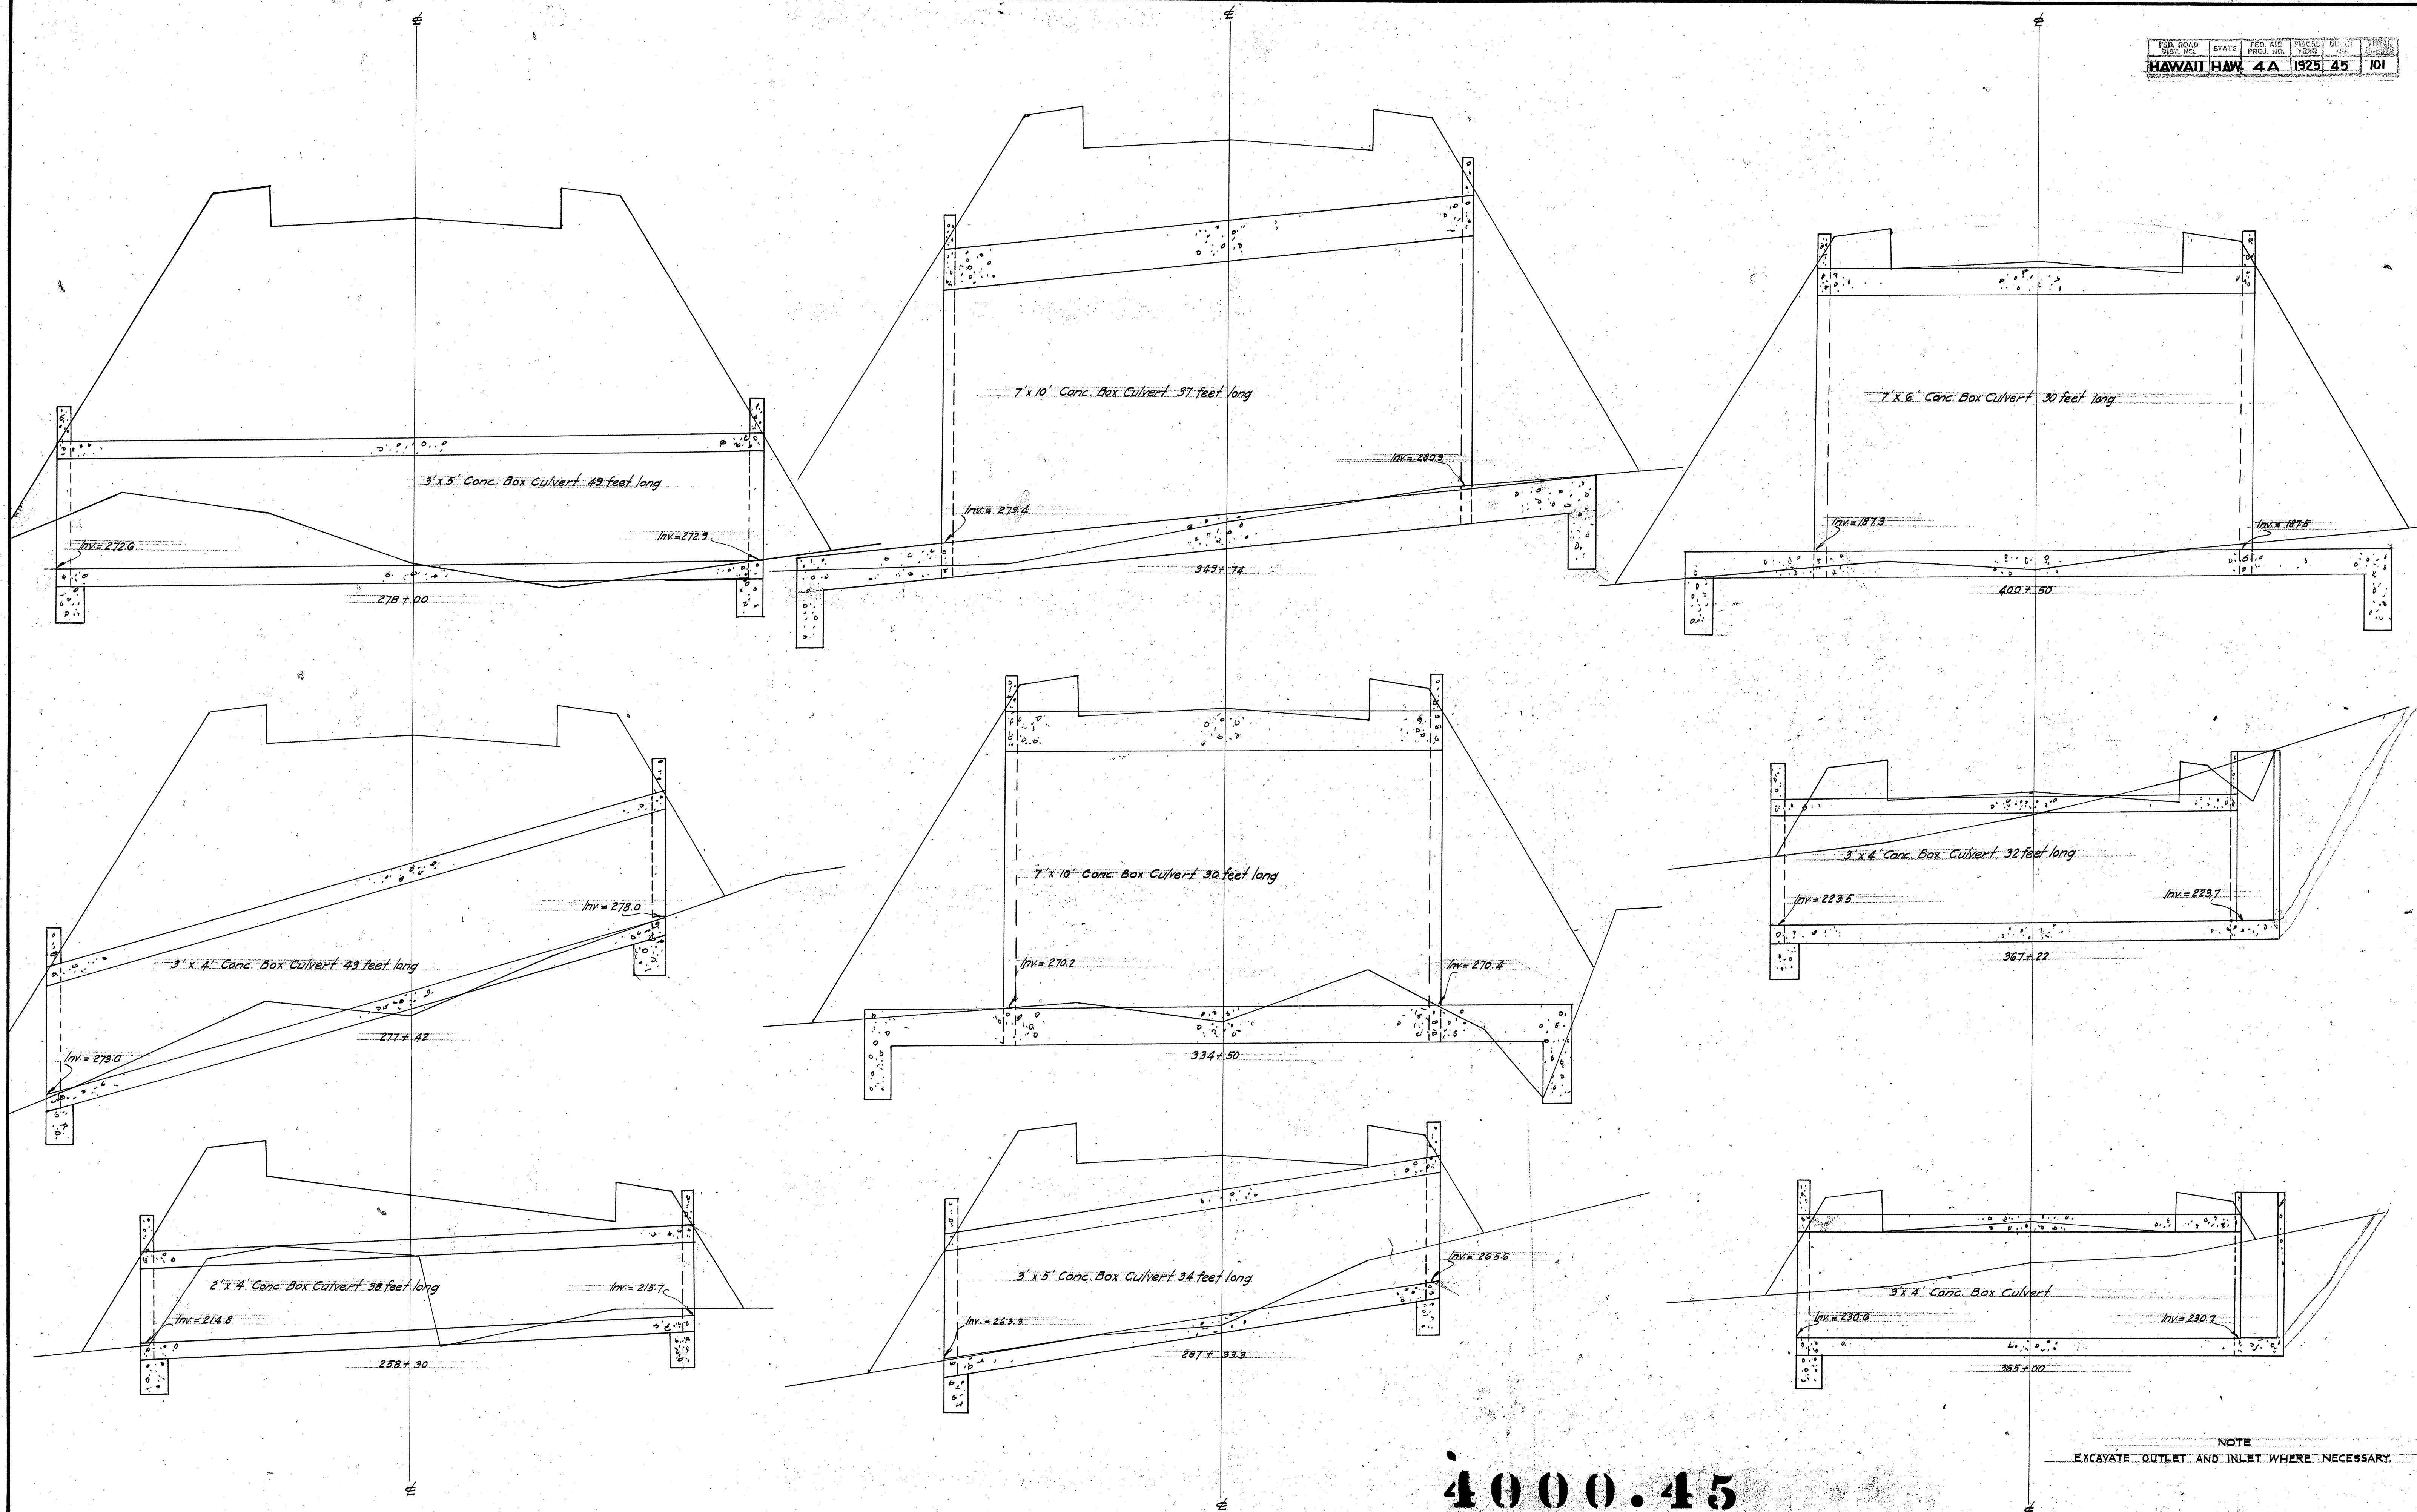
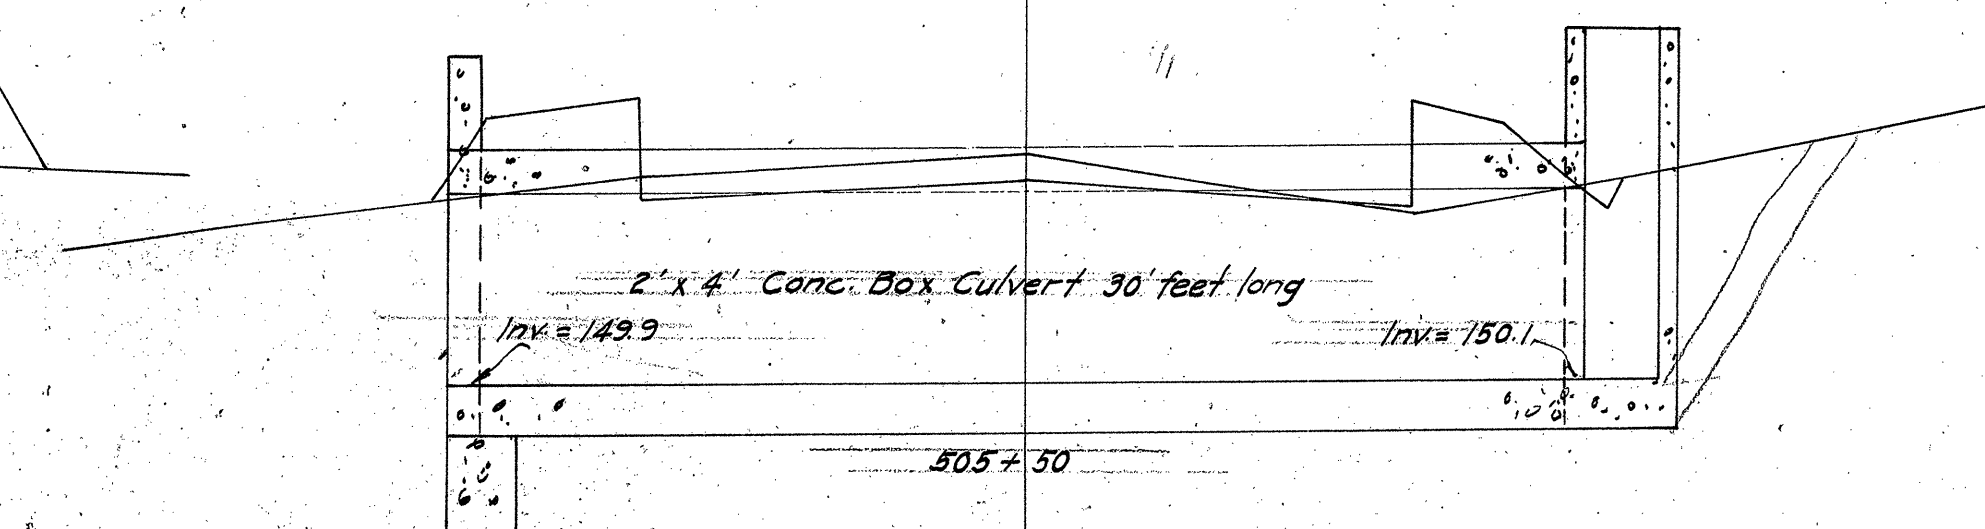
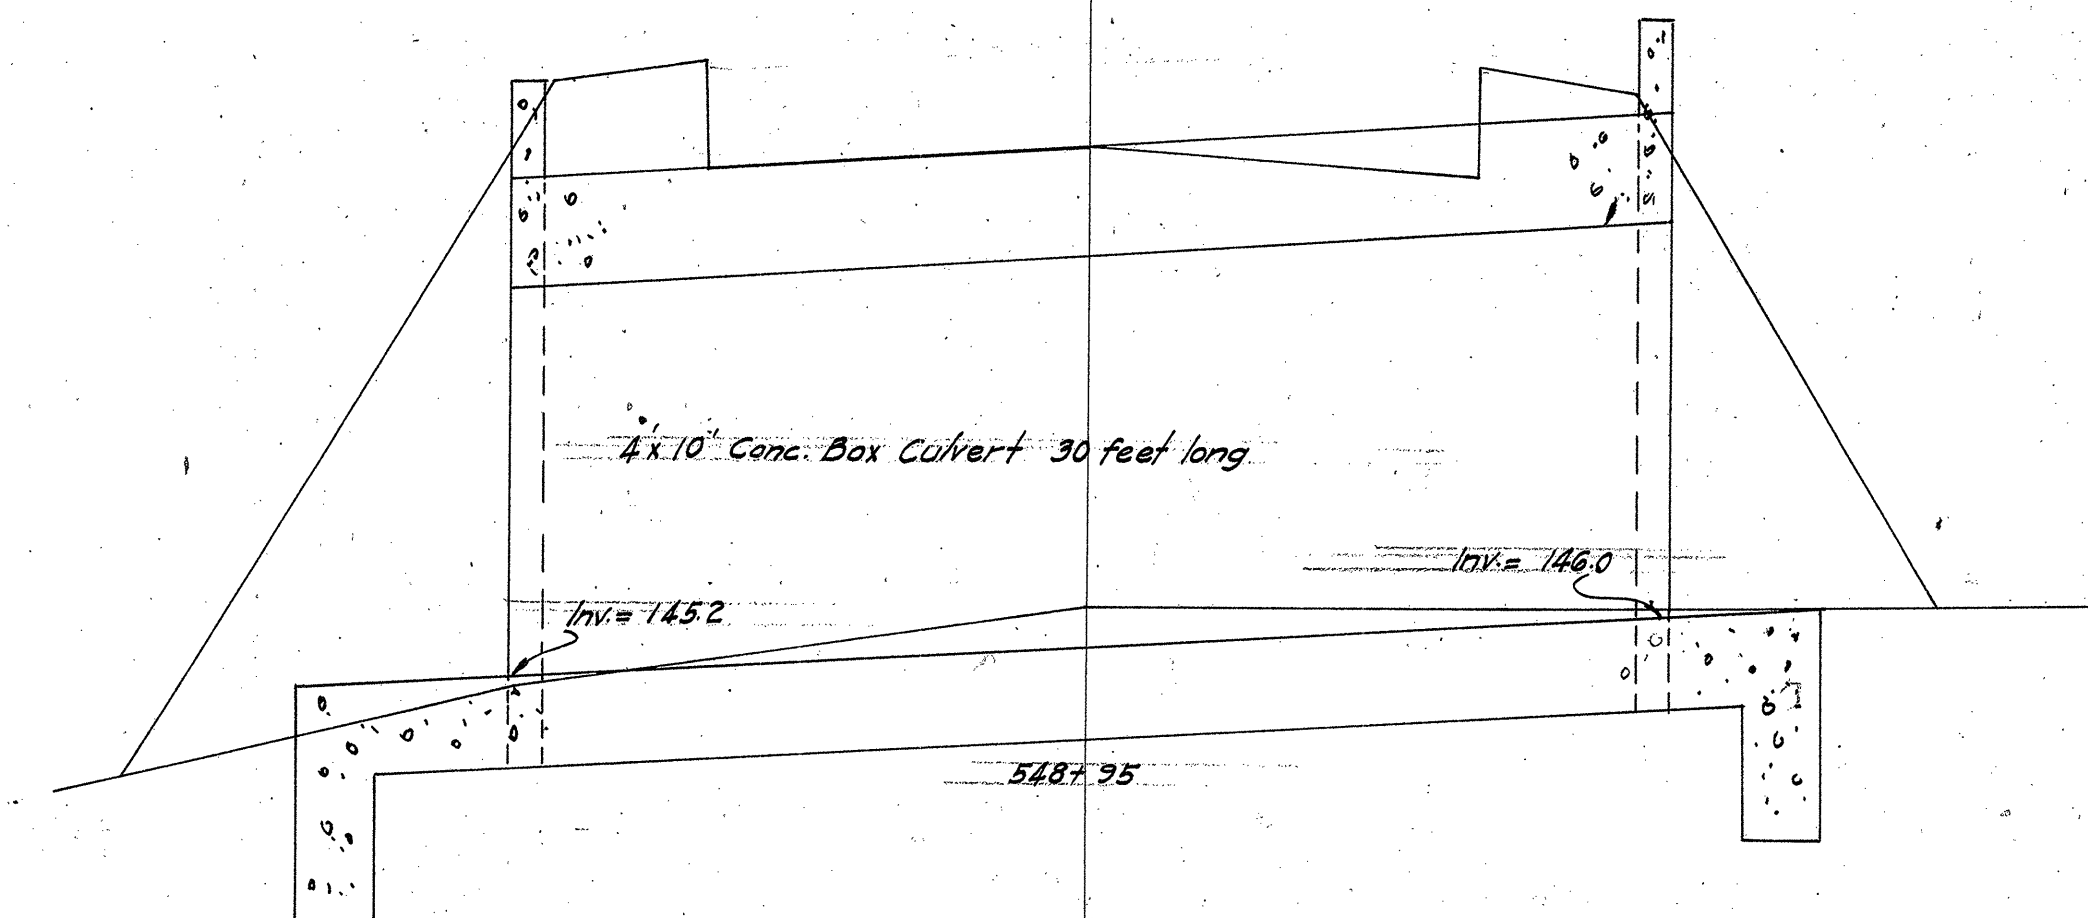
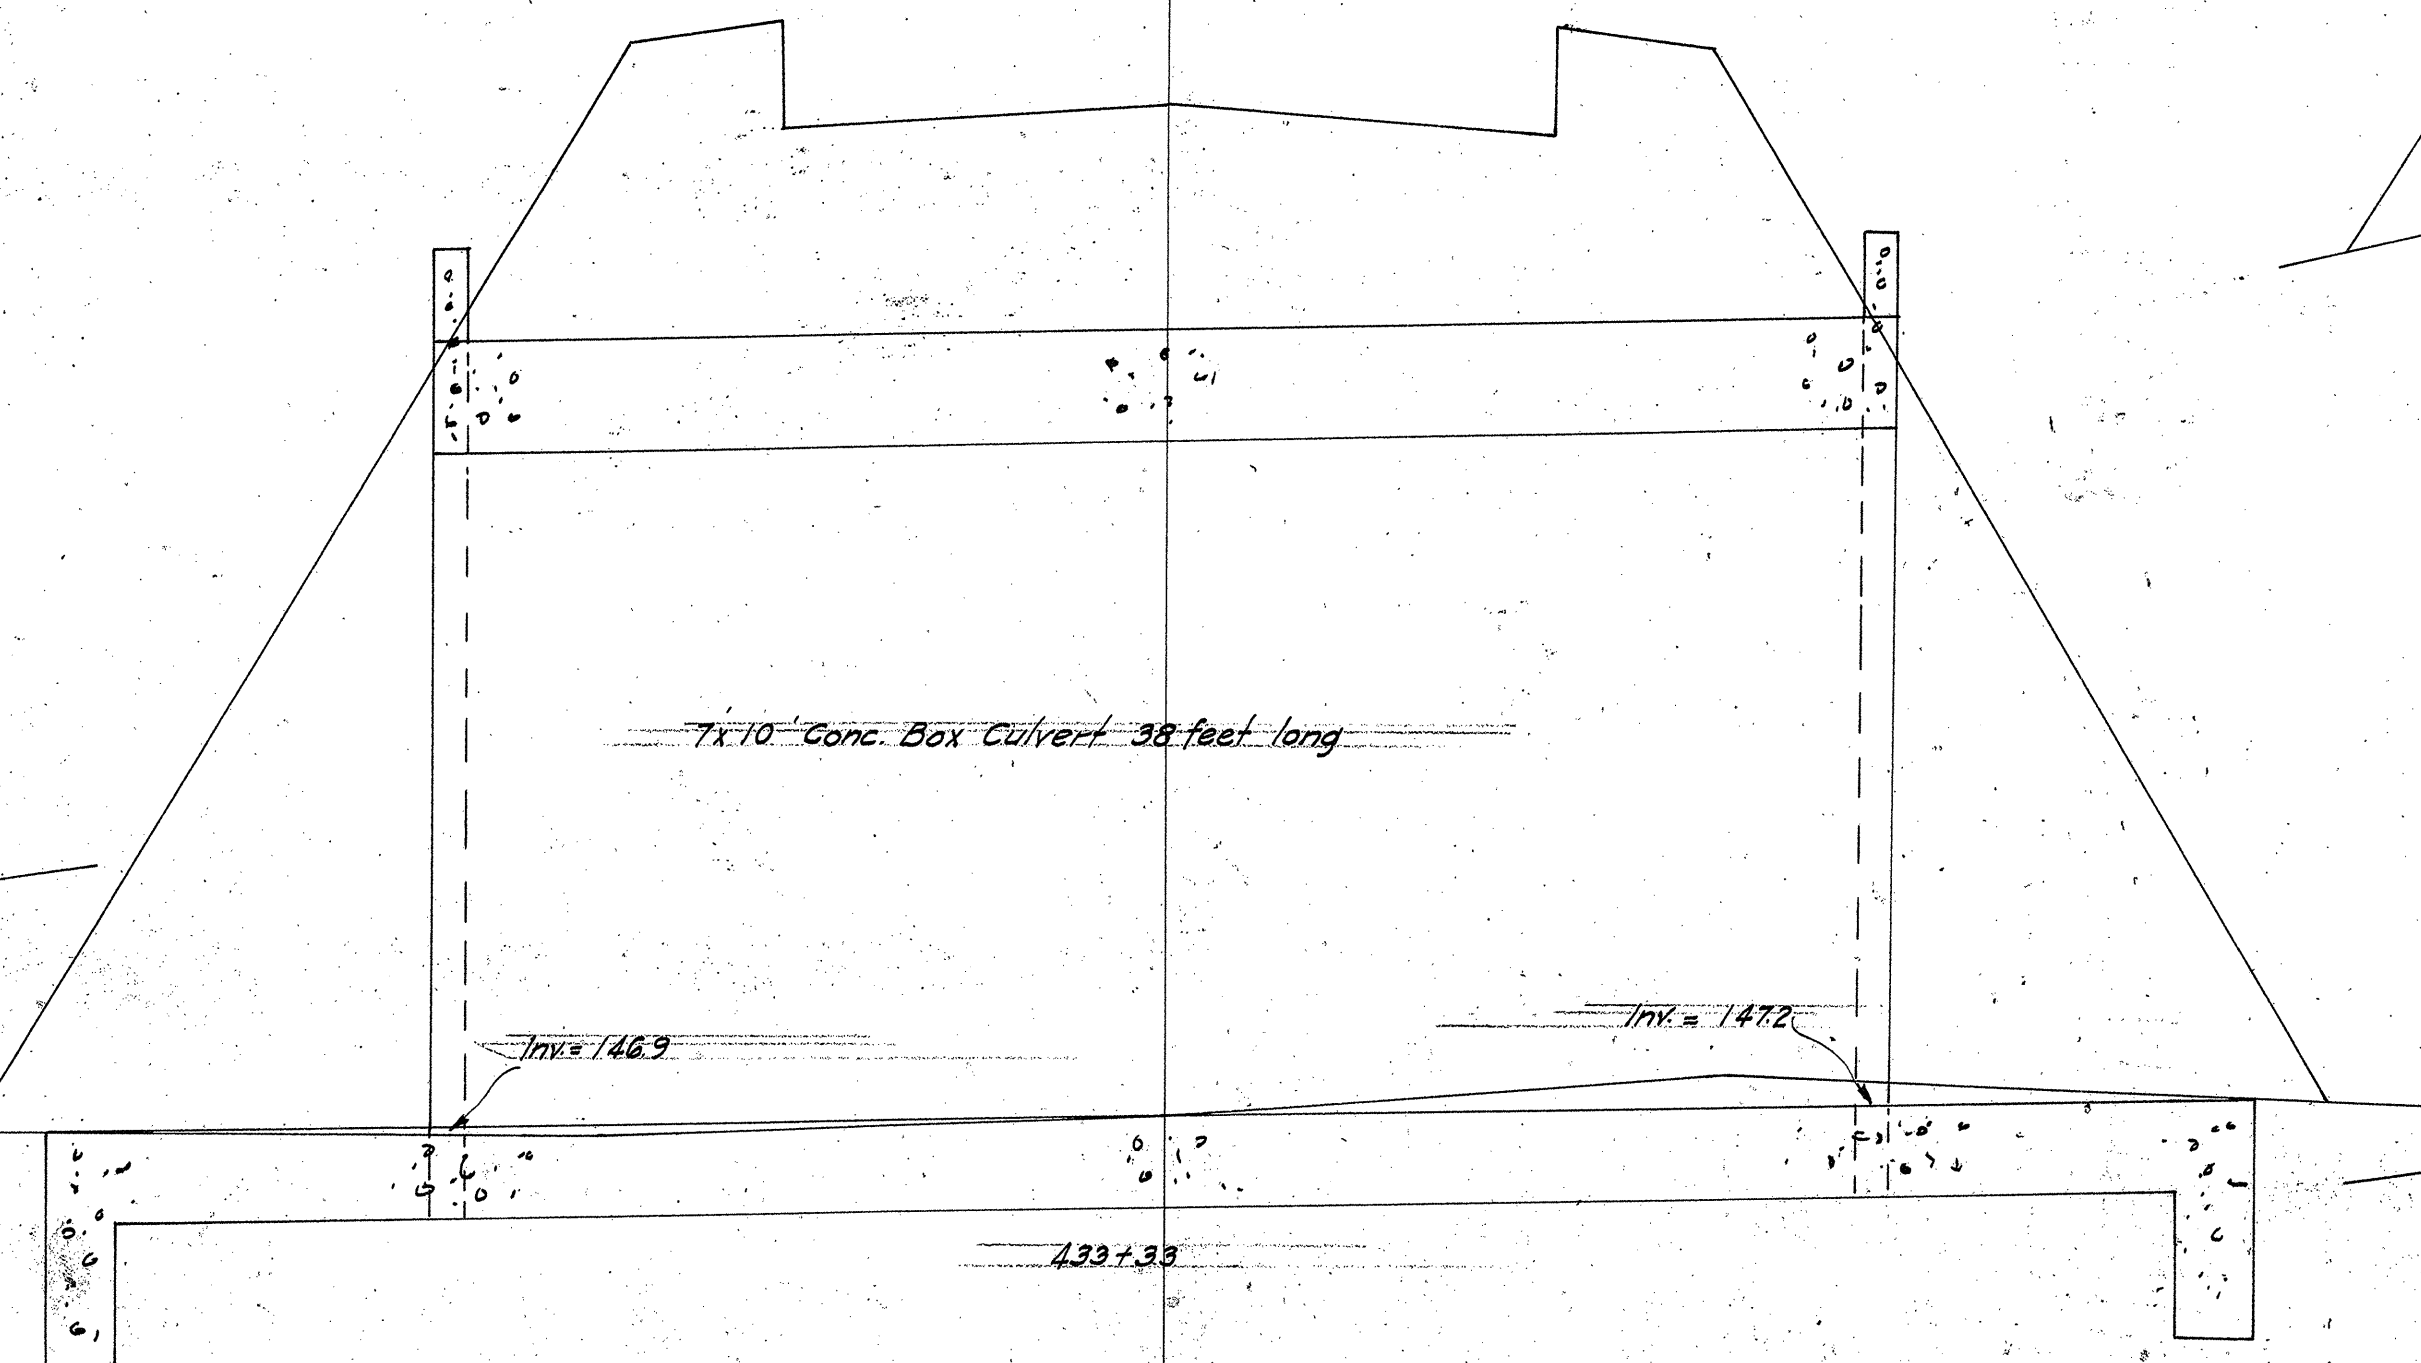
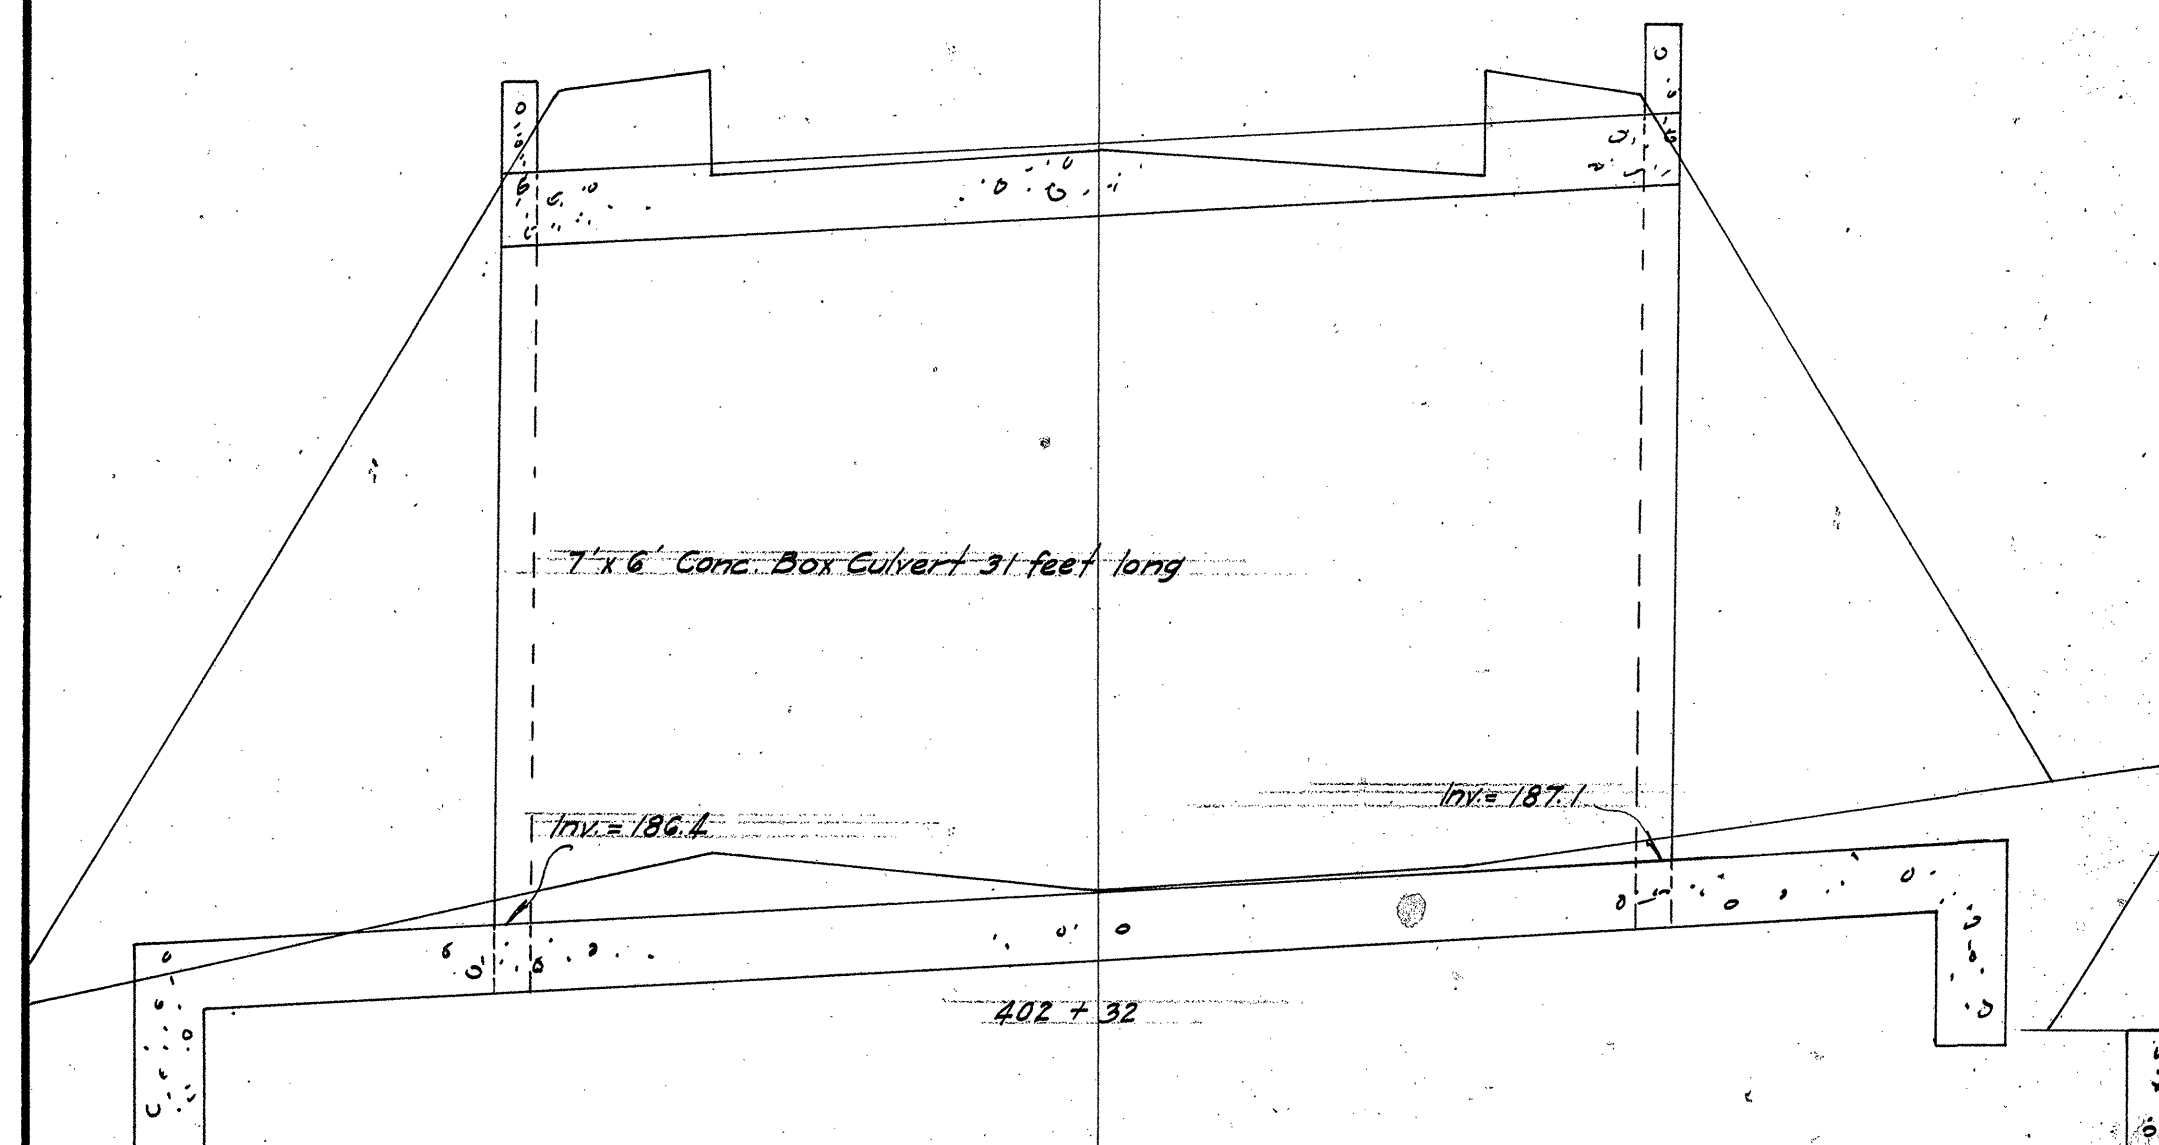
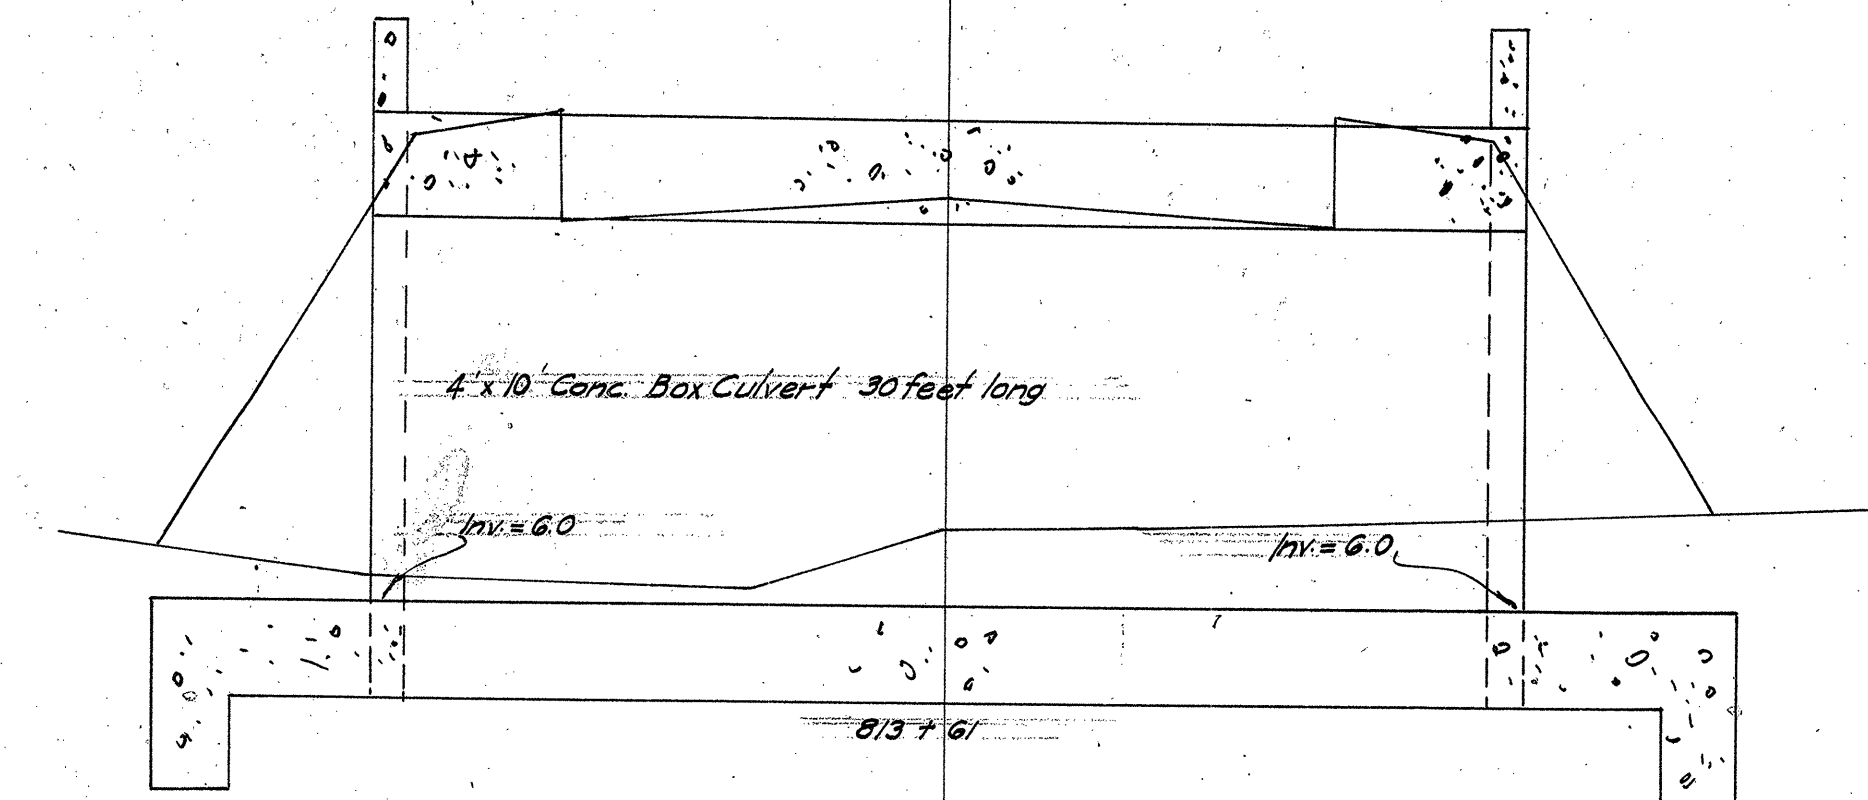


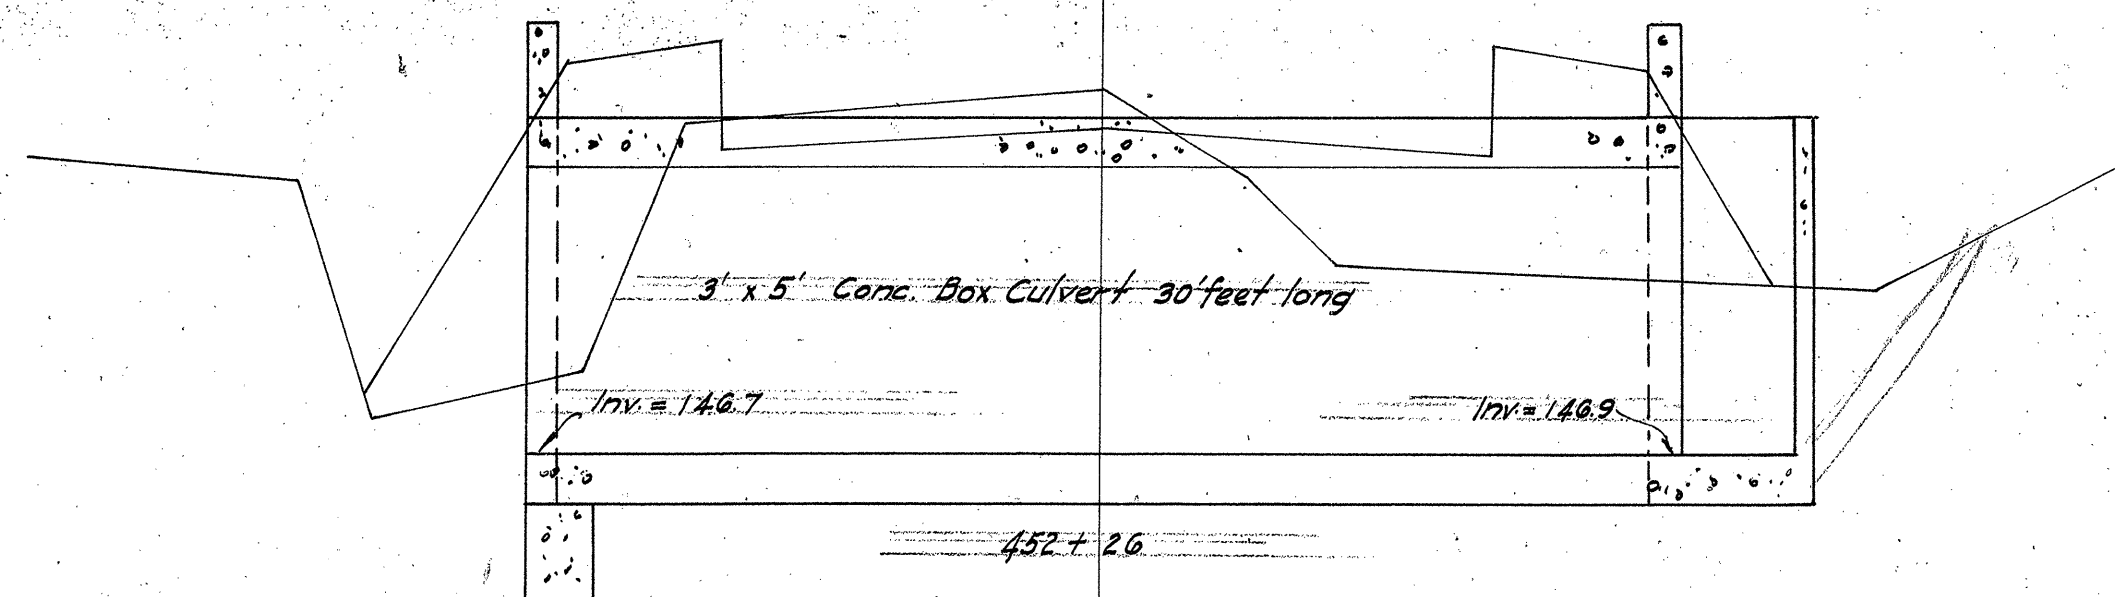

4000.45

NOTE
EXCAVATE OUTLET AND INLET WHERE NECESSARY.

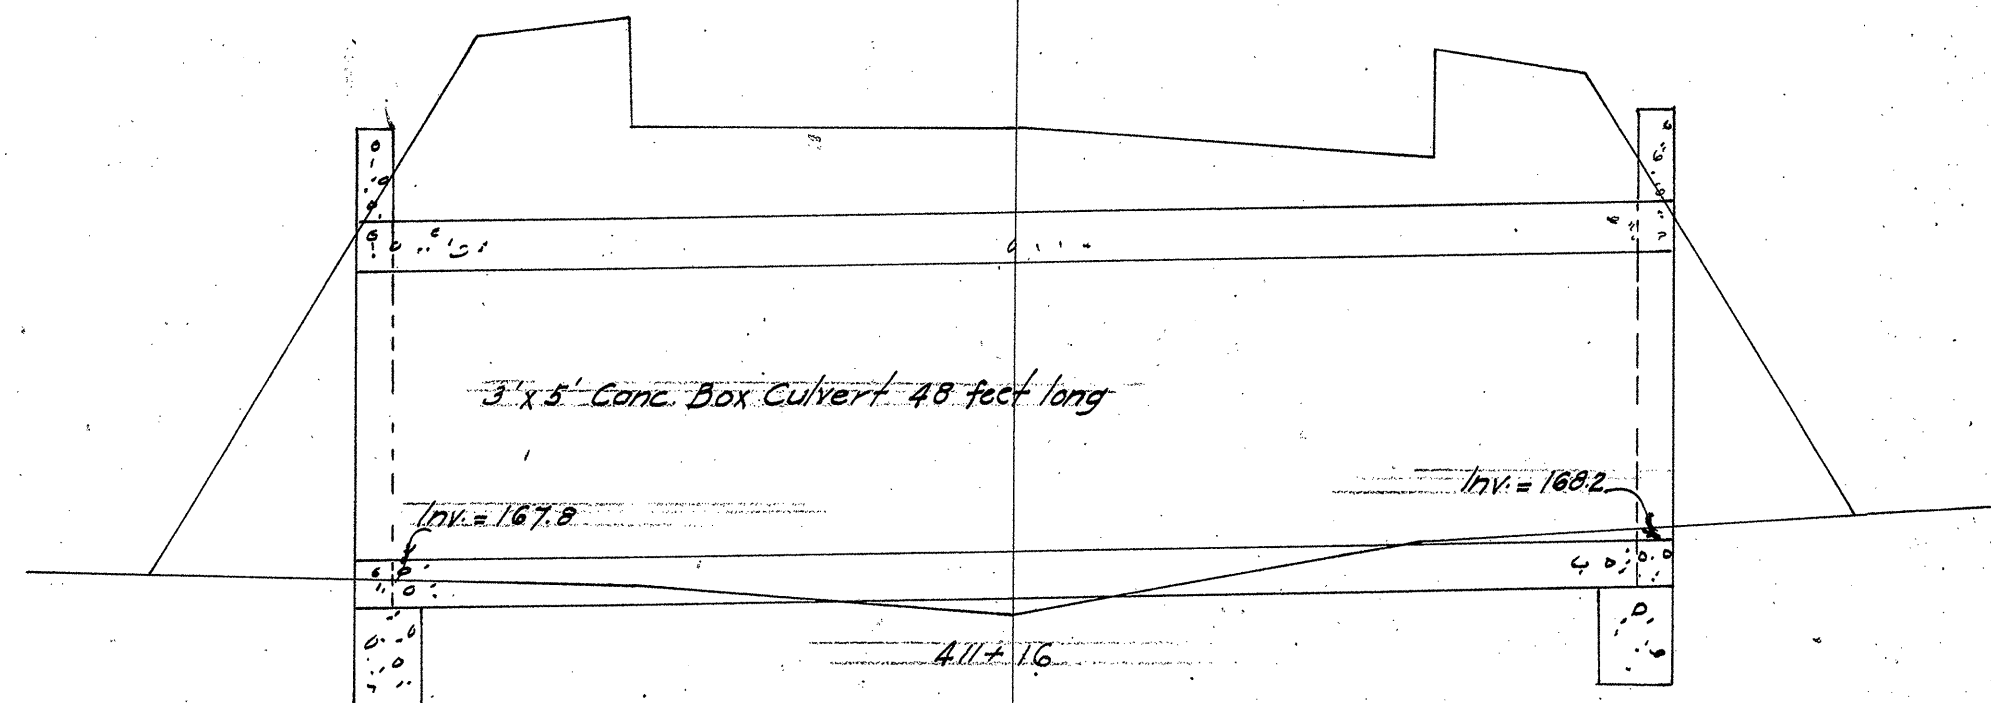

NOTE
EXCAVATE OUTLET AND INLET WHERE NECESSARY.

4000.46

6.16.3