


NOTE

Project is now divided as follows
 Group A sta. 246+00 to 705+37.75 with typical sections to be as shown on sheet 4000.2
 Group B sta. 705+37.75 to 725+00 with typical sections to be as shown at left

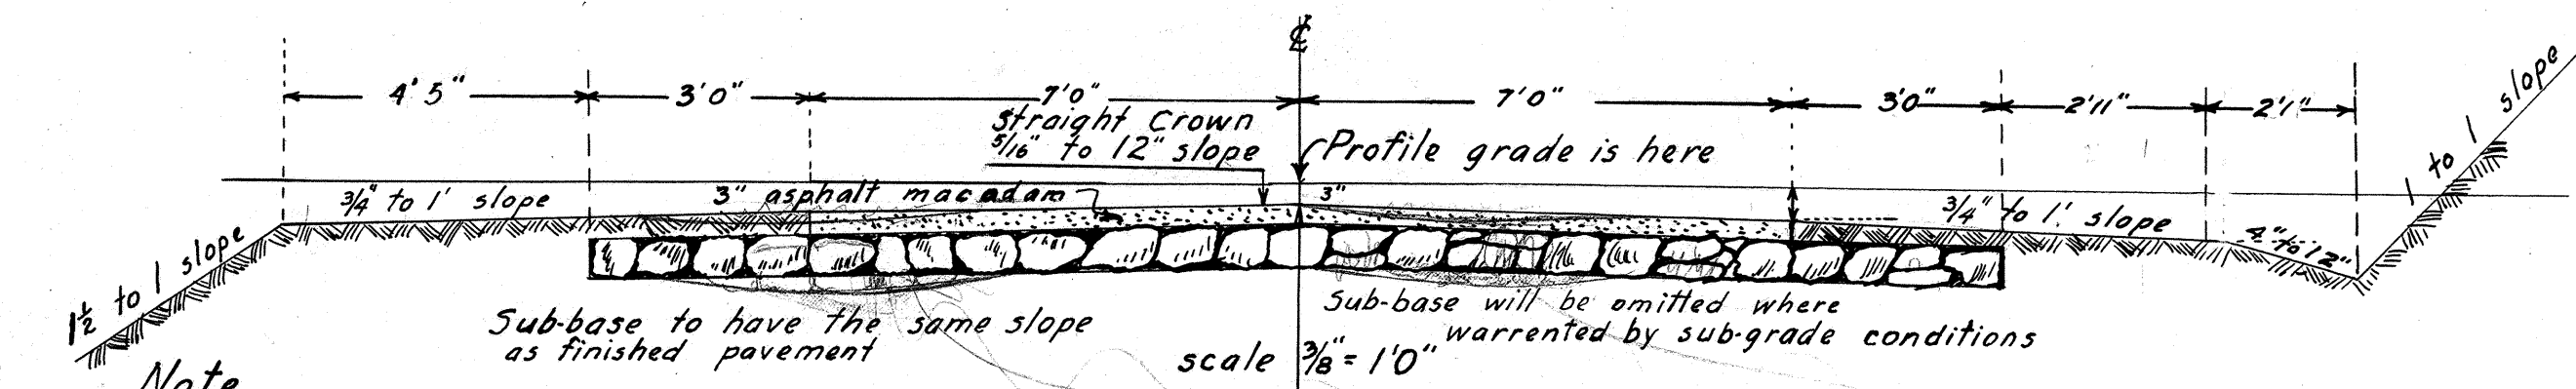

Note
 3" Asphalt macadam surface course
 3" (loose) #2 rock, 1 1/2 gals. asphalt per sq. yd.,
 sufficient #3 rock to fill voids and cover
 ROAD SECTION ON TANGENT
 STA. 705+37.75 to 725+00

show base and pavement
 depressed about 1/2" at these
 points on the typ. section
 existing detail
 heavy for new

Approved: John H. Bigelow Date: Mar. 3, 1928.
 Territory Highway Engineer

4000.SPECIAL