


- ~ LIST OF COMMON ABBREVIATIONS ~
- | | | | |
|--------------|--|--------|---------------------|
| C.R.M. | Cement rubble masonry. | C.H.W. | Concrete Head Wall. |
| D.R.M. | Dry rubble masonry. | M.H.W. | Masonry Head Wall. |
| Conc. Culvt. | Circular concrete culvert which is either | C.B. | Catch Basin |
| | (a) Cast-in-place circular concrete culvert or | ○ T.P. | Telephone Pole |
| | (b) concrete pipe culvert. | ○ E.P. | Wood Electric Pole |
| Box Culvt. | Various reinf. conc. box culverts as detailed. | ○ F.H. | Fire Hydrant |
| Metal Culvt. | Corrugated galvanized metal pipe culvert. | ○ L.T. | Large Tree |
| C.D.I. | Concrete drop intake | | Warning Signs |
| M.D.I. | Masonry drop intake | | |


POKAI
BAY

Note: Plantation R.R. Bridge to be relocated on new line across Kaupuni Stream. See Details.

FED. ROAD DIST. NO.	STATE	FED. AID PROJ. NO.	FISCAL YEAR	SHEET NO.	TOTAL SHEETS
HAWAII	HAW	W22830	1936	3	83

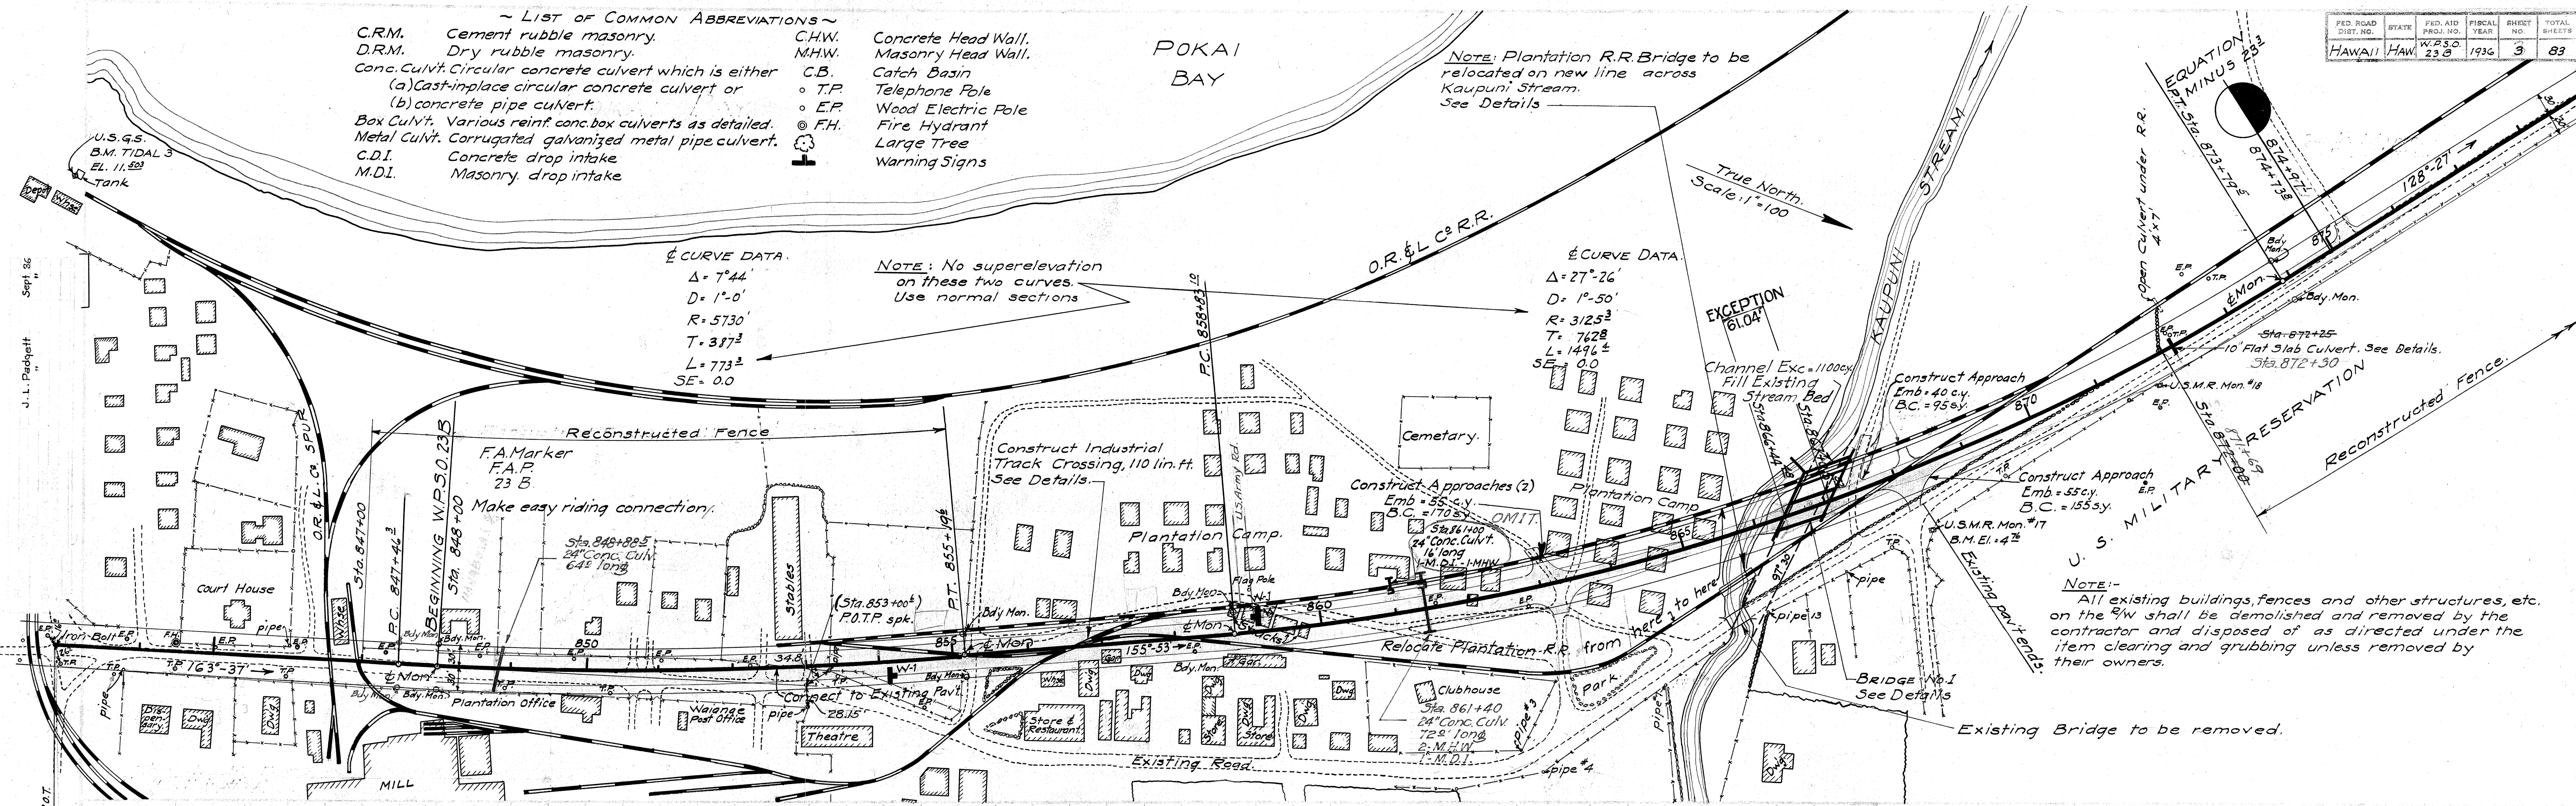

NOTE:-
All existing buildings, fences and other structures, etc. on the R/W shall be demolished and removed by the contractor and disposed of as directed under the item clearing and grubbing unless removed by their owners.

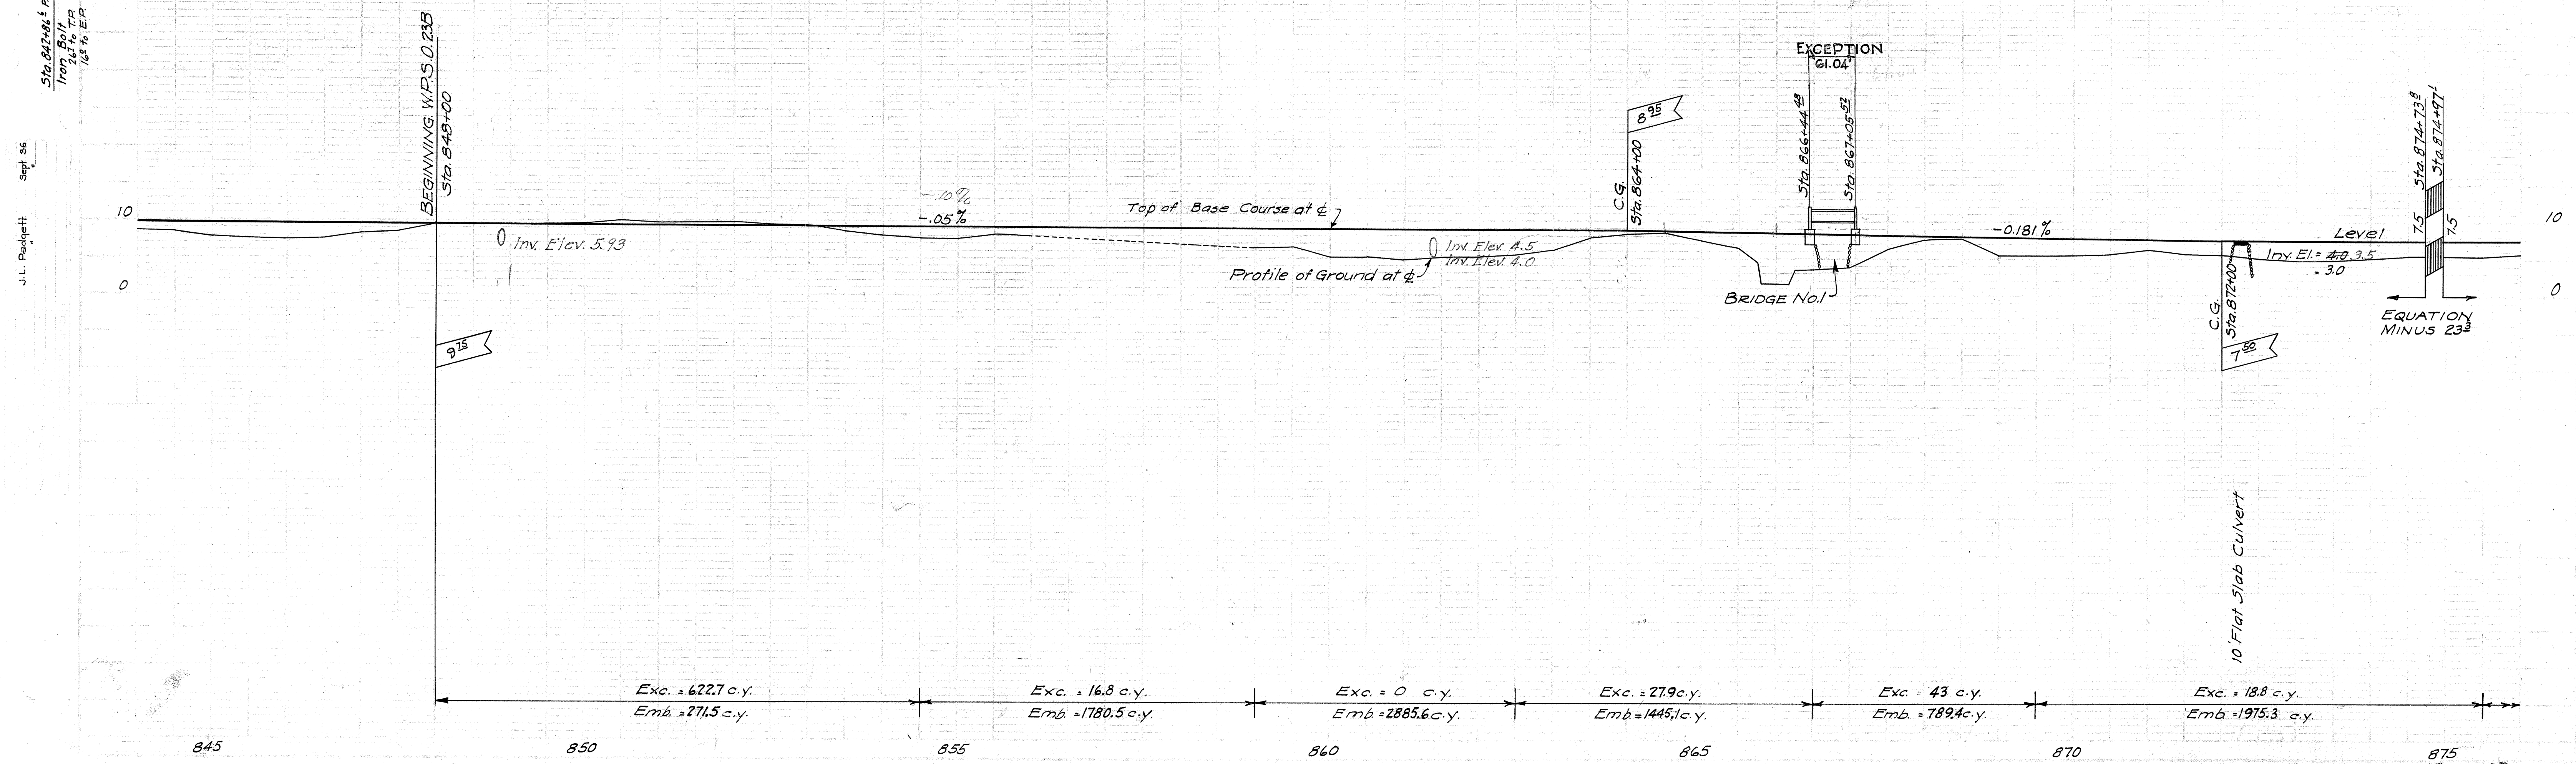

4383.3

FED. ROAD DIST. NO.	STATE	FED. AID PROJ. NO.	FISCAL YEAR	SHEET NO.	TOTAL SHEETS
HAWAII	HAW	W.P.S.O. 23 B	1936	4	83


J.L. Padgett Sept 36

J.L. Padgett Sept 36


U. S. MILITARY RESERVATION

Curve Data.
 $\Delta = 1^\circ 7' L$
 $D = 1^\circ$
 $R = 5730$
 $T = 55.1$
 $L = 111.2$

885+79.11 P.P. + Heavy
 10+53.21 P.P.

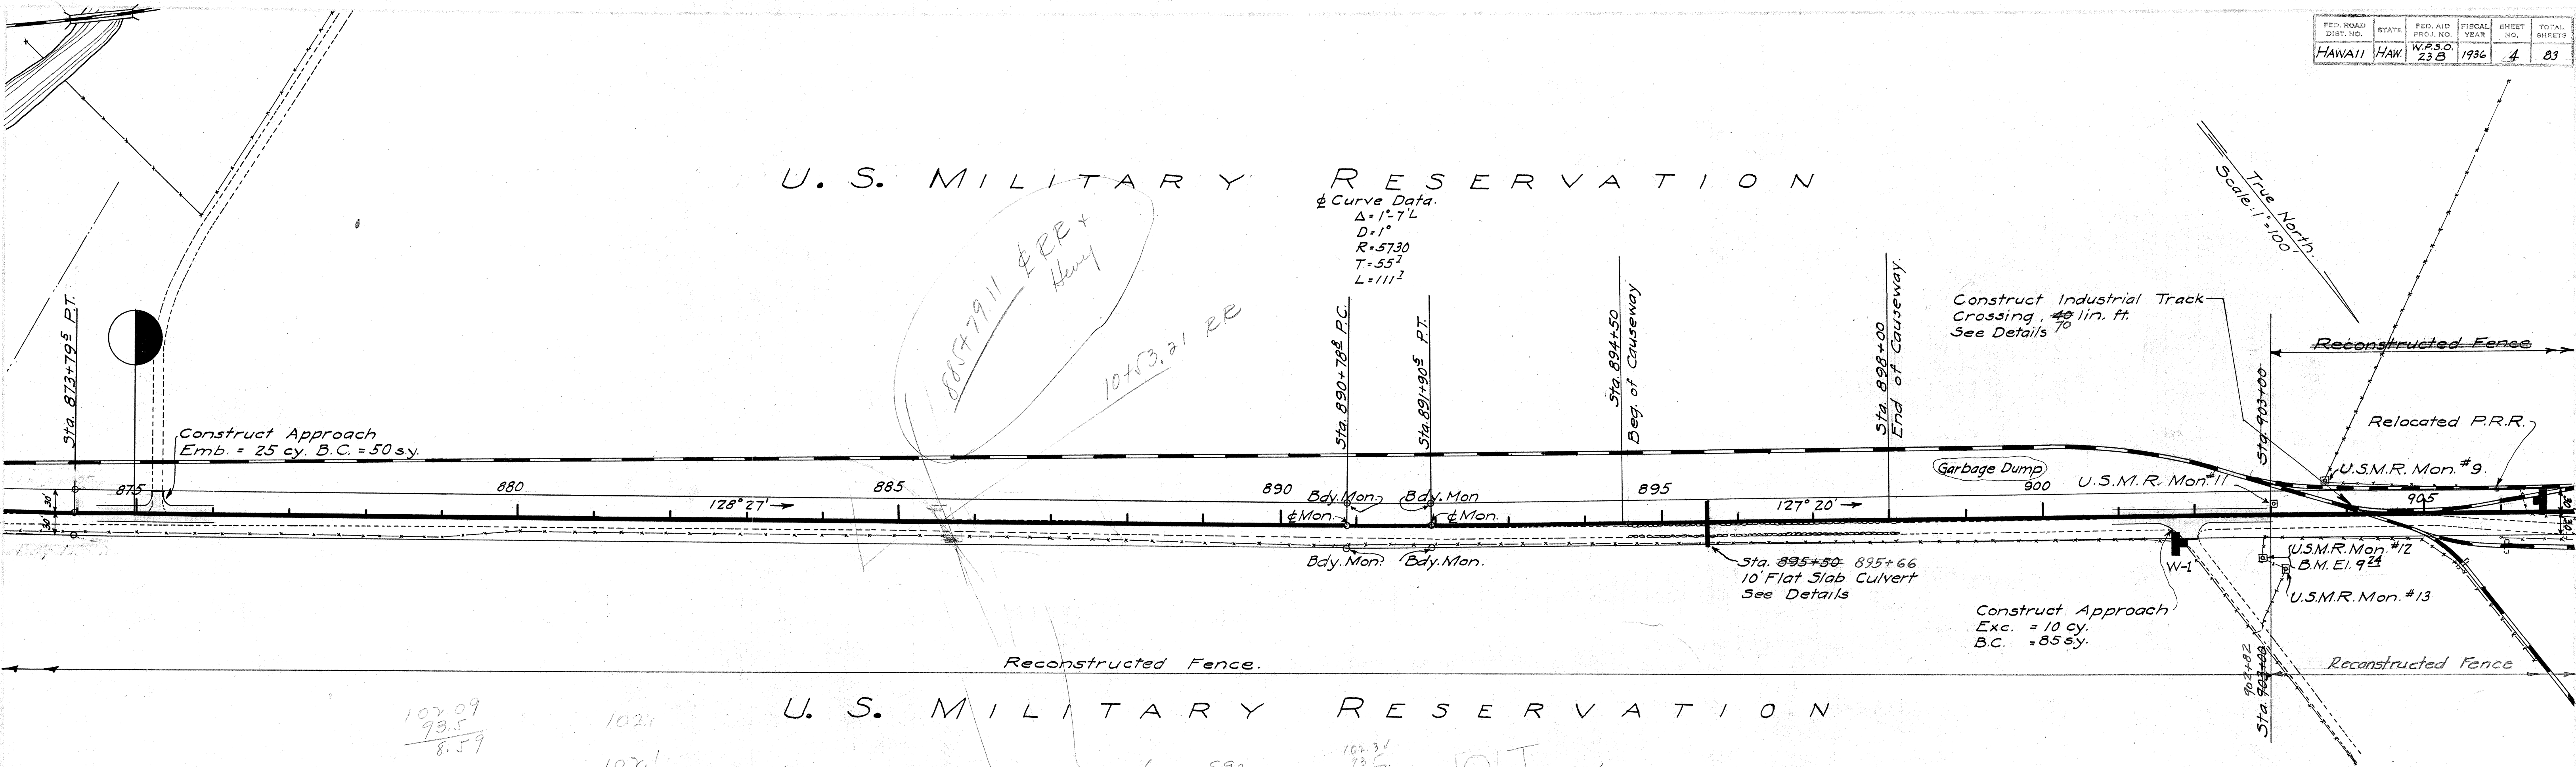


U. S. MILITARY RESERVATION

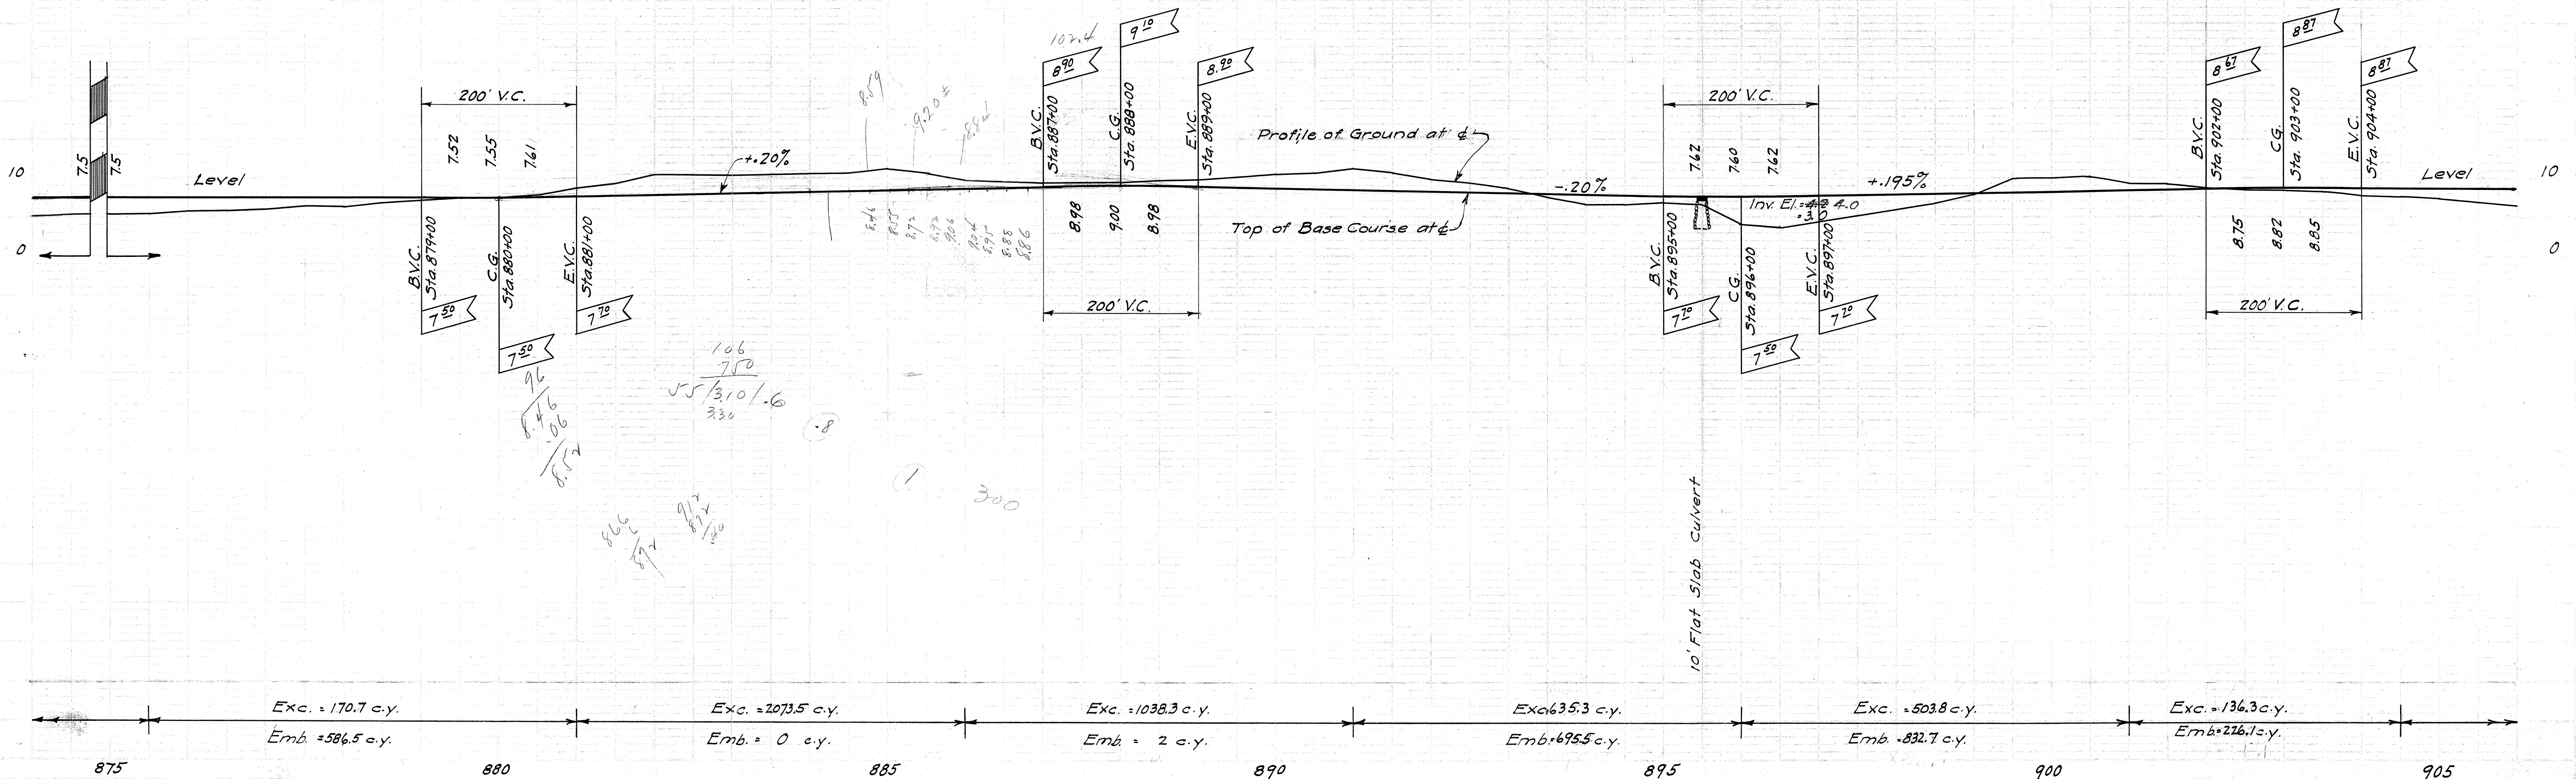


4383.4

J.L. Padgett
Sept 26

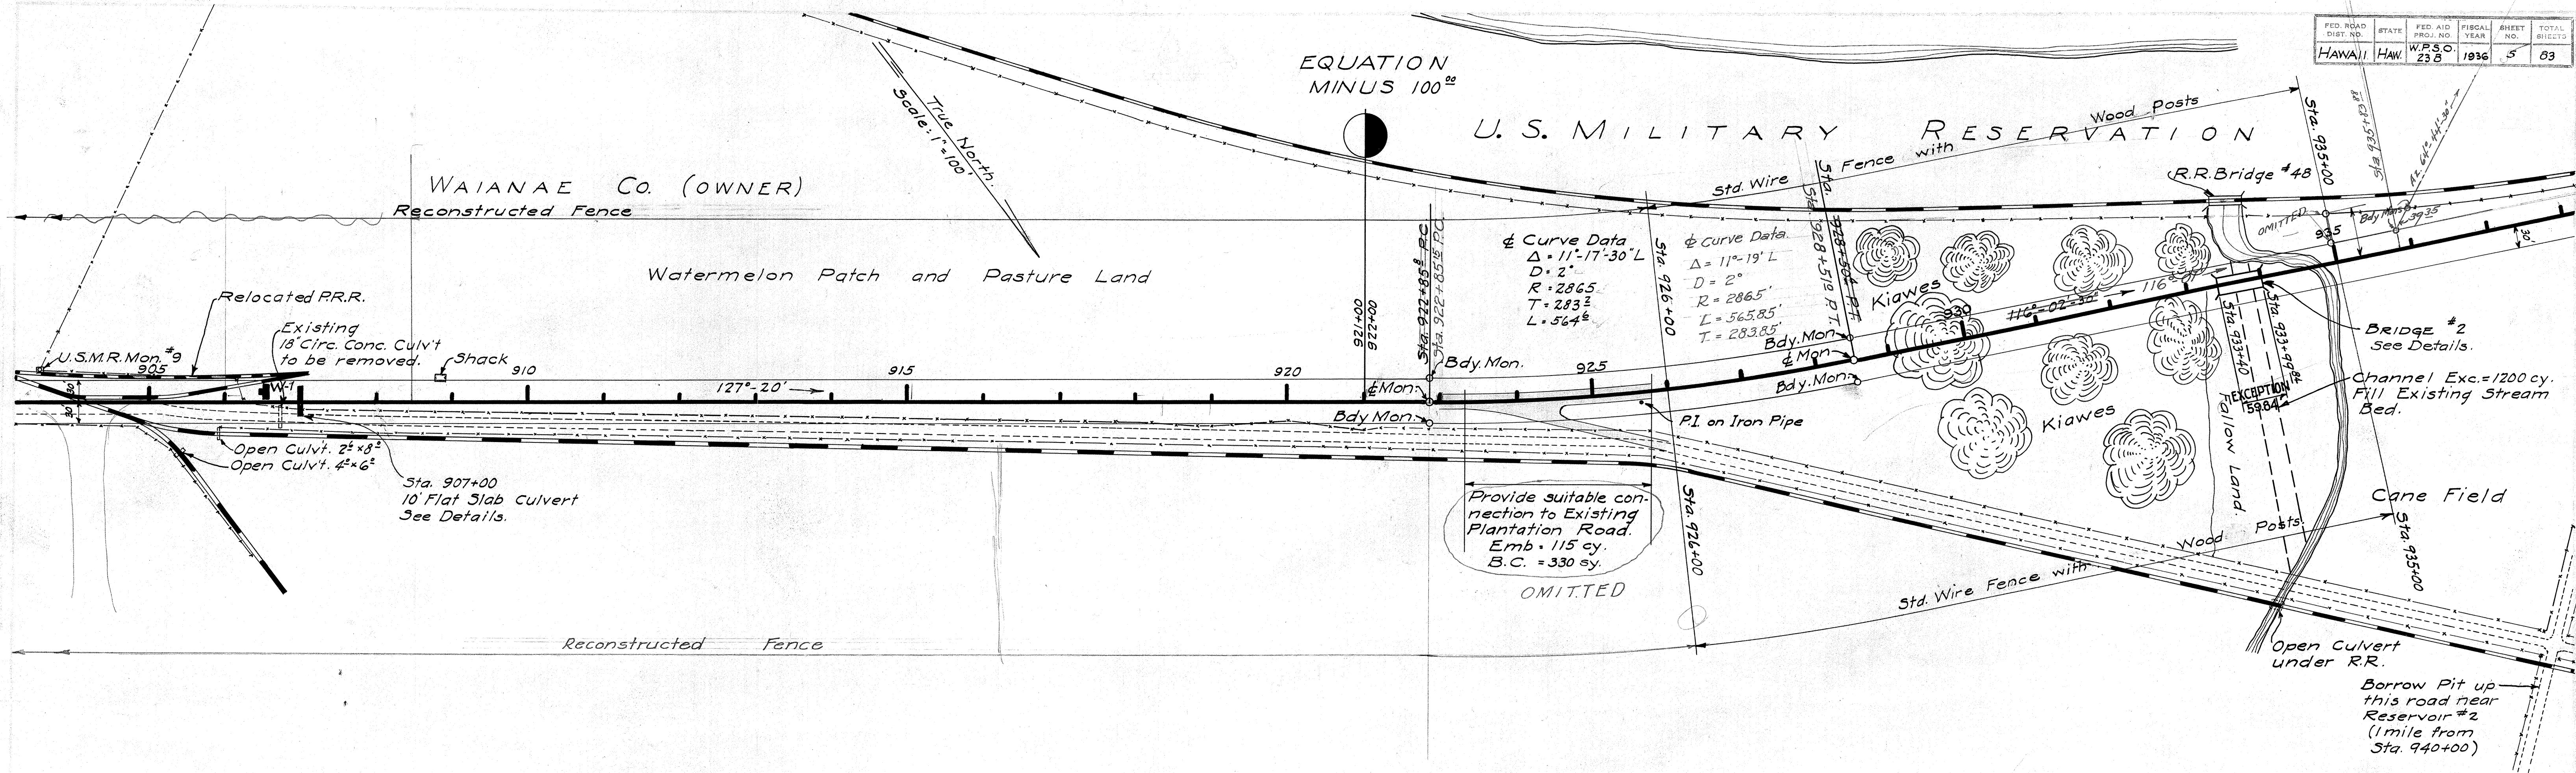


J.L. Padgett
Sept 26

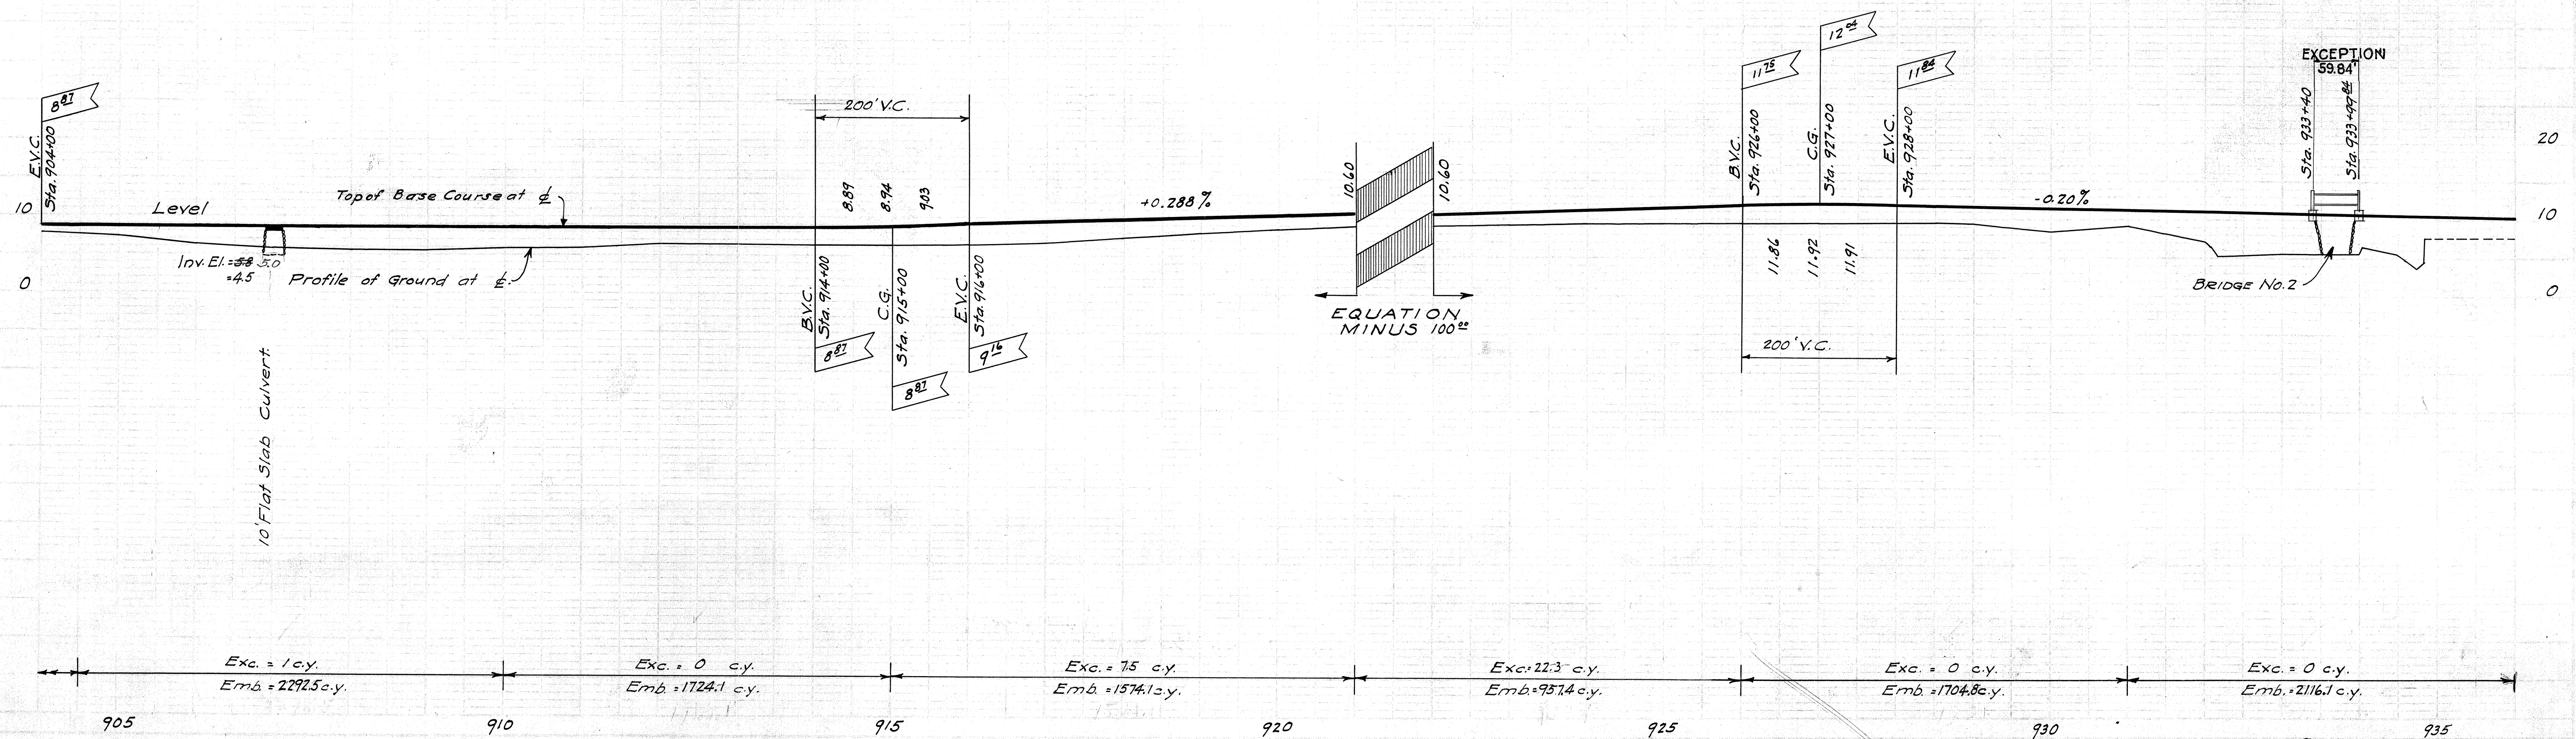


FED. ROAD DIST. NO.	STATE	FED. AID PROJ. NO.	FISCAL YEAR	SHEET NO.	TOTAL SHEETS
HAWAII	HAW.	W.P.S.O. 238	1936	6	83

J.L. Padgett Sept. 36


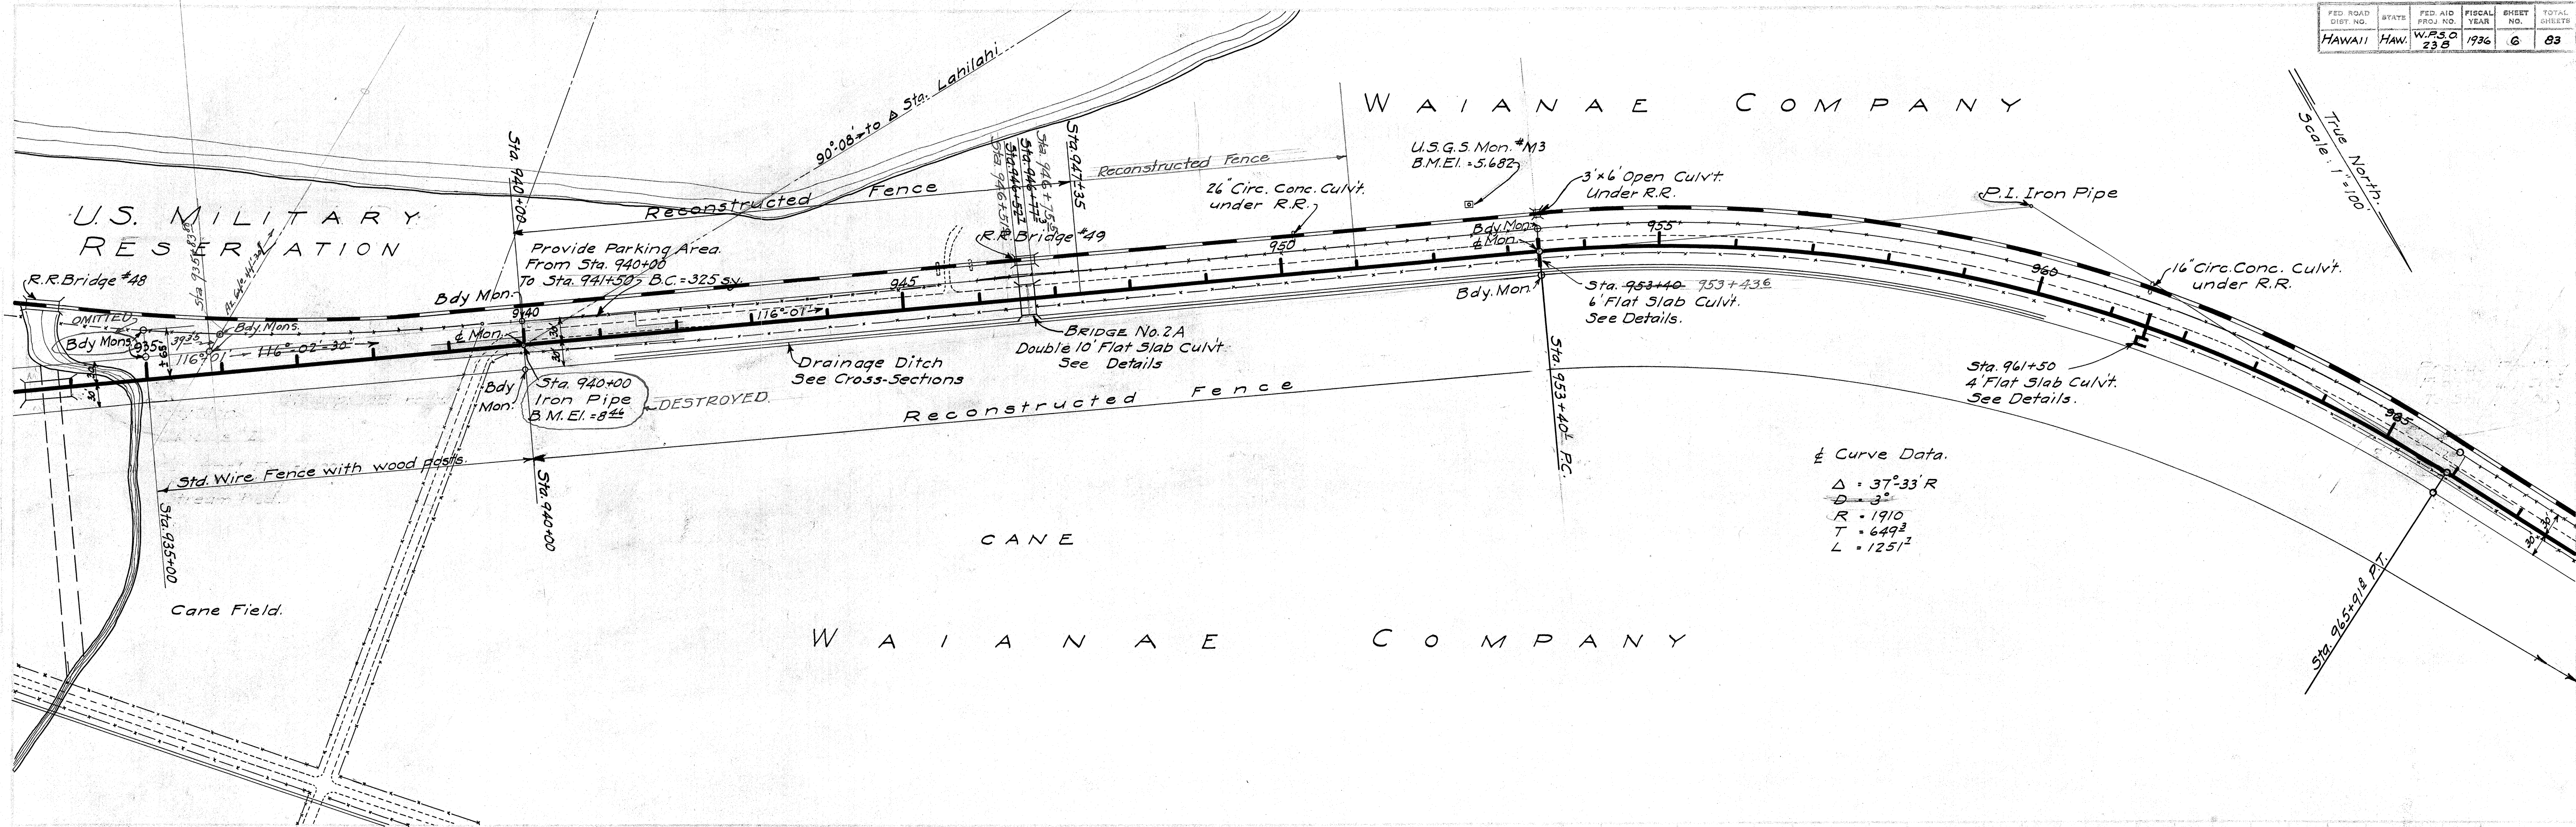


J.L. Padgett Sept. 36

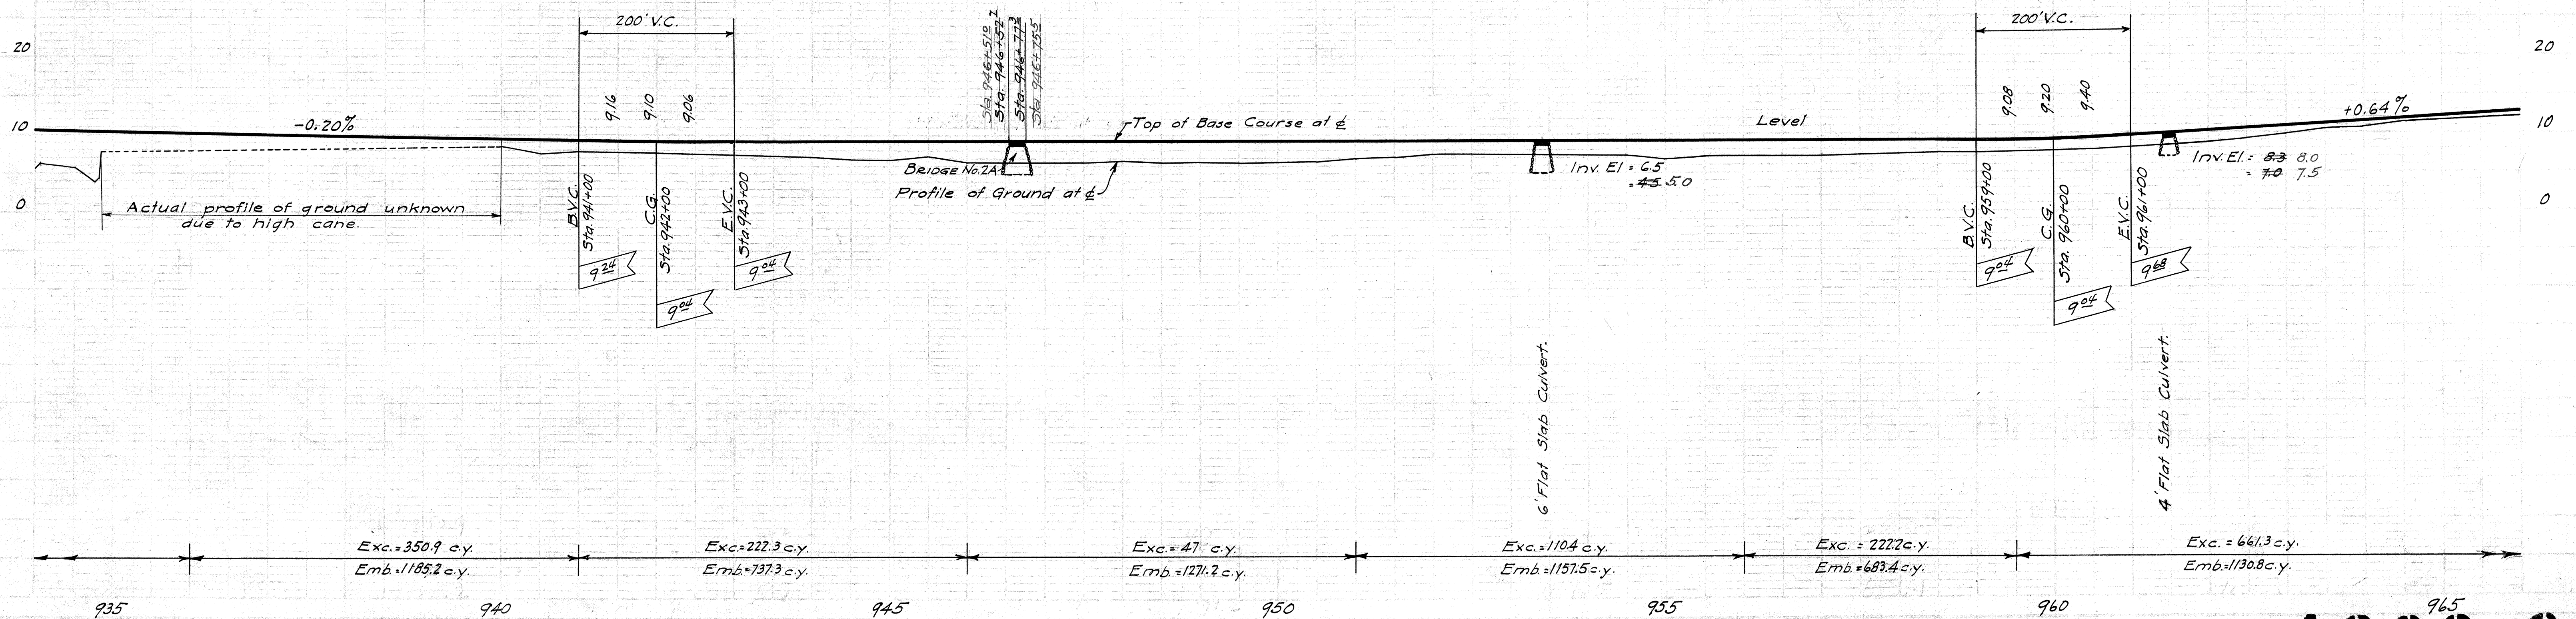

4383.6



J.L. Padgett Sept. 36

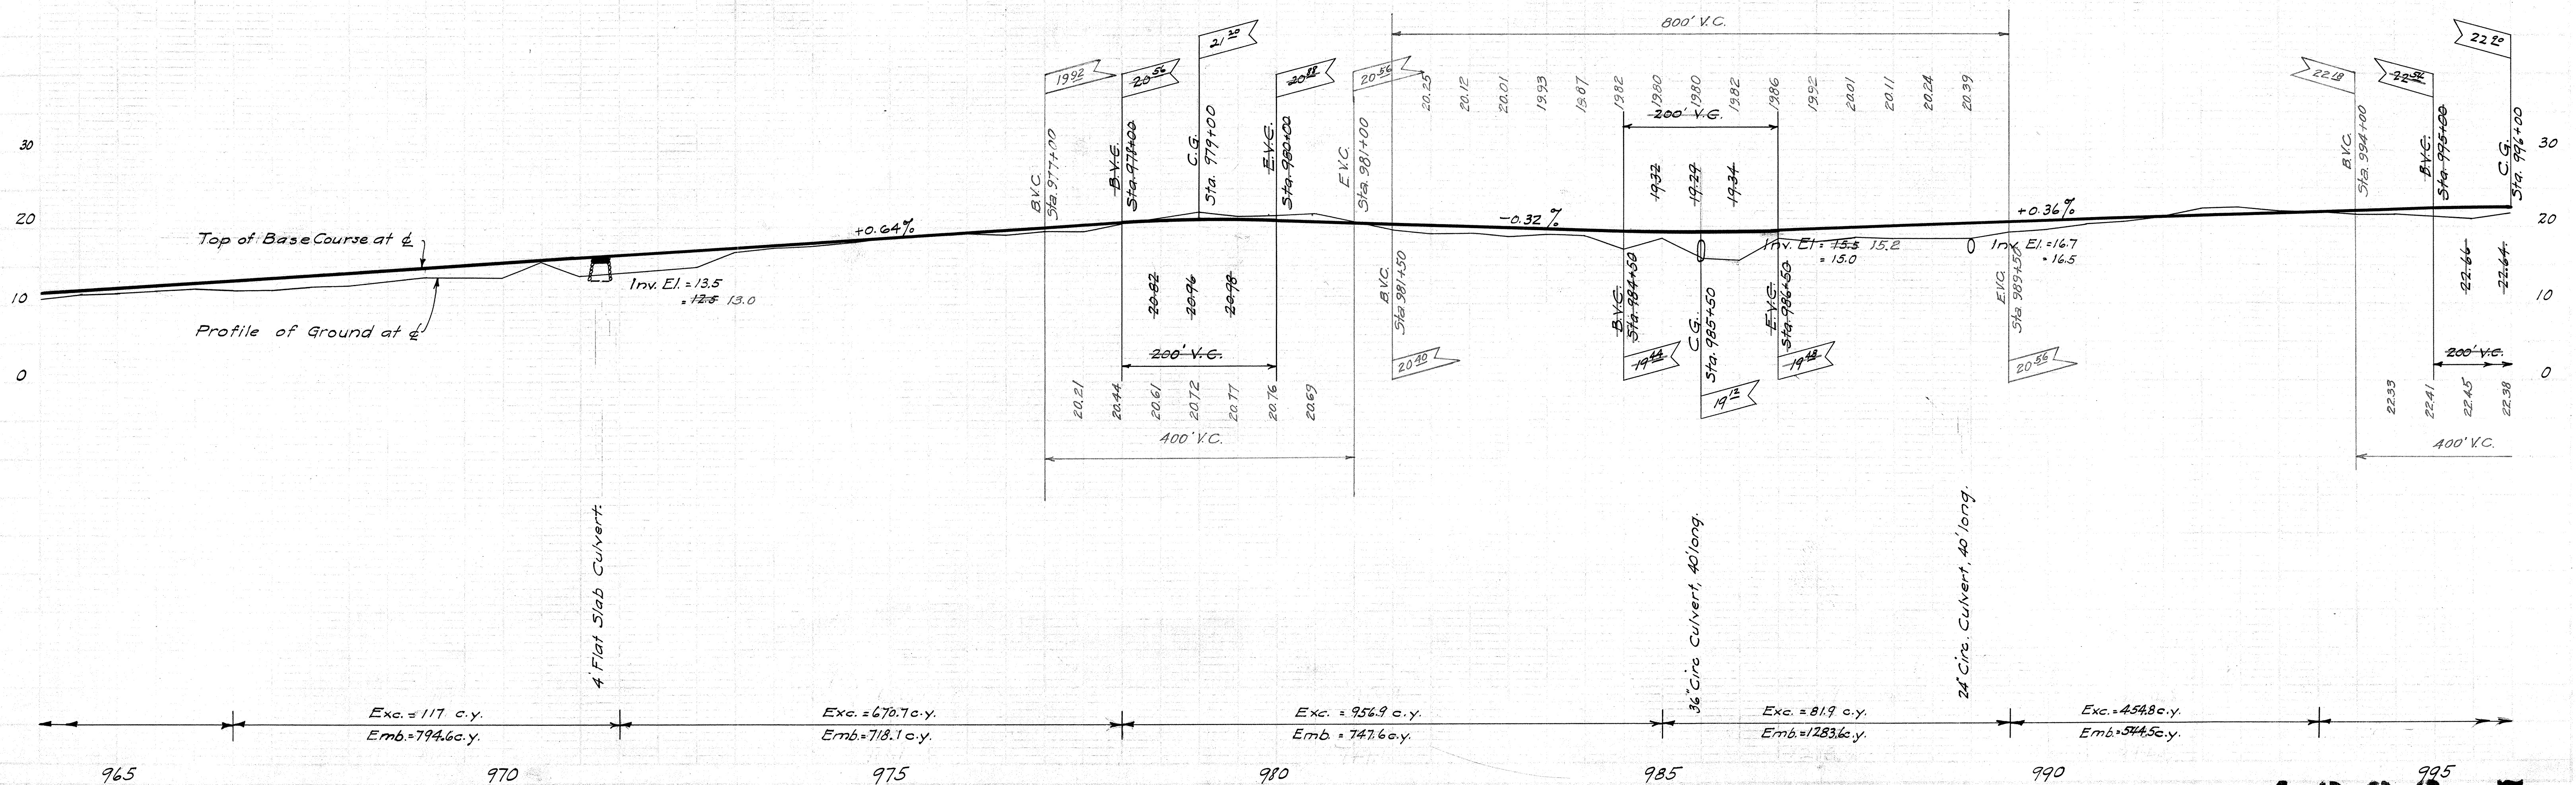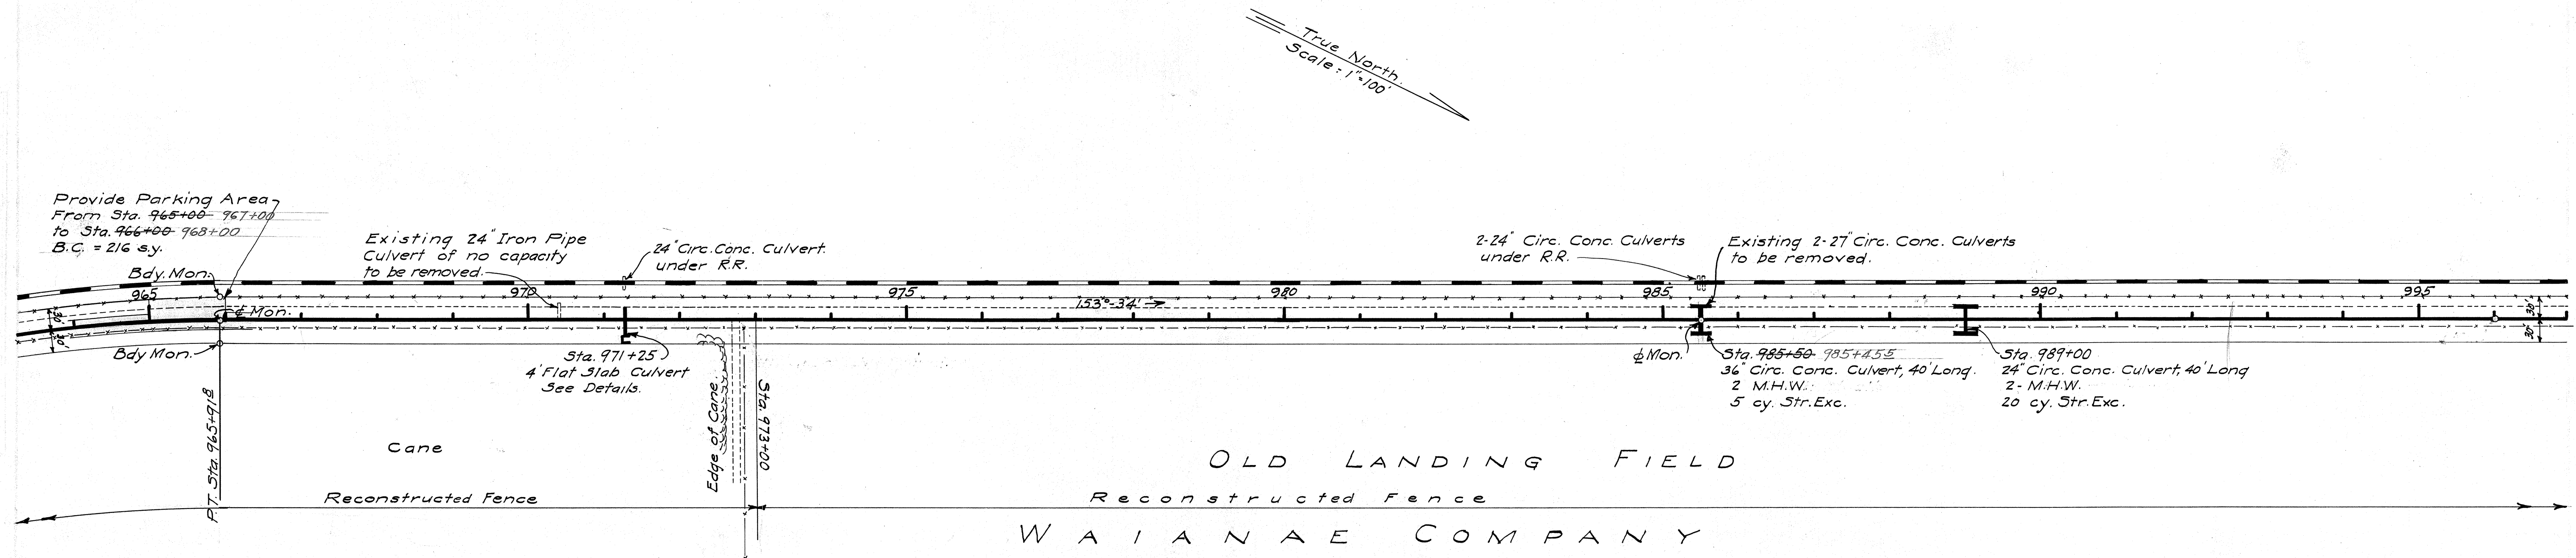

J.L. Padgett Sept. 36

438⁹⁹⁵3.7

FED. ROAD DIST. NO.	STATE	FED. AID PROJ. NO.	FISCAL YEAR	SHEET NO.	TOT. SHEETS
HAWAII	HAW.	W.P.S.O. 23.5	1936	8	83

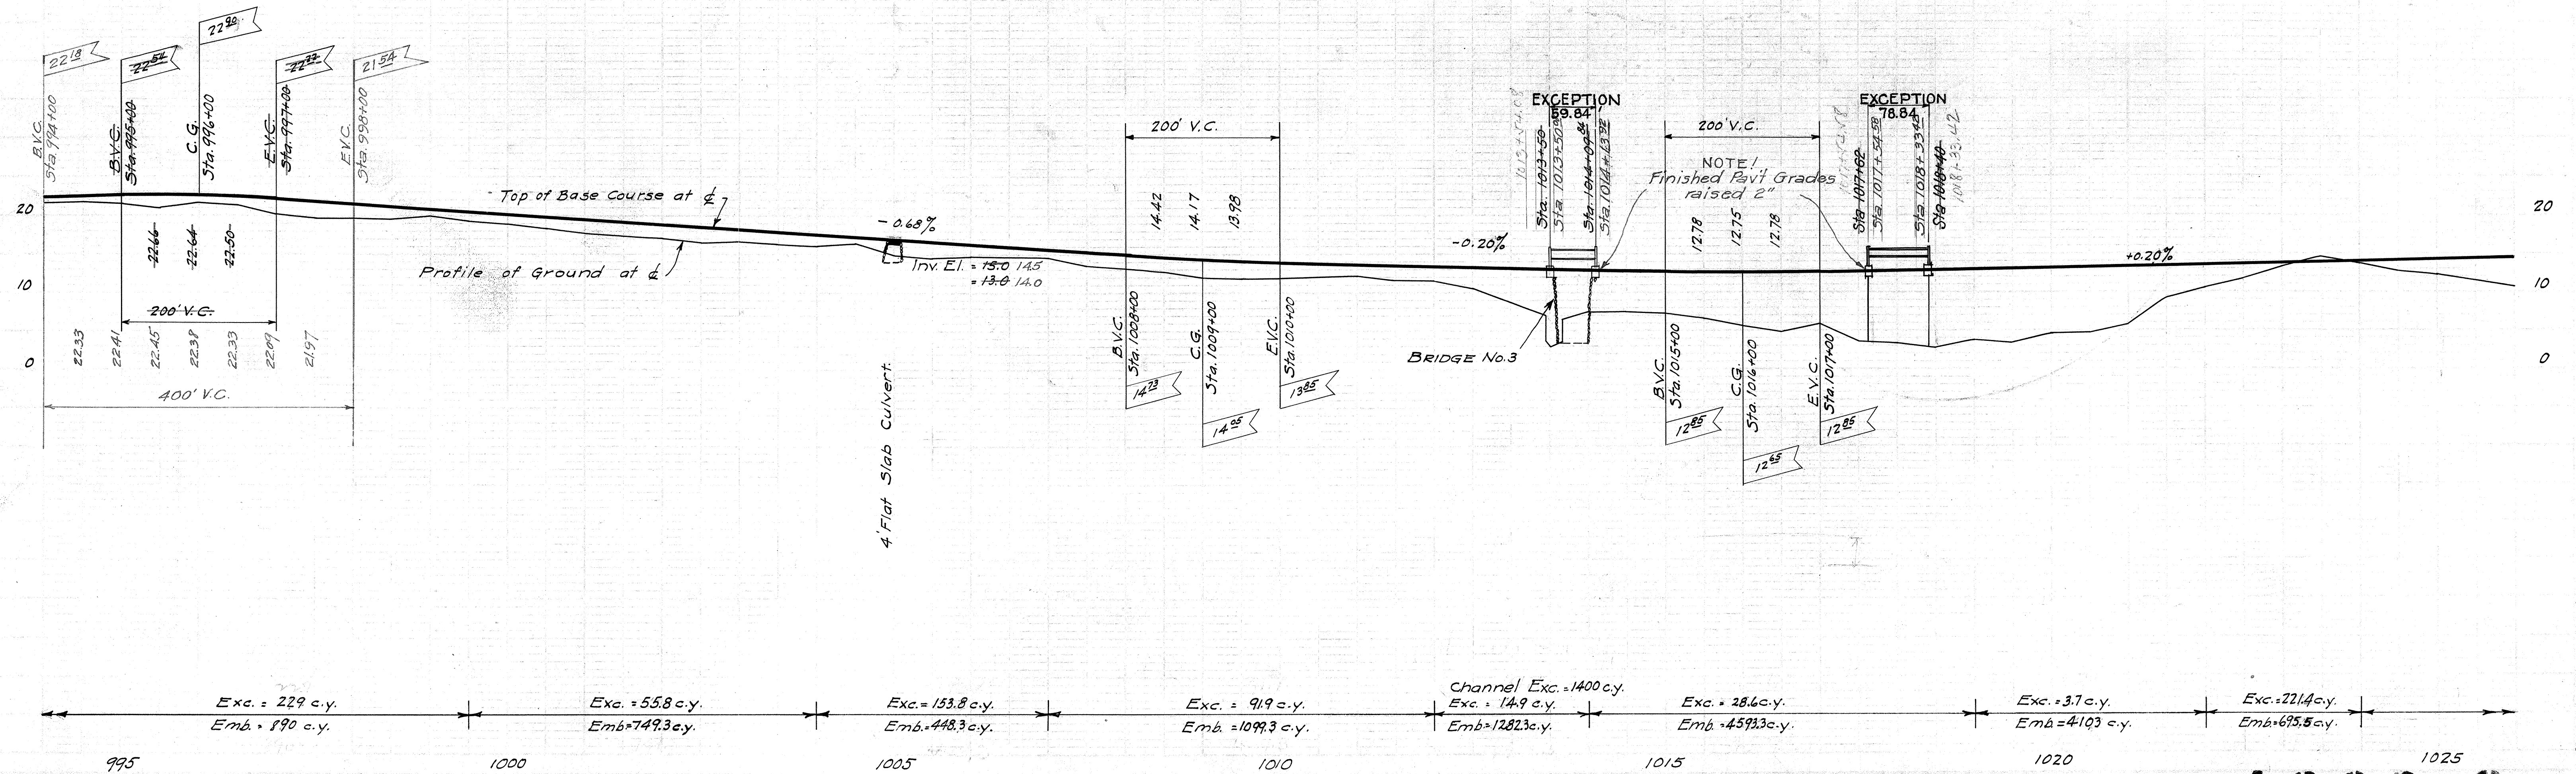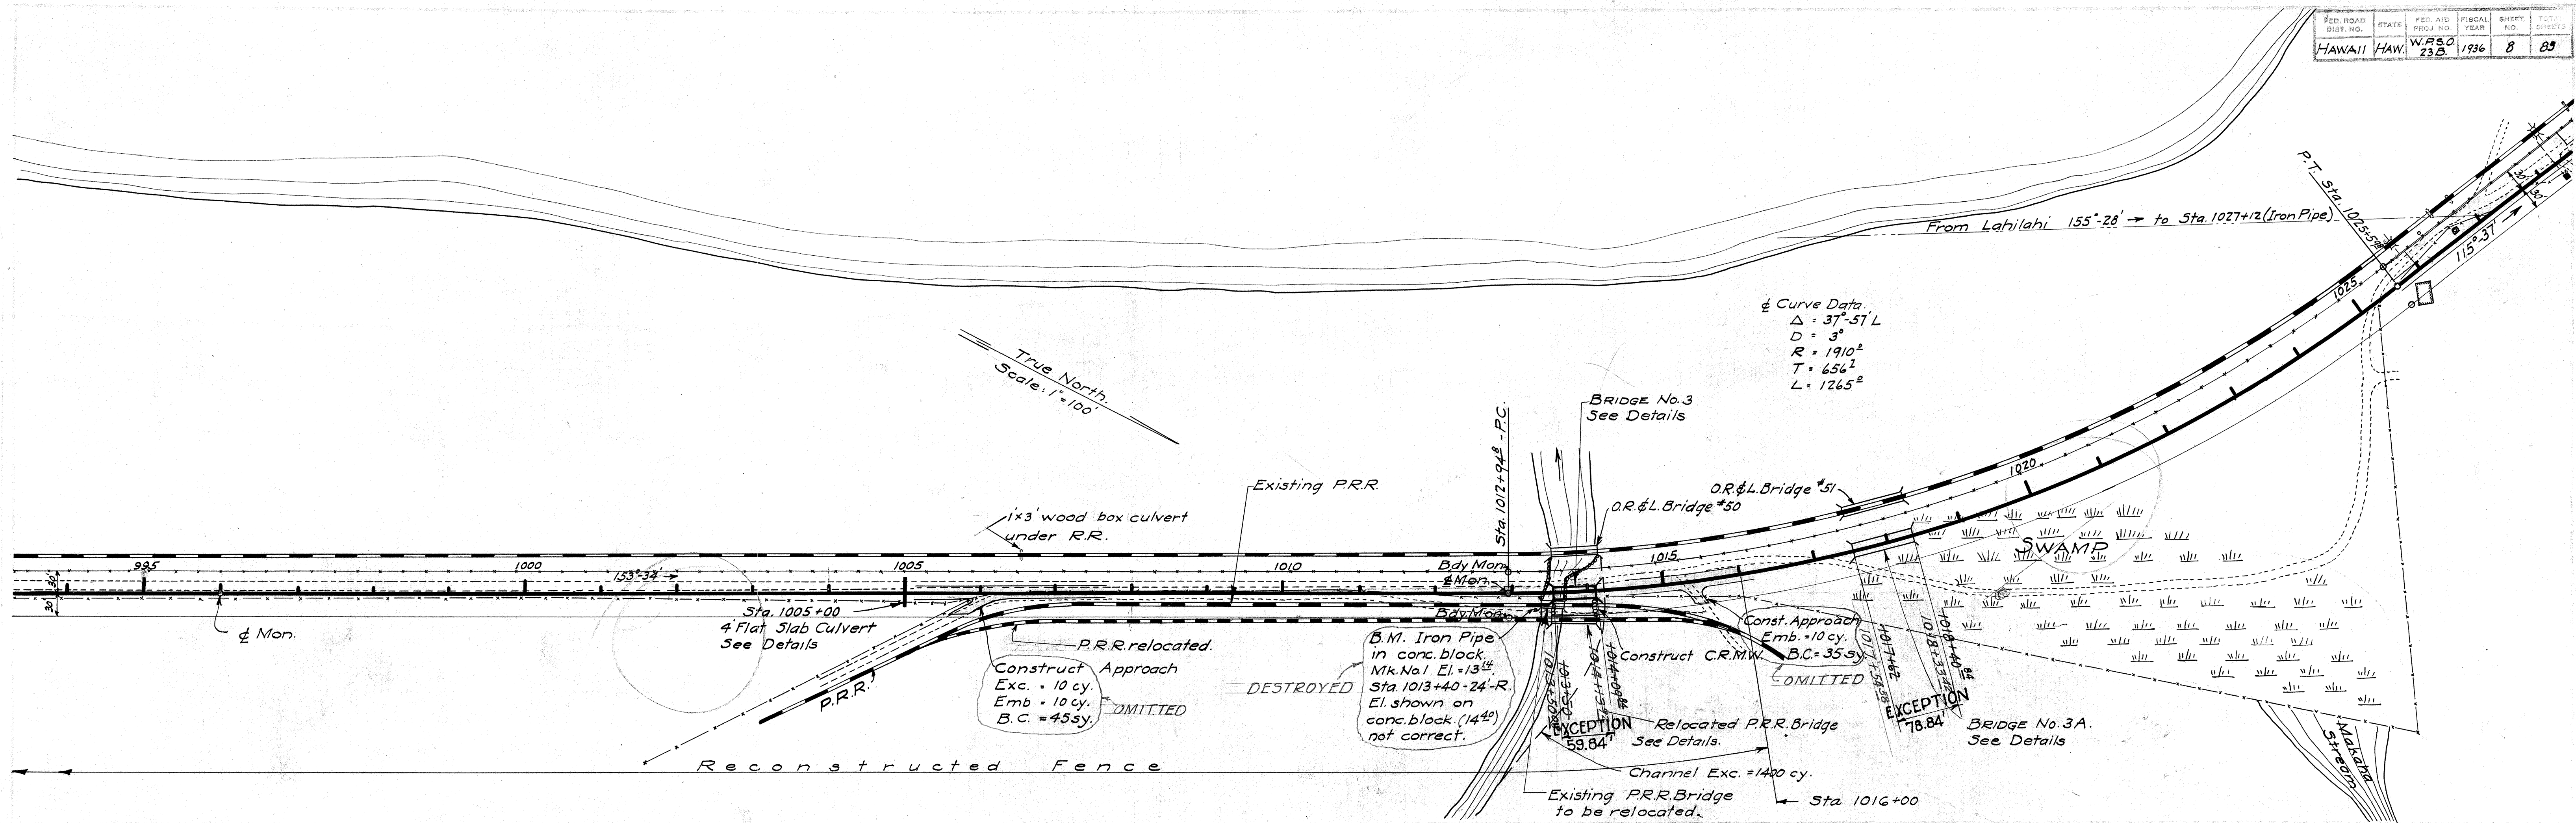


4383.8

FED. ROAD DIST. NO.	STATE	FED. AID PROJ. NO.	FISCAL YEAR	SHEET NO.	TOTAL SHEETS
HAWAII	HAW.	W.P.3.0, 23.5	1936	9	89

Sept 36
J.L. Radgett


Sept 36
J.L. Radgett

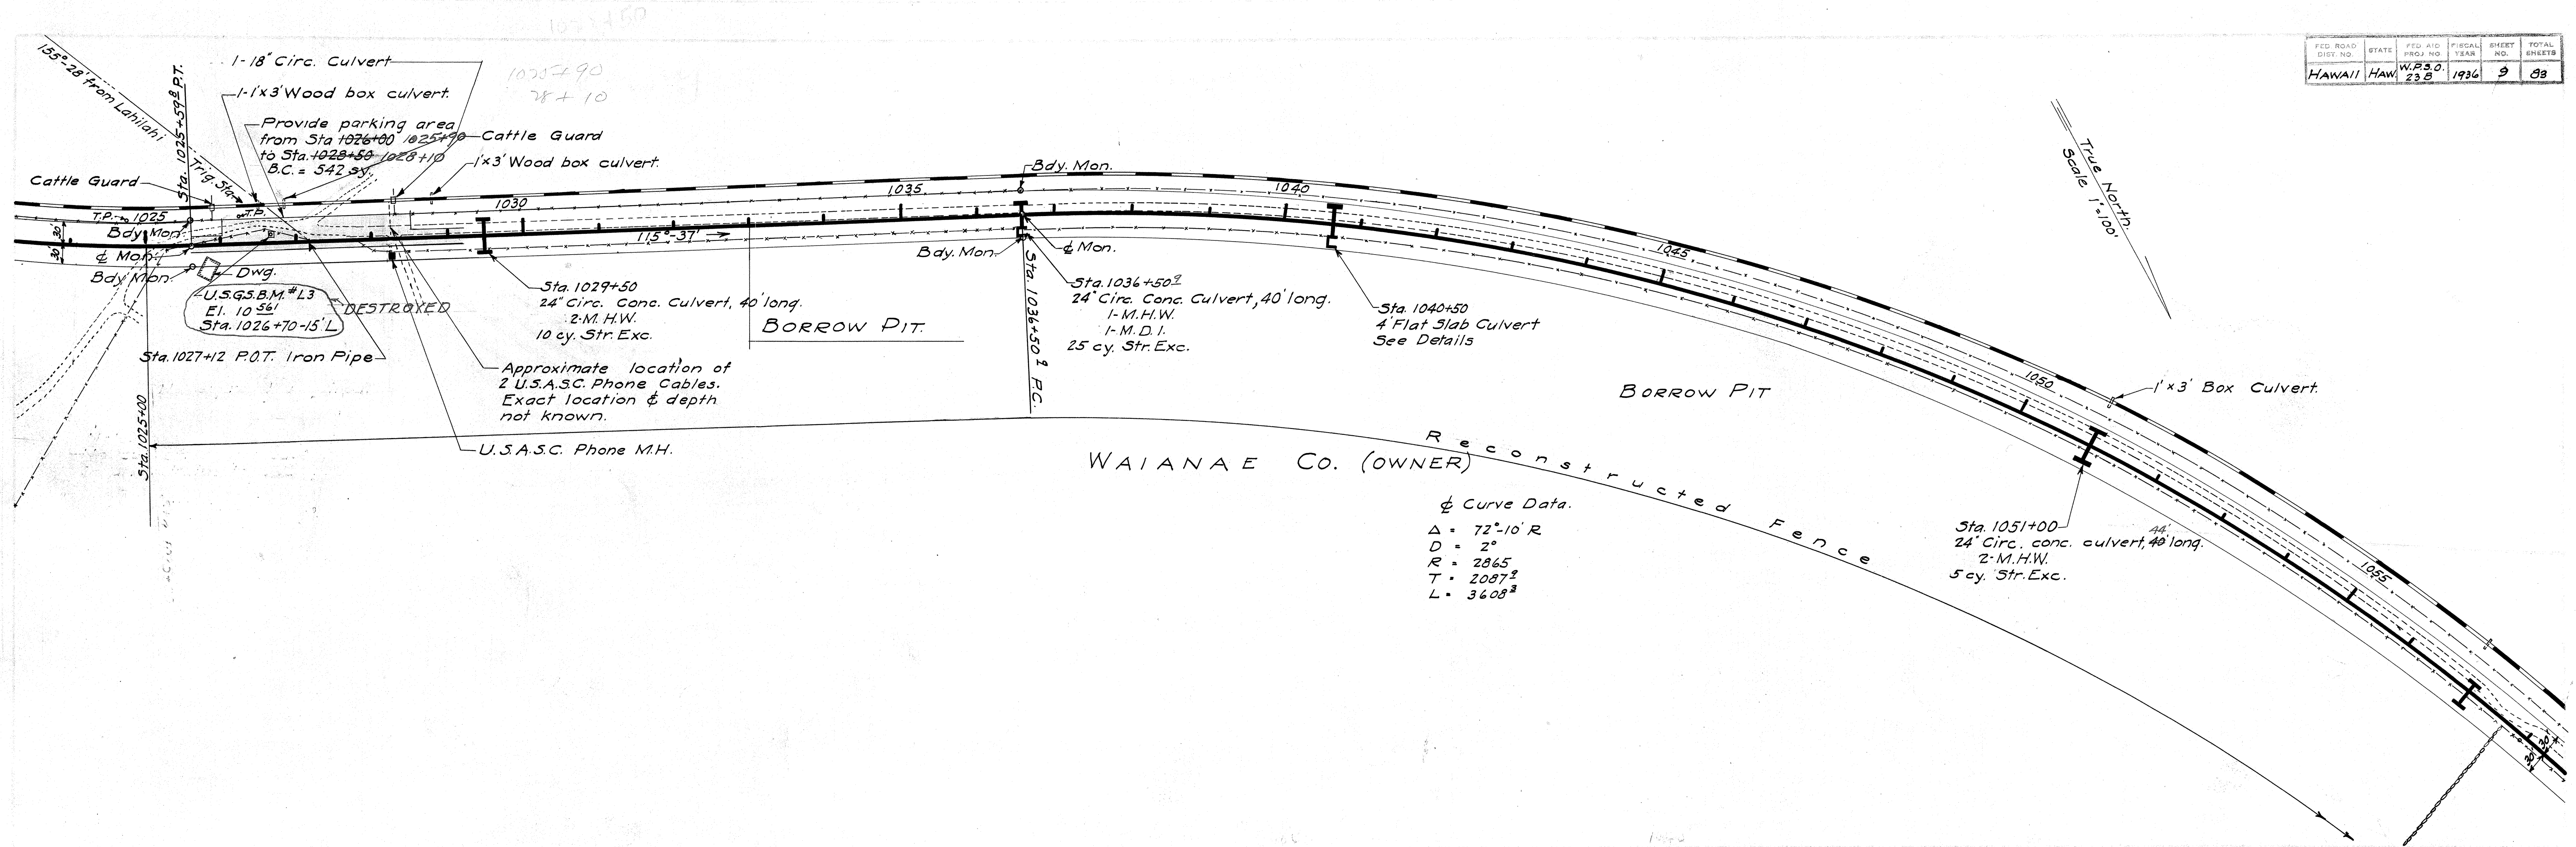

WAIANAE CO. (OWNER)

Curve Data.

$\Delta = 72^\circ 10'$
 $D = 2^\circ$
 $R = 2865$
 $T = 2087.2$
 $L = 3608.3$

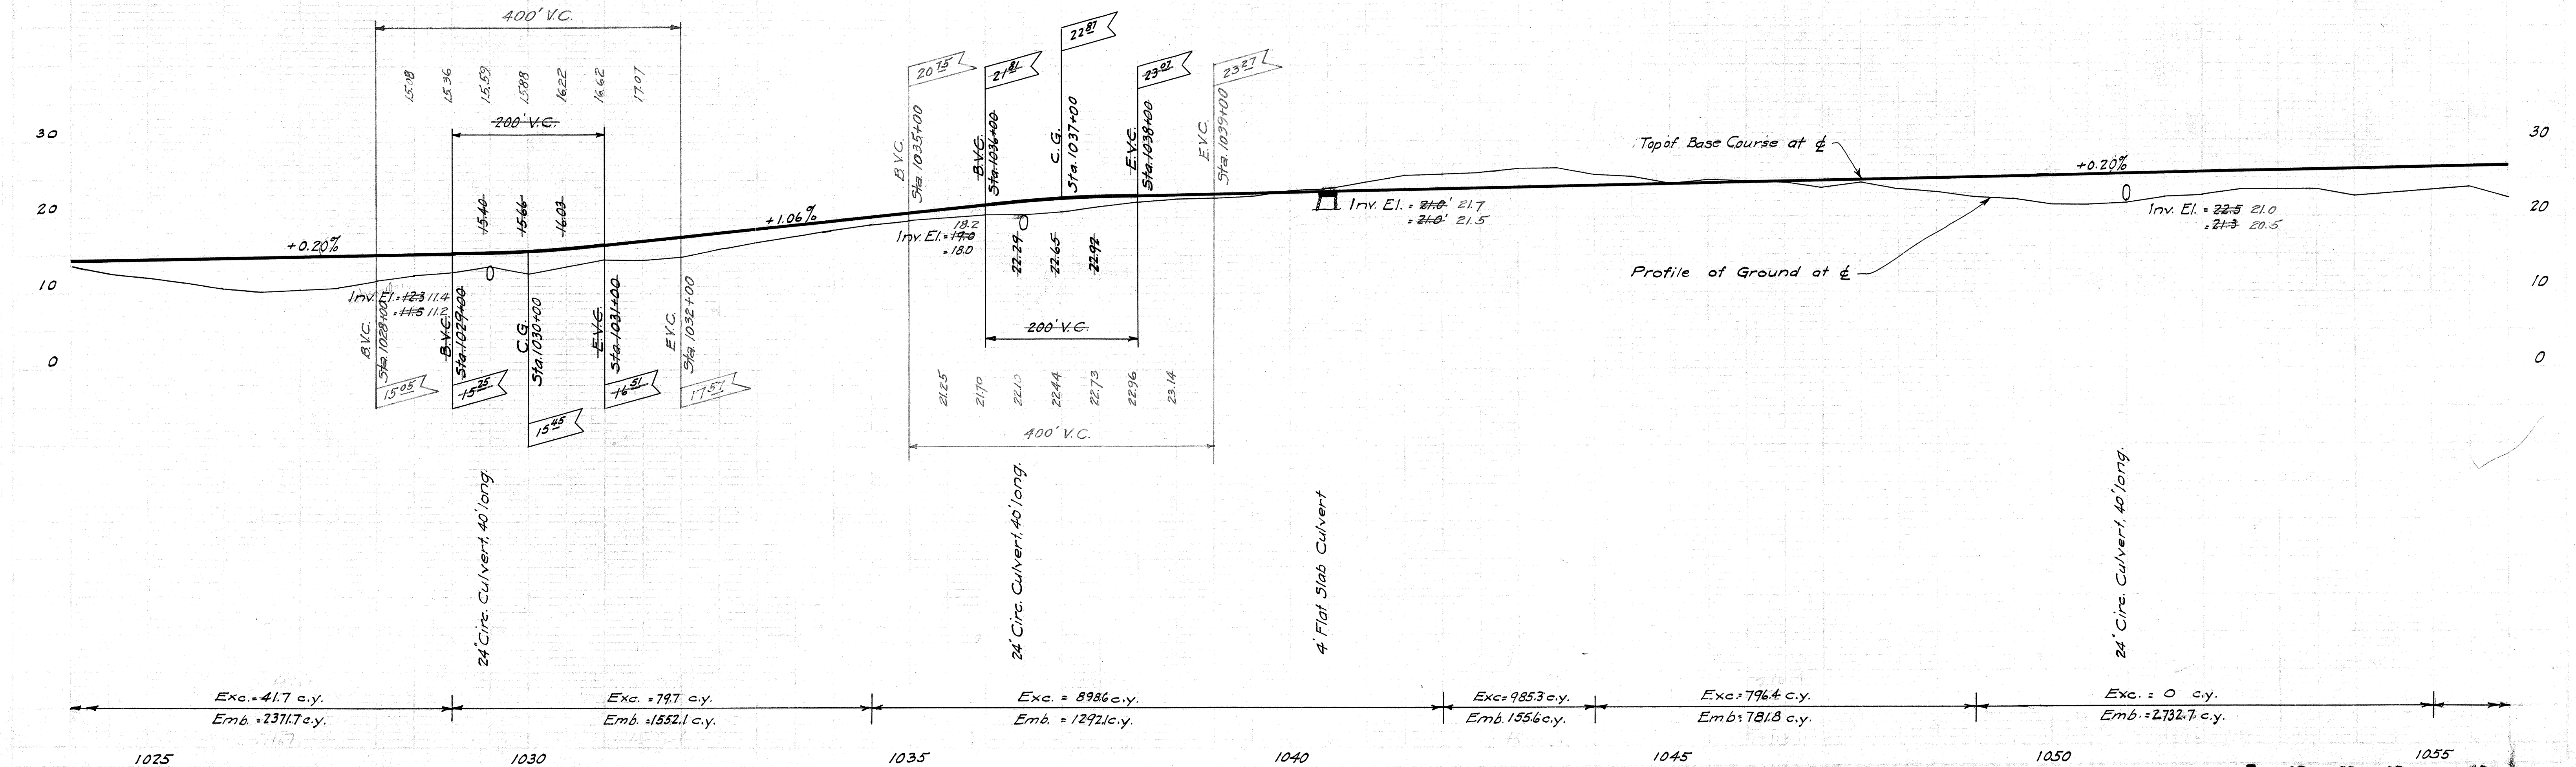

4383.9

FED. ROAD DIST. NO.	STATE	FED. AID PROJ. NO.	FISCAL YEAR	SHEET NO.	TOTAL SHEETS
HAWAII	HAW.	W. 25.0 23.8	1936	10	83



TERRITORY OF HAWAII (OWNER)
L. L. McCANDLESS (LESSEE)

WAIANAE CO. (OWNER)

WAIANAE CO. (OWNER)

AGNES CHUN HOON (OWNER)

True North
Scale: 1"=100'

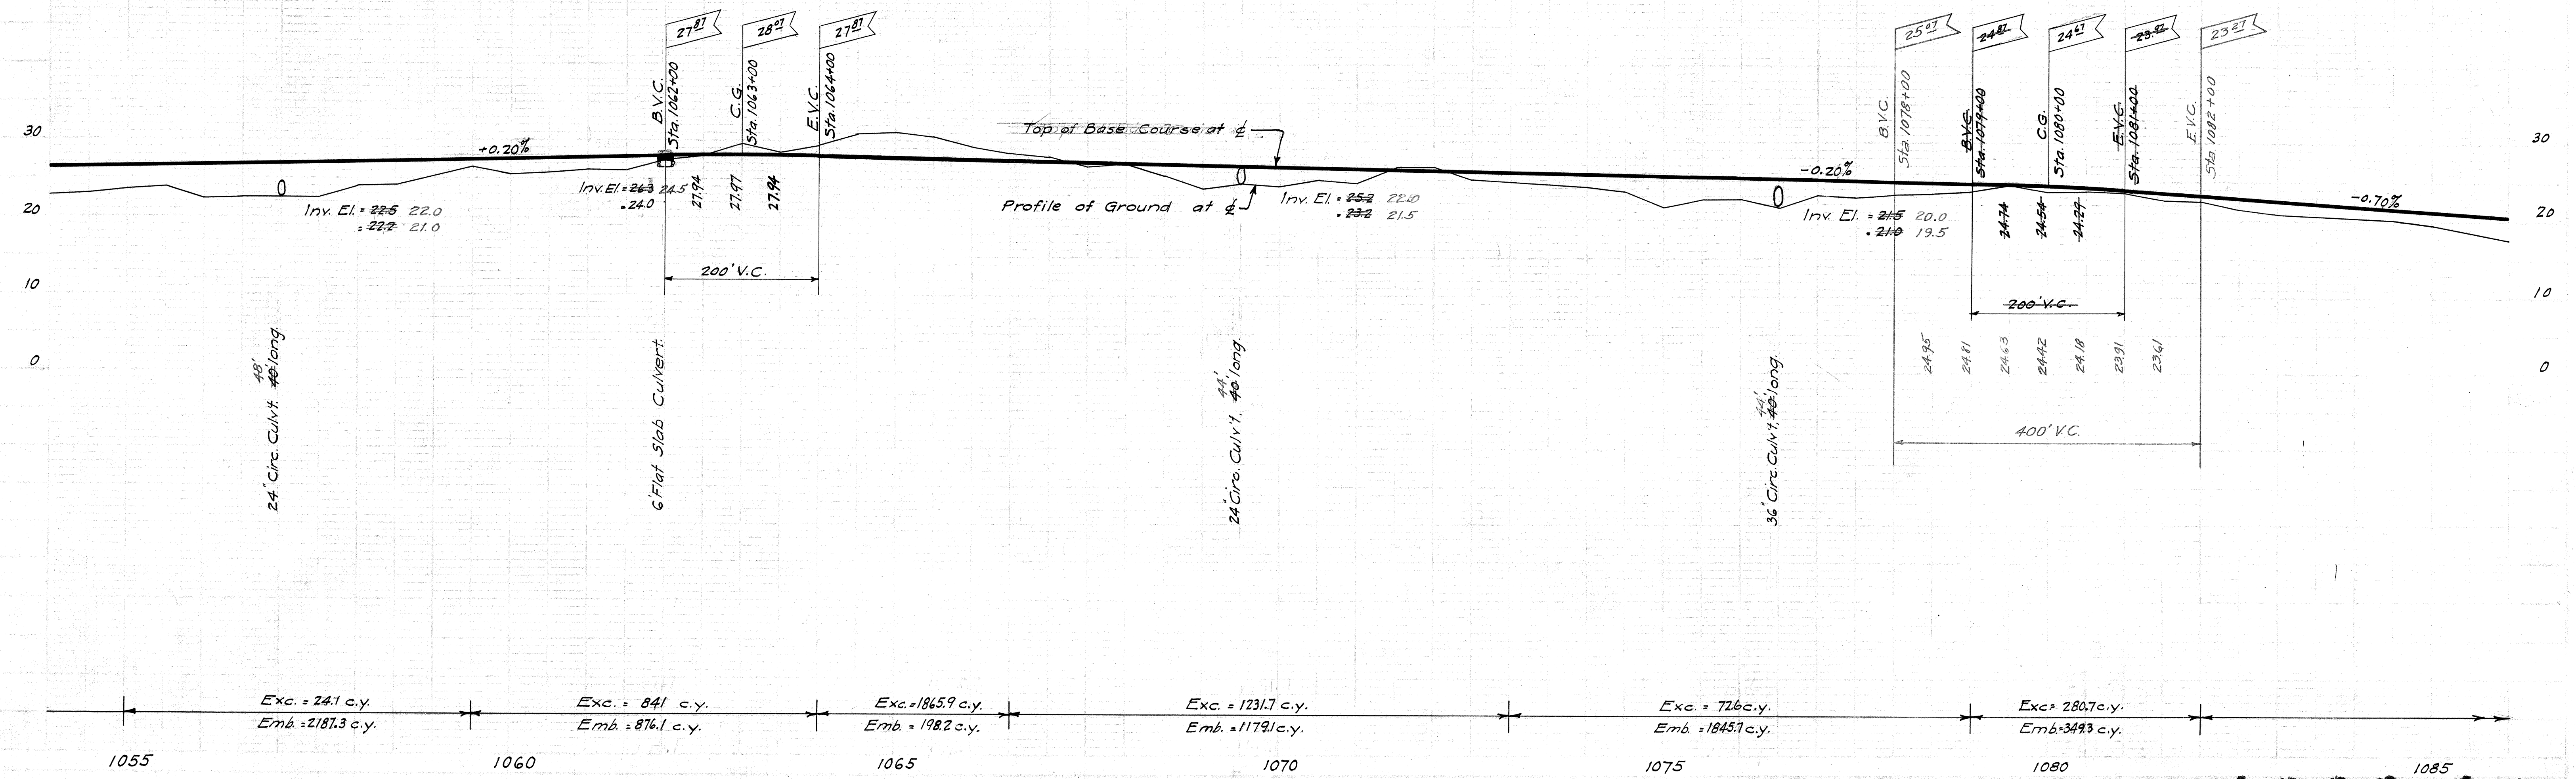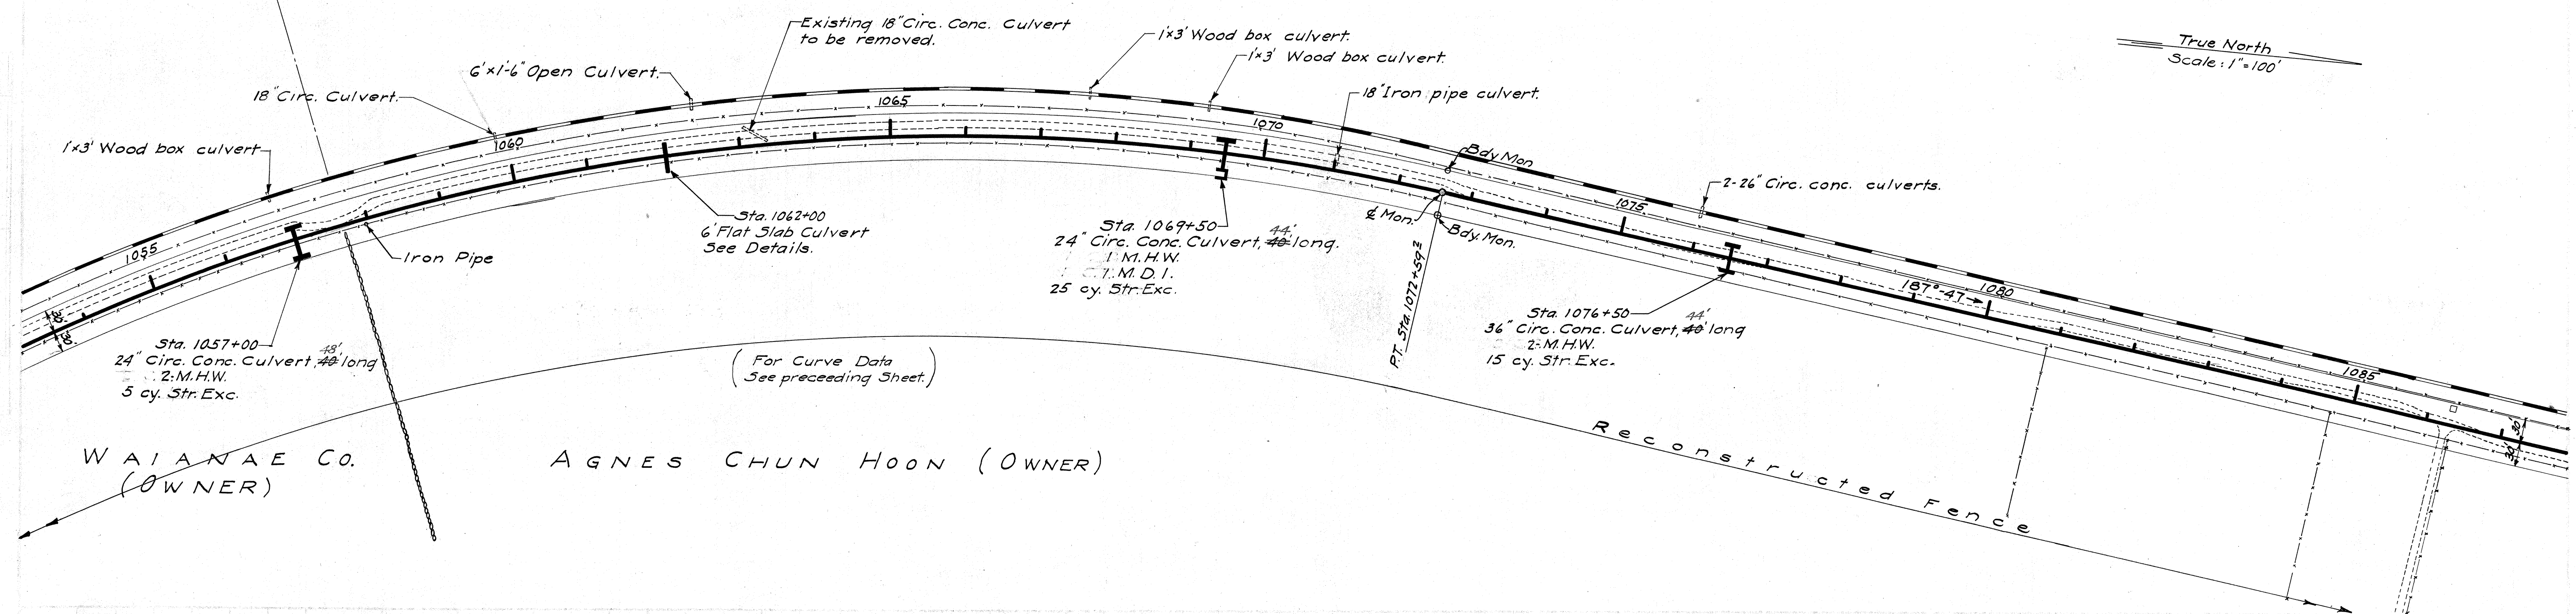


4383.10


FED. ROAD DIST. NO.	STATE	FED. AID PROJ. NO.	FISCAL YEAR	SHEET NO.	TOTAL SHEETS
HAWAII	HAW.	W.P. 5.0 238	1936	11	83

TERRITORY OF HAWAII (OWNER) L. L. McCANDLESS (LESSEE)

Curve Data.
 $\Delta = 15^\circ 52' L$
 $D = 2^\circ$
 $R = 2865'$
 $T = 399\frac{1}{2}'$
 $L = 793\frac{1}{2}'$

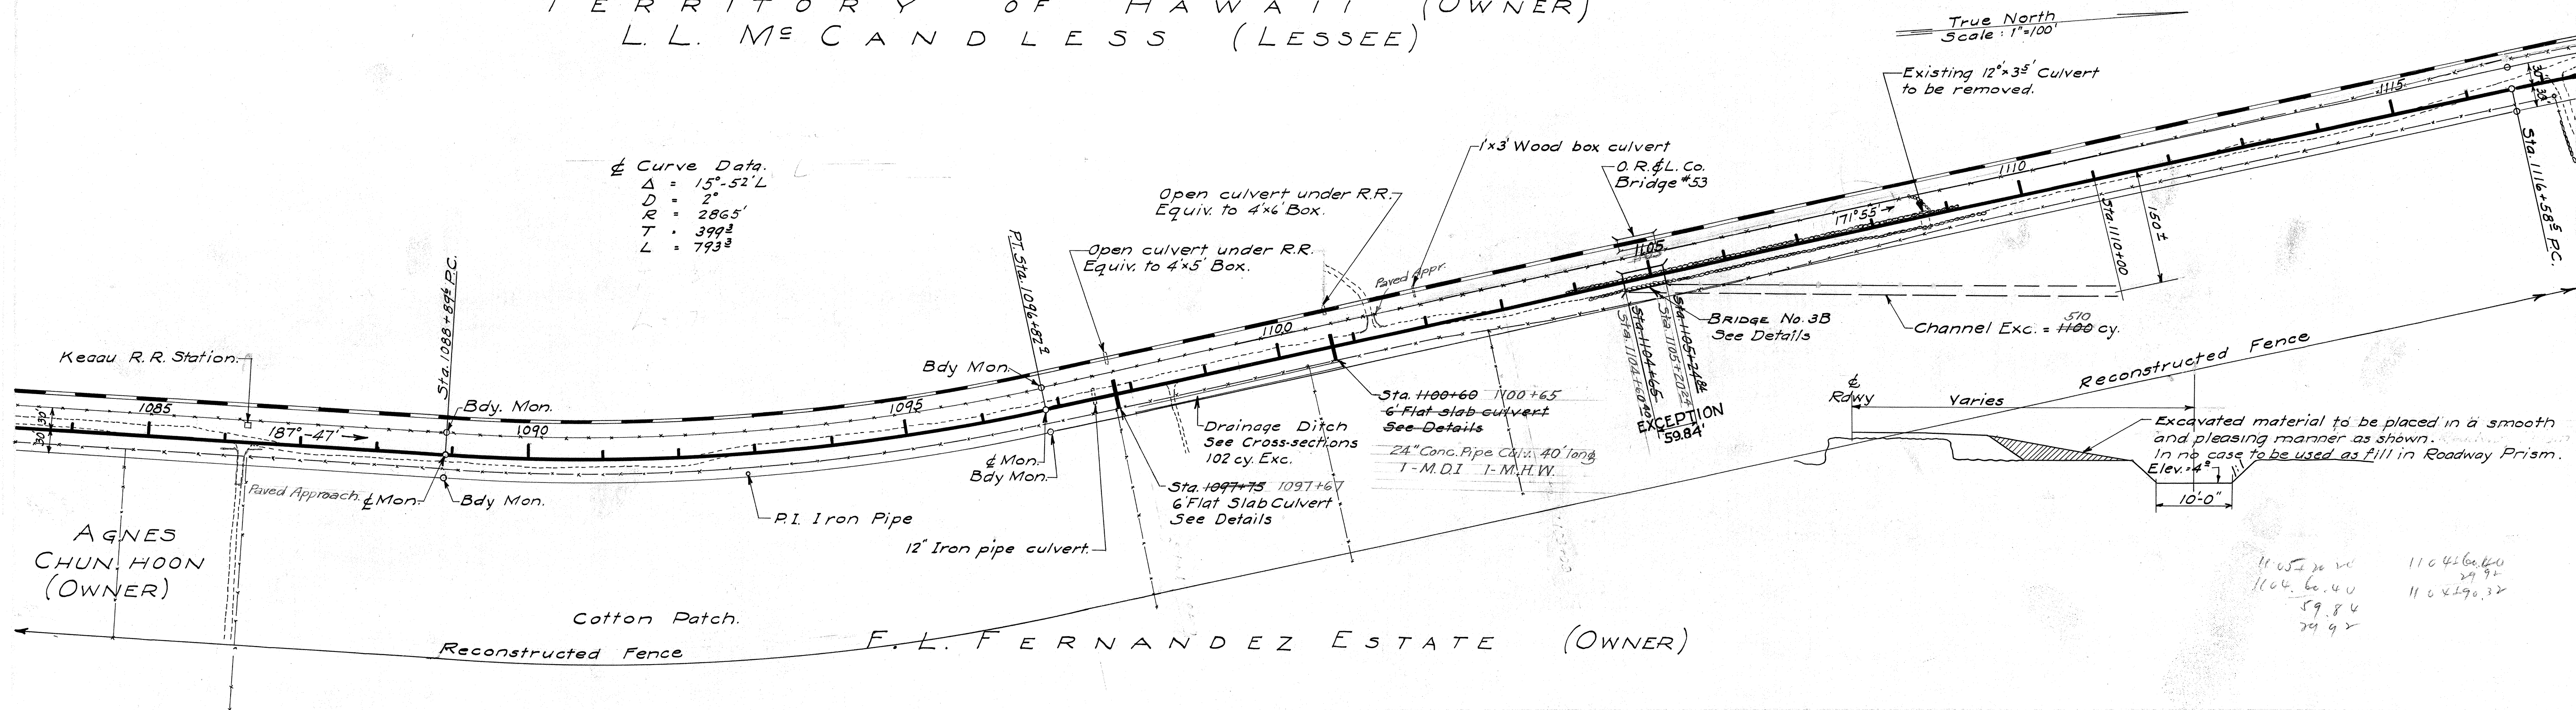

1105+30 VC 11046.60
 1104.60.40 29.92
 59.84
 29.92

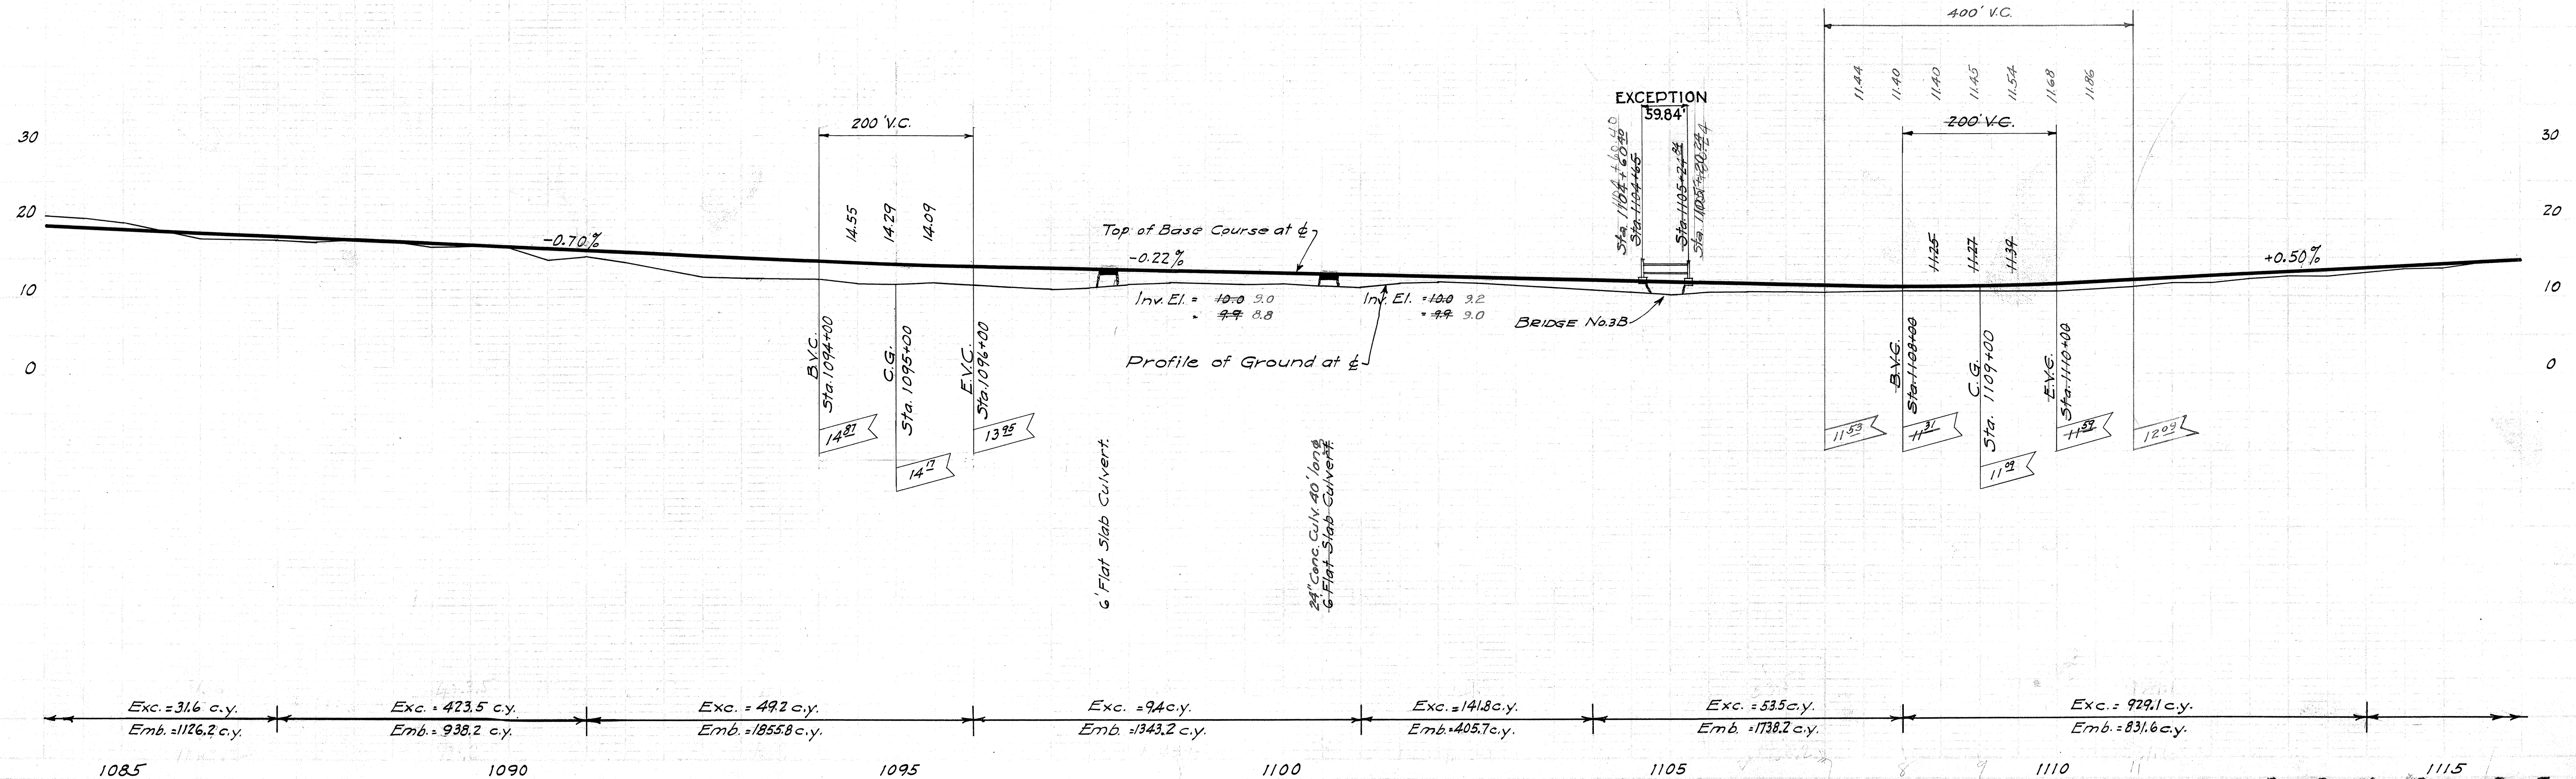

TERRITORY OF HAWAII (OWNER)
L. L. M^cCANDLESS (LESSEE)



L. L. M^cCANDLESS (OWNER)

Sept. 36

J.L. Padgett

Sept. 36



J.L. Padgett

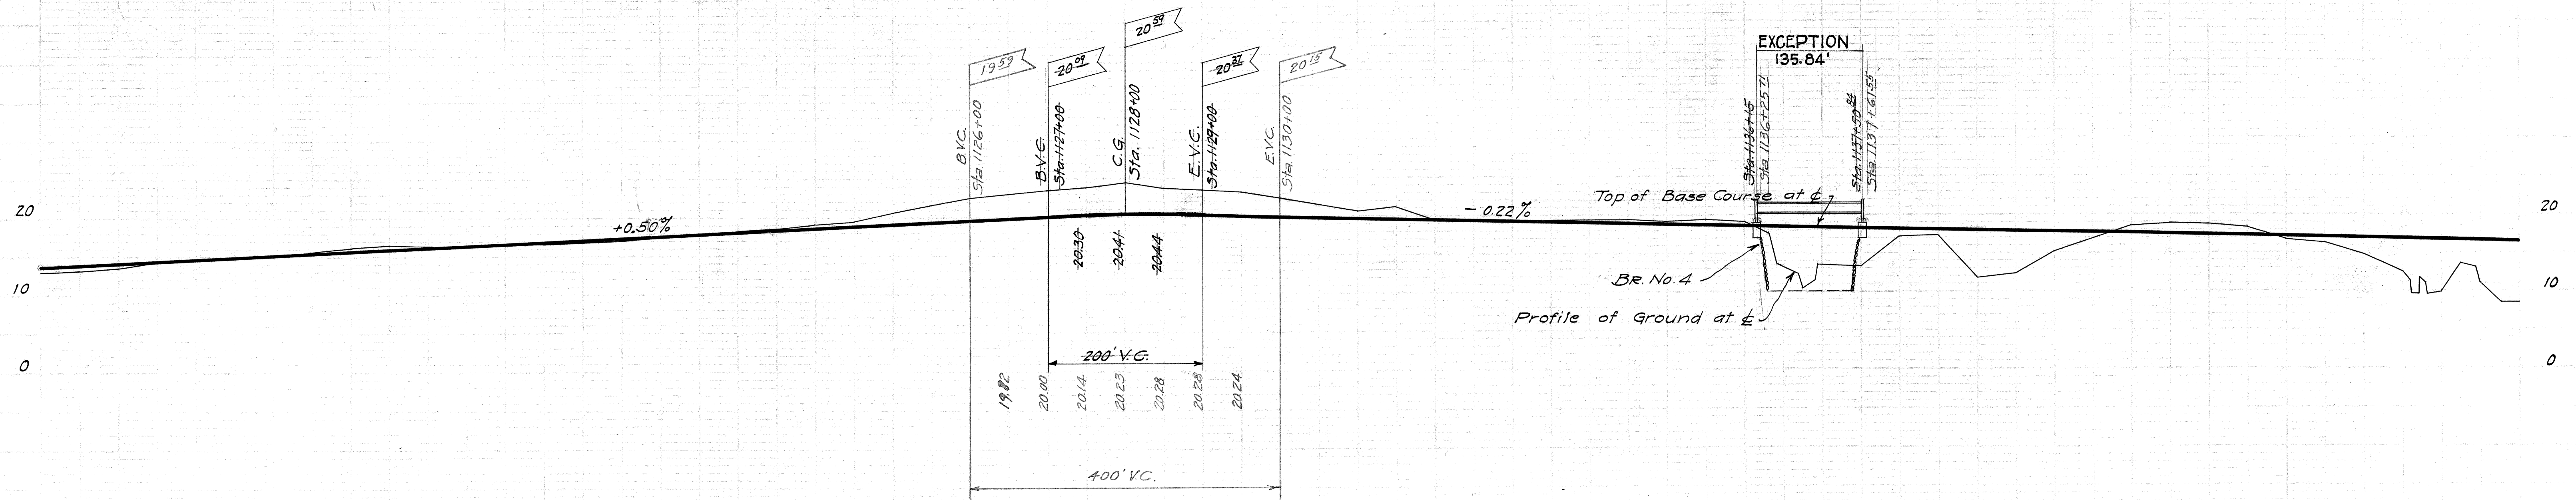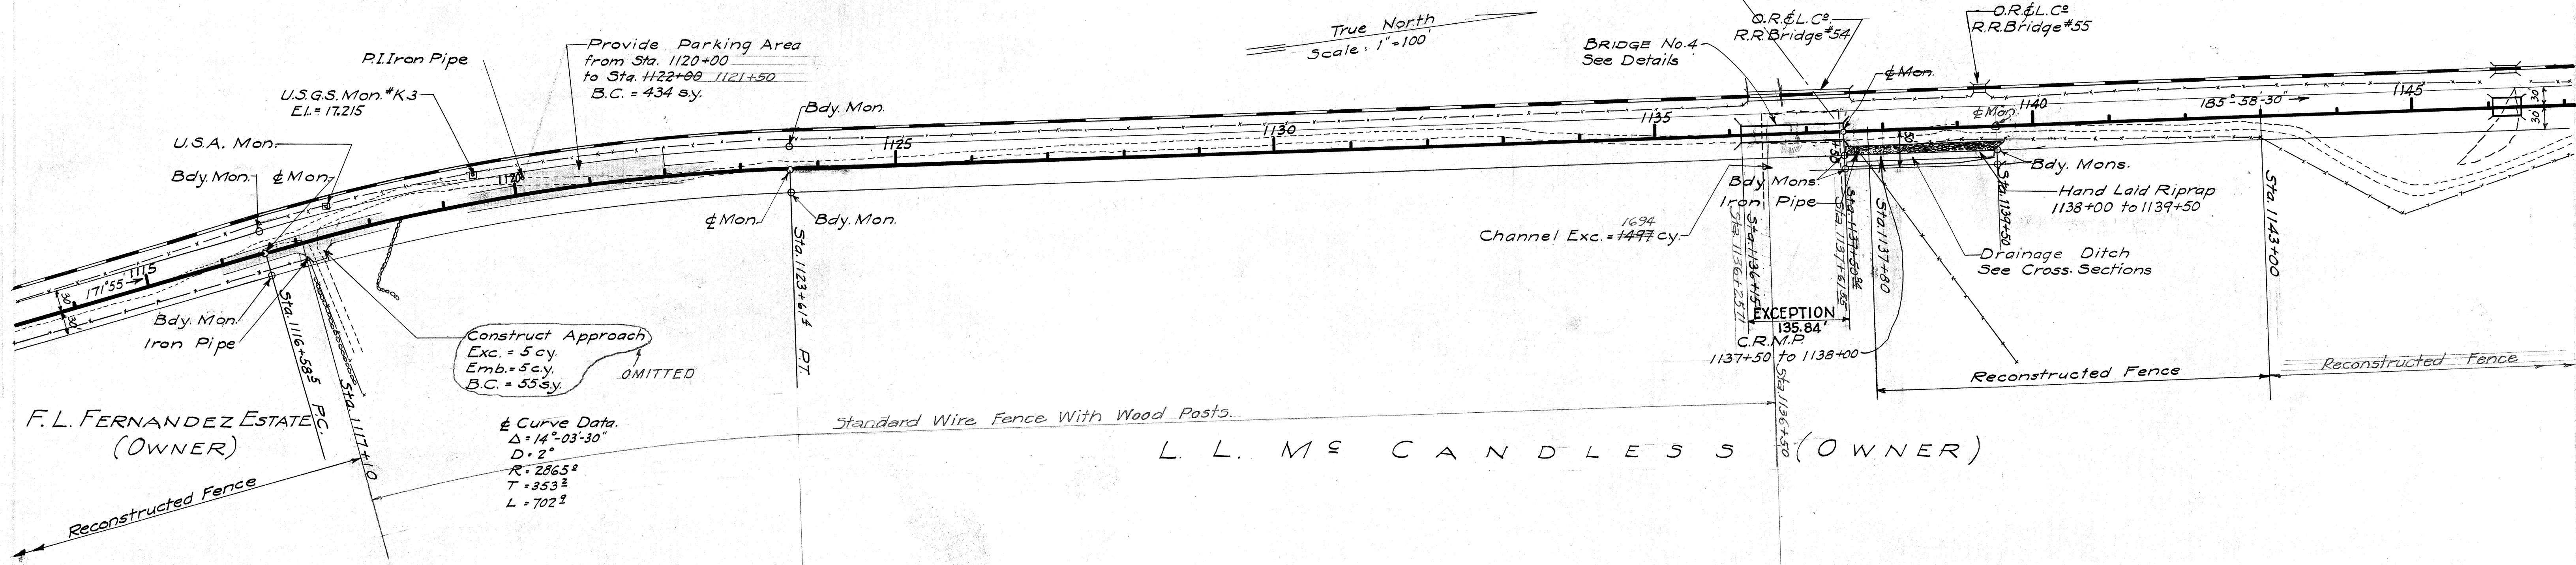

4383.12

FED. ROAD DIST. NO.	STATE	FED. AID PROJ. NO.	FISCAL YEAR	SHEET NO.	TOTAL SHEETS
HAWAII	HAW.	WBSO 238	1936	14	83




Revised 12/4/36

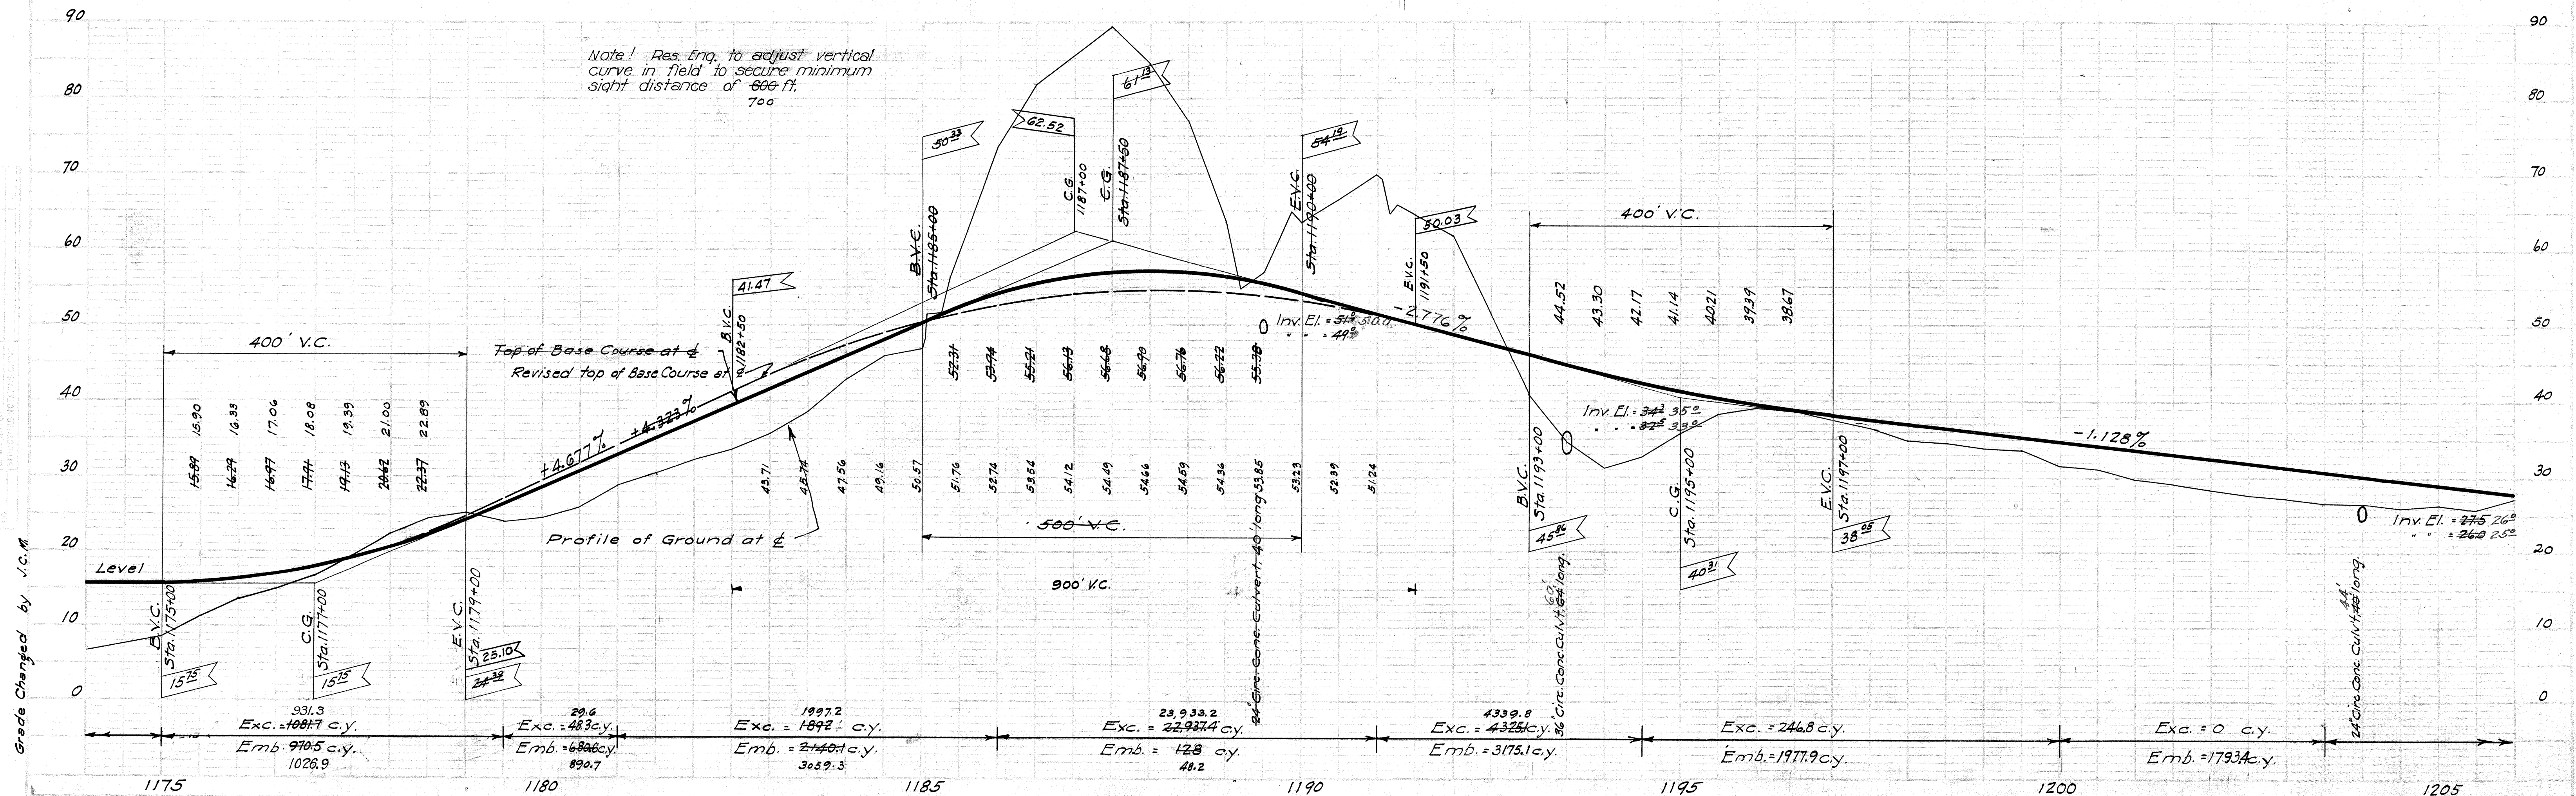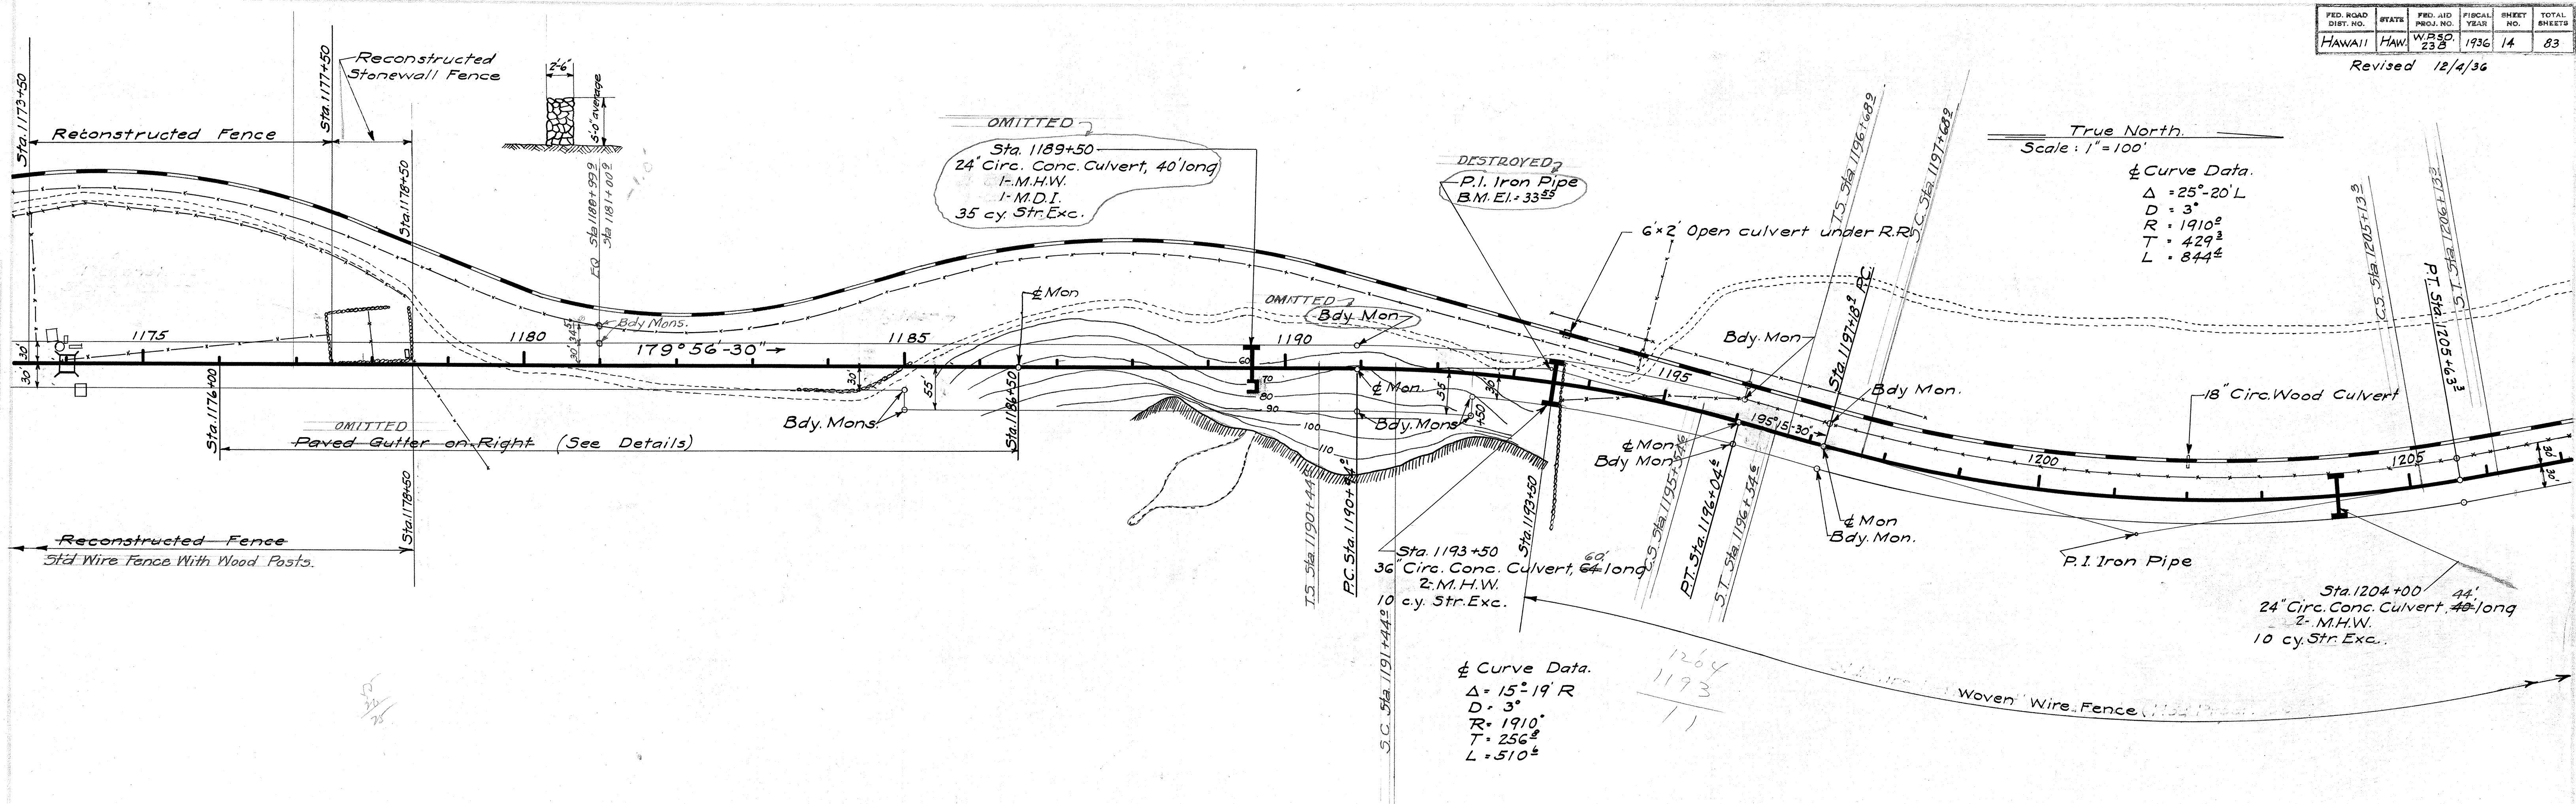

4383.14

U.L. Rodgers
Supt. 26
HAWAIIAN TERRITORY
DEPT. OF PUBLIC WORKS
ROADS AND ALLEGED CULVERTS
ST. OF WAY (CROSSING)

U.L. Rodgers
Supt. 26
HAWAIIAN TERRITORY
DEPT. OF PUBLIC WORKS
ROADS AND ALLEGED CULVERTS
ST. OF WAY (CROSSING)

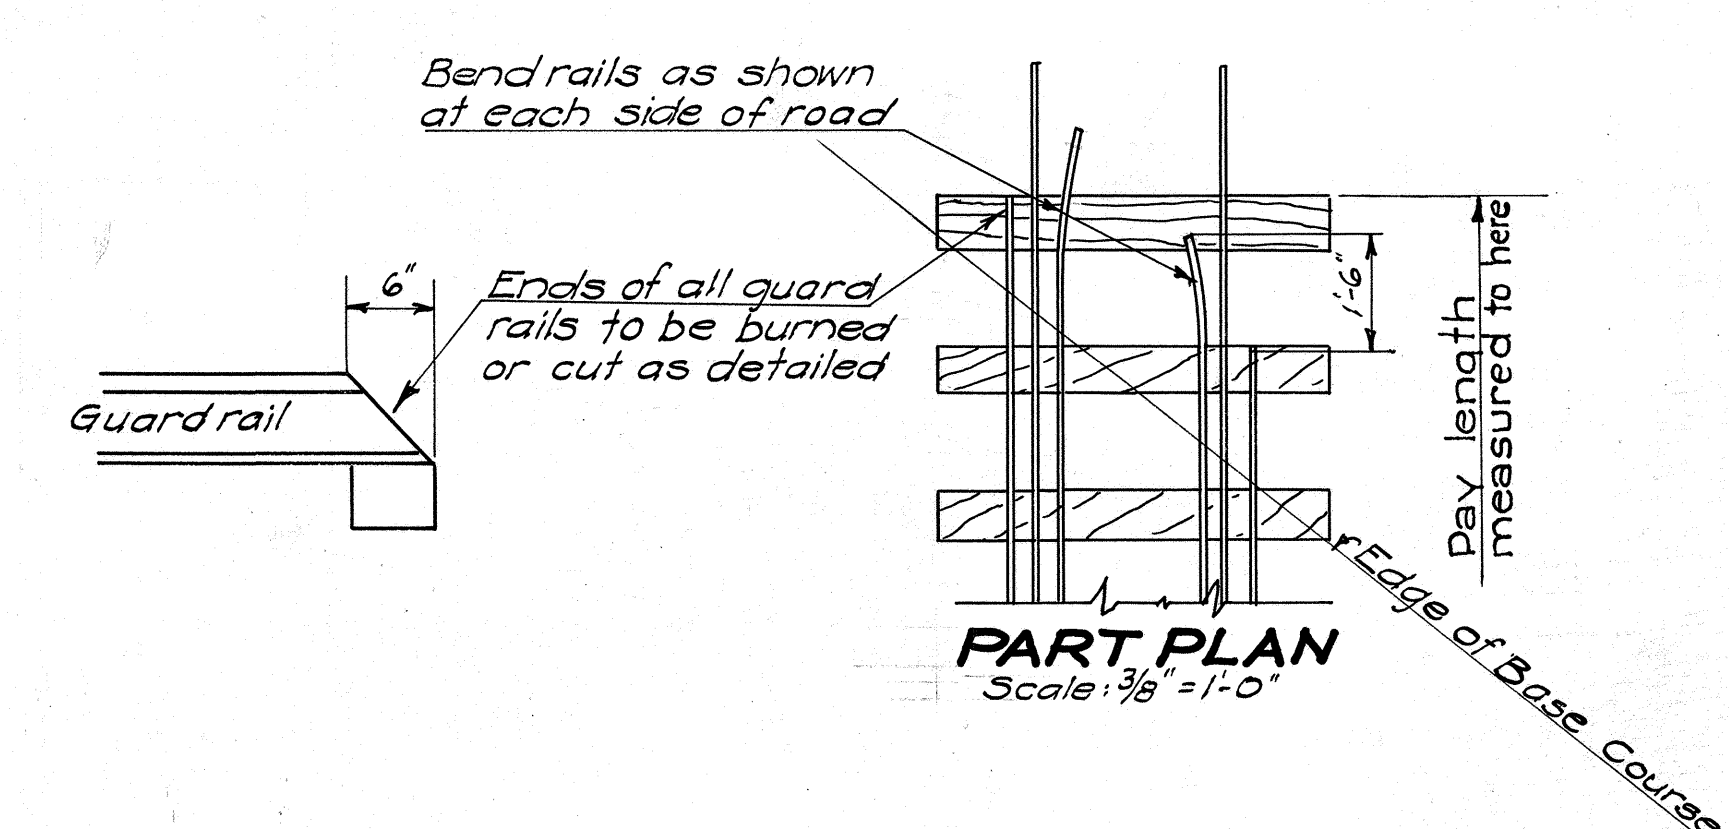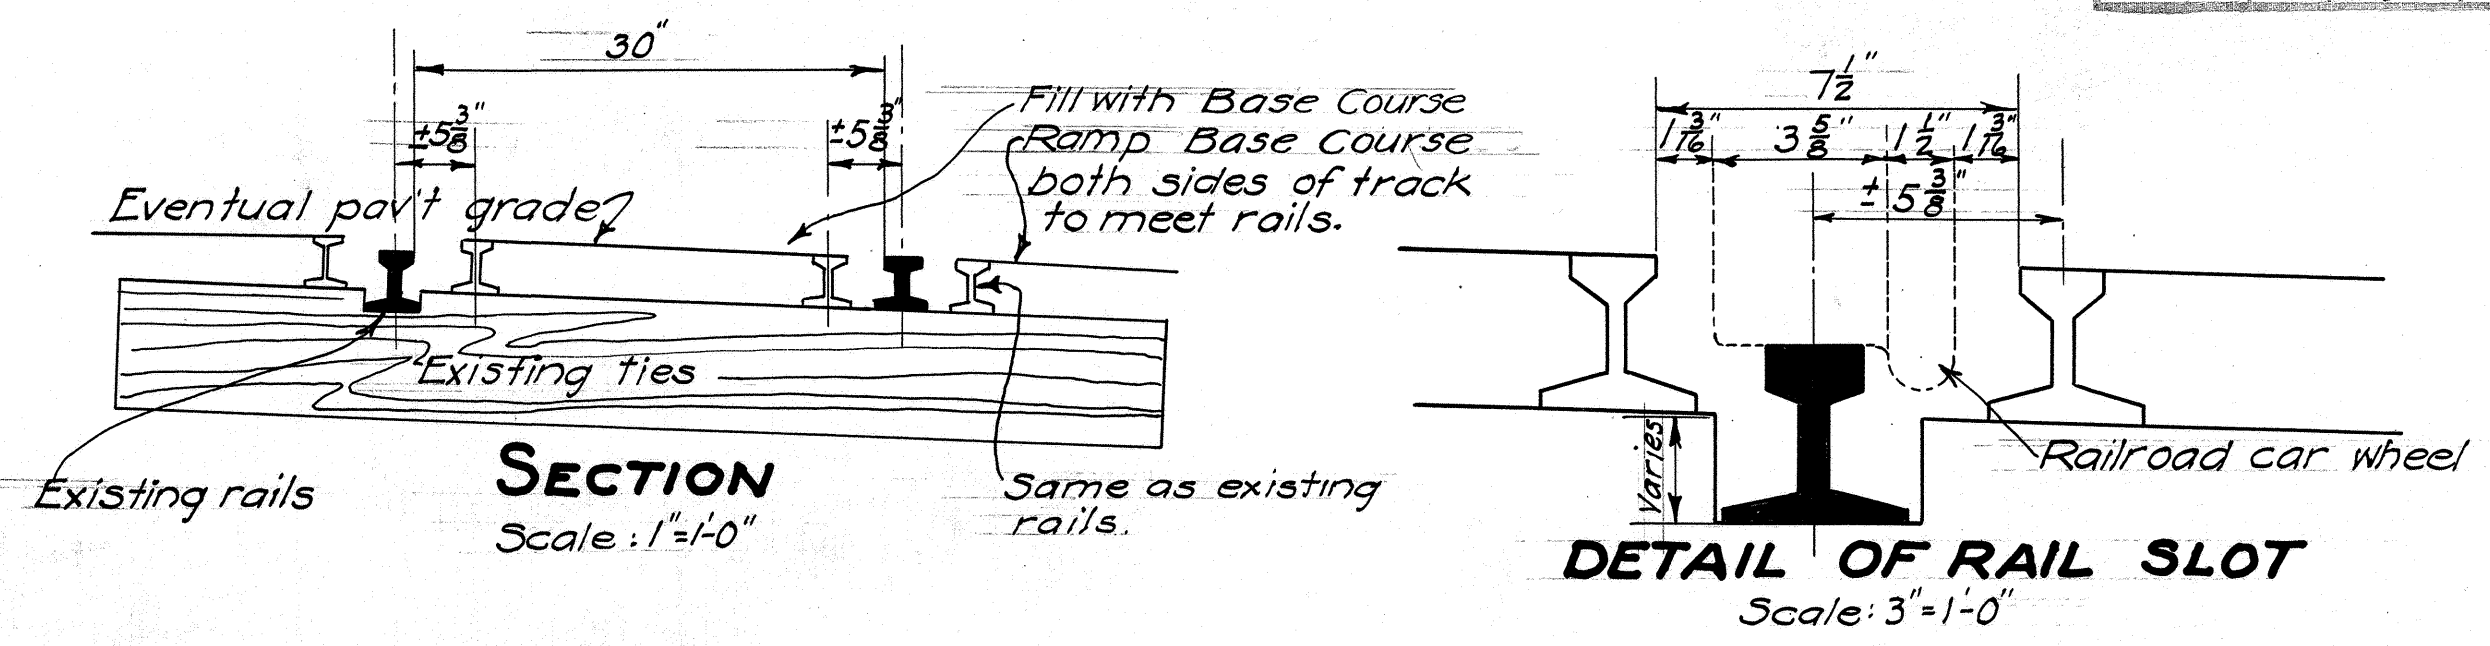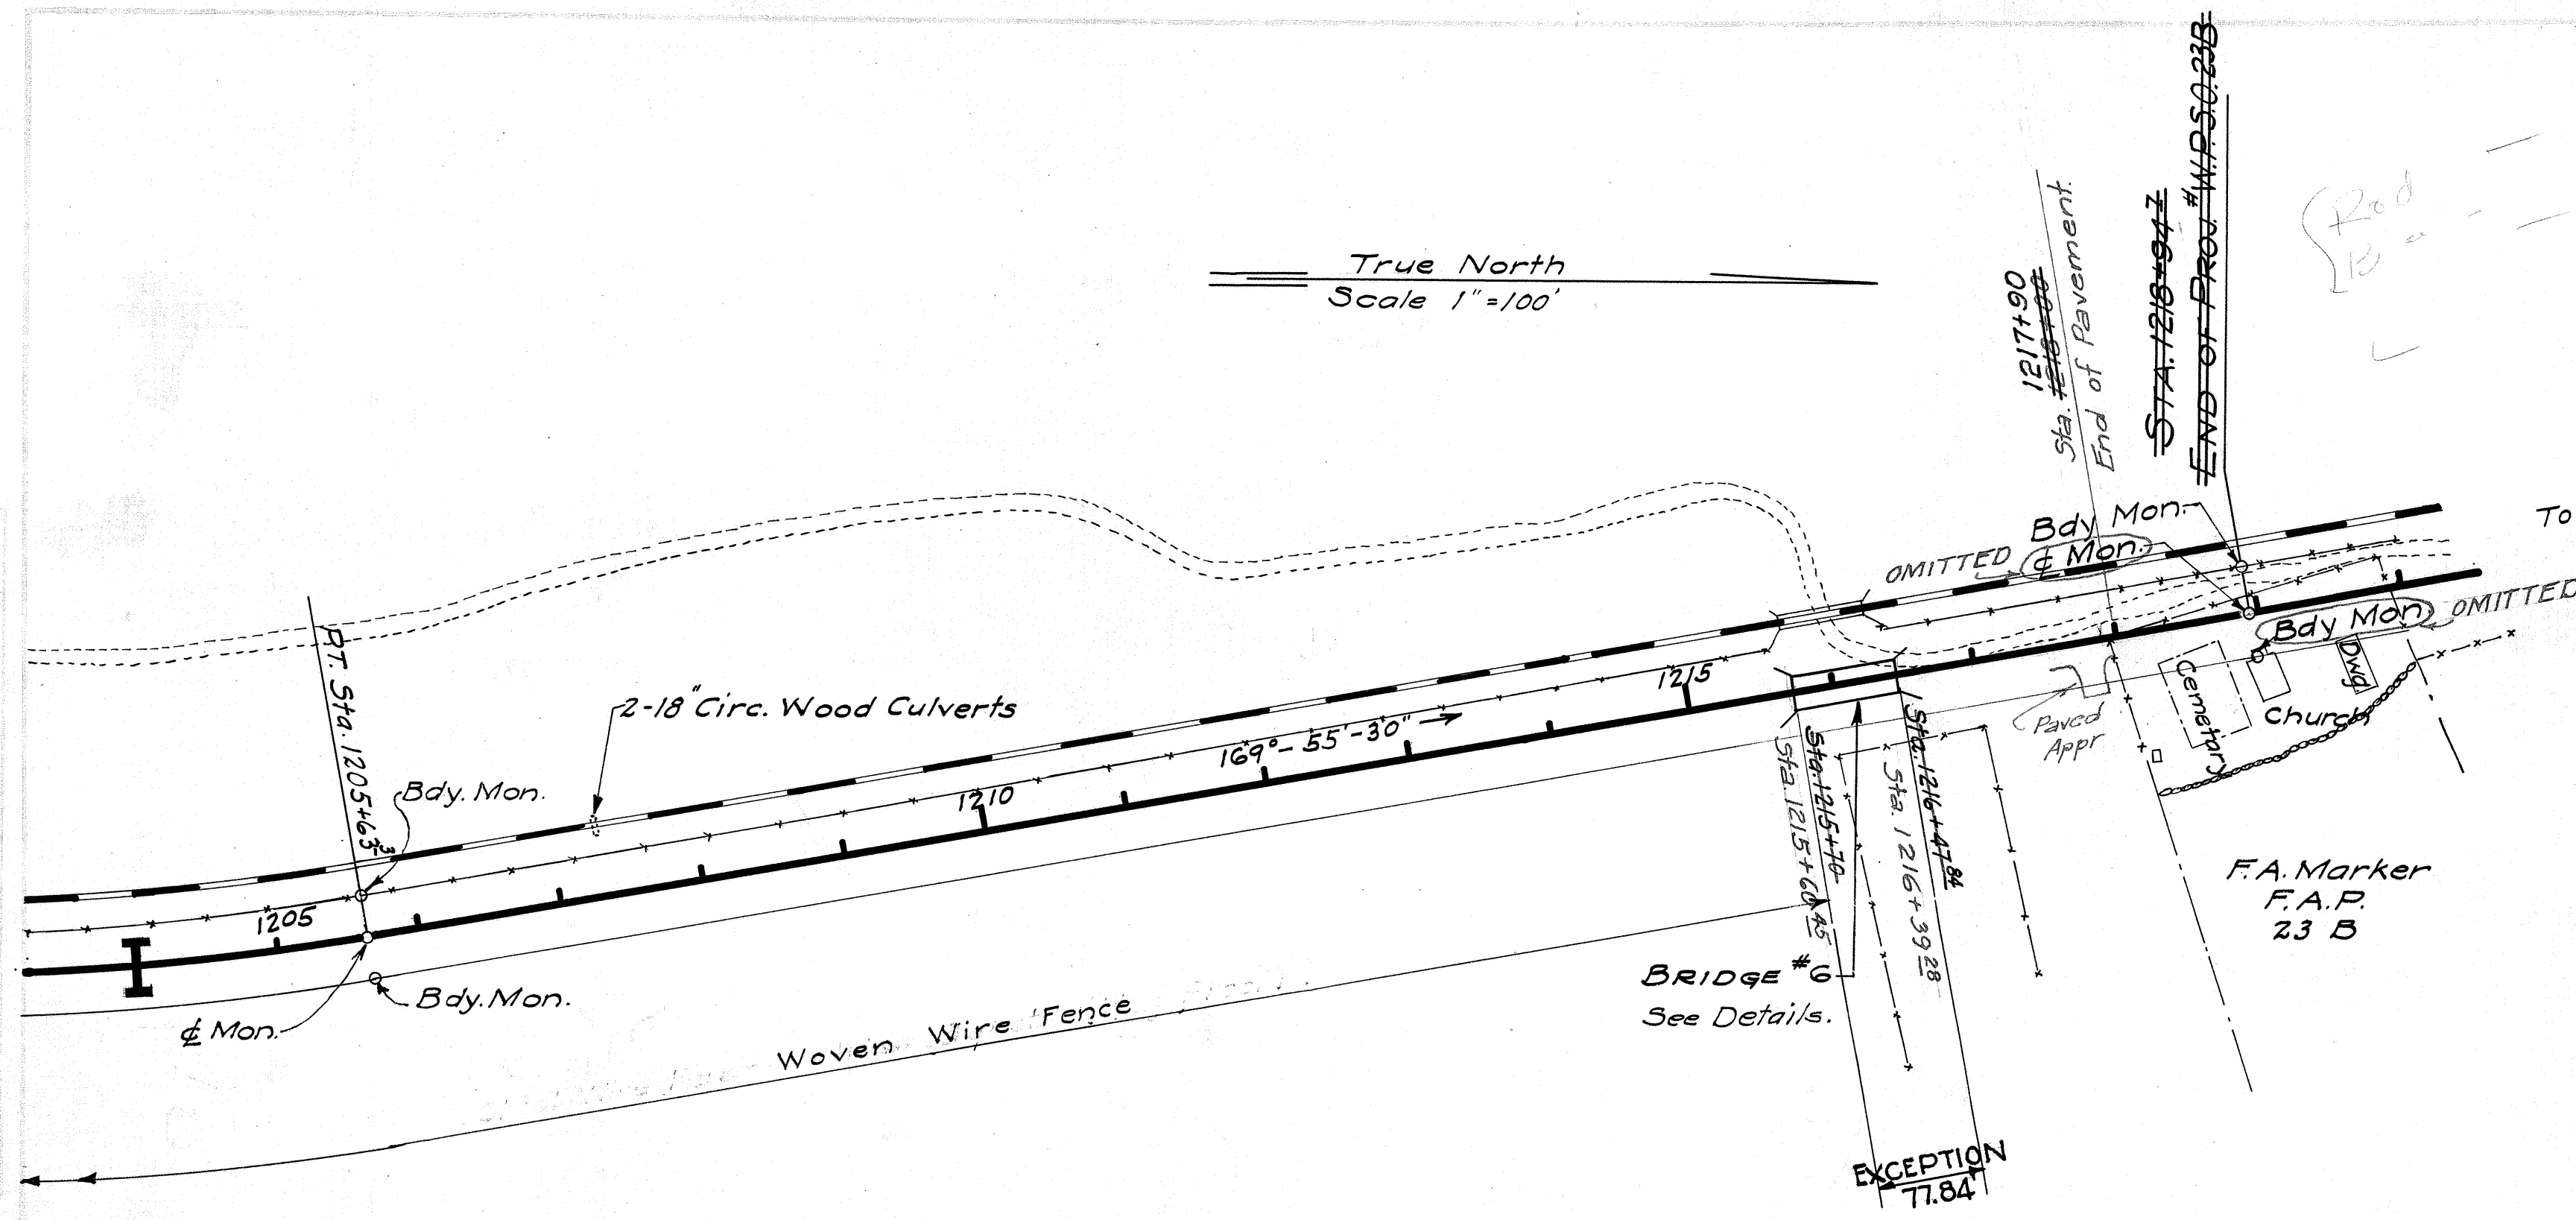

INDUSTRIAL TRACK CROSSING DETAILS

