

INDEX TO DRAWINGS	
SHEET NO.	DESCRIPTION
1	TITLE SHEET
2	TYPICAL SECTIONS
3 - 15	PLANS & PROFILE
16 - 17	STANDARD DETAILS
18	FLAT SLAB CULVERT DETAILS
19 - 24	BRIDGE DETAILS
25 - 83	CROSS SECTIONS

FED. ROAD DIST. NO.	STATE	FED. AID PROJ. NO.	FISCAL YEAR	SHEET NO.	TOTAL SHEETS
HAWAII	HAW.	W.P.S.O. 23B	1936	1	83


TERRITORY OF HAWAII
TERRITORIAL HIGHWAY DEPARTMENT
HONOLULU T.H.

PLANS OF
KAENA POINT ROAD
U. S. WORKS PROGRAM HIGHWAY PROJECT NO. W.P.S.O. 23B.
HAWAII F.A.P. NO. 23B.
DISTRICT OF WAIANAE
ISLAND OF OAHU



SCALES

PLAN 1 INCH=100 FEET
PROFILE ———— HORIZ. 1 INCH=100 FEET
 VERT. 1 INCH= 10 FEET
CROSS SECTIONS 1 INCH= 5 FEET

KAENA PT. ROAD
NO. W.P.S.O. 23 B

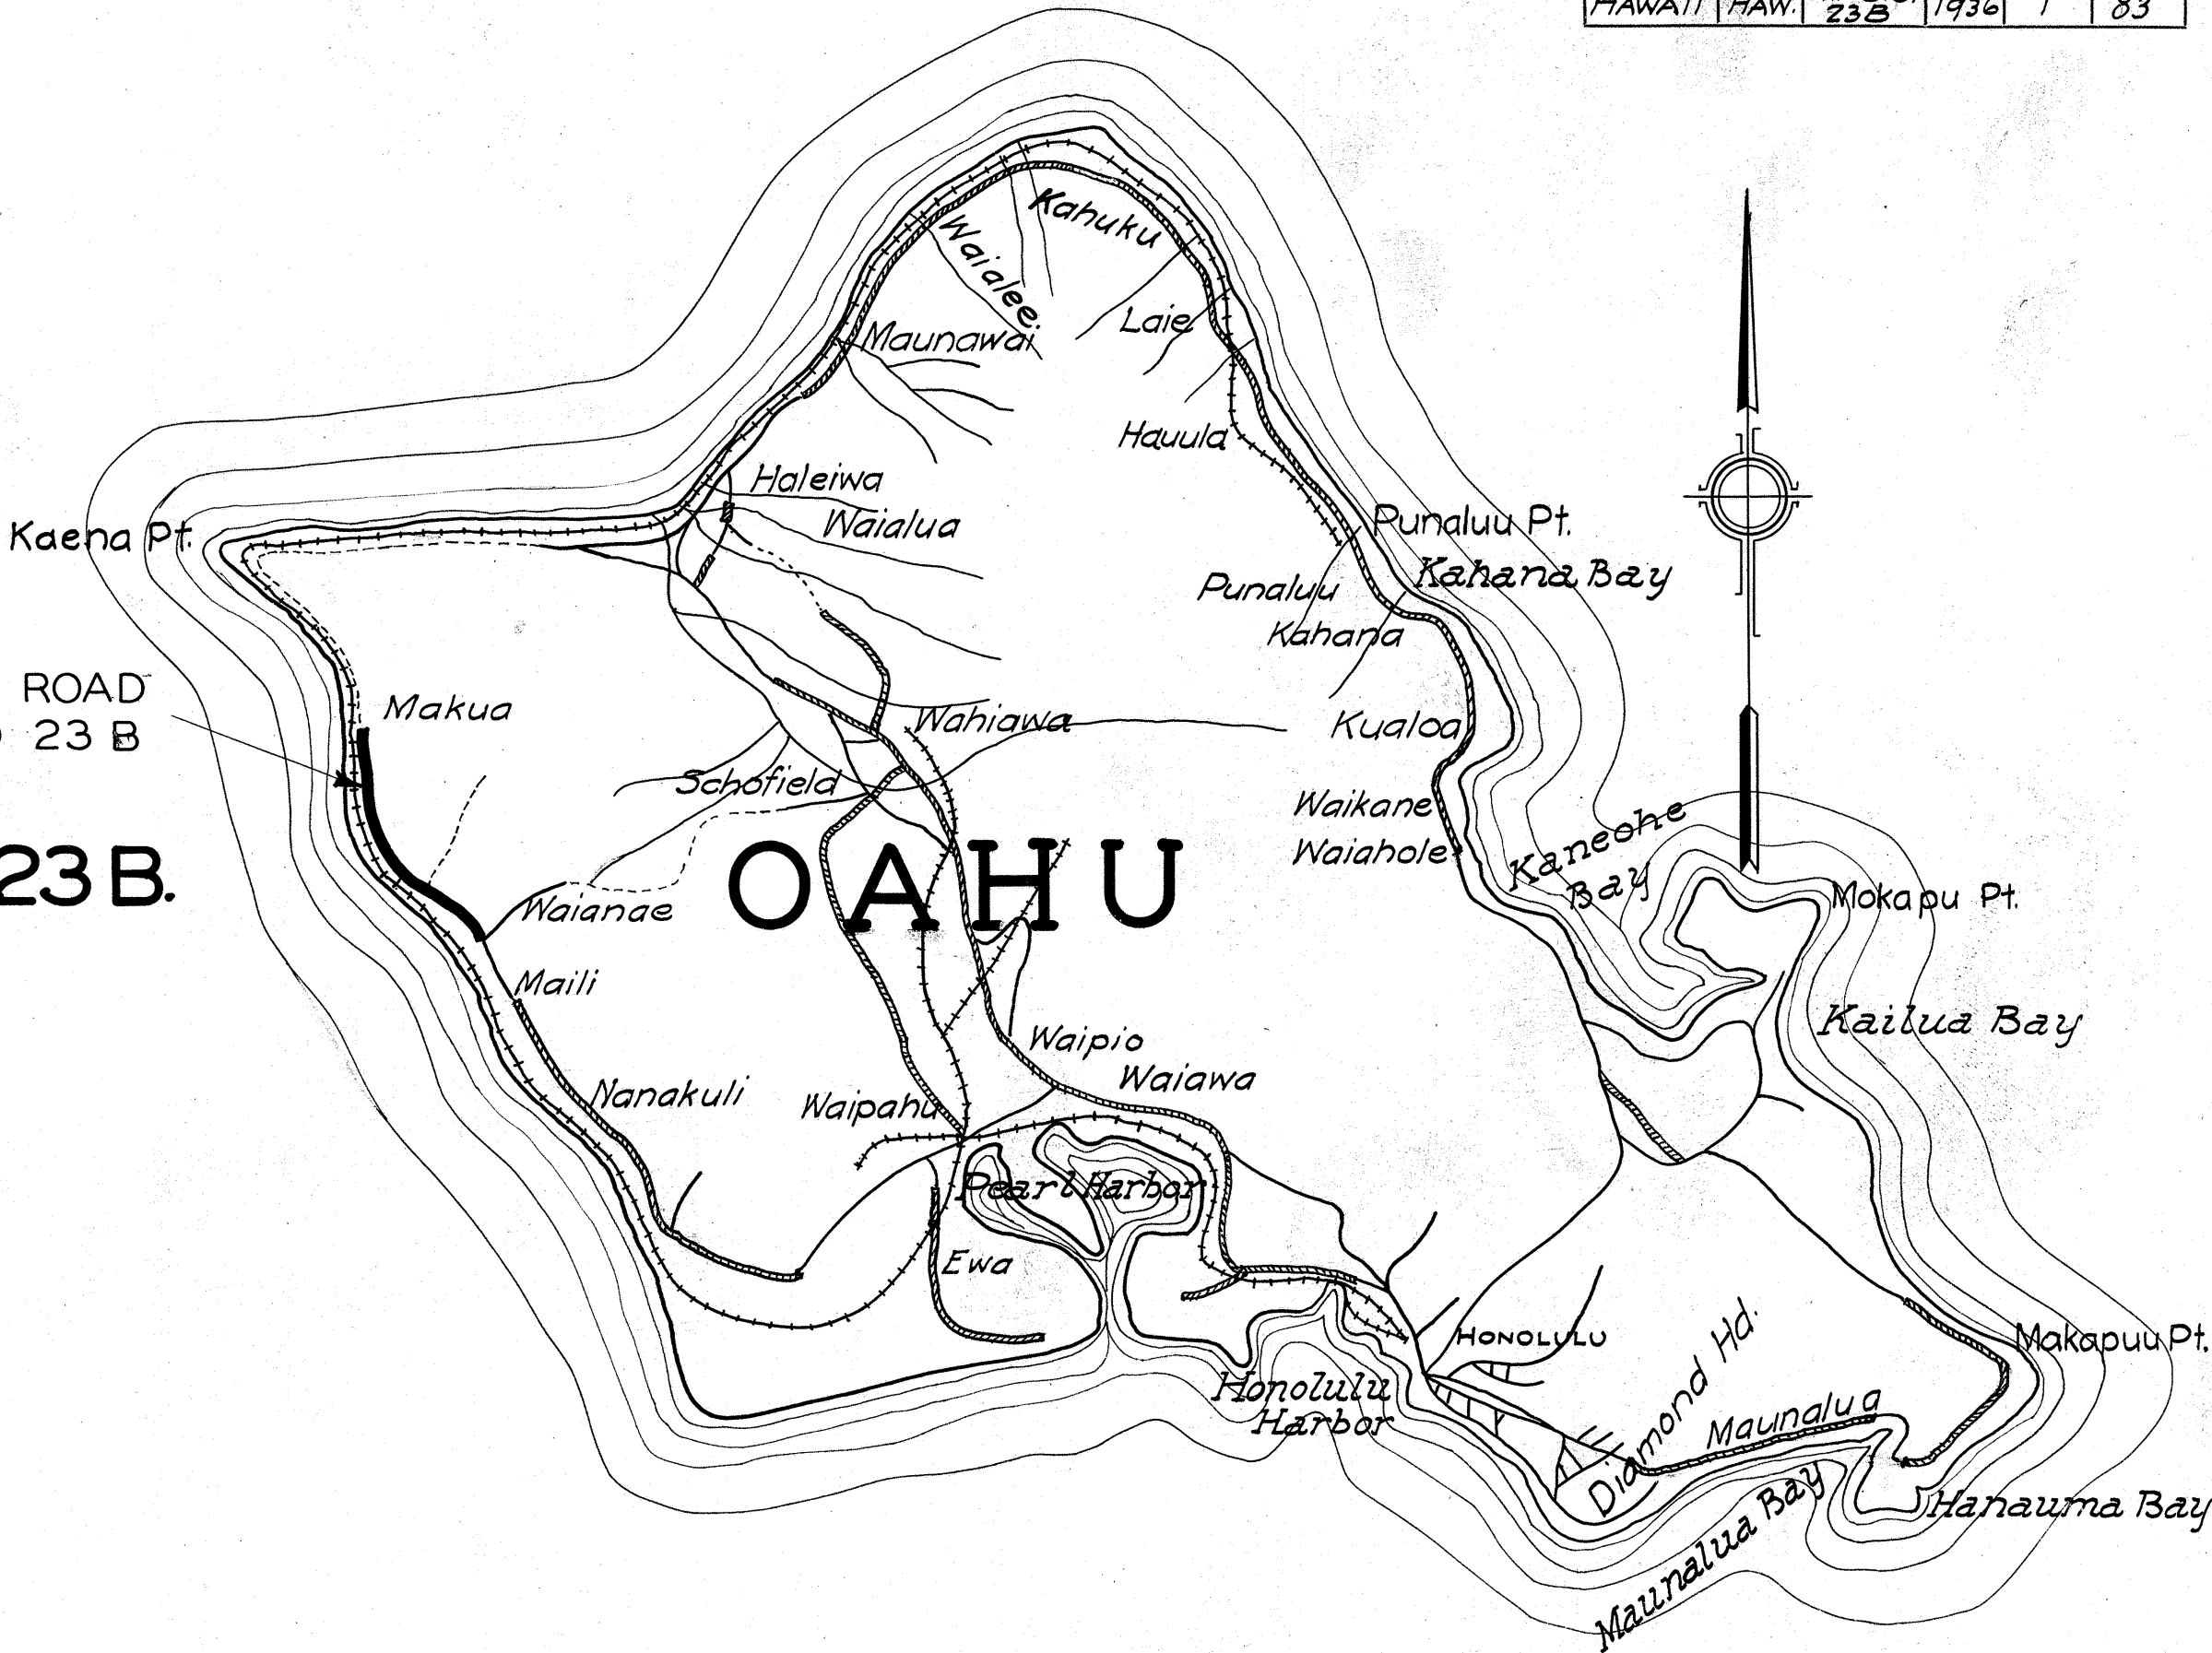

CONVENTIONAL SIGNS
Present Road
Existing Fence
Boundary Line (not fenced)
Existing Stone Fence
Railroad
Center Line
Large Tree
Cement Rubble Retaining Wall
Bridges
Culverts
Trails

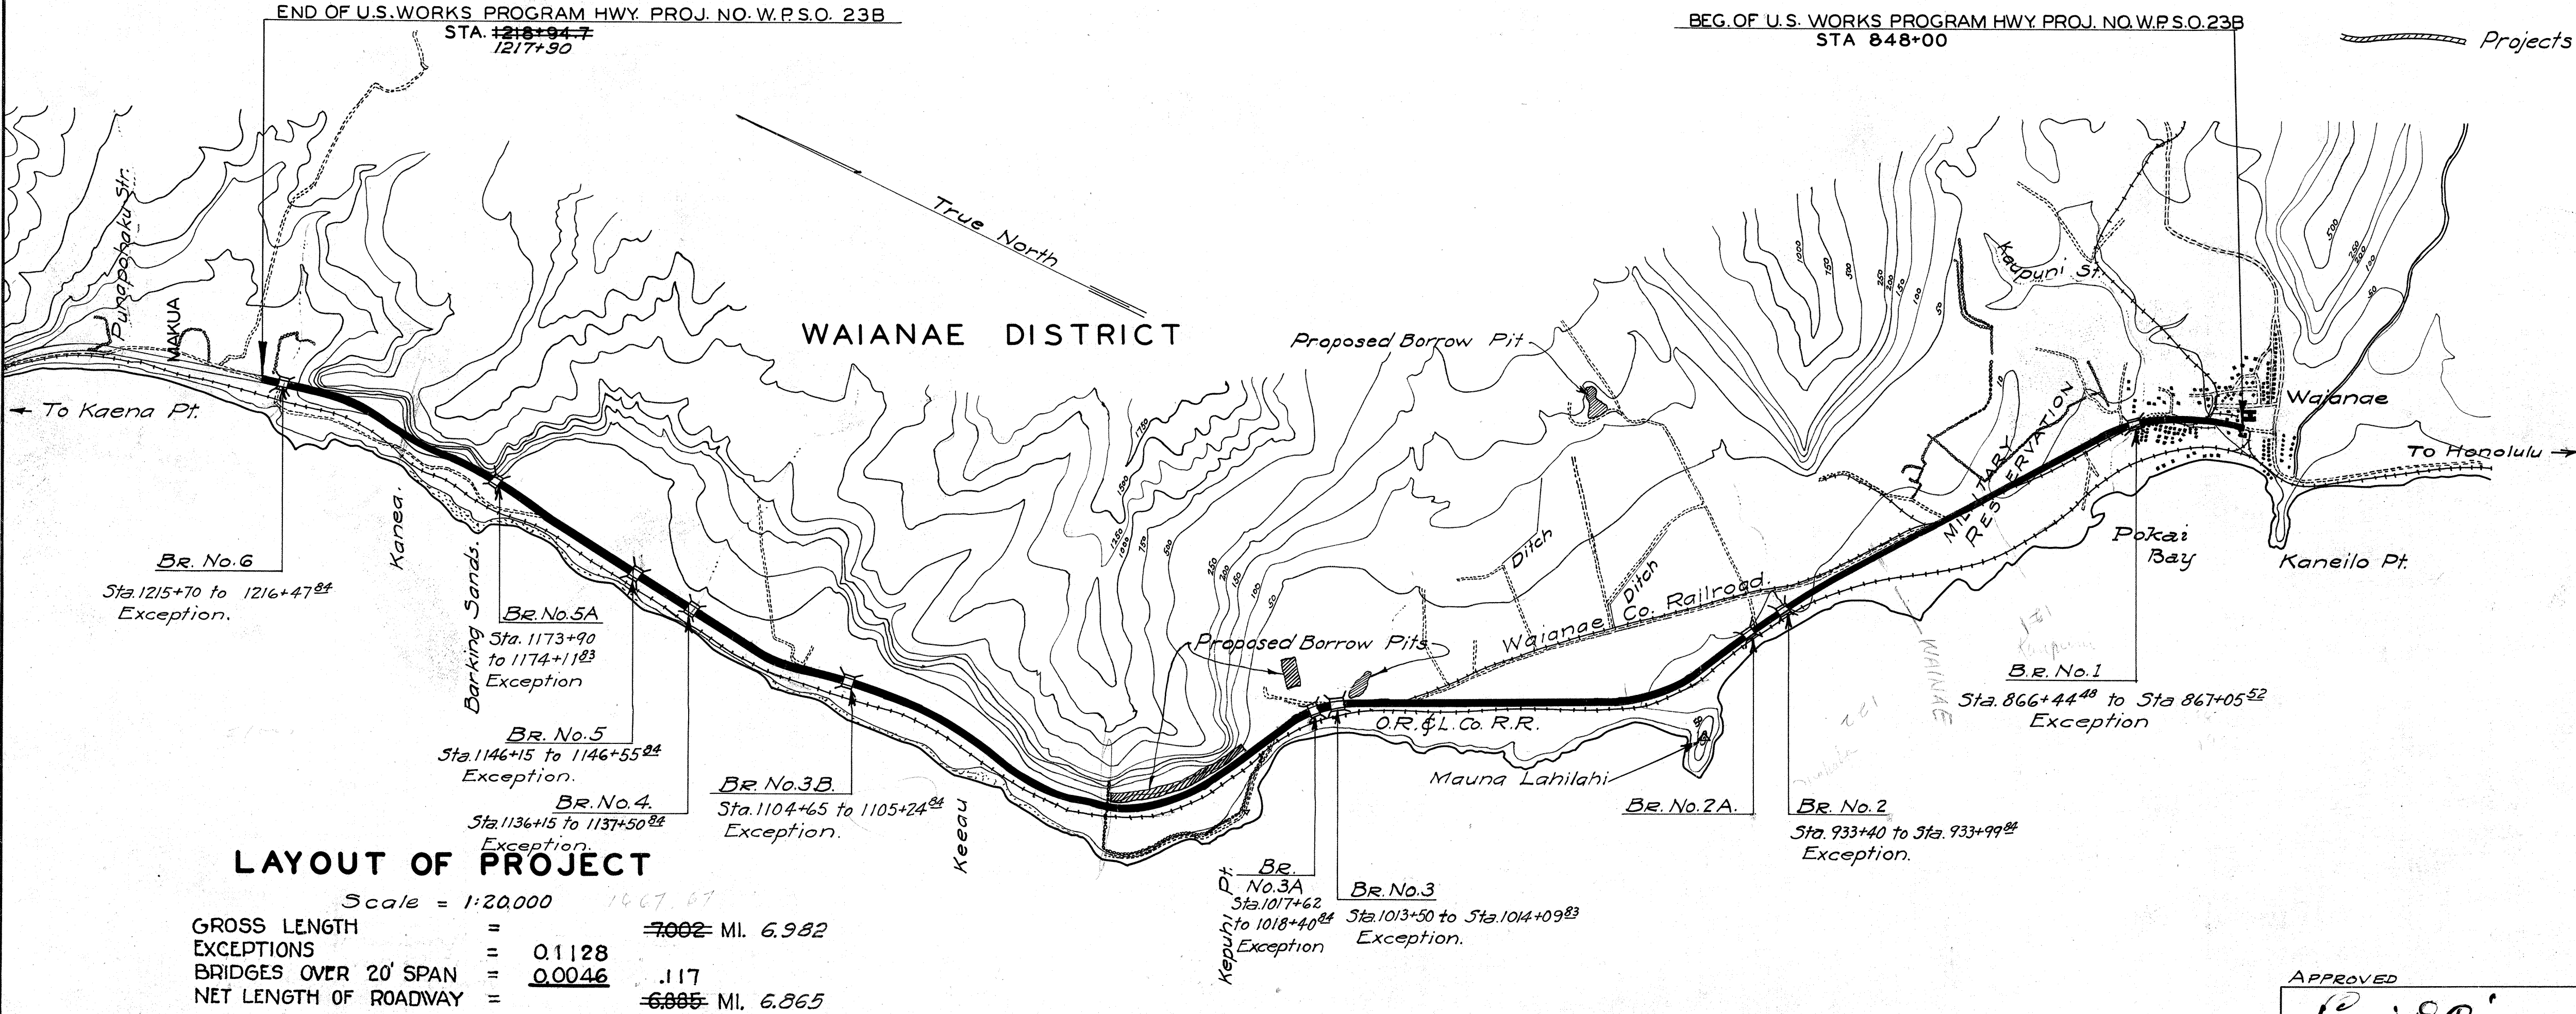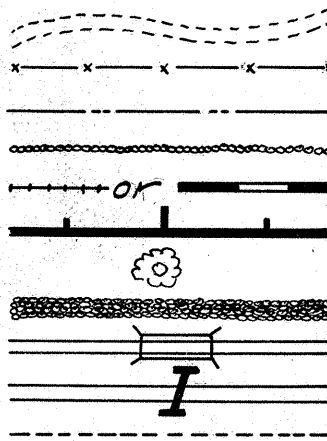

LAYOUT OF PROJECT

Scale = 1:20,000

GROSS LENGTH = 6.982 MI. 6.982
EXCEPTIONS = 0.1128
BRIDGES OVER 20' SPAN = 0.0046 .117
NET LENGTH OF ROADWAY = 6.865 MI. 6.865

APPROVED
Louis O. Cain
Date: 10-16-36
TERRITORIAL HIGHWAY ENGINEER.

RECOMMENDED FOR APPROVAL

PRINCIPAL HIGHWAY ENGINEER, Bu. of Pub. Rds.
RECOMMENDED FOR APPROVAL

CHIEF ENGINEER, Bu. of Public Roads.
APPROVED

CHIEF, Bureau of Public Roads.

4383.1