


INDEX TO DRAWINGS	
SHEET NO.	DESCRIPTION
1	Title Sheet
2	Typical Sections

TERRITORY OF HAWAII
TERRITORIAL HIGHWAY DEPARTMENT
HONOLULU, OAHU, T. H.


PLANS OF KAENA POINT ROAD WAR DAMAGE REHABILITATION PROJECT NO. W.D.R. 5 (I)

DISTRICT OF WAIANAE
ISLAND OF OAHU

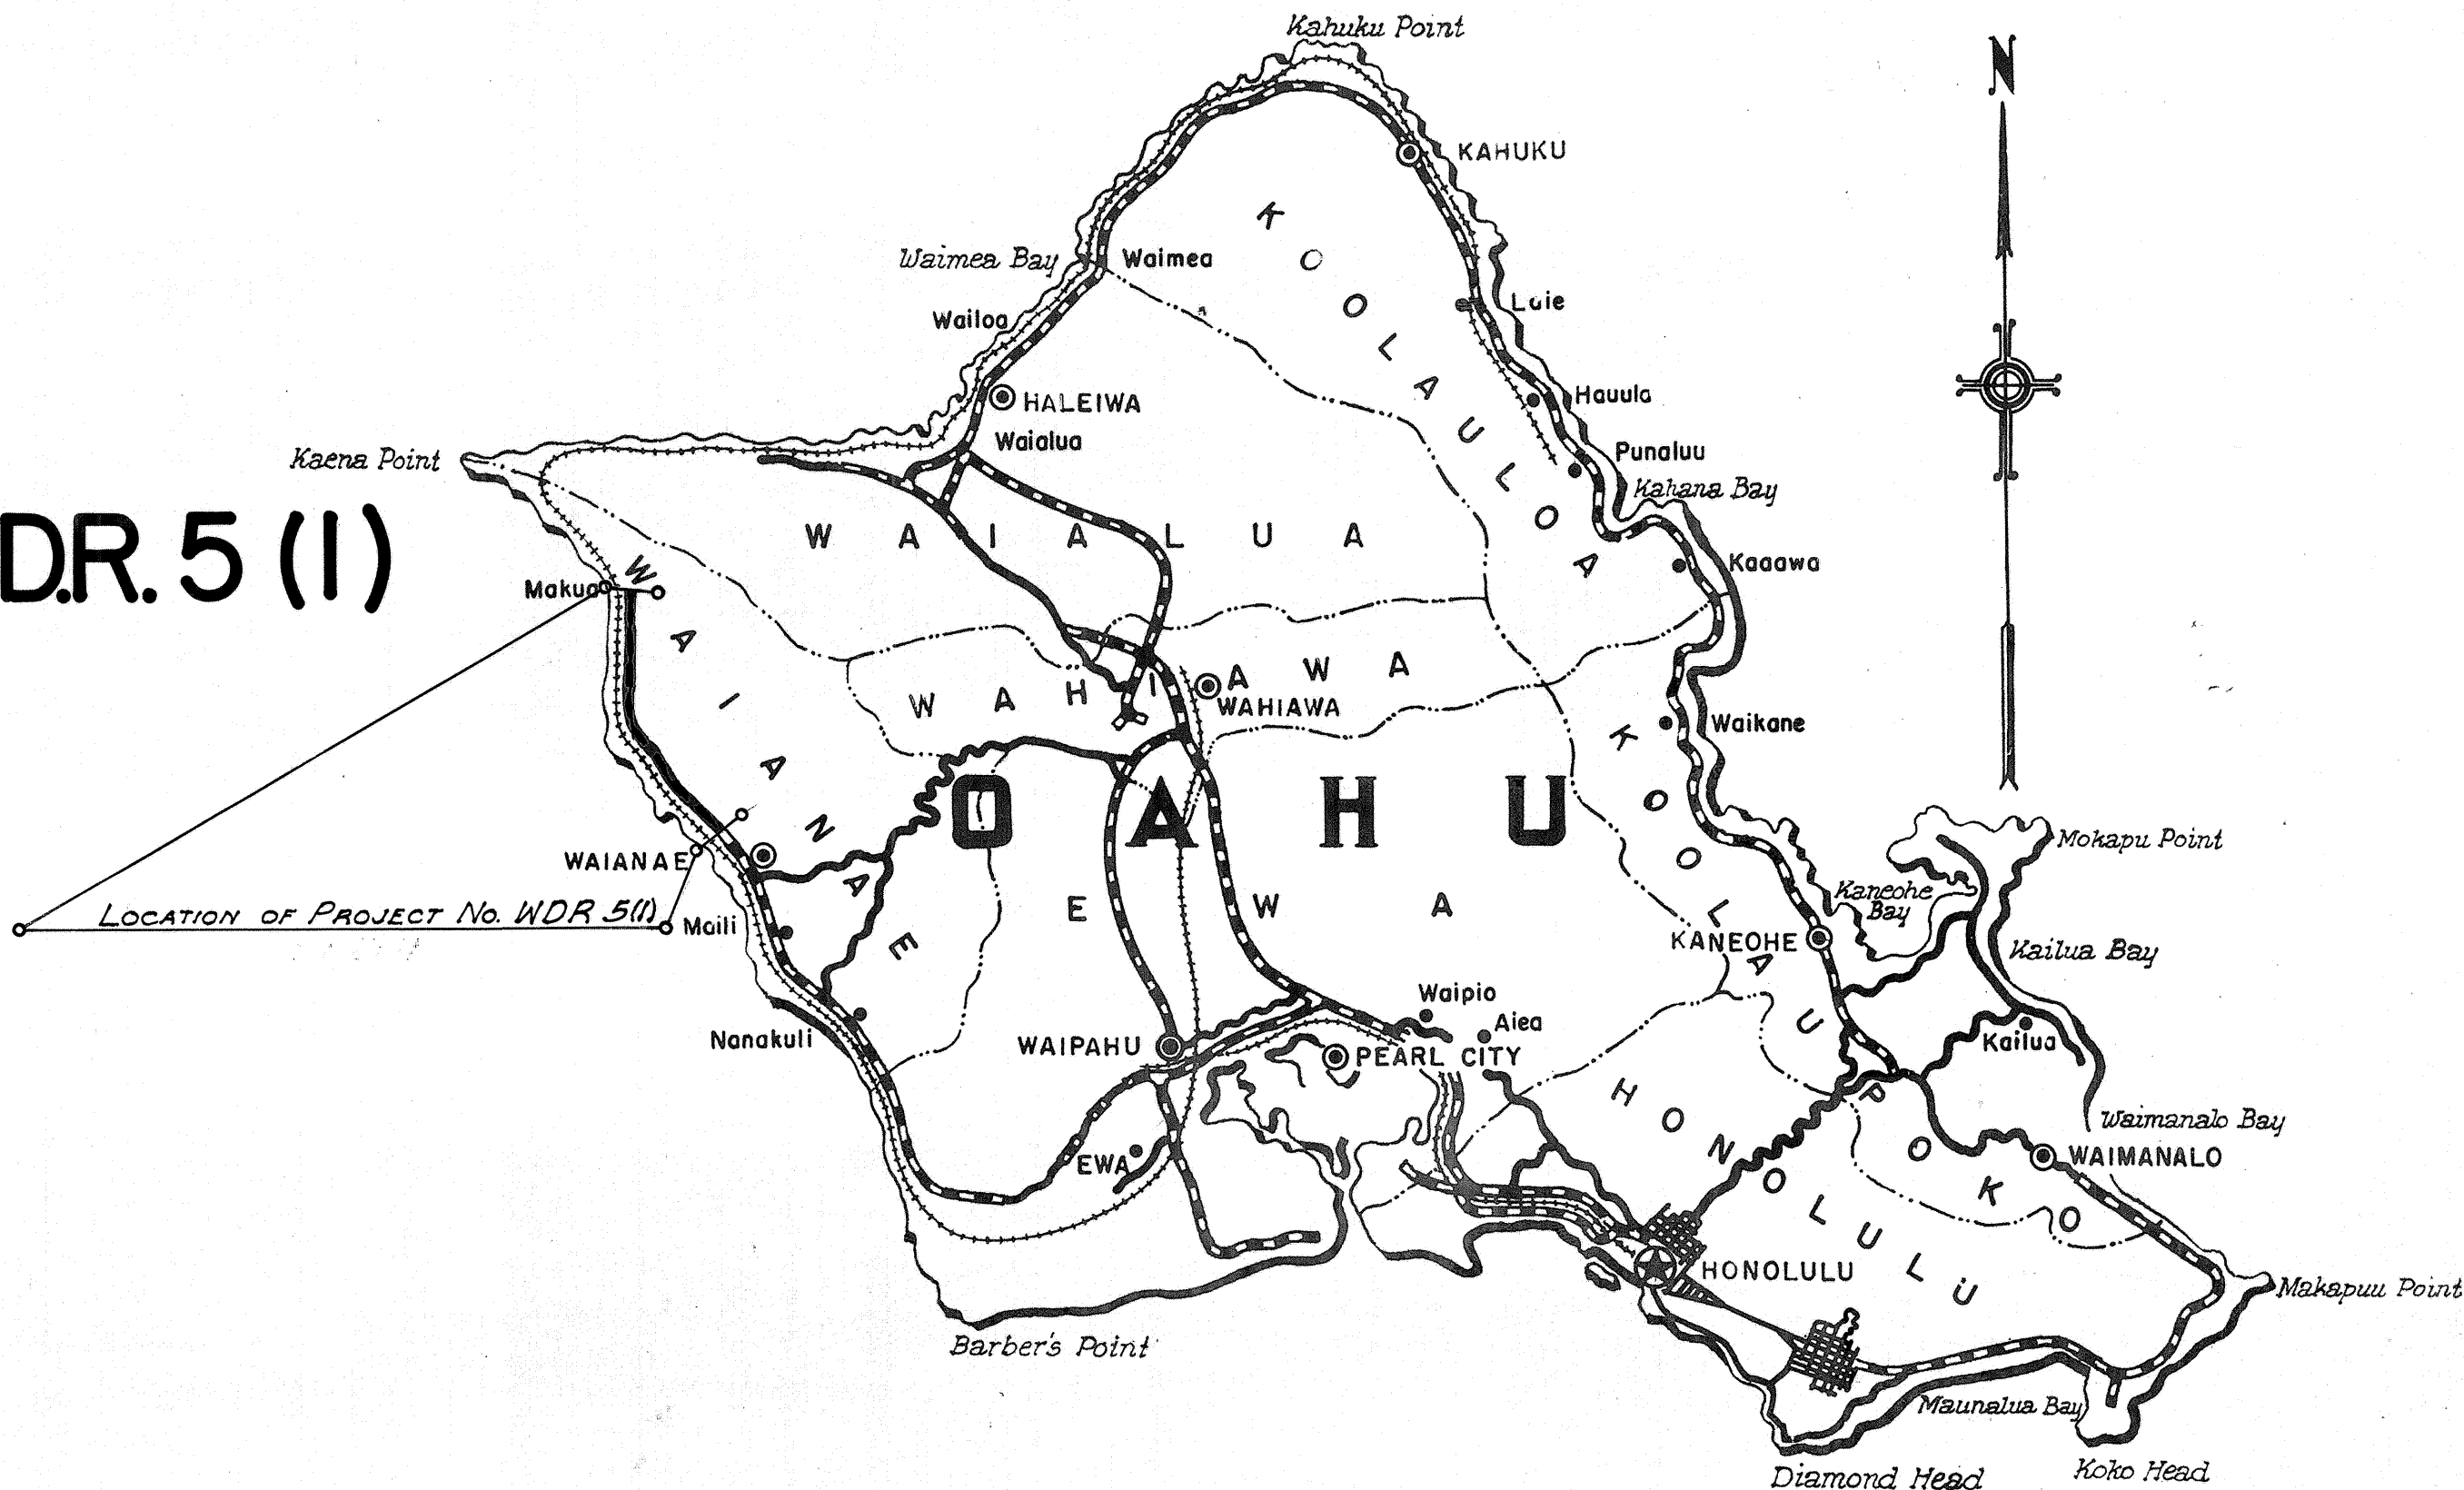

Federal Aid Projects Previously Constructed Or Under Construction

Revised Oct. 29, 1943

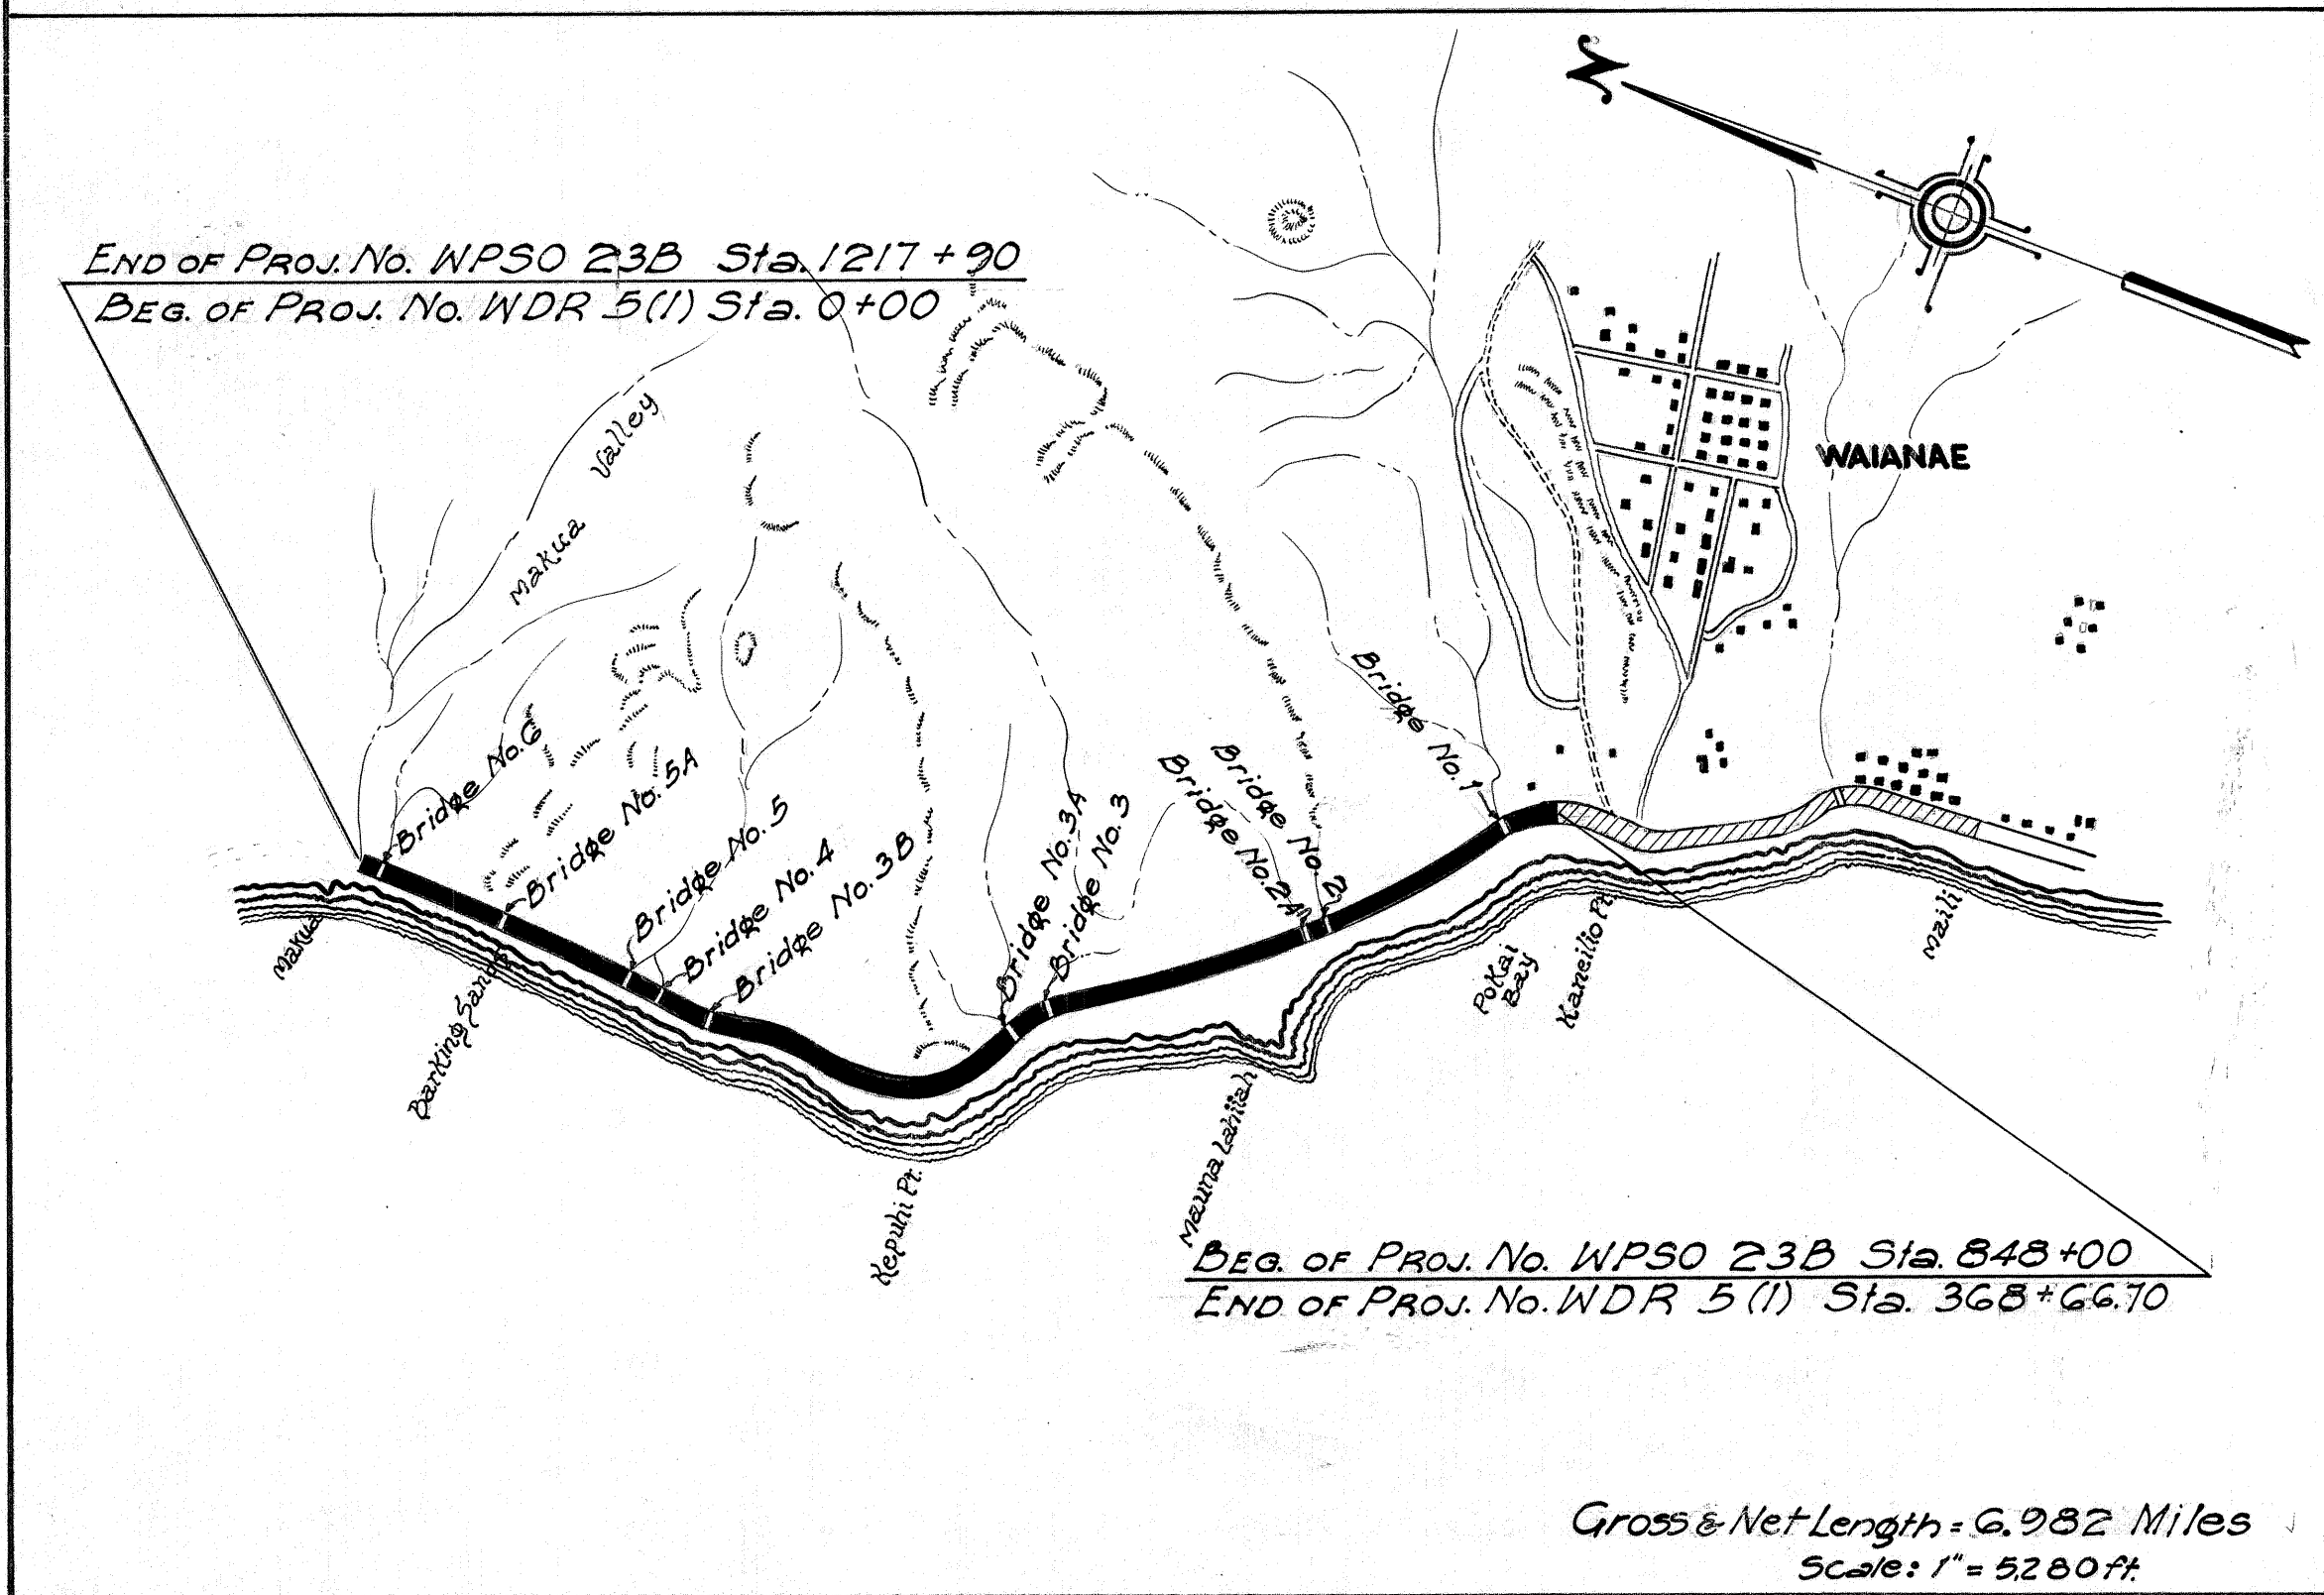


Gross & Net Length = 6.982 Miles
Scale: 1" = 3280 ft.

DATE	
SURVEYED BY	
DESIGNED BY	
DRAWN BY	
CHECKED BY	
QUANTITIES CHECKED BY	
CHECKED BY	
NOTE BOOK	
No.	


RECOMMENDED FOR APPROVAL DATE.....	
DISTRICT ENGINEER PUBLIC ROADS ADMINISTRATION FEDERAL WORKS AGENCY	
APPROVED	DATE.....
DIVISION ENGINEER PUBLIC ROADS ADMINISTRATION FEDERAL WORKS AGENCY	

APPROVED	DATE 10-4-45
TERRITORIAL HIGHWAY ENGINEER	


FED. ROAD DIST. NO.	STATE	FED. AID PROJ. NO.	FISCAL YEAR	SHEET NO.	TOTAL SHEET
HAWAII	HAW	WDR 5(1)	1948	2	2

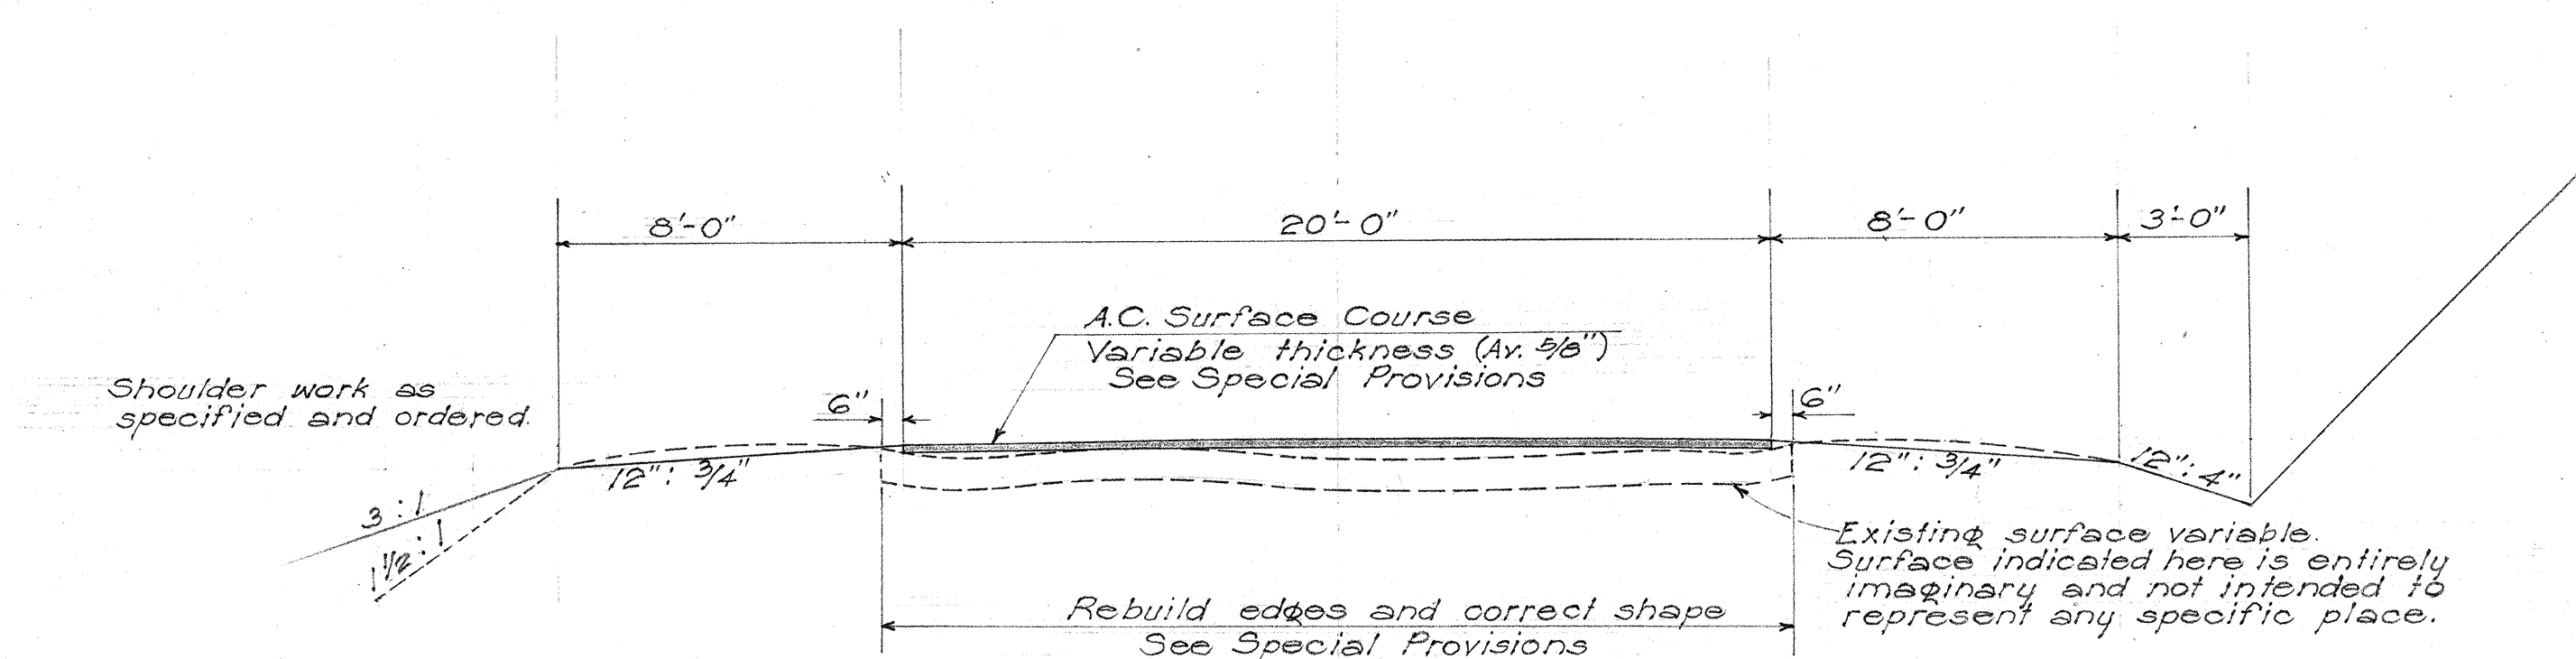


TYPICAL SECTION OF WORK TO BE DONE
ASPHALT CONCRETE RESURFACING ALTERNATE
STA. 0+00 to STA. 353+66.70
Scale: 1/4" = 1'-0"

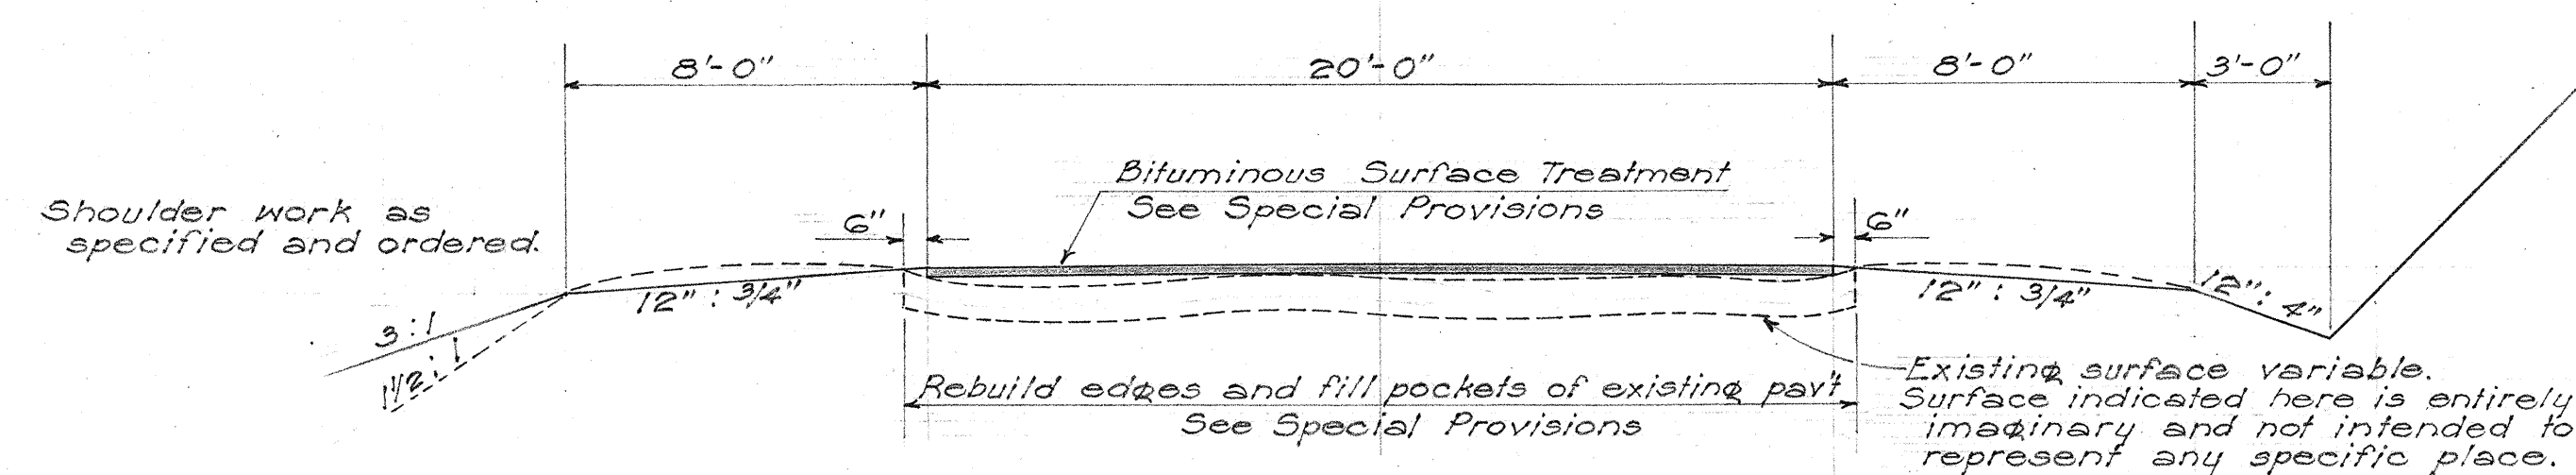


TYPICAL SECTION OF WORK TO BE DONE
BITUMINOUS SURFACE TREATMENT ALTERNATE
STA. 0+00 TO STA. 353+66.70
Scale: 1/4" = 1'-0"

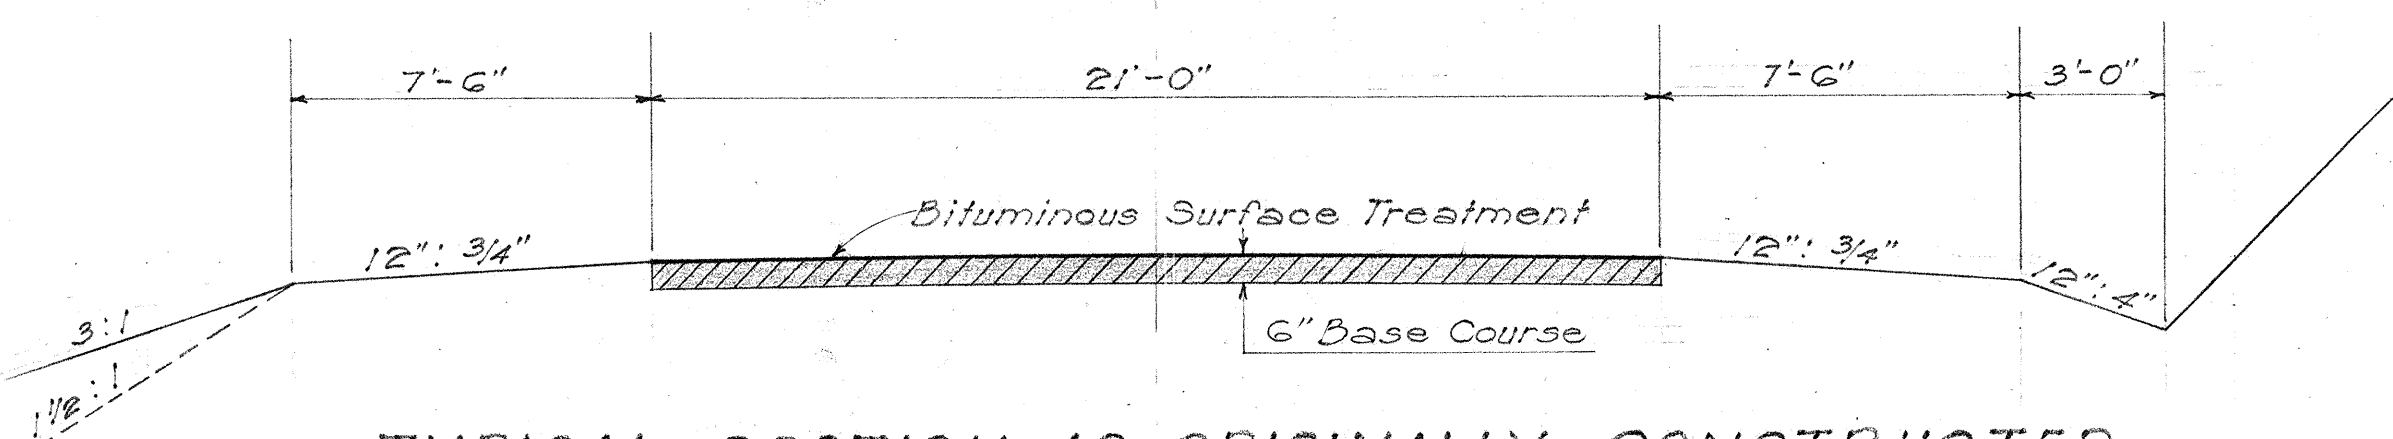


TYPICAL SECTION AS ORIGINALLY CONSTRUCTED
STA. 0+00 to STA. 353+66.70
Scale: 1/4" = 1'-0"

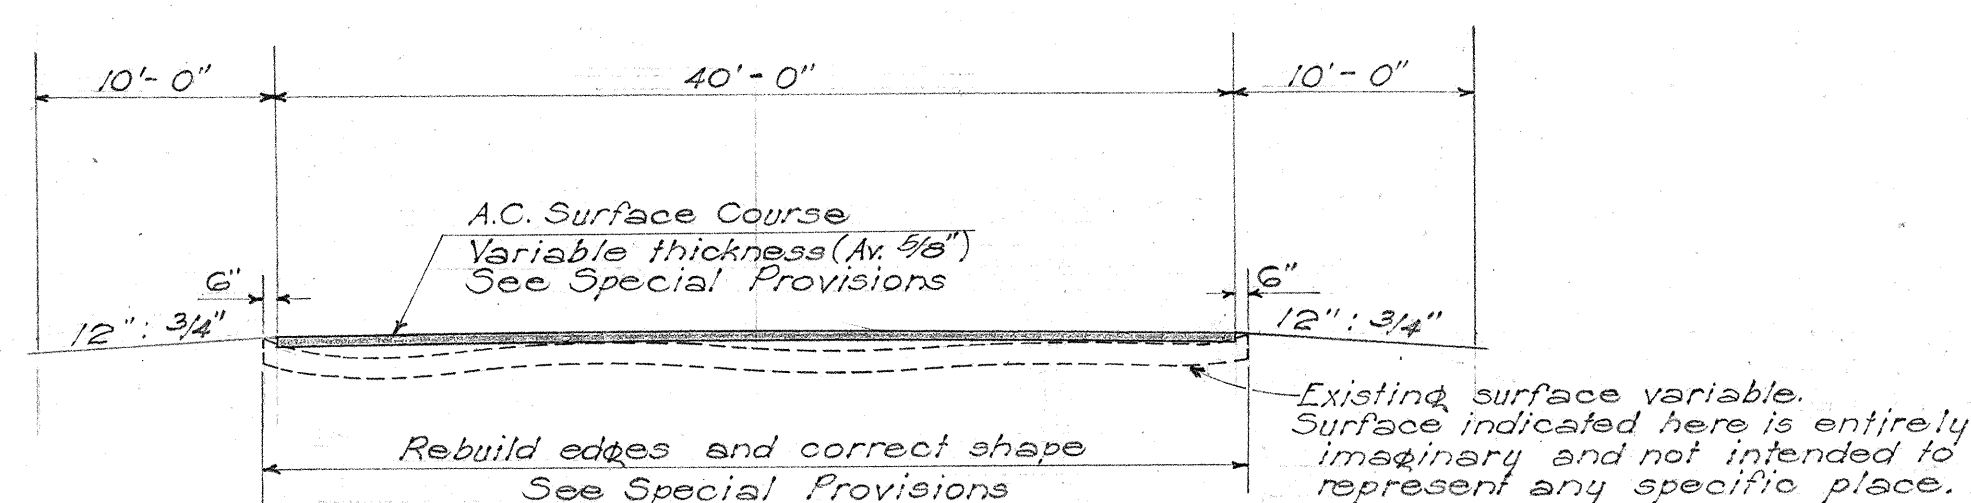

TYPICAL SECTION OF WORK TO BE DONE
ASPHALT CONCRETE RESURFACING ALTERNATE
STA. 353+66.70 TO STA. 368+66.70
Scale: 1/8" = 1'-0"

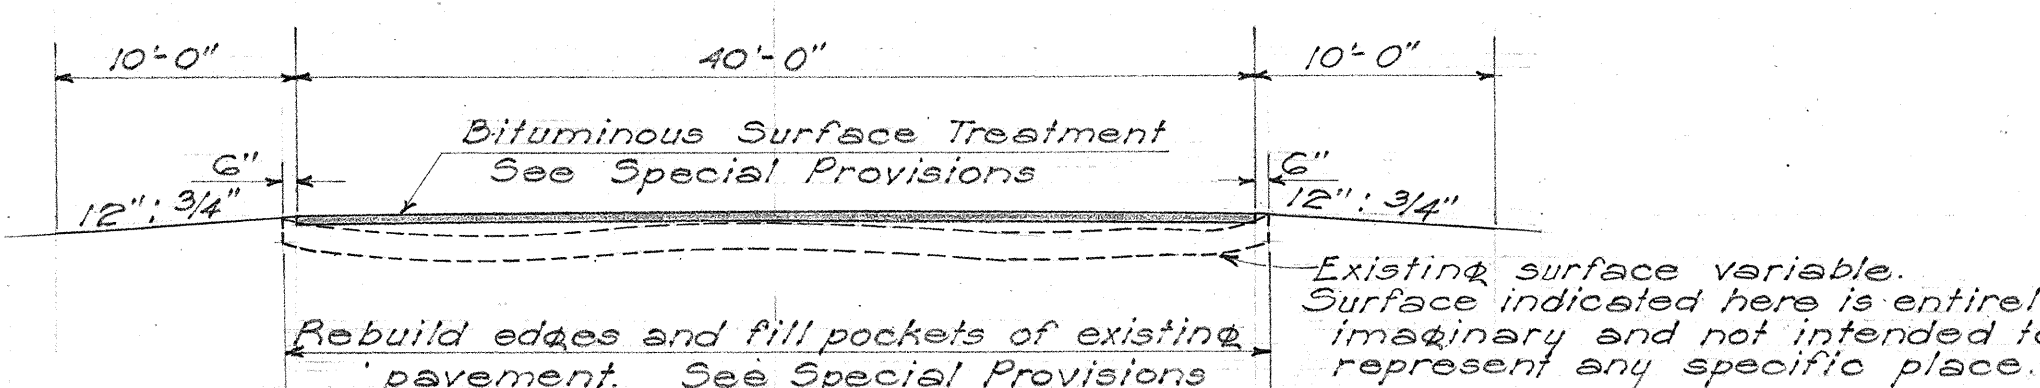

TYPICAL SECTION OF WORK TO BE DONE
BITUMINOUS SURFACE TREATMENT ALTERNATE
STA.353+66.70 to STA.368+66.70
Scale: 1/8" = 1'-0"

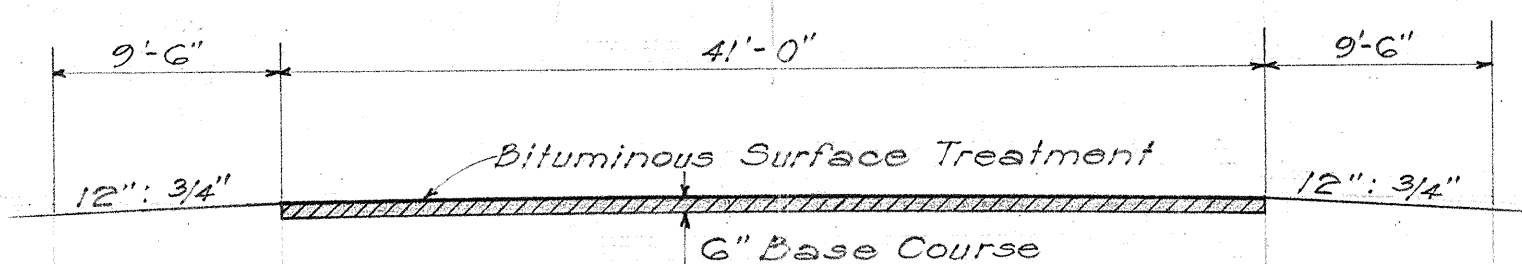

TYPICAL SECTION AS ORIGINALLY CONSTRUCTED
STA. 353+66.70 to STA. 368+66.70
Scale: $\frac{1}{8}'' = 1'-0''$

TERRITORIAL HIGHWAY DEPARTMENT
TERRITORY OF HAWAII
TYPICAL SECTIONS
KAENA POINT ROAD
Project No. W.D.R. 5(1) 1st UNIT
Scale: As noted Sept. 1948

5357.2