	INDEX TO DRAWINGS
SHEETNO	DESCRIPTION
	Title Sheet
2	Typical Sections
3-7	Plan and Profile
8-9	Details of 4' Flat Slab Culverts
10-13	Standard Details
14-23	Mailiilii Bridge Details
24	Standard Bridge Details
25-38	Cross Sections
39-43	Borrow Pit Details

CONVENTIONAL SIGNS

Railroad

Existing Dirt Road

Existing Fence

Boundary Line

Center Line

Paved Approaches Etc.

Culverts

Bridges

TERRITORY OF HAWAII
TERRITORIAL HIGHWAY DEPARTMENT
HONOLULU, T. H.

PLANS OF

WAIANAE ROAD

FEDERAL AID SECONDARY PROJ. NO. S 20(2)

WAIANAE DISTRICT ISLAND OF OAHU

SCALE:


PLAN PROFILE

CROSS SECT

I INCH = 100 F7 HOR.I INCH = 100 " VER.I INCH = 10 " HOR.I INCH = 5 " MAKULE IA WALLIAM

MAKULE IA WAL

Federal Aid Projects previously constructed or under construction.

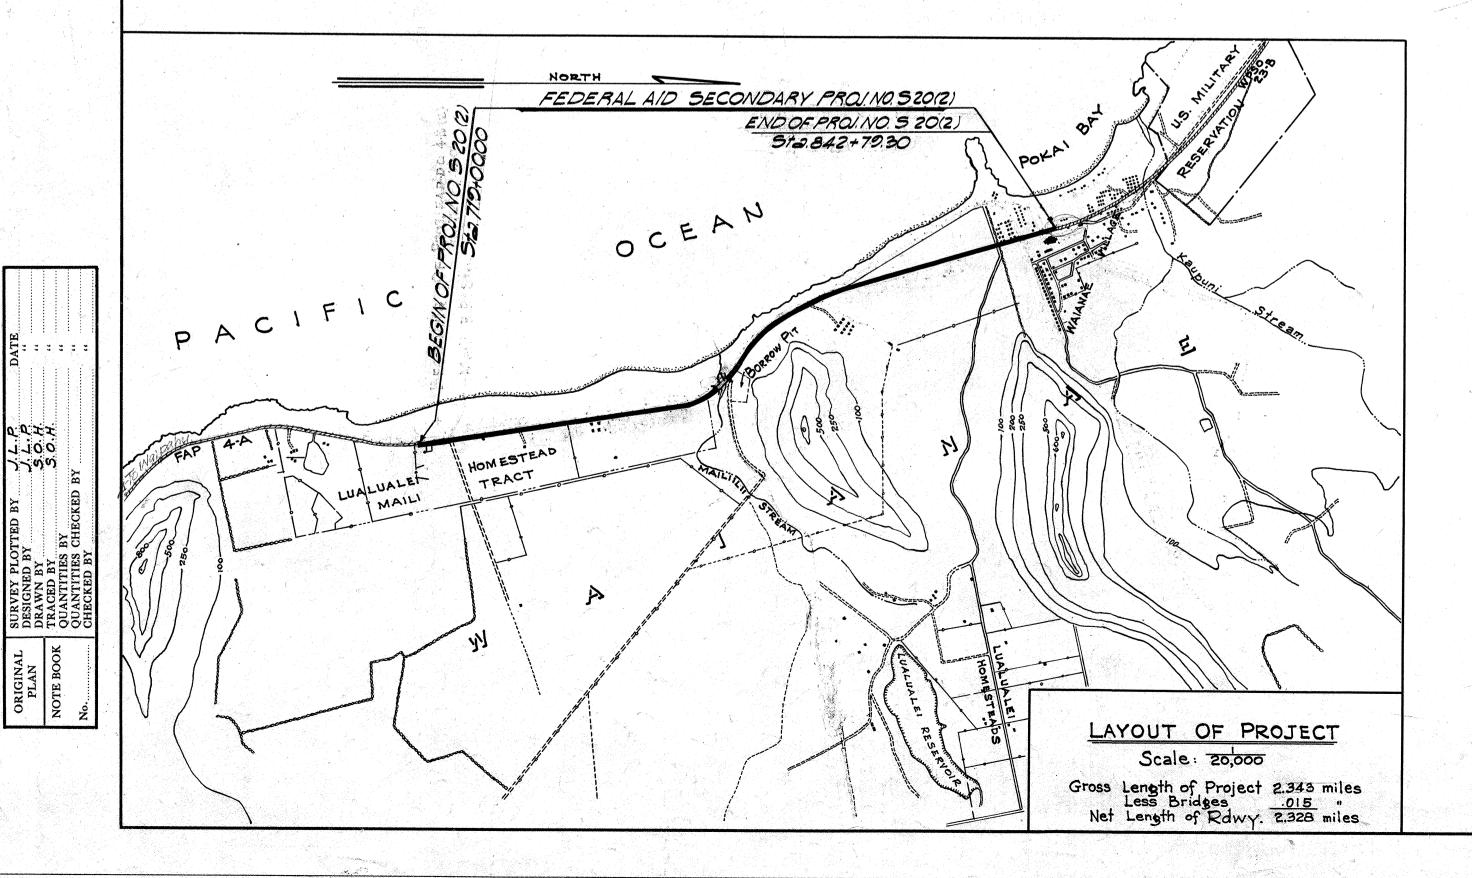

NOTE:

ALL CHANGES MADE DURING CONSTRUCTION
HAVE BEEN NOTED IN RED IN THESE
TRACINGS AND CHECKED BY:

Possess D'Zusio
RESIDENT ENGINEER

FED. ROAD DIST. NO. STATE PROJ. NO. SHEET SHEET SHEETS

HAWRII HAW 2520(2) 1949 4 43

DATE 4/9/50

RECOMMENDED FOR APPROVALS DATES

DISTRICT ENGINEER
PUBLIC ROADS ADMINISTRATION FEDERAL WORKS AGENCY

APPROVED DATE: 1-10-49

TERRITORIAL HIGHWAY ENGINEER

DIVISION ENGINEER
PUBLIC ROADS ADMINISTRATION
FEDERAL WORKS AGENCY

5096.1