
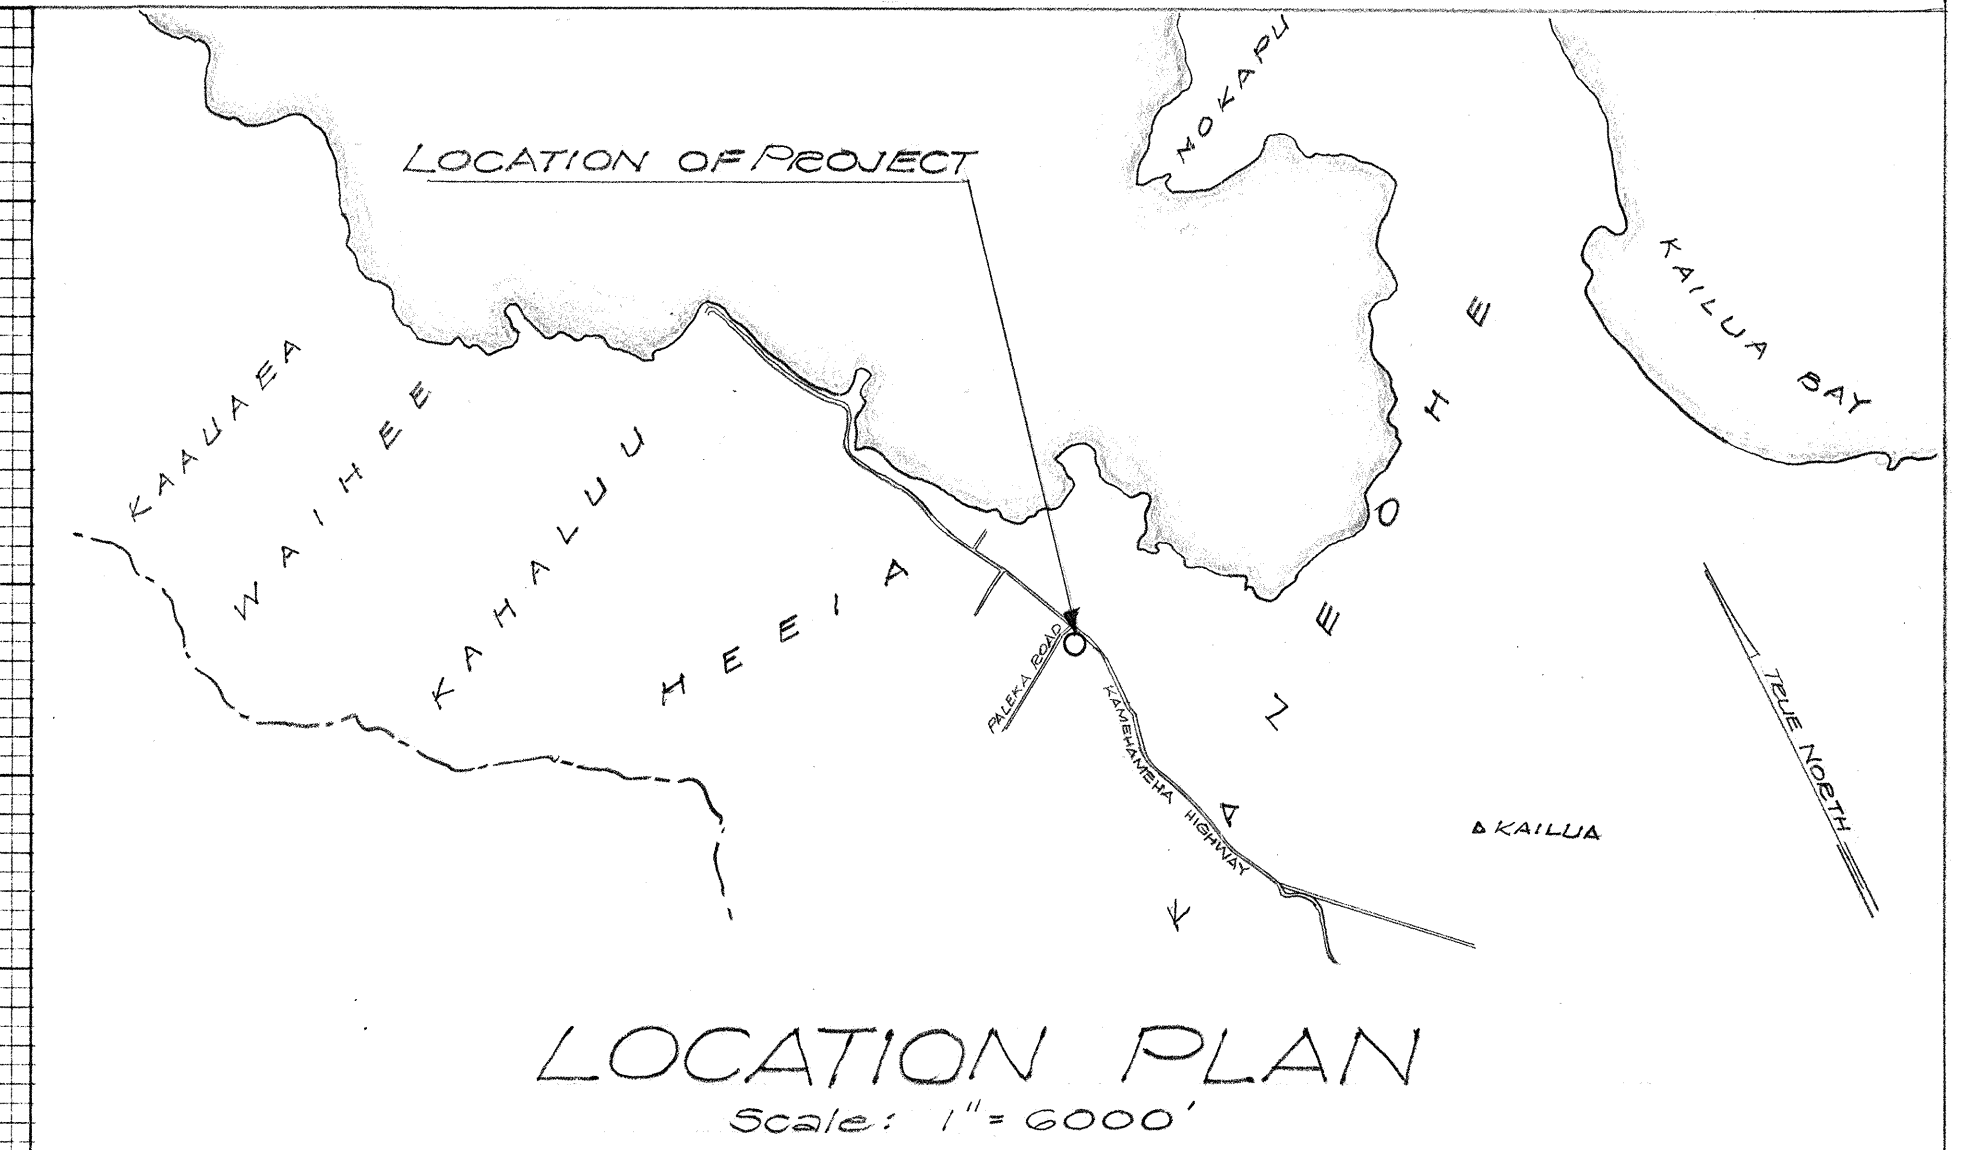
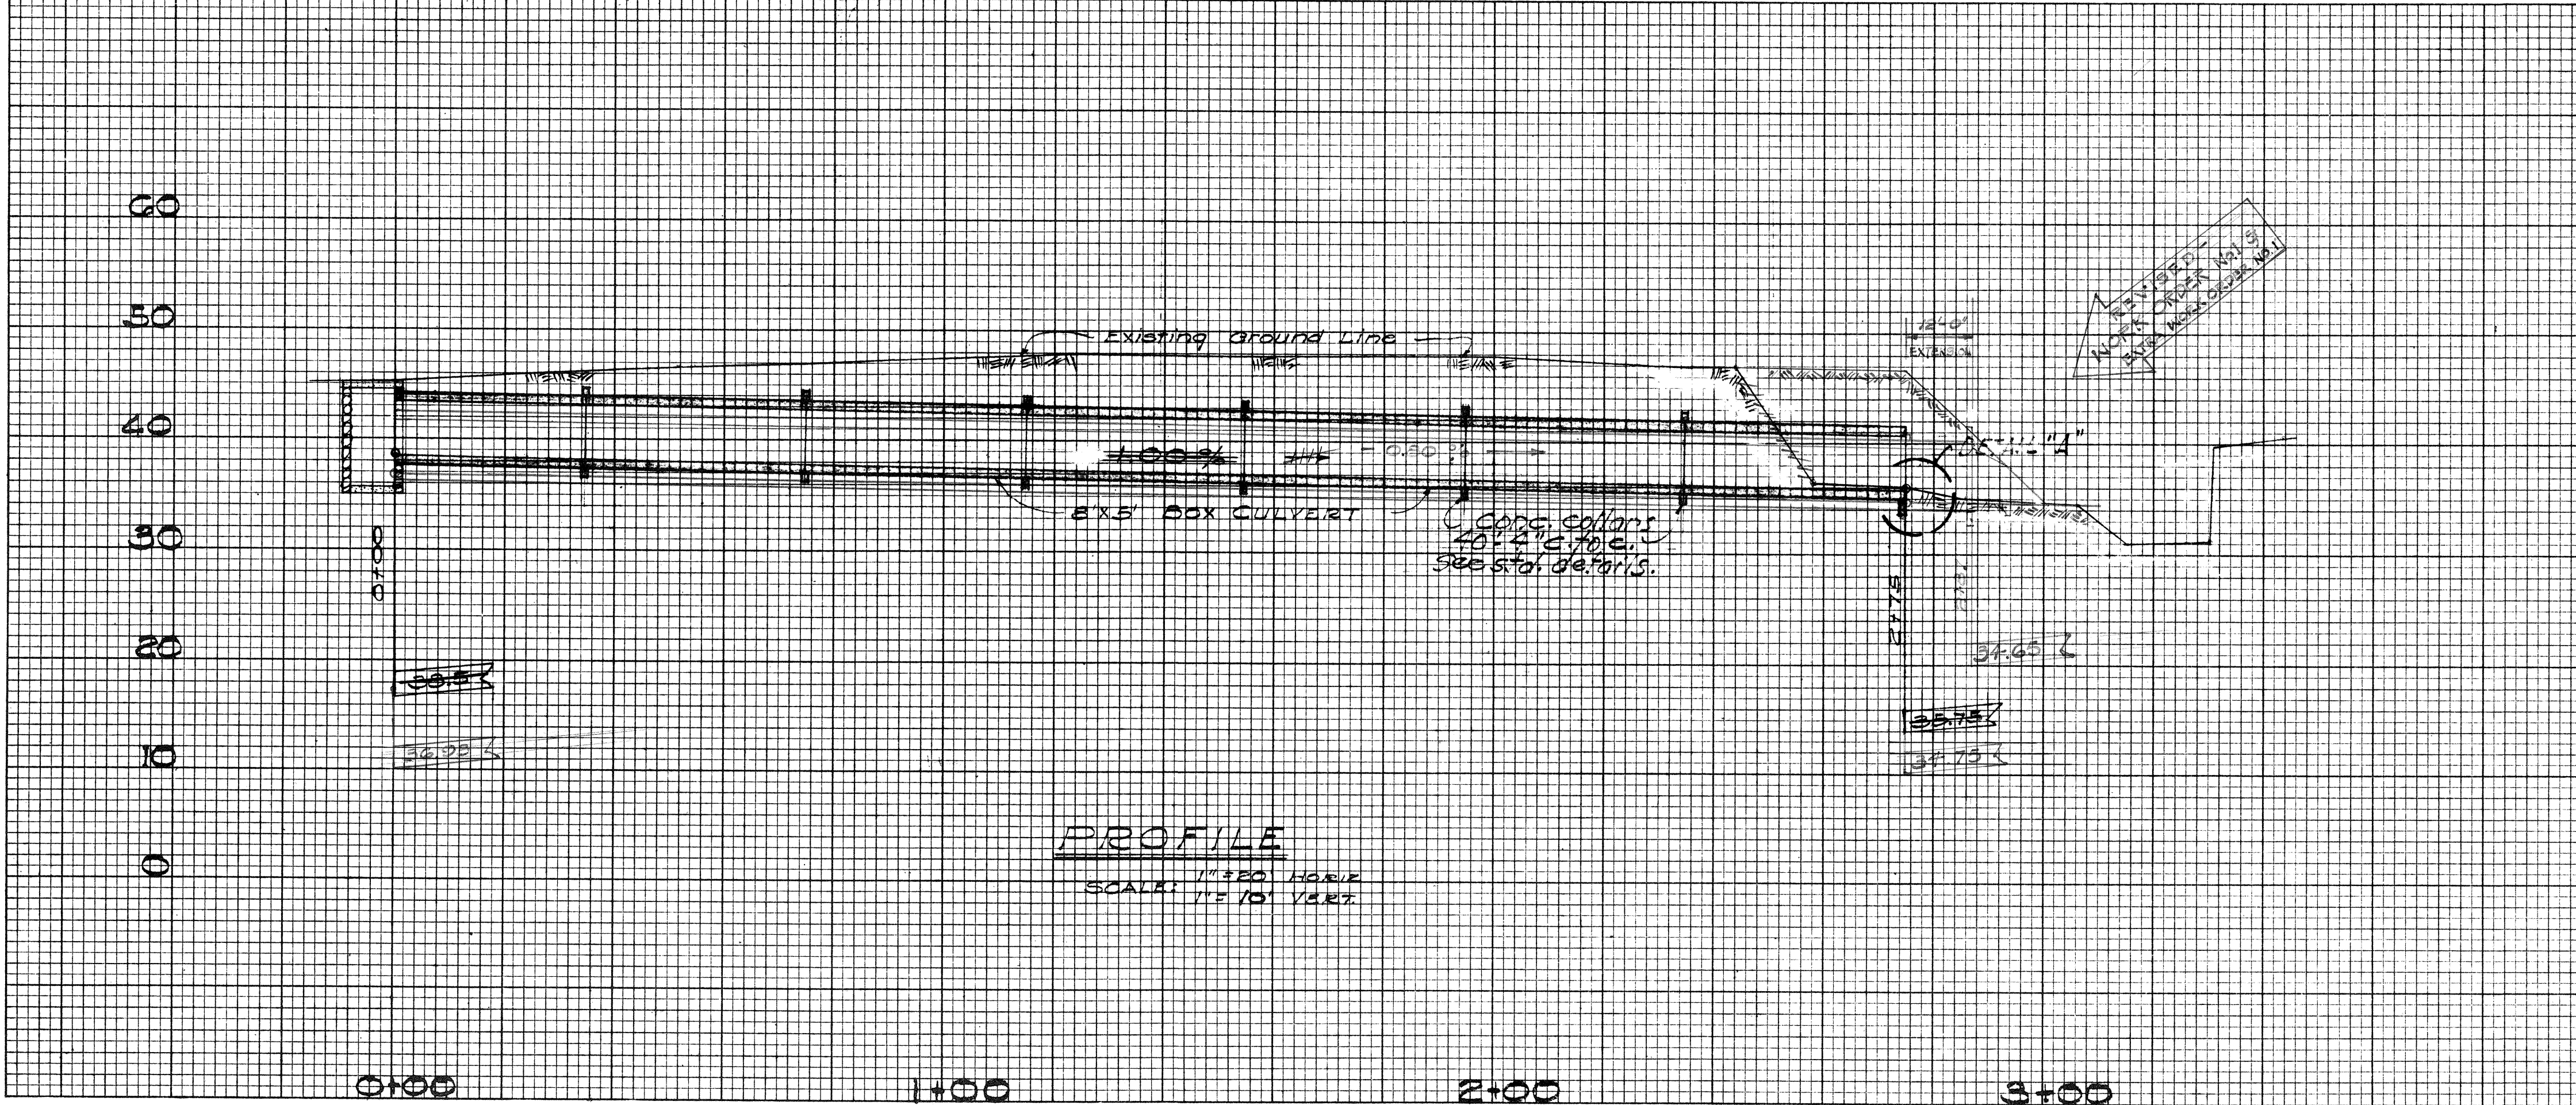
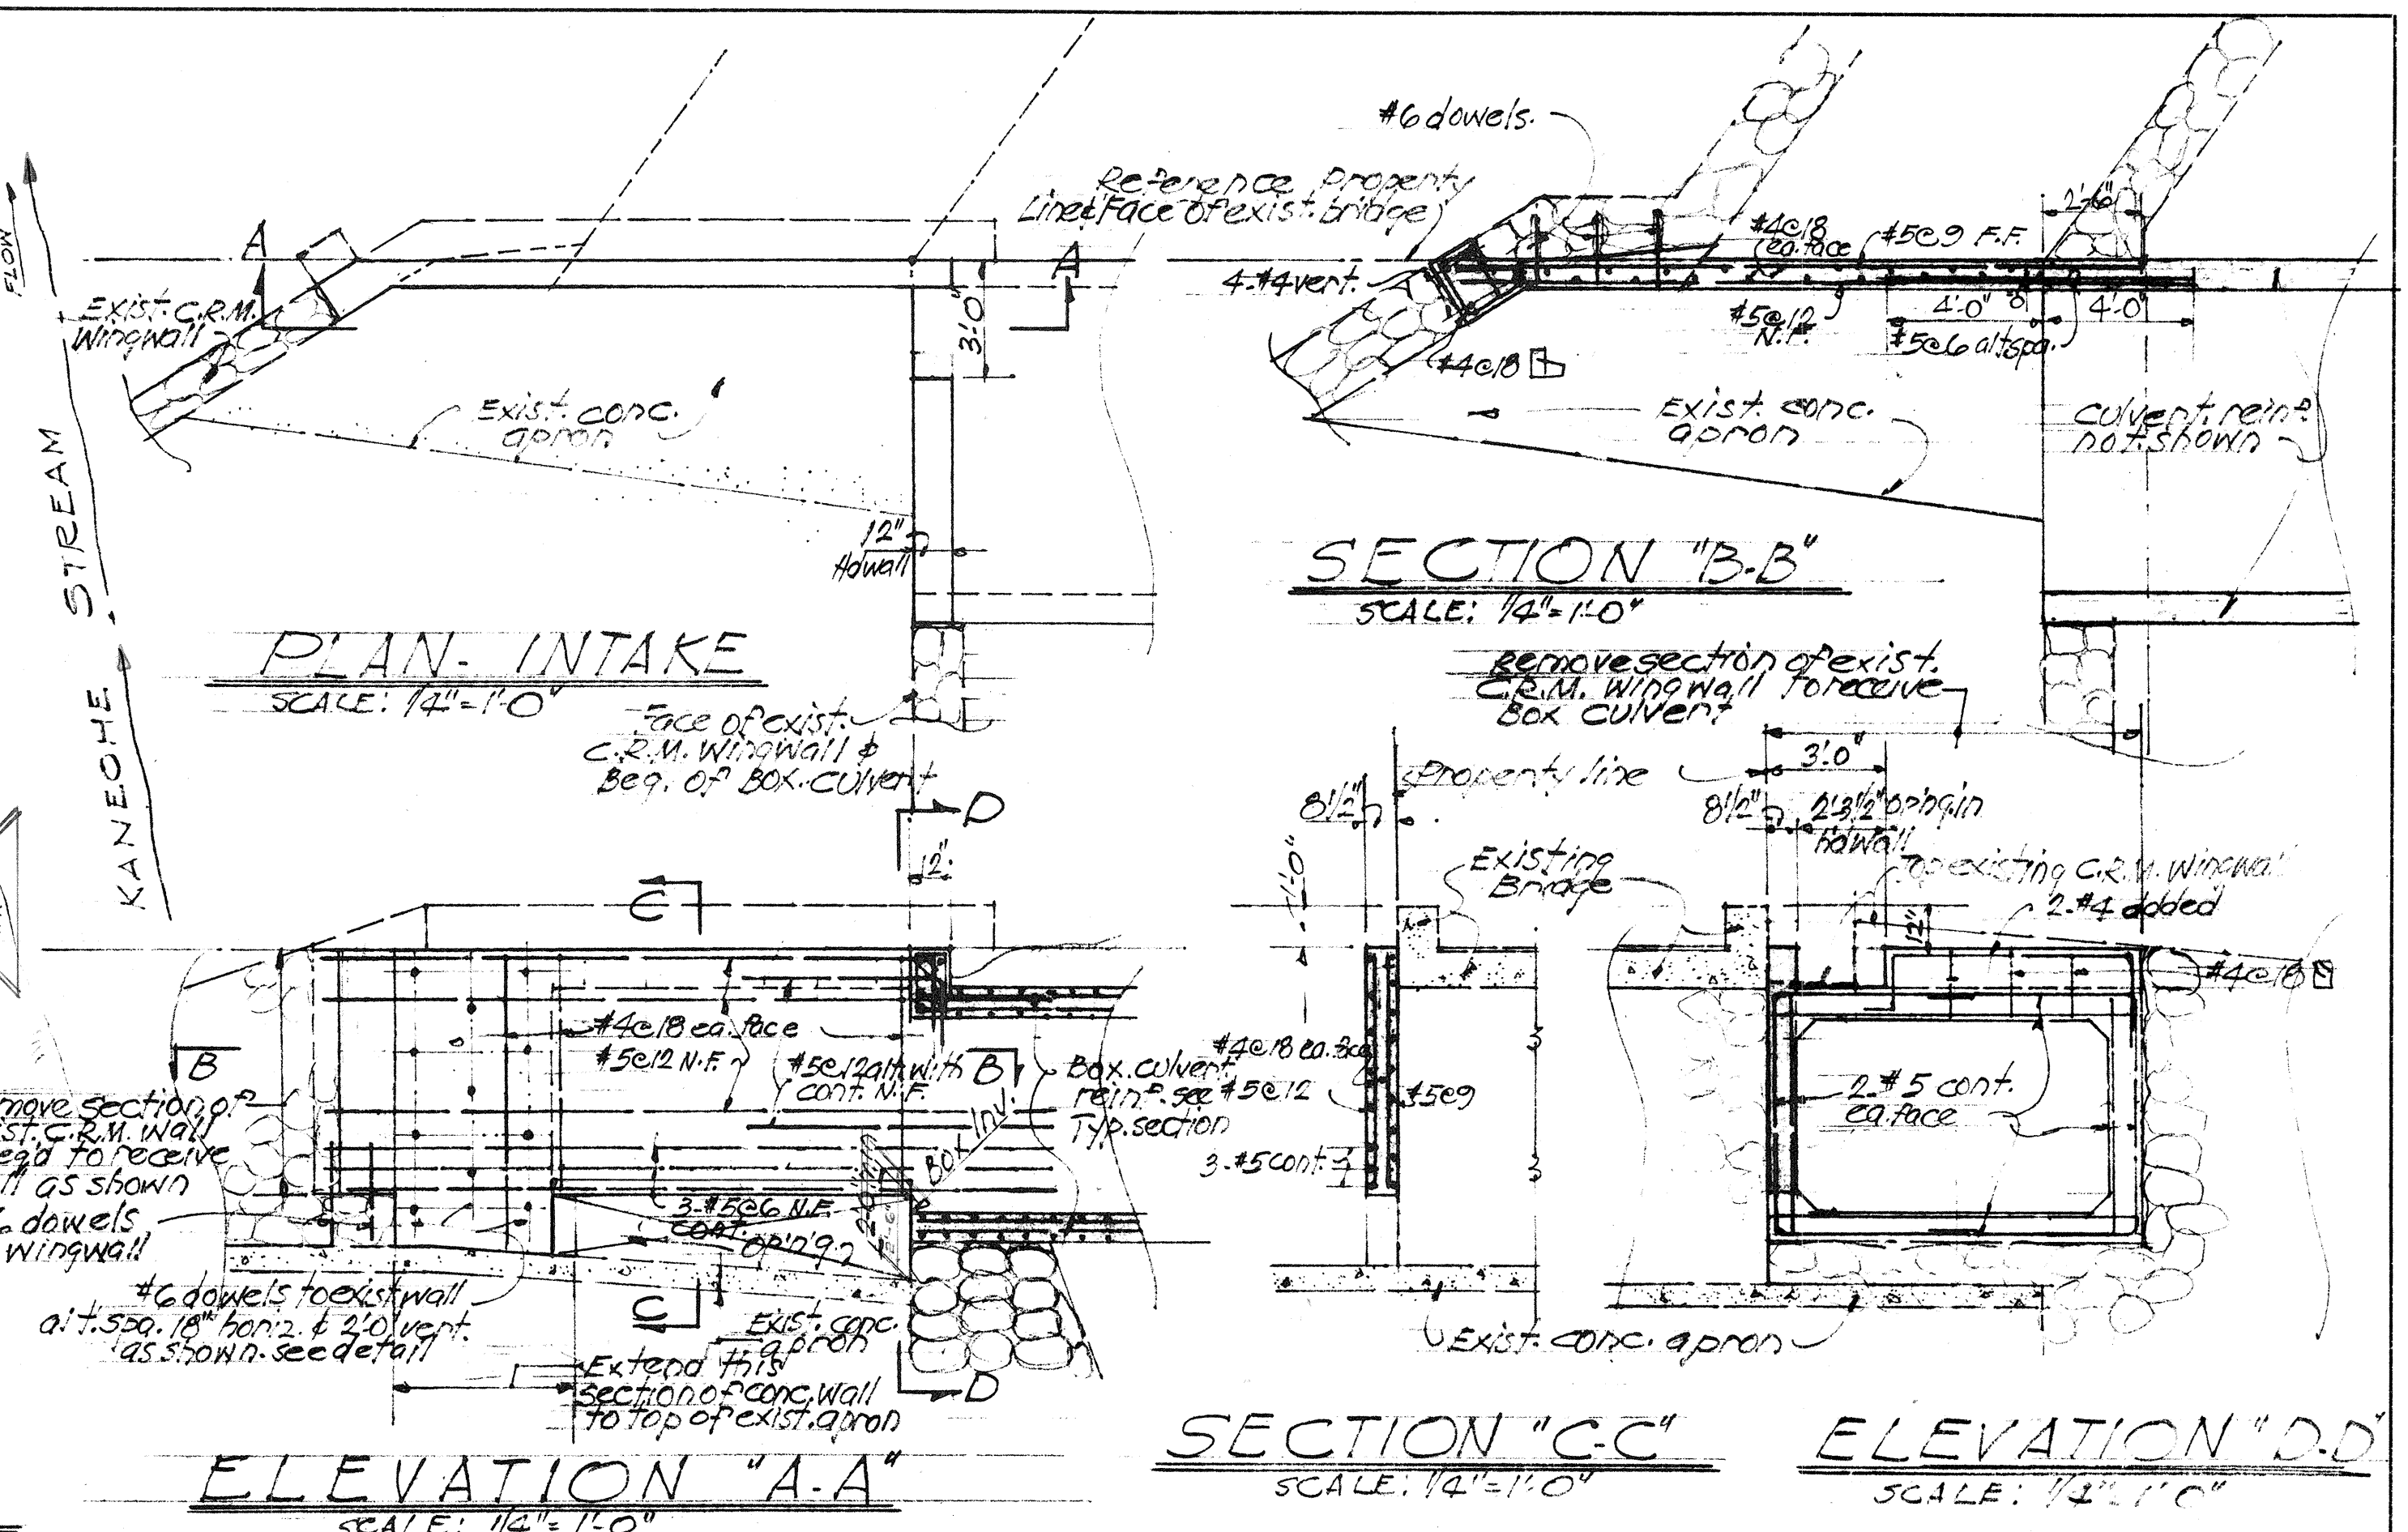
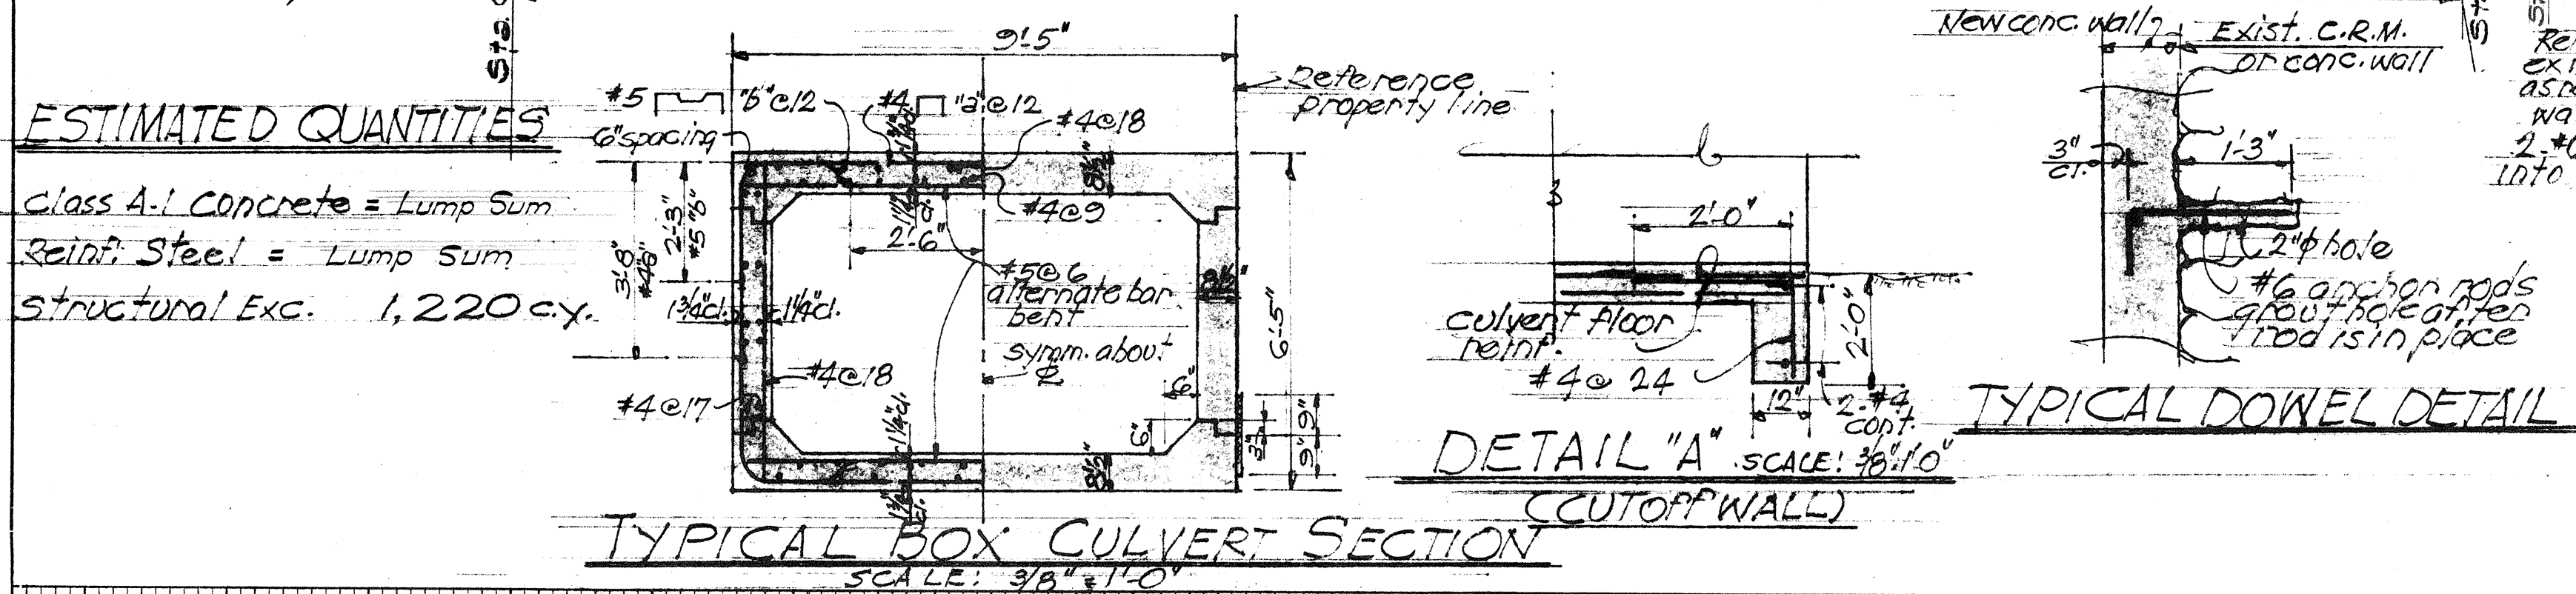


FINAL	SURVEYED	BY	DATE
SURVEY	PLOTTED		
NOTE BOOK	REVISIONS		
NO.	AREAS CHECKED		

ORIGINAL	SURVEYED	BY	DATE
SURVEY	PLOTTED		
NOTE BOOK	REVISIONS		
NO.	AREAS CHECKED		

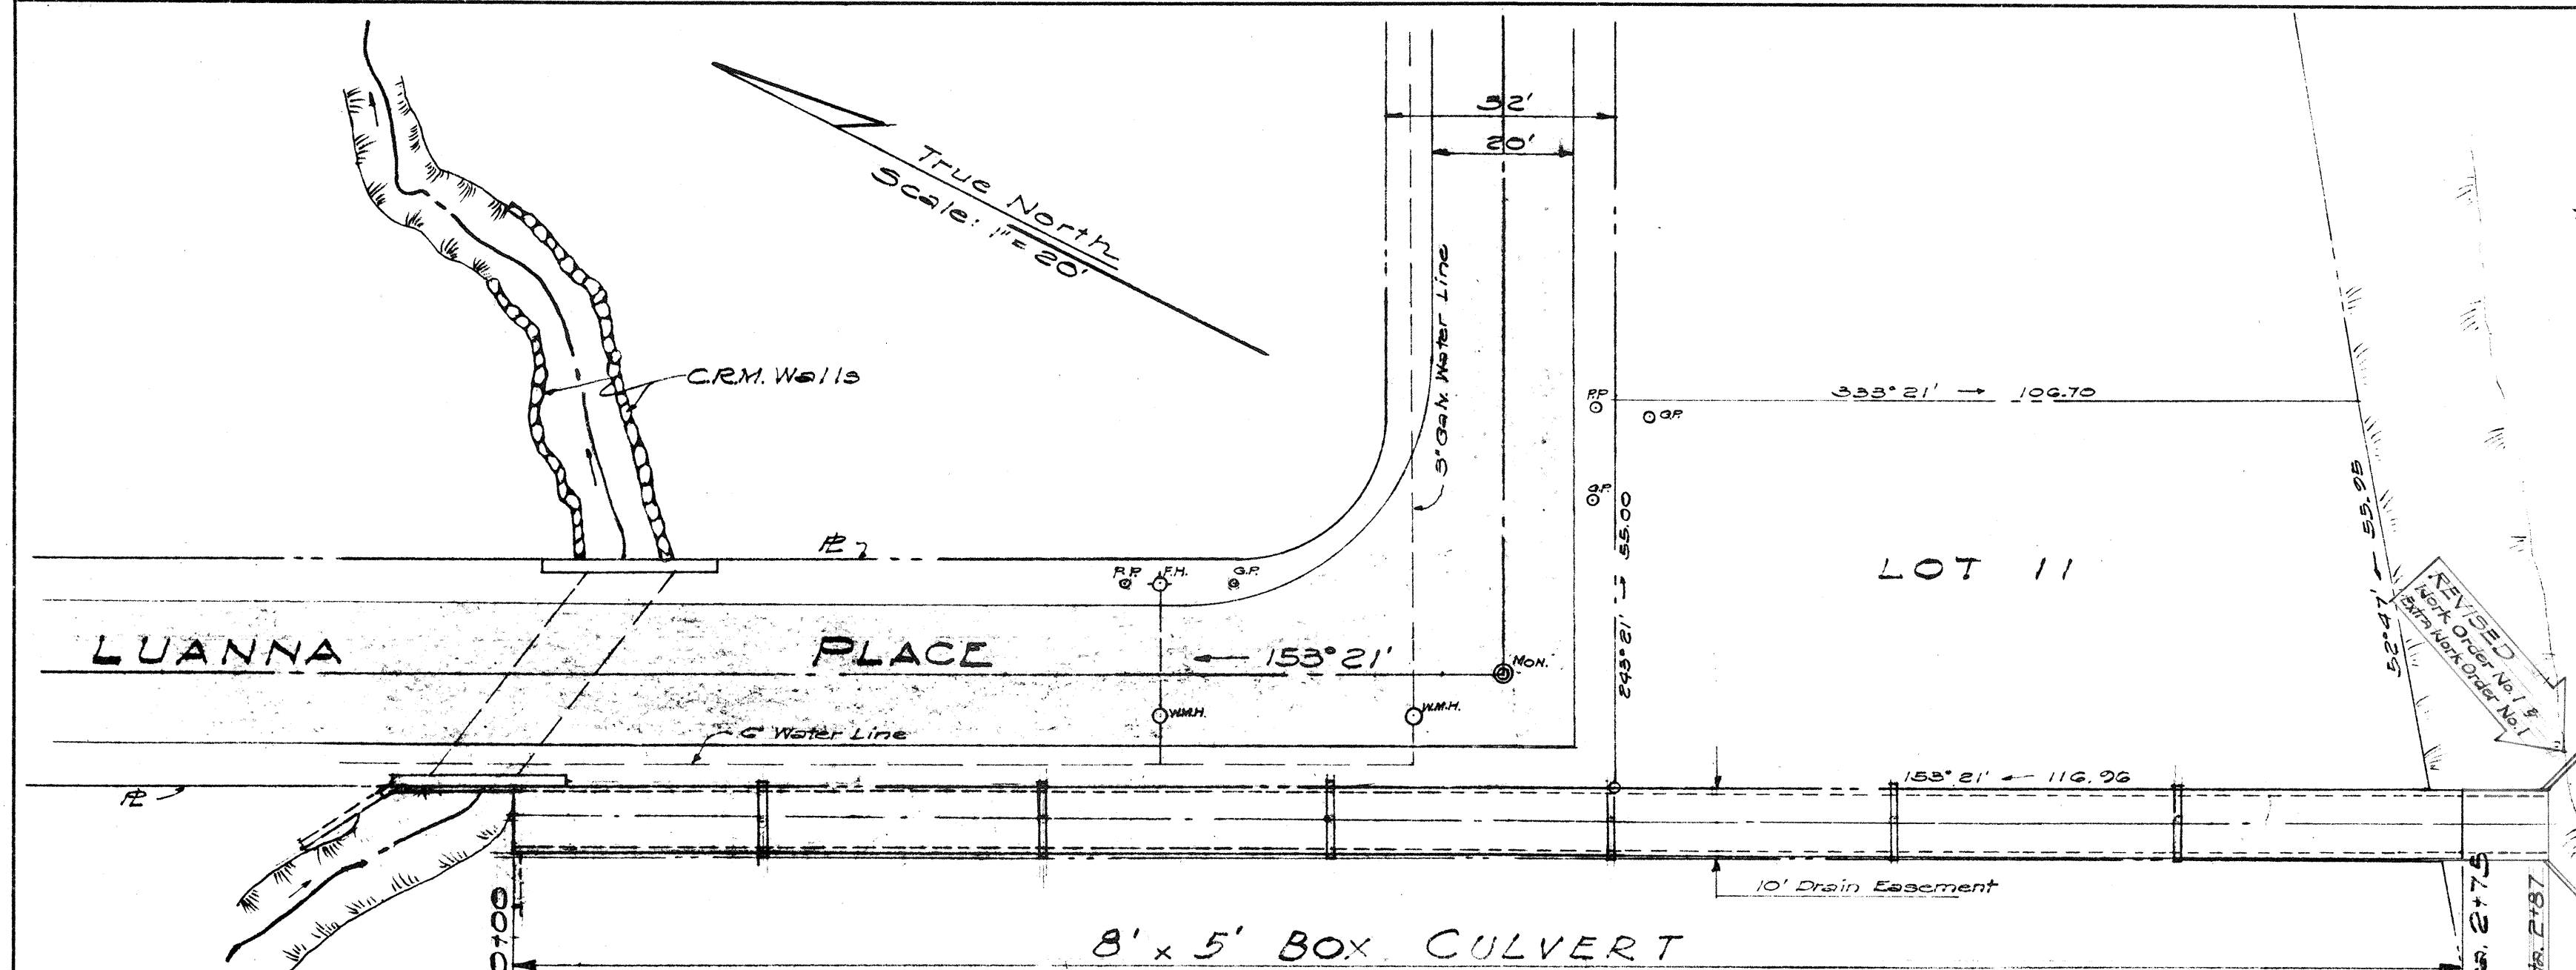

TERRITORIAL HIGHWAY DEPARTMENT
TERRITORY OF HAWAII

**8x5 BOX CULVERT
FOR LUANNA TRACT**

JOB NO. 5929

SCALE: AS NOTED OCT. 1987

5929.6