
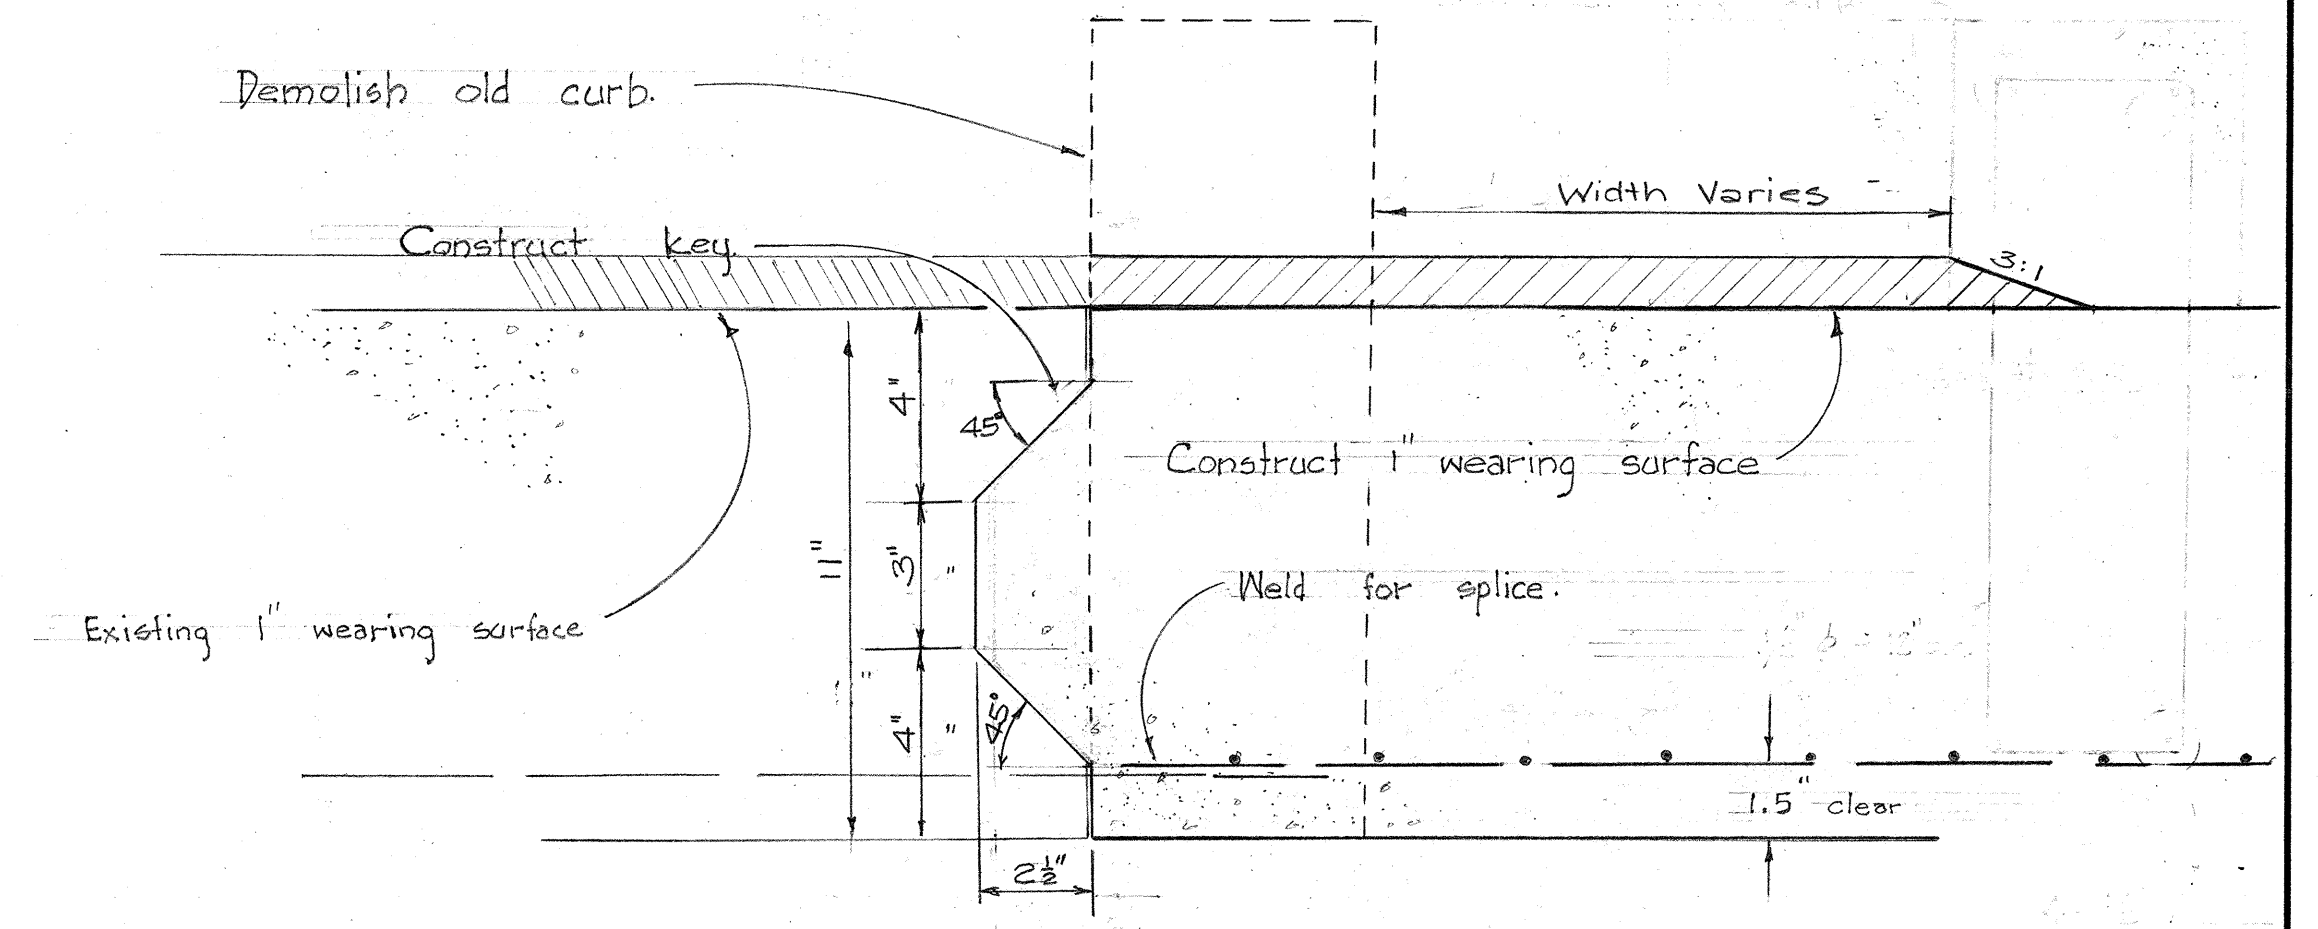
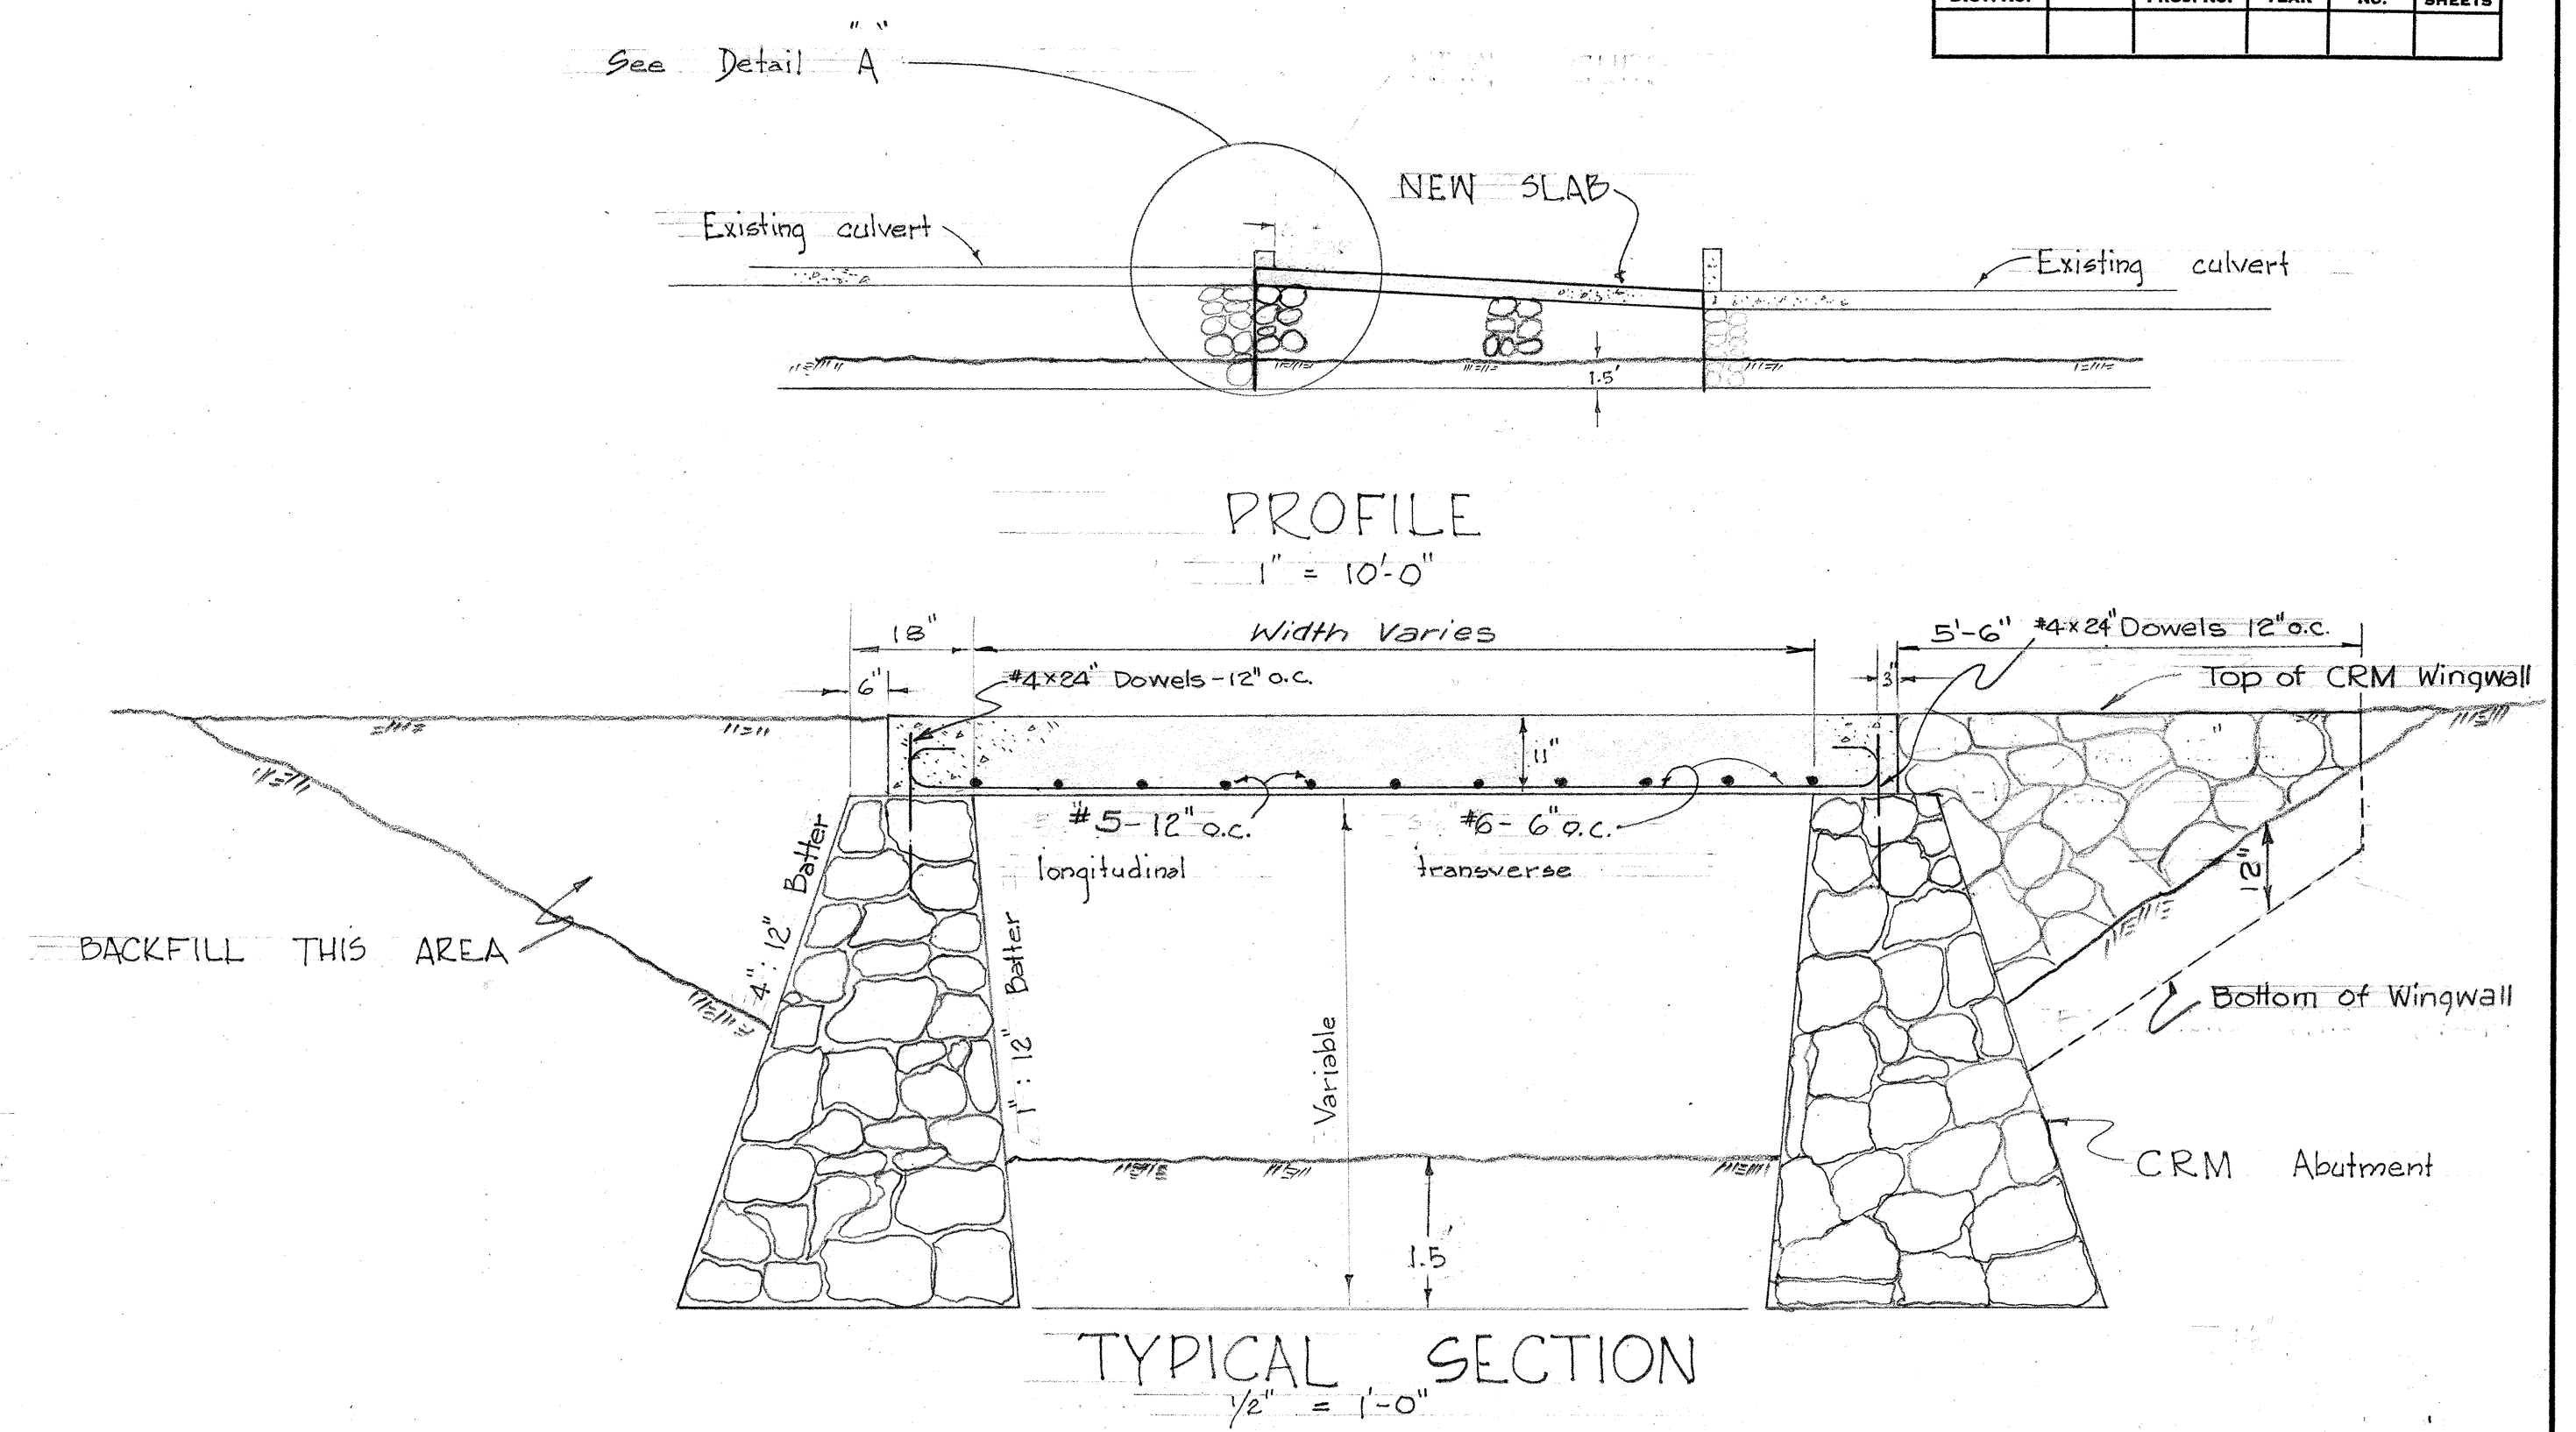


FED. ROAD DIST. NO.	STATE	FED. AID PROJ. NO.	FISCAL YEAR	SHEET NO.	TOTAL SHEETS

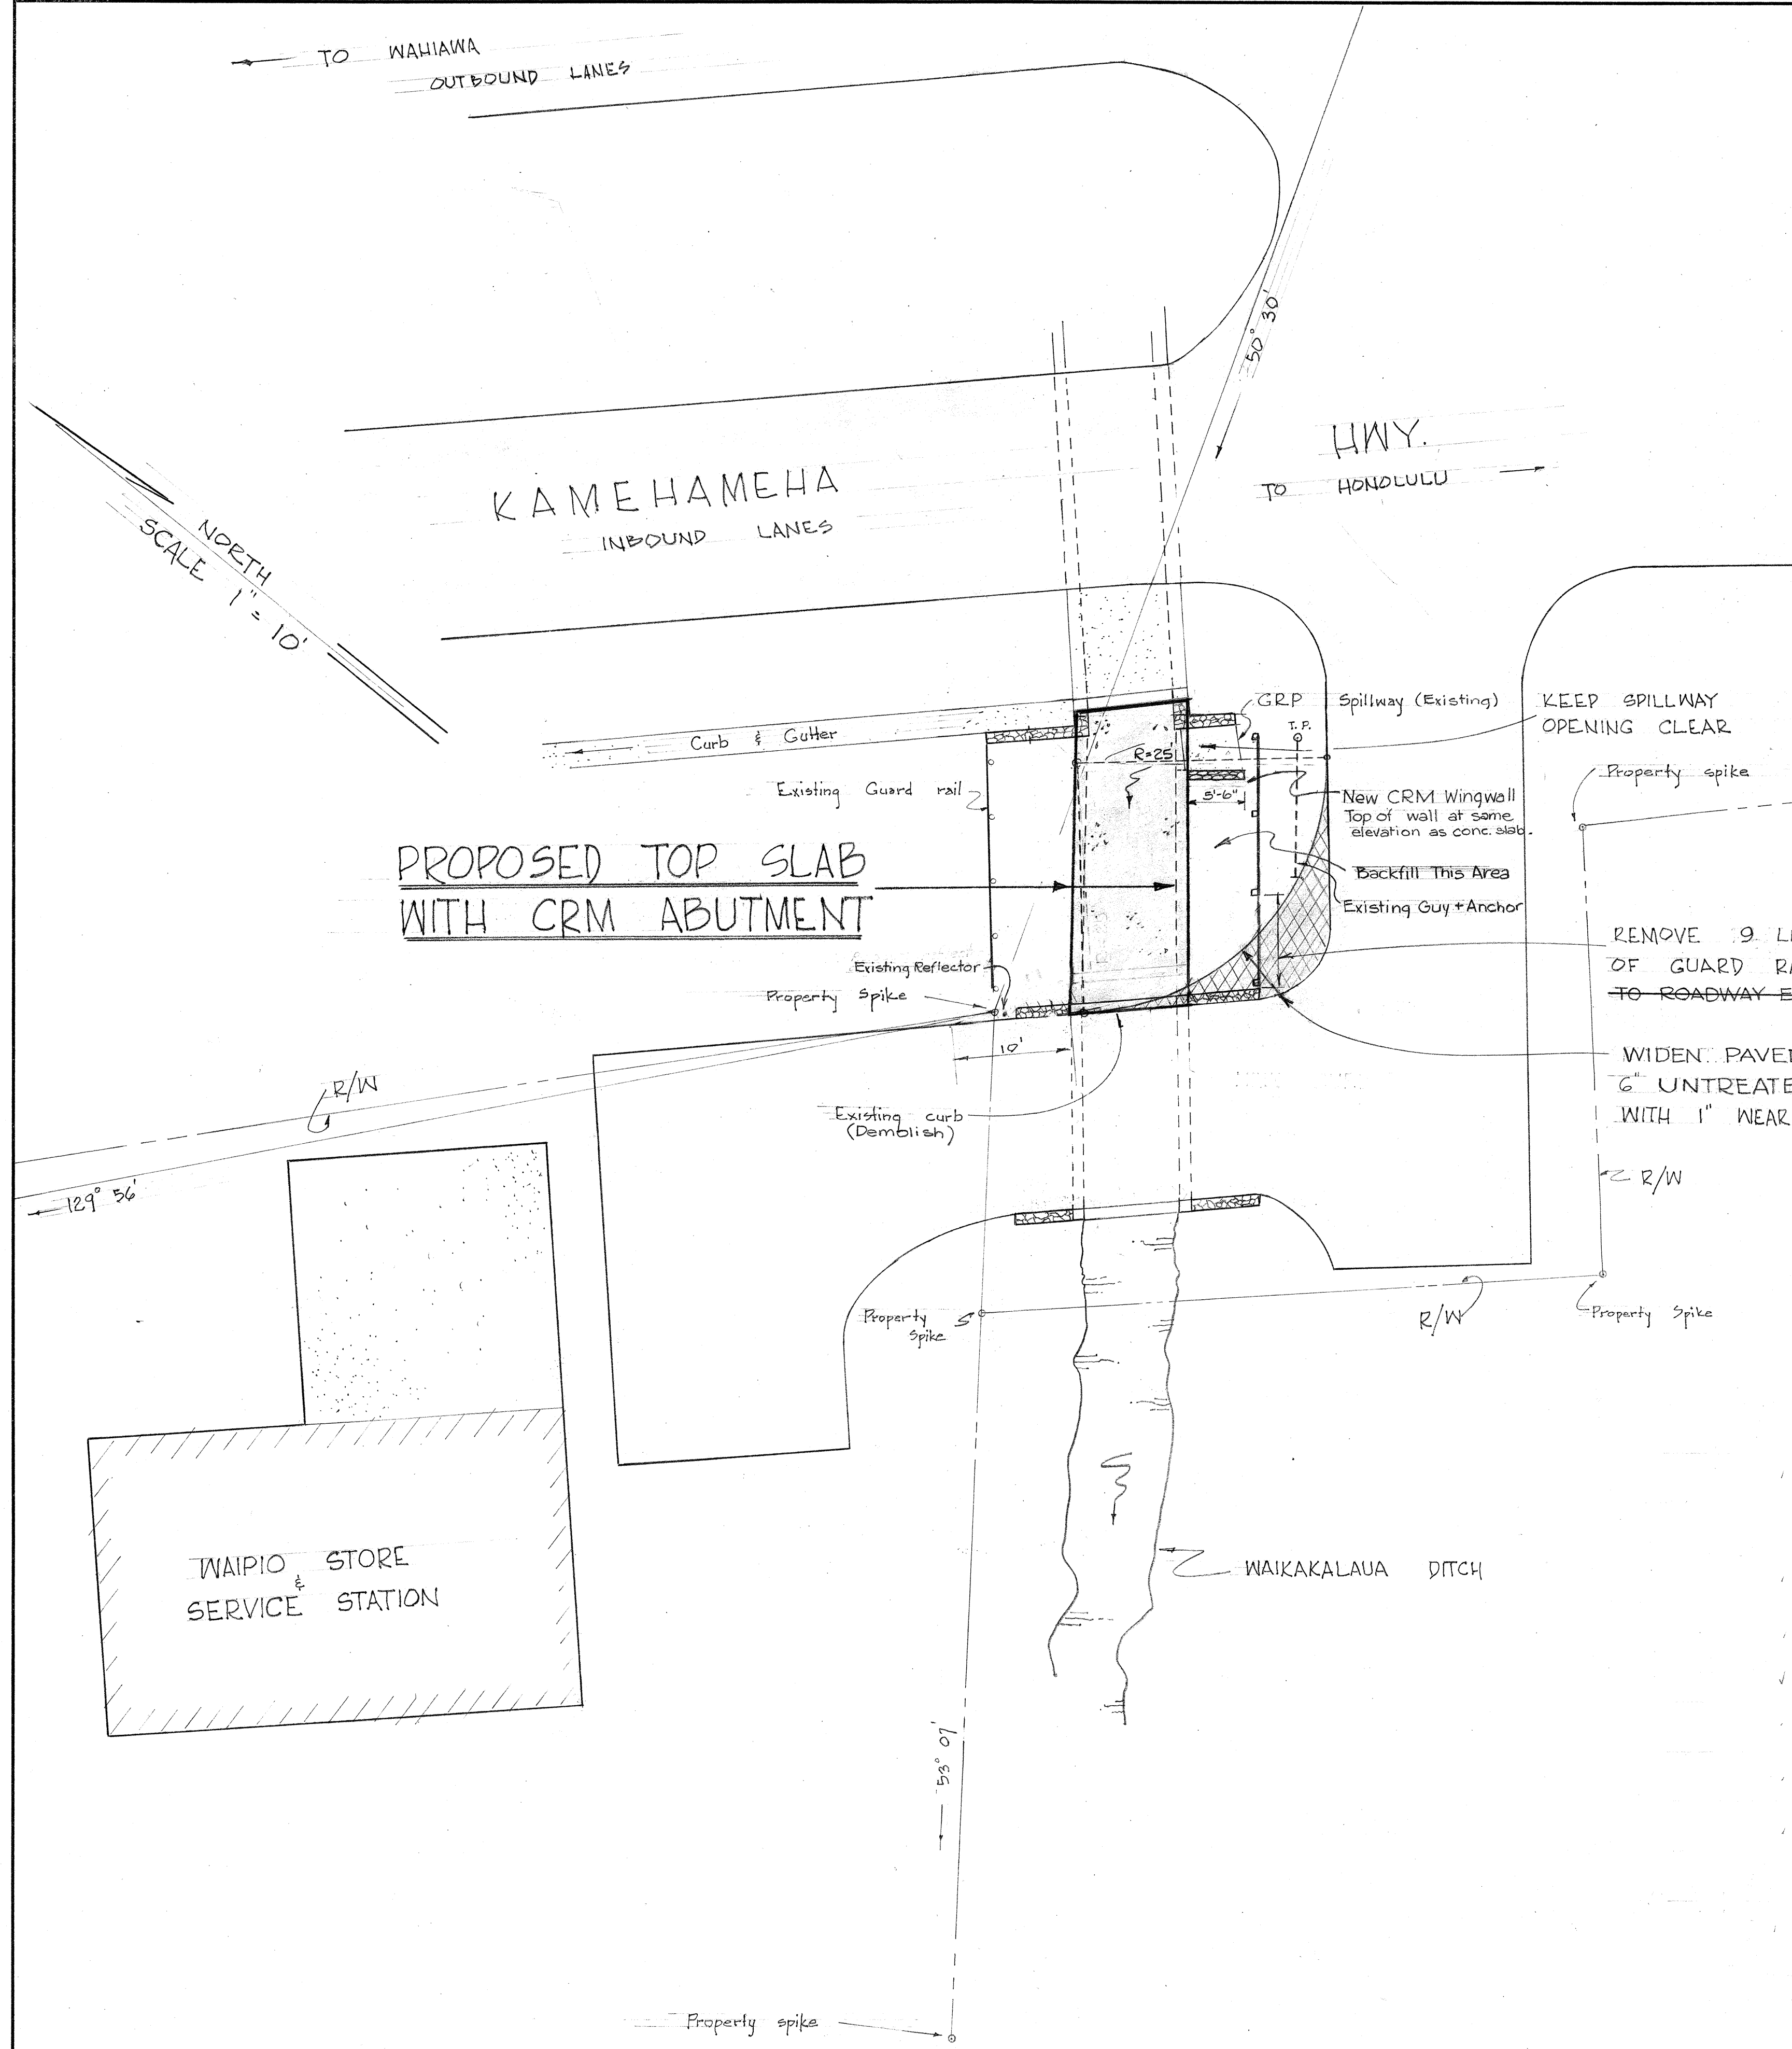

ESTIMATED QUANTITIES

Structural Exc.	22 36 c.y.
CRM	283 37 c.y.
Class A-1 Concrete	12.7 c.y.
Steel	1636 1500 lbs.
A.C. - Mix V	1.1 ton
Untreated Base	5 c.y.
Prime Coat SC-Asphalt	8 gal.
Sprinkling	0.3 Mgal.
Roadway Exc.	2 c.y.

FILE	DESIGN	CONSTRUCTION	NO.
1577	1	3	02

TERRITORIAL HIGHWAY DEPARTMENT
TERRITORY OF HAWAII
PROPOSED CULVERT EXTENSION
OFF KAM HWY AT WAIPAO STORE
STA. 66 + 23 ± LEFT
 SCALE: AS NOTED
 DISTRICT ENGINEER'S OFFICE

SHEET No. OF SHEETS

5929.7

Job 5929 DD-P

ORIGINAL PLAN	DESIGNED BY	DATE
NOTE BOOK No.	TRACED BY	
	QUANTITIES BY	
	CHECKED BY	