



FINAL SURVEY
 NO. _____
 DATE _____
 BY _____
 SURVEYED
 PLOTTED
 TEMPLATE
 AREAS CHECKED

ORIGINAL SURVEY
 NO. _____
 DATE _____
 BY _____
 SURVEYED
 PLOTTED
 TEMPLATE
 AREAS CHECKED

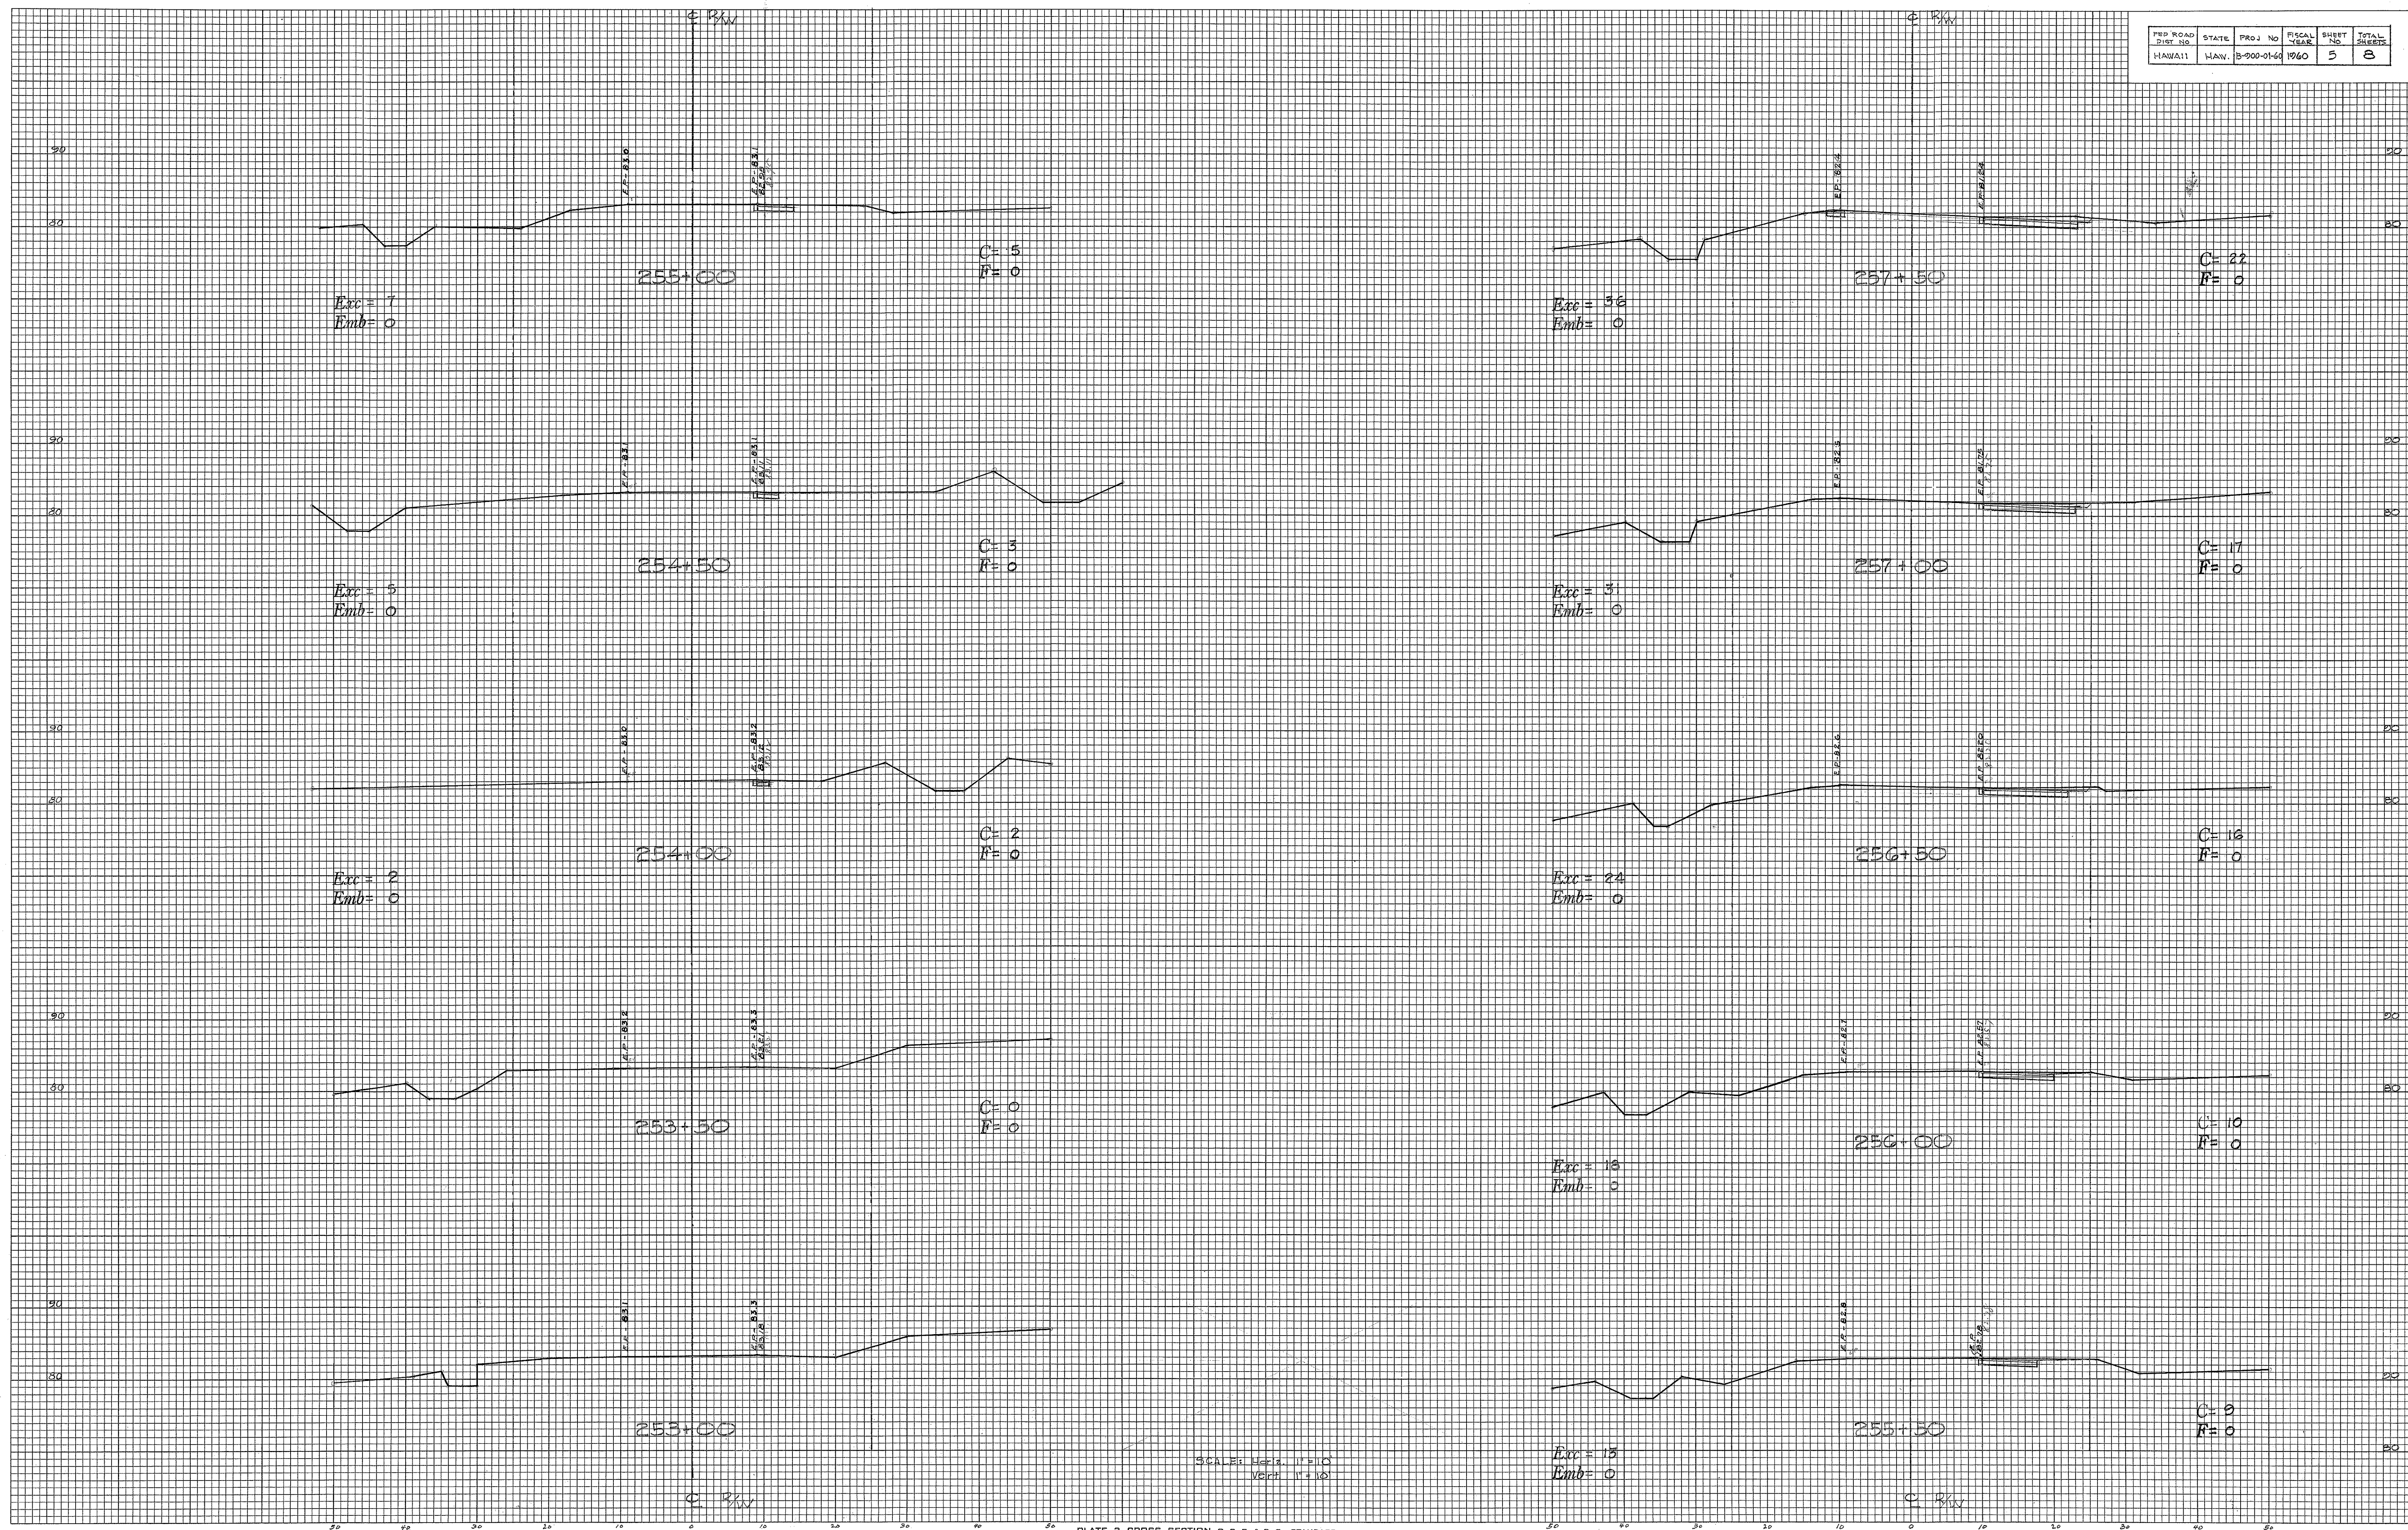



FINAL SURVEY
 SURVEYED BY
 DATE
 NOTE BOOK NO.
 TEMPLATE AREAS CHECKED

ORIGINAL SURVEY
 SURVEYED BY
 DATE
 NOTE BOOK NO.
 TEMPLATE AREAS CHECKED

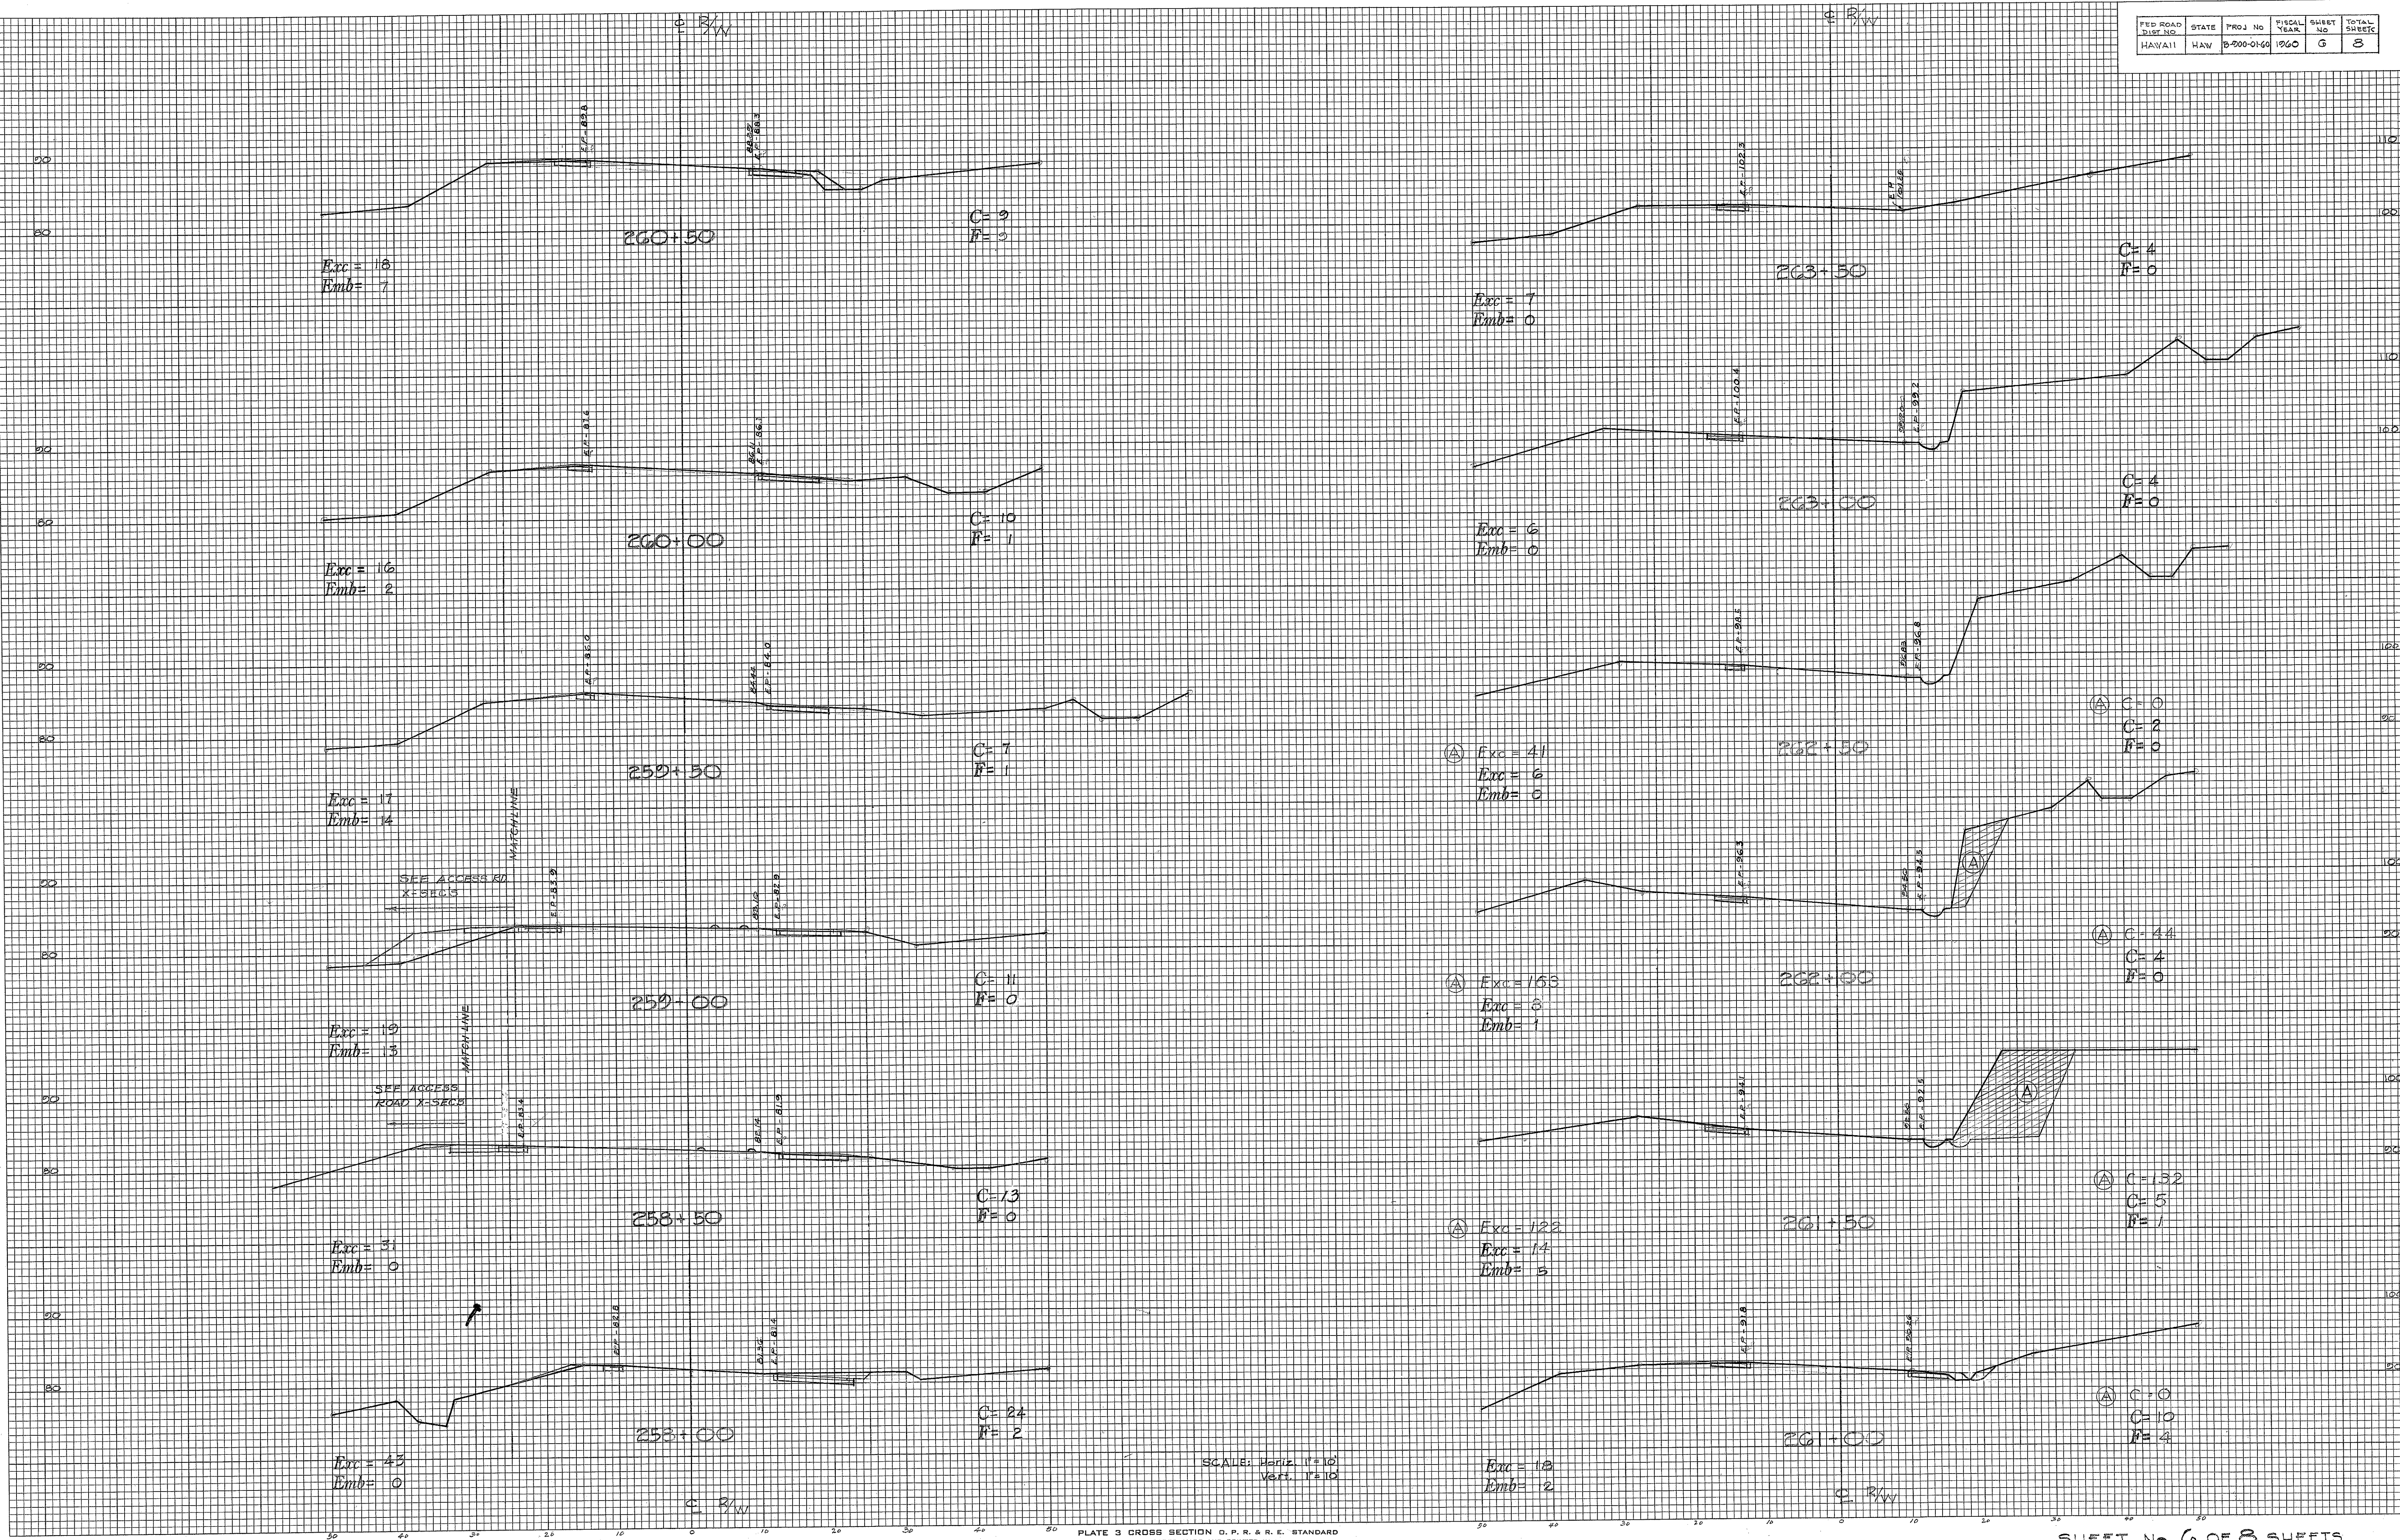

FINAL SURVEY	DATE	BY
	NO. _____	NO. _____
	NOTE BOOK	NO. _____
	NO. _____	NO. _____

ORIGINAL SURVEY	DATE	BY
	NO. _____	NO. _____
	NOTE BOOK	NO. _____
	NO. _____	NO. _____

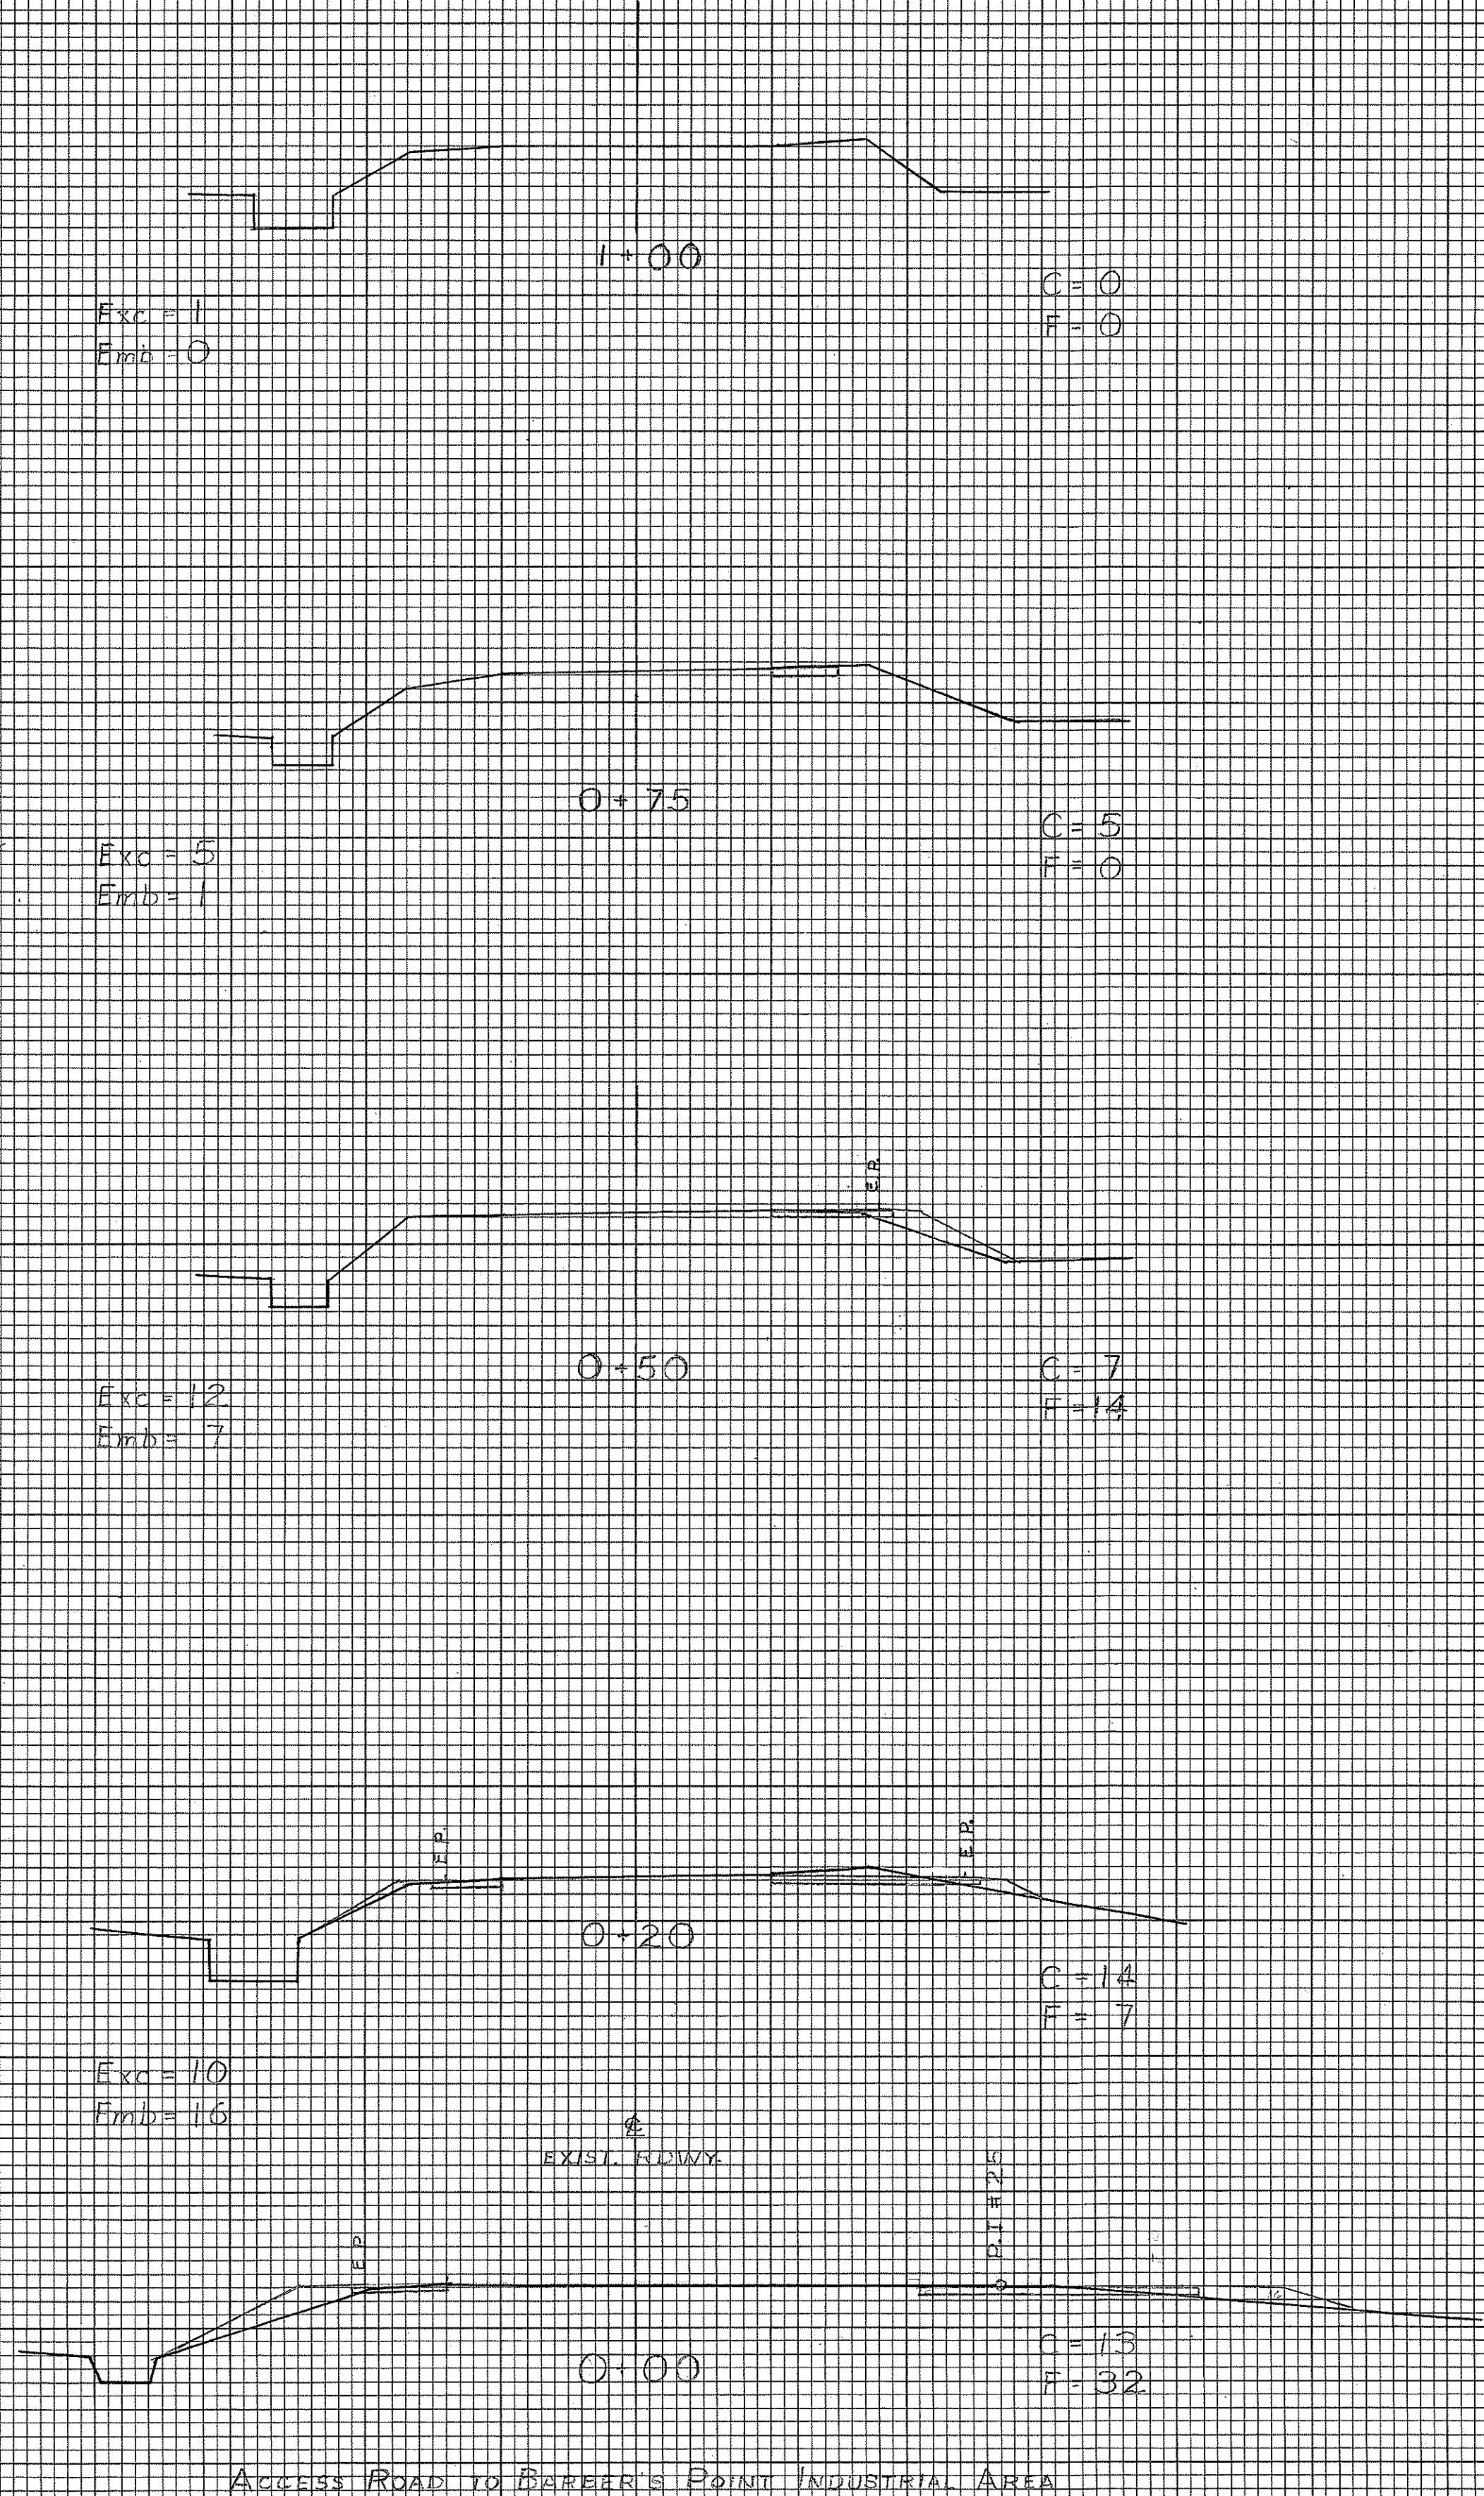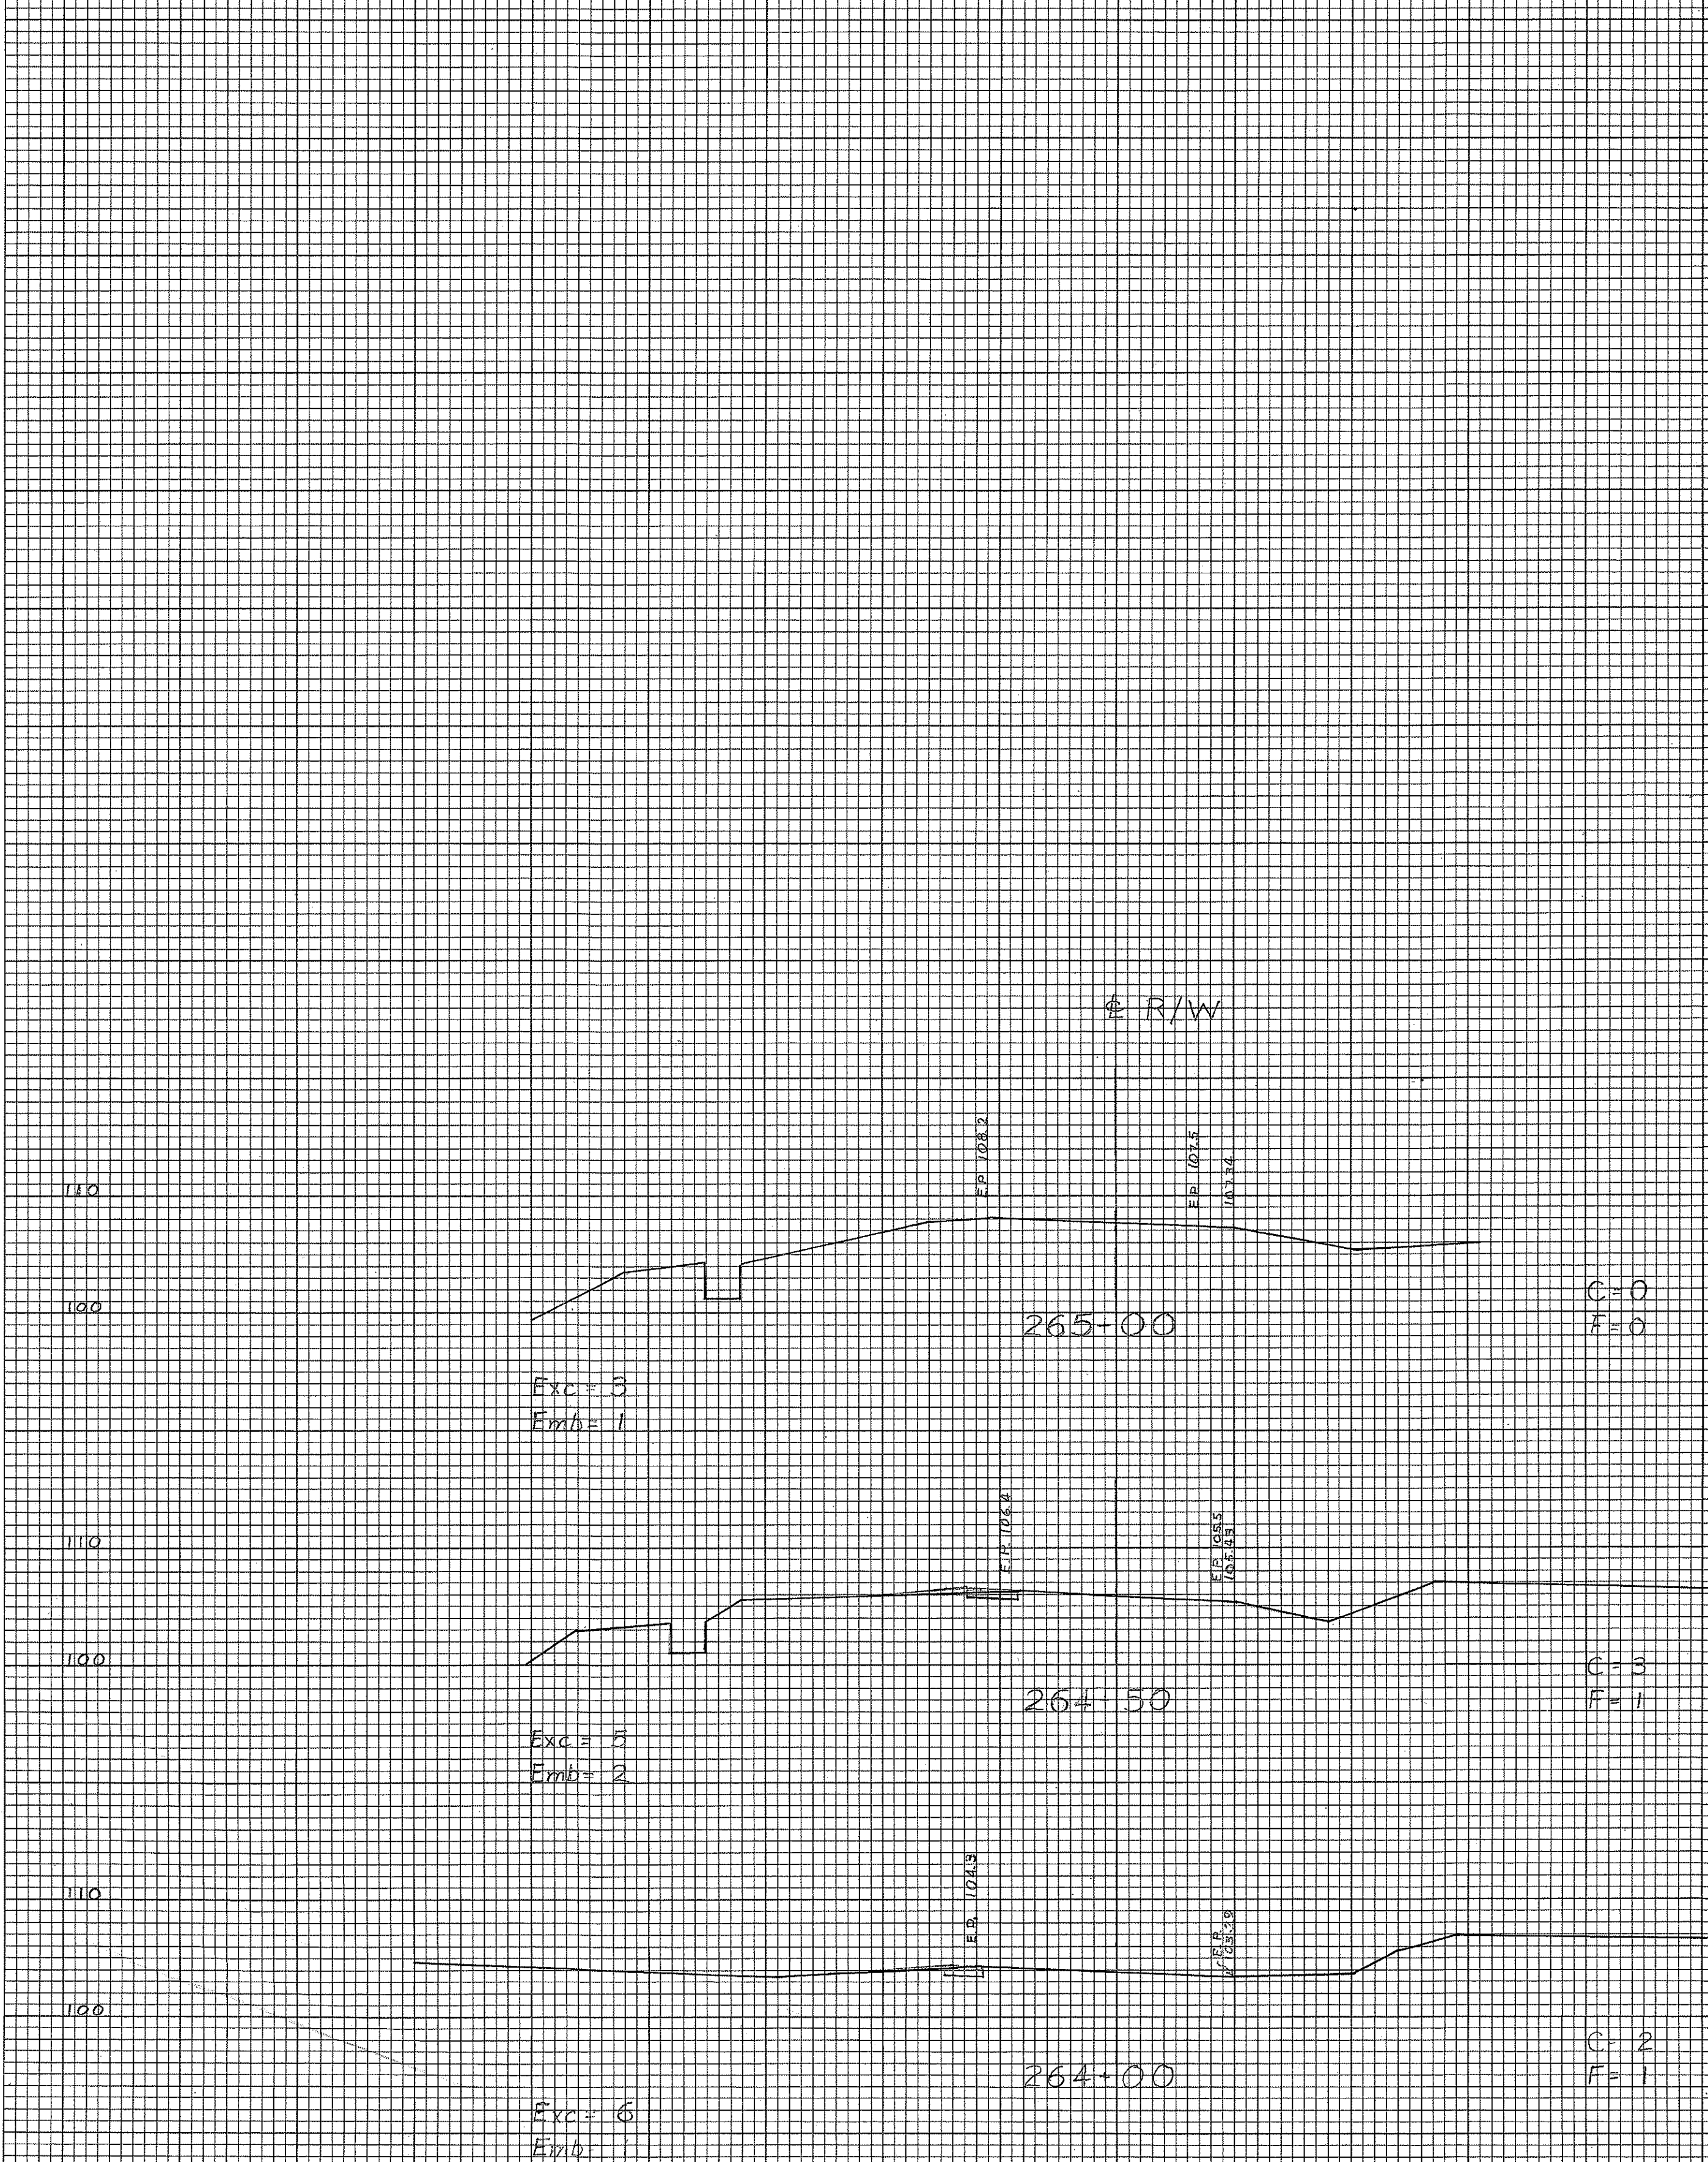

ACCESS ROAD TO BARBER'S POINT INDUSTRIAL AREA